


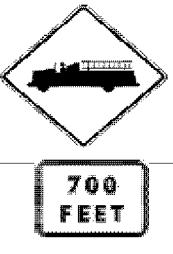


DIRECTION	MILEPOINT	LOCATION CODE (SHEET 2)	SIGN CODE	WIDTH (IN)	HEIGHT (IN)	SHEETING REMARKS	SIGN LEGEND	NEW SIGNS		EXISTING SIGNS				EXIST POST		NUMBER OF NEW POSTS	SQUARE STEEL (IN)			TUBULAR STEEL Ø (IN)				SIGN FRAME REQUIRED	REMARKS	SIGN DETAIL LOCATION		
								"A"	"B"	RETAIN	SALVAGE FROM	SALVAGE TO	REMOVE	RETAIN	REMOVE		1.75	2.00	2.50	3.00	3.50	4.00	5.00			SHSM	PROJECT SHEET #	STANDARD SHEET #
																	(LB / FT)			(LB / FT)								
NORTH HERO US-2 WB							FY-FLUORESCENT YELLOW FYG-FLUORESCENT YELLOW GREEN																"SHSM"-STANDARD HIGHWAY SIGNS AND MARKINGS					
		F	W11-8	30	30		 12/03/14	6.25							1		X	17.50							X			
		F	W16-2P	24	18			3.00																X				
WB	5.887	F	W11-2	30	30																							
		F	W16-9	24	10		12/03/14											17.25										
		F	W11-2	30	30	FYG	 12/03/14	6.25							1		X							X				
		F	W16-9P	24	12	FYG		2.00																X				
WB	5.813	F	W11-2	30	30																							
		F	R6-1	12	36		STATE LAW YIELD TO PEDESTRIANS IN CROSSWALK				1	1														SALVAGE AND RETURN SIGN TO TOWN		
		F	W16-7	24	12																							
		F	W11-2	30	30	FYG	 12/03/14	6.25																X				
		F	W16-7P	24	12	FYG		2.00																X				
WB	5.772	F	R2-1	24	30																							
		F	R2-1	24	30		 12/03/14	5.00							1		X	13.00						X				
WB	5.724	F	UNK.	UNK.	UNK.		NO PARKING BETWEEN SIGNS <==																					
WB	5.701	F	UNK.	UNK.	UNK.		NO PARKING BETWEEN SIGNS <==																					
SIGN SUMMARY SHEET							SHEET TOTALS	30.75	0.00	0	1	0	8	0	0	3		47.75	0	0.0	0.0	0.0	0.0				PROJECT NAME: ALBURGH-COLCHESTER	
								SF	SF	EA	EA	EA	EA	EA	EA	EA		FT	EA	LB	LB	LB	LB				PROJECT NUMBER: STPG SIGN(45)	
VERMONT AGENCY OF TRANSPORTATION							TOWN DIRECTIONAL TOTALS	363.5	0.0	10	1	0	67	0	0	37		555.0	0		0.0							FILE NAME: 4 NORTH HERO US2 WB TSS.xl PLOT DATE: 3/14/2014
																											DRAWN BY: J. BLANCHARD	
																											DESIGNED BY: B. TOOTHAKER	
																											CHECKED: K. KERN	
																											NORTH HERO WB SHEET 3	
																											SHEET 78 OF 167	