




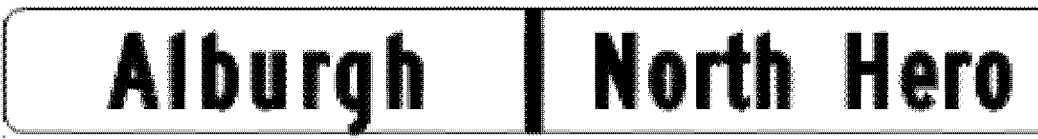





DIRECTION	MILEPOINT	LOCATION CODE (SHEET 2)	SIGN CODE	WIDTH (IN)	HEIGHT (IN)	SHEETING REMARKS	SIGN LEGEND	NEW SIGNS		EXISTING SIGNS				EXIST POST		NUMBER OF NEW POSTS	SQUARE STEEL (IN)			TUBULAR STEEL Ø (IN)				SIGN FRAME REQUIRED	REMARKS	SIGN DETAIL LOCATION		
								"A"	"B"	RETAIN	SALVAGE FROM	SALVAGE TO	REMOVE	RETAIN	REMOVE		1.75	2.00	2.50	3.00	3.50	4.00	5.00			SHSM	PROJECT SHEET #	STANDARD SHEET #
																	(LB / FT)			(LB / FT)								
NORTH HERO US-2 WB							FY-FLUORESCENT YELLOW FYG-FLUORESCENT YELLOW GREEN																"SHSM"-STANDARD HIGHWAY SIGNS AND MARKINGS					
		F	M1-4	24	24	BLK/ WHT	 11/26/14	4.00																X				
WB	0.258	F	R2-1	24	30																							
		F	R2-1	24	30		 11/26/14	5.00																	X			
WB	0.046	F	W1-2	30	30																							
		F	W1-2R	30	30		 11/26/14	6.25																	X			
WB	0.034	F	VD-018	30	18		 11/26/14	3.75																		6		
WB	0.018	F	S3-1T	30	30																							
		F	S3-1	36	36	FYG	 11/26/14	9.00																	X			
WB	0.000	G	VD-024	72	10		11/26/14																					
		G	VD-024	72	10		 5.00	5.00																		7		
		F	R2-1	24	30		 5.00	5.00																	X			
		G	VD-700	6	10		  0.42	0.42																			E-138	
		G	VD-700	6	10			0.42																		E-138		
SIGN SUMMARY SHEET							SHEET TOTALS	38.83	0.00	0	0	0	4	0	0	5	68.75	0	0.0	0.0	0.0	0.0						
							SF	SF	EA	EA	EA	EA	EA	EA	EA	EA	EA	EA	EA	EA	EA	EA	EA	EA	EA	EA	EA	
VERMONT AGENCY OF TRANSPORTATION							TOWN DIRECTIONAL TOTALS	363.52	0.0	10	1	0	67	0	0	37	623.50	0		0.0								

PROJECT NAME: ALBURGH-COLCHESTER
PROJECT NUMBER: STPG SIGN(45)
FILE NAME: 4 NORTH HERO US2 WB TSS.xl PLOT DATE: 3/14/2014
PROJECT MANAGER: D. BRYANT DRAWN BY: J. BLANCHARD
DESIGNED BY: B. TOOTHAKER CHECKED: K. KERN
NORTH HERO WB SHEET 10 SHEET 85 OF 167