



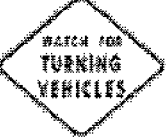

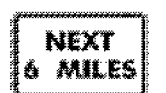


DIRECTION	MILEPOINT	LOCATION CODE (SHEET 2)	SIGN CODE	WIDTH (IN)	HEIGHT (IN)	SHEETING REMARKS	SIGN LEGEND	NEW SIGNS		EXISTING SIGNS				EXIST POST		NUMBER OF NEW POSTS	SQUARE STEEL (IN)			TUBULAR STEEL Ø (IN)				SIGN FRAME REQUIRED	REMARKS	SIGN DETAIL LOCATION		
								"A"	"B"	RETAIN	SALVAGE FROM	SALVAGE TO	REMOVE	RETAIN	REMOVE		1.75	2.00	2.50	3.00	3.50	4.00	5.00			SHSM	PROJECT SHEET #	STANDARD SHEET #
																	(LB / FT)			(LB / FT)								
GRAND ISLE US-2 EB							FY-FLUORESCENT YELLOW FYG-FLUORESCENT YELLOW GREEN															"SHSM"-STANDARD HIGHWAY SIGNS AND MARKINGS						
EB	-0.016	C	VD-024	60	7.5																					7		
		C	VD-024	72	10																							
		C	VD-700	6	10																						E-138	
		C	VD-700	6	10																						E-138	
EB	0.126	B	W3-3	30	30		SIGNAL AHEAD 11/21/14			1																		
EB	0.185	B	VW-170A	48	48		DRAW BRIDGE AHEAD 11/21/14			1																		
EB	0.262	A	W11-1	30	30																							
		A	W11-1	30	30																						X	
EB	0.375	A	R2-1	24	30																							
		A	R2-1	24	30																						X	
EB	0.433	A	VW-205	30	30																							
		A	VW-205	36	36																						E-154	
EB	0.605	A	W7-3A	24	18																							
		A	W11-5	30	30																							
		A	W11-5	30	30																						X	
SIGN SUMMARY SHEET							SHEET TOTALS		32.33	0.00	2	0	0	6	0	0	1	15.0	0	0.0	0.0	0.0	0.0	PROJECT NAME: ALBURGH-COLCHESTER PROJECT NUMBER: STPG SIGN(45)				
							SF	SF	EA	EA	EA	EA	EA	EA	EA	FT	EA	LB	LB	LB	LB	FILE NAME: 5 GRAND ISLE US2 EB TSS.xls PLOT DATE: 3/14/2014 PROJECT MANAGER: D. BRYANT DRAWN BY: J. BLANCHARD DESIGNED BY: B. TOOTHAKER CHECKED: K. KERN GRAND ISLE EB SHEET 1 SHEET 86 OF 167						
VERMONT AGENCY OF TRANSPORTATION							TOWN DIRECTIONAL TOTALS		319.6	0.0	19	2	0	61	0	0	33	495.0	0		0.0							