







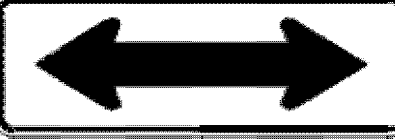


DIRECTION	MILEPOINT	LOCATION CODE (SHEET 2)	SIGN CODE	WIDTH (IN)	HEIGHT (IN)	SHEETING REMARKS	SIGN LEGEND	NEW SIGNS		EXISTING SIGNS				EXIST POST		NUMBER OF NEW POSTS	SQUARE STEEL (IN)			TUBULAR STEEL Ø (IN)				SIGN FRAME REQUIRED	REMARKS	SIGN DETAIL LOCATION							
								"A"	"B"	RETAIN	SALVAGE FROM	SALVAGE TO	REMOVE	RETAIN	REMOVE		1.75	2.00	2.50	FOUNDATION	3.00	3.50	4.00			5.00	SHSM	PROJECT SHEET #	STANDARD SHEET #				
																	(LB / FT)				(LB / FT)												
GRAND ISLE US-2 EB							FY-FLUORESCENT YELLOW FYG-FLUORESCENT YELLOW GREEN																"SHSM"-STANDARD HIGHWAY SIGNS AND MARKINGS										
		A	VD1-1	72	12			6.00							2	14.25 X 14.00																	
		A	VD1-1	72	12		 II/24/14	6.00																									
EB	4.598	A	W11-3	30	30																												
		A	W11-3	30	30			6.25							1	15.00 X																	
EB	4.624	A	R2-1	24	30																												
		A	R2-1	24	30		 II/25/14	5.00							1	14.50 X																	
EB	5.338	A	VR-072	24	24		 II/25/14	4.00							1	14.50 X																	
		B	VR-072	24	24		 II/25/14	4.00																									
EB	5.360	A	VD-062BRN	72	16		BUSINESS SIGN			1																							
EB	5.429	A	W2-2L	30	30																												
		A	W2-2	30	30		 II/25/14	6.25							1	16.25 X																	
EB	5.466	A	VW-060	30	30																												
		A	VW-060	30	30		 II/25/14	6.25							1	13.50 X																	
EB	5.537	C	W1-7	60	30																												
		C	W1-7	48	24			8.00							2	13.75 X 13.75																	
SIGN SUMMARY SHEET							SHEET TOTALS	51.75	0.00	1	0	0	5	0	0	9	129.50 135.0	0	0.0	0.0	0.0	0.0											
							SF	SF	EA	EA	EA	EA	EA	EA	EA	EA	FT	EA	LB	LB	LB	LB											
VERMONT AGENCY OF TRANSPORTATION							TOWN DIRECTIONAL TOTALS	319.6	0.0	19	2	0	61	0	0	33	495.0	0			0.0												
											</																						