



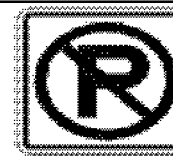





DIRECTION	MILEPOINT	LOCATION CODE (SHEET 2)	SIGN CODE	WIDTH (IN)	HEIGHT (IN)	SHEETING REMARKS	SIGN LEGEND	NEW SIGNS		EXISTING SIGNS				EXIST POST		NUMBER OF NEW POSTS	SQUARE STEEL (IN)			TUBULAR STEEL Ø (IN)				SIGN FRAME REQUIRED	REMARKS	SIGN DETAIL LOCATION			
								"A"	"B"	RETAIN	SALVAGE FROM	SALVAGE TO	REMOVE	RETAIN	REMOVE		1.75	2.00	2.50	3.00	3.50	4.00	5.00			SHSM	PROJECT SHEET #	STANDARD SHEET #	
																	(LB / FT)			(LB / FT)									
MILTON US-2 WB							FY-FLUORESCENT YELLOW FYG-FLUORESCENT YELLOW GREEN															"SHSM"-STANDARD HIGHWAY SIGNS AND MARKINGS							
		F	R2-1	30	36		 11/11/14	7.50															REQUIRES VEGETATION CLEARING	X					
WB	2.367	F	VW-318	30	30		WILDLIFE CROSSING			1				X															
		F	W7-3A	24	18		NEXT 1 MILE			1				X															
WB	2.192	F	VR-644P	24	12		BEGIN						1	X															
		F	R8-3A	24	24		NO PARKING SYMBOL 11/14/14						1																
		F	R3-9cP	30	12	BLK/WHT	 04/24/15	2.50										14.00						X					
		F	R8-3	36	36		 9.00																	X					
WB	2.083	F	M4-6P	24	12		END PARKING 11/11/14						1	X															
		F	R8-3A	24	24		NO PARKING SYMBOL						1																
WB	2.050	F	R3-9dP	30	12	BLK/WHT	 11/11/14	2.50						1				X	14.50					INSTALL 1.17 MI WEST OF TH-40 (175 FT WEST OF EXISTING)	X				
		F	R8-3	36	36		 04/24/15	9.00																X					
WB	1.886	F	D11-1	24	18		11/11/14						1	X															
		F	D11-1	24	18		 3.00											13.00	X					X					
WB	1.600	F	M4-6	12	6	WHT/GRN	 11/11/14	0.50						1				13.50	X					INSTALL 1510 FT FROM BIKE ROUTE SIGN	X				
		F	D11-1	24	18		 3.00																	X					
SIGN SUMMARY SHEET							SHEET TOTALS		37.00	0.00	2	0	0	5	0	0	3	55.00	0	0.0	0.0	0.0	0.0	PROJECT NAME: ALBURGH COLCHESTER PROJECT NUMBER: STPG SIGN(45)					
VERMONT AGENCY OF TRANSPORTATION							SF	SF	EA	EA	EA	EA	EA	EA	EA	EA	EA	FT	EA	LB	LB	LB	LB	FILE NAME: 10 MILTON US2 WB TSS.xls PLOT DATE: 3/14/2014 PROJECT MANAGER: D. BRYANT DRAWN BY: J. BLANCHARD DESIGNED BY: B. TOOTHAKER CHECKED: K. KERN MILTON WB SHEET 4 SHEET 140 OF 167					
TOWN DIRECTIONAL TOTALS							317.3	0.0	4	0	0	46	0	0	24	360.0	0	0.0	0.0	0.0	0.0								