


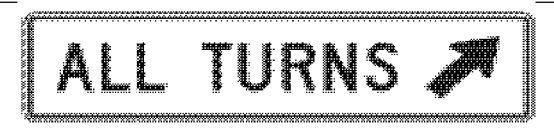


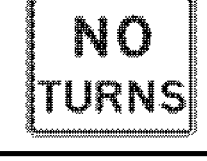




DIRECTION	MILEPOINT	LOCATION CODE (SHEET 2)	SIGN CODE	WIDTH (IN)	HEIGHT (IN)	SHEETING REMARKS	SIGN LEGEND	NEW SIGNS		EXISTING SIGNS				EXIST POST		NUMBER OF NEW POSTS	SQUARE STEEL (IN)			TUBULAR STEEL Ø (IN)				SIGN FRAME REQUIRED	REMARKS	SIGN DETAIL LOCATION				
								"A"	"B"	RETAIN	SALVAGE FROM	SALVAGE TO	REMOVE	RETAIN	REMOVE		1.75	2.00	2.50	FOUNDATION	3.00	3.50	4.00			5.00	SHSM	PROJECT SHEET #	STANDARD SHEET #	
																	(LB / FT)				(LB / FT)									
COLCHESTER US-2 WB							FY-FLUORESCENT YELLOW FYG-FLUORESCENT YELLOW GREEN																"SHSM"-STANDARD HIGHWAY SIGNS AND MARKINGS							
		F	M1-4	24	24	BLK/WHT		4.00																			X			
WB	1.855	F	VR-428	24	30		ALL TURNS RIGHT LANE 10/30/14						X		X															SLIP BASES
		F	R3-23	60	36			15.00								2	X										X			
WB	1.807	F	D1-1M	72	12		JASPER MINE RD ----> (45 DEG)						1		X															
		F	VD1-1	72	12		 11/05/14	6.00																					9	
		F	VD1-1	72	12			6.00																					9	
WB	1.776	F	VR-903R	36	30		THRU/RIGHT ALL TURNS						1		X															
		F	R3-24	72	18			9.00								2	X										X			
WB	1.739	F	VR-284	30	36		ALL TURNS ==>> (45 DEG)						1		X															
		F	R3-24	72	18			9.00								2	X										X			
WB	1.688	F	R3-3	24	24			4.00								1	12.50 X										X			INSTALL IN MEDIAN AT INTERSECTION RTE 2 AND JASPER MINE RD (TH-103)
		E	R3-3	24	24			4.00																			X			
WB	1.686	F	R1-1	30	30								1		X															
		E	R5-1	30	30								1				13.50													
		F	R1-1	30	30			6.25								1	X										X			EAST OF JUGHANDLE AT INTERSECTION WITH JASPER MINE RD (TH-103)
SIGN SUMMARY SHEET							SHEET TOTALS	63.25	0.00	0	0	0	7	0	0	8	106.25 120.0	0	0.0	0.0	0.0	0.0		PROJECT NAME: ALBURGH-COLCHESTER						
								SF	SF	EA	EA	EA	EA	EA	EA	EA	FT	EA	LB	LB	LB	LB		PROJECT NUMBER: STPG SIGN(45)						
VERMONT AGENCY OF TRANSPORTATION							TOWN DIRECTIONAL TOTALS	464.5	0.0	22	0	0	52	0	0	43	645.0	0		0.0				FILE NAME: 12 COLCHESTER US2 WB TSS	PLOT DATE: 3/14/2014					
																							PROJECT MANAGER: D. BRYANT	DRAWN BY: J. BLANCHARD						
																							DESIGNED BY: B. TOOTHAKER	CHECKED: K. KERN						
																						COLCHESTER WB SHEET 3	SHEET 159 OF 167							