



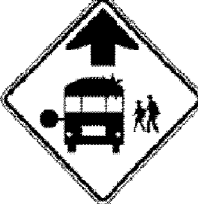





| DIRECTION | MILEPOINT | LOCATION CODE (SHEET 2) | SIGN CODE | WIDTH (IN) | HEIGHT (IN) | SHEETING REMARKS | SIGN LEGEND | NEW SIGNS | | EXISTING SIGNS | | | | EXIST POST | | NUMBER OF NEW POSTS | SQUARE STEEL (IN) | | | TUBULAR STEEL Ø (IN) | | | | SIGN FRAME REQUIRED | REMARKS | SIGN DETAIL LOCATION | | | |
|----------------------------------|-----------|-------------------------|-----------|------------|-------------|------------------|--|--------------------------------|-----|----------------|--------------|------------|--------|------------|--------|---------------------|-------------------|------|-------|----------------------|------|------|--|---|---------|--|------|-----------------|------------------|
| | | | | | | | | "A" | "B" | RETAIN | SALVAGE FROM | SALVAGE TO | REMOVE | RETAIN | REMOVE | | 1.75 | 2.00 | 2.50 | FOUNDATION | 3.00 | 3.50 | 4.00 | | | 5.00 | SHSM | PROJECT SHEET # | STANDARD SHEET # |
| | | | | | | | | | | | | | | | | | | | | | | | | | | | | | |
| SB HARTLAND VT 12 | | | | | | | FY-FLUORESCENT YELLOW FYG-FLUORESCENT YELLOW GREEN | | | | | | | | | | | | | | | | "SHSM"-STANDARD HIGHWAY SIGNS AND MARKINGS | | | | | | |
| SB | 4.942 | F | D3-1 | 30 | 5 | | DAMON RD | | | | | | | | | | | | | | | | | | | | | | |
| | | H | R1-1 | 30 | 30 | | STOP | | | | | | | | | | | | | | | | | | | | | | |
| | | F | D3-1 | 36 | 12 | |  0120 1409 0495 | | | | | | | | | | | | | | | | | | | | | | |
| | | H | R1-1 | 30 | 30 | |  | | | | | | | | | | | | | | | | | | | | | | |
| | | | | | | | | | | | | | | | | | | | | | | | | | | | | | |
| SB | 4.734 | F | W1-2L | 30 | 30 | | LEFT CURVE | | | | | | | | | | | | | | | | | | | | | | |
| SB | 4.699 | F | S3-1 | 30 | 30 | | SCHOOL BUS STOP AHEAD | | | | | | | | | | | | | | | | | | | | | | |
| | | F | W1-10L | 36 | 36 | |  | | | | | | | | | | | | | | | | | | | | | | |
| | | F | W16-8aP | 24 | 15 | |  | | | | | | | | | | | | | | | | | | | | | | |
| SB | 4.650 | F | S3-1 | 36 | 36 | FYG |  | | | | | | | | | | | | | | | | | | | | | | |
| SB | 4.541 | G | VR-017 | 24 | 30 | |  24,000 POUNDS | | | | | | | | | | | | | | | | | | | | | | |
| | | G | VR-017 | 24 | 30 | | NOTICE WEIGHT LIMIT | | | | | | | | | | | | | | | | | | | | | | |
| | | | | | | | | | | | | | | | | | | | | | | | | | | | | | |
| SB | 4.535 | F | D3-1 | 36 | 5 | | HARTLAND HILL RD | | | | | | | | | | | | | | | | | | | | | | |
| | | H | R1-1 | 30 | 30 | | STOP | | | | | | | | | | | | | | | | | | | | | | |
| | | H | R1-1 | 30 | 30 | |  0120 1409 0454 | | | | | | | | | | | | | | | | | | | | | | |
| SB | 4.535 | F | D3-1 | 60 | 12 | |  | | | | | | | | | | | | | | | | | | | | | | |
| SIGN SUMMARY SHEET | | | | | | | | SHEET TOTALS | | 46.00 | 0.00 | 0 | 3 | 3 | 10 | 0 | 0 | 8 | 145.0 | 135.0 | 0 | 0.0 | 0.0 | 0.0 | 0.0 | PROJECT NAME: HARTLAND, BETH EL PROJECT NUMBER: STPG SIGN (40) | | | |
| VERMONT AGENCY OF TRANSPORTATION | | | | | | | | TOWN DIRECTIONAL TOTALS | | 277.6 | 0.0 | 12 | 3 | 3 | 64 | 0 | 0 | 49 | 735.0 | 0 | 0.0 | 0.0 | 0.0 | 0.0 | 0.0 | FILE NAME: HARTLAND VT ROUTE 12 SB PROJECT MANAGER: AMY GAMBLE DESIGNED BY: M. MILLER HARTLAND VT-12 SOUTHBOUND 3 | | | |
| | | | | | | | | | | | | | | | | | | | | | | | | PLOT DATE: 8/1/2012 DRAWN BY: M. MILLER CHECKED: AMY GAMBLE SHEET 28 OF 86 | | | | | |