




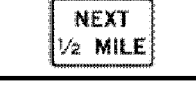



DIRECTION	MILEPOINT	LOCATION CODE (SHEET 2)	SIGN CODE	WIDTH (IN)	HEIGHT (IN)	SHEETING REMARKS	SIGN LEGEND	NEW SIGNS		EXISTING SIGNS			EXIST POST		NUMBER OF NEW POSTS	SQUARE STEEL (IN)			TUBULAR STEEL Ø (IN)				SIGN FRAME REQUIRED	REMARKS	SIGN DETAIL LOCATION													
								"A"	"B"	RETAIN	SALVAGE FROM	SALVAGE TO	REMOVE	RETAIN		REMOVE	1.75	2.00	2.50	3.00	3.50	4.00			5.00	SHSM	PROJECT SHEET #	STANDARD SHEET #										
																	(LB / FT)			(LB / FT)																		
<b>SB HARTLAND VT 12</b>							FY-FLUORESCENT YELLOW FYG-FLUORESCENT YELLOW GREEN																"SHSM"-STANDARD HIGHWAY SIGNS AND MARKINGS															
SB	0.714	F	R2-1	24	30		 (CONT.)	5.00						1	13.0'	X									X													
SB	0.652	F	W11-8	30	30		FIRE STATION SYMBOL					1		X														NOT NEEDED; FIRE STATION IS CLEARLY VISIBLE JUST AHEAD										
SB	0.460	F	W3-5	36	36							1		X																								
		F	W3-5	36	36			9.00						2	17.0'/17.0'	X									X													
SB	0.420	F	VD-018	30	18							1		X																								
		F	VD-018	30	18			3.75						1	15.0'	X											14											
SB	0.385	F	R2-1	24	30		SPEED LIMIT 30					1		X														TO BE REPLACED 50 FT± SOUTH OF THIS POSITION										
SB	0.375	F	R2-1	30	36			7.50						1	14.0'	X									X			INSTALL ACROSS FROM THE NB-FACING SPEED LIMIT 40 SIGN										
SB	0.328	F	W11-2	30	30		PEDESTRIAN SYMBOL					1		X																								
		F	W7-3aP	24	18		NEXT 1/2 MILE (PLAQUE)					1																										
		F	W11-2	30	30	FYG		6.25						1	15.5'	X									X													
		F	W7-3aP	24	18	FYG		3.00																			8											
SB	0.248	F	R2-1	24	30							1		X																								
		F	R2-1	24	30			5.00						1	13.5'	X									X													
SB	0.198	F	M2-1	21	15		JCT (CONT. ON NEXT PAGE)					1	X	X														EXISTING POST WAS RETAINED DUE TO A BURIED CABLE IN THE VICINITY.										
<b>SIGN SUMMARY SHEET</b>								<b>SHEET TOTALS</b>		39.50	0.00	0	0	0	8	0	0	7	105.0	0	0.0	0.0	0.0	0.0	PROJECT NAME: HARTLAND-BETHEL PROJECT NUMBER: STPG SIGN (40)													
VERMONT AGENCY OF TRANSPORTATION								SF	SF	EA	EA	FILENAME: HARTLAND VT ROUTE 12 SB PROJECT MANAGER: AMY GAMBLE DESIGNED BY: M. MILLER HARTLAND VT-12 SOUTHBOUND 7					
<b>TOWN DIRECTIONAL TOTALS</b>								277.6	0.0	12	3	3	64	0	0	49	735.0	0	0.0	0.0	0.0	0.0	PLOT DATE: 8/1/2012 DRAWN BY: M. MILLER CHECKED: AMY GAMBLE SHEET 32 OF 86															