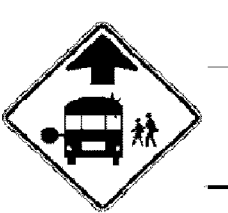
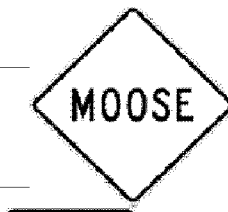
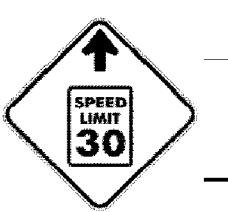

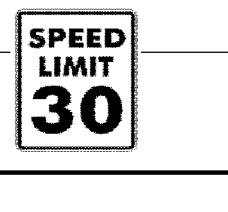


DIRECTION	MILEPOINT	LOCATION CODE (SHEET 2)	SIGN CODE	WIDTH (IN)	HEIGHT (IN)	SHEETING REMARKS	SIGN LEGEND	NEW SIGNS		EXISTING SIGNS				EXIST POST		NUMBER OF NEW POSTS	SQUARE STEEL (IN)			TUBULAR STEEL Ø (IN)					SIGN FRAME REQUIRED	REMARKS	SIGN DETAIL LOCATION		
								"A"	"B"	RETAIN	SALVAGE FROM	SALVAGE TO	REMOVE	RETAIN	REMOVE		1.75	2.00	2.50	3.00	3.50	4.00	5.00	SHSM			PROJECT SHEET #	STANDARD SHEET #	
																													(LB / FT)
NB BARNARD VT 12							FY-FLUORESCENT YELLOW FYG-FLUORESCENT YELLOW GREEN																"SHSM"-STANDARD HIGHWAY SIGNS AND MARKINGS						
NB	2.605	A	S3-1	30	30		 SCHOOL BUS STOP AHEAD (TEXT)																						
		A	S3-1	36	36	FYG		0.00 0.00																			X		
NB	2.661	A	VW-000	30	30		MOOSE CROSSING																						
		A	W7-3aP	24	18		 NEXT 1 MILE (PLAQUE)																						
		A	VW-001	36	36			9.00																			7		
		A	VW-249	24	18			3.00																	INSTALL THE PLAQUE ON THE LEFT SIDE POST			8	
NB	3.894	A	W11-6H	30	30		SNOWMOBILE CROSSING (HINGED SIGN)	6.25																					
		A	W3-5	36	36		 SPEED LIMIT 30																						
		A	W3-5	36	36			9.00																		X			
NB	4.307	A	VD-018	30	18		 Barnard Bethel 9																						
		A	VD-018	30	18			3.75																			14		
NB	4.413	A	R2-1	24	30		 SPEED LIMIT 30																						
		A	R2-1	30	36			7.50																	NOTE: THE NEW SIGN IS LARGER	X			
NB	4.463	A	S1-1	30	30		SCHOOL SYMBOL																						
		A	W16-9P	24	10		AHEAD (PLAQUE) (CONT. ON NEXT PAGE)																						
SIGN SUMMARY SHEET							SHEET TOTALS	38.50 41.25	0.00	0	0	0	9	0	0	8	89.0 120.0	0	0.0	0.0	0.0	0.0		PROJECT NAME: HARTLAND-BETHEL PROJECT NUMBER: STPG SIGN (40)					
VERMONT AGENCY OF TRANSPORTATION							TOWN DIRECTIONAL TOTALS	322.2	0.0	6	2	2	59	0	0	65	975.0	0		0.0				FILE NAME: BARNARD VT ROUTE 12 NB PROJECT MANAGER: AMY GAMBLE DESIGNED BY: M. MILLER BARNARD VT-12 NORTHBOUND 2	PLOT DATE: 8/1/2012 DRAWN BY: M. MILLER CHECKED: AMY GAMBLE SHEET 49 OF 85				