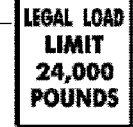

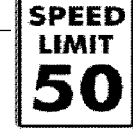


DIRECTION	MILEPOINT	LOCATION CODE (SHEET ?)	SIGN CODE	WIDTH (IN)	HEIGHT (IN)	SHEETING REMARKS	SIGN LEGEND	NEW SIGNS		EXISTING SIGNS				EXIST POST		NUMBER OF NEW POSTS	SQUARE STEEL (IN)			TUBULAR STEEL Ø (IN)				SIGN FRAME REQUIRED	REMARKS	SIGN DETAIL LOCATION		
								"A"	"B"	RETAIN	SALVAGE FROM	SALVAGE TO	REMOVE	RETAIN	REMOVE		1.75	2.00	2.50	3.00	3.50	4.00	5.00			SHSM	PROJECT SHEET #	STANDARD SHEET #
																	(LB / FT)			(LB / FT)								
NB BARNARD VT 12							FY-FLUORESCENT YELLOW FYG-FLUORESCENT YELLOW GREEN																"SHSM"-STANDARD HIGHWAY SIGNS AND MARKINGS					
NB	8.977	A	D3-1	66	12		<b>Rhoades Hill TH-7</b>	5.50							2	11.0' / 11.0' X										12		
NB	8.980	C	D3-1	30	6		RHOADES HILL TH7					1		X														
		C	VR-017	24	30		LEGAL LOAD LIMIT 24,000 POUNDS					1																
		C	VR-017	24	30		 <b>TH 7</b>	5.00							1	14.0' X									6			
NB	8.986	D	R1-1	30	30							1		X														
		D	R1-1	30	30			6.25							1	13.0' X									X			
NB	9.357	A	VS3-4	36	36		SCHOOL BUS TURN AROUND			1			X															
NB	9.526 9.522	A	R2-1	24	30							1		X														
		A	R2-1	24	30			5.00							1	14.0' X									X			
NB	8.648	A	D3-1	66	12		HAMBSCH FARM RD. TH-66	5.50							2													
<b>SIGN SUMMARY SHEET</b>							<b>SHEET TOTALS</b>	27.25 24.75	0.00	1	0	0	5 4	0	0	5	63.0 75.0	0	0.0	0.0	0.0	0.0		PROJECT NAME: HARTLAND-BETHEL PROJECT NUMBER: STPG SIGN (40)				
VERMONT AGENCY OF TRANSPORTATION							<b>TOWN DIRECTIONAL TOTALS</b>	322.2	0.0	6	2	2	59	0	0	65	975.0	0		0.0				FILE NAME: BARNARD VT ROUTE 12 NB PROJECT MANAGER: AMY GAMBLE DESIGNED BY: M. MILLER BARNARD VT-12 NORTHBOUND 9	PLOT DATE: 8/1/2012 DRAWN BY: M. MILLER CHECKED: AMY GAMBLE SHEET 66 OF 86			