






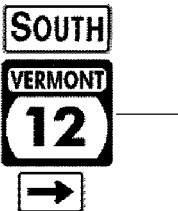


DIRECTION	MILEPOINT	LOCATION CODE (SHEET 2)	SIGN CODE	WIDTH (IN)	HEIGHT (IN)	SHEETING REMARKS	SIGN LEGEND	NEW SIGNS		EXISTING SIGNS			EXIST POST		NUMBER OF NEW POSTS	SQUARE STEEL (IN)			TUBULAR STEEL Ø (IN)					SIGN FRAME REQUIRED	REMARKS	SIGN DETAIL LOCATION				
								"A"	"B"	RETAIN	SALVAGE FROM	SALVAGE TO	REMOVE	RETAIN		REMOVE	1.75	2.00	2.50	FOUNDATION	3.00	3.50	4.00			5.00	SHSM	PROJECT SHEET #	STANDARD SHEET #	
																														(LB / FT)
<b>SB BARNARD VT 12</b>							FY-FLUORESCENT YELLOW FYG-FLUORESCENT YELLOW GREEN																	"SHSM"-STANDARD HIGHWAY SIGNS AND MARKINGS						
SB	4.797	F	M1-5	24	24		 (CONT.)	4.00																				E-136B		
		F	M6-1R	21	15			2.19															X							
SB	4.738	F	M3-3	24	12		SOUTH																							
		F	M1-5	24	24		VT ROUTE 12																							
		F	M3-3	24	12			2.00															X							
		F	M1-5	24	24			4.00																				E-136B		
SB	4.707	F	S1-1	30	30		SCHOOL SYMBOL																							
		F	W16-9P	24	10		AHEAD PLAQUE																							
		F	S1-1	36	36	FYG		9.00															X							
		F	S4-3P	30	8	FYG		2.00																						
		F	S4-3P	30	8	FYG		1.67																				8		
		F	S4-3P	30	8	FYG																								
SB	4.670	F	R2-1	24	30																									
		F	R2-1	24	30			5.00															X							
		F	R2-1	24	30																									
SB	4.621	G	VR-017	24	30		LEGAL LOAD LIMIT 24,000 POUNDS																							
		F	R6-2R	18	24		ONE WAY RIGHT																							
		E	R6-2L	18	24		ONE WAY LEFT (CONT. ON NEXT PAGE)																							
<b>SIGN SUMMARY SHEET</b>							<b>SHEET TOTALS</b>	29.86 <del>27.86</del>	0.00	0	0	0	9 <del>8</del>	0	0	4	60.0	0	0.0	0.0	0.0	0.0								
VERMONT AGENCY OF TRANSPORTATION							<b>TOWN DIRECTIONAL TOTALS</b>	441.5	0.0	2	3	3	78	0	0	87	1305.0	0		0.0										
															PROJECT NAME: HARTLAND-BETHEL PROJECT NUMBER: STPG SIGN (40)															
															FILE NAME: BARNARD VT ROUTE 12 SB PROJECT MANAGER: AMY GAMBLE DESIGNED BY: M. MILLER BARNARD VT-12 SOUTHBOUND 7															
															PLOT DATE: 8/1/2012 DRAWN BY: M. MILLER CHECKED: AMY GAMBLE SHEET 63 OF 86															