




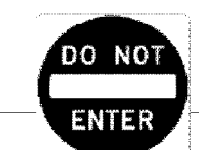


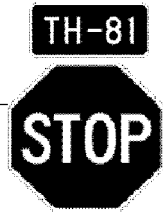


DIRECTION	MILEPOINT	LOCATION CODE (SHEET 2)	SIGN CODE	WIDTH (IN)	HEIGHT (IN)	SHEETING REMARKS	SIGN LEGEND	NEW SIGNS		EXISTING SIGNS			EXIST POST		NUMBER OF NEW POSTS	SQUARE STEEL (IN)			TUBULAR STEEL Ø (IN)				SIGN FRAME REQUIRED	REMARKS	SIGN DETAIL LOCATION				
								"A"	"B"	RETAIN	SALVAGE FROM	SALVAGE TO	REMOVE	RETAIN		REMOVE	1.75	2.00	2.50	FOUNDATION	3.00	3.50			4.00	5.00	SHSM	PROJECT SHEET #	STANDARD SHEET #
SB BARNARD VT 12							FY-FLUORESCENT YELLOW FYG-FLUORESCENT YELLOW GREEN															"SHSM"-STANDARD HIGHWAY SIGNS AND MARKINGS							
SB	4.621	G	VR-017	24	30		 BACK-TO-BACK  (CONT.)	5.00						1	14.0'	X											6		
		H	R5-1a	36	24			6.00																	X				
SB	4.615	H	R5-1	30	30		DO NOT ENTER																						
		F	R6-1R	36	12		 BACK-TO-BACK 	3.00						1	11.0'	X									X				
		E	R6-1L	36	12			3.00																	X				
SB	4.584	F	R6-2L	18	24		ONE WAY LEFT																						
		E	R6-2R	18	24		ONE WAY RIGHT																						
		G	R5-1	30	30		DO NOT ENTER																						
		G	R5-1	30	30			6.25						1	14.0'	X									X				
		F	R6-1L	36	12		 BACK-TO-BACK 	3.00																	X				
		E	R6-1R	36	12			3.00																	X				
SB	4.576	H	R1-1	30	30		STOP																						
		F	D3-1	24	12			2.00						1	14.0'	X											12		
		H	R1-1	30	30			6.25																	X				
SB	4.527	F	R2-1	24	30		SPEED LIMIT 30 (CONT. ON NEXT PAGE)																						
SIGN SUMMARY SHEET							SHEET TOTALS	37.50 37.51	0.00	0	1	0	7	0	0	4	53.0	46.0	0	0.0	0.0	0.0	0.0	PROJECT NAME: HARTLAND-BETHEL PROJECT NUMBER: STPG SIGN (40)					
VERMONT AGENCY OF TRANSPORTATION							TOWN DIRECTIONAL TOTALS	441.5	0.0	2	3	3	78	0	0	87	1305.0	0	0.0	0.0	0.0	0.0	FILENAME: BARNARD VT ROUTE 12 SB PROJECT MANAGER: AMY GAMBLE DESIGNED BY: M. MILLER BARNARD VT-12 SOUTHBOUND 8					PLOT DATE: 8/1/2012 DRAWN BY: M. MILLER CHECKED BY: AMY GAMBLE SHEET 64 OF 85	