


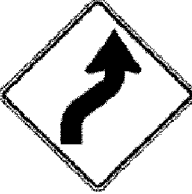


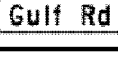


DIRECTION	MILEPOINT	LOCATION CODE (SHEET 2)	SIGN CODE	WIDTH (IN)	HEIGHT (IN)	SHEETING REMARKS	SIGN LEGEND	NEW SIGNS		EXISTING SIGNS			EXIST POST		NUMBER OF NEW POSTS	SQUARE STEEL (IN)			TUBULAR STEEL Ø (IN)				SIGN FRAME REQUIRED	REMARKS	SIGN DETAIL LOCATION			
								"A"	"B"	RETAIN	SALVAGE FROM	SALVAGE TO	REMOVE	RETAIN		REMOVE	1.75	2.00	2.50	3.00	3.50	4.00			5.00	SHSM	PROJECT SHEET #	STANDARD SHEET #
																	(LB / FT)			(LB / FT)								
SB BARNARD VT 12							FY-FLUORESCENT YELLOW FYG-FLUORESCENT YELLOW GREEN															"SHSM"-STANDARD HIGHWAY SIGNS AND MARKINGS						
SB	3.588	F	VW-000	30	30		MOOSE CROSSING (TEXT)																SIGNS AND POST MISSING					
		F	W7-3ap	24	18		NEXT 1 MILE (PLAQUE)																					
		F	VW-001	36	36			9.00						2	16.0'	17.0'							INSTALL ³⁰ 290 FT± SOUTH OF THE SIGN INSTALLED AT MP 3.643		7			
		F	VW-249	24	18			3.00															INSTALL THE PLAQUE ON THE LEFT SIDE POST		8			
SB	3.250	F	W7-1a	30	30		HILL SYMBOL 7%				1		X															
SB	3.133	F	W1-4R	30	30		RIGHT REVERSE CURVE				1		X															
		F	W7-1a	30	30			6.25						1	15.0'										X			
SB	3.017	F	W1-4R	30	30			6.25						1	15.0'								INSTALL ⁶⁵⁰ 416 FT± SOUTH OF THE PREVIOUS POSITION AT MP 3.133	X				
SB	2.924	F	S3-1	30	30		SCHOOL BUS STOP AHEAD (TEXT)				1		X										NOTE LOCATION AS REFERENCE FOR THE NEXT SIGN					
SB	2.916	F	S3-1	36	36	FYG		0.00 9.00						0 2	0 X						THIS IS NOT WARRANTED.	INSTALL 40 FT± SOUTH OF THE PREVIOUS POSITION AT MP 2.924	X					
SB	2.717	F	W11-7	30	30		EQUESTRIAN SYMBOL				1		X										SIGNS NO LONGER WARRANTED					
		F	W11-7P	24	18		EQUESTRIAN XING (PLAQUE)				1																	
SB	2.322	F	W1-10cL	36	36			9.00						2	15.0'	16.0'							INSTALL THIS ASSEMBLY 340 FT± NORTH OF THE LEGAL LOAD LIMIT SIGN AT MP 2.258	X				
		F	W16-8P	24	8			1.33															INSTALL THE PLAQUE ON THE RIGHT-SIDE POST UNDER THE CURVE LEFT SIGN		8			
SB	2.258	G	R2-1	24	30		SPEED LIMIT 25 (CONT. ON NEXT PAGE)			1		1		X									GULF RD (TH-62)					
SIGN SUMMARY SHEET							SHEET TOTALS	34.83 43.83	0.00	0	1	0	6	0	0	8	94.0 120.0	0	0.0	0.0	0.0	0.0	PROJECT NAME: HARTLAND-BETHEL PROJECT NUMBER: STPG SIGN (40)					
VERMONT AGENCY OF TRANSPORTATION							TOWN DIRECTIONAL TOTALS	441.5	0.0	2	3	3	78	0	0	87	1305.0	0	0.0	0.0	0.0	0.0	FILENAME: BARNARD VT ROUTE 12 SB PROJECT MANAGER: AMY GAMBLE DESIGNED BY: M. MILLER BARNARD VT-12 SOUTHBOUND 10	PLOT DATE: 8/1/2012 DRAWN BY: M. MILLER CHECKED: AMY GAMBLE SHEET 66 OF 85				