


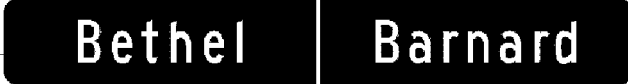


DIRECTION	MILEPOINT	LOCATION CODE (SHEET 2)	SIGN CODE	WIDTH (IN)	HEIGHT (IN)	SHEETING REMARKS	SIGN LEGEND	NEW SIGNS		EXISTING SIGNS			EXIST POST		NUMBER OF NEW POSTS	SQUARE STEEL (IN)			TUBULAR STEEL Ø (IN)				SIGN FRAME REQUIRED	REMARKS	SIGN DETAIL LOCATION																						
								"A"	"B"	RETAIN	SALVAGE FROM	SALVAGE TO	REMOVE	RETAIN		REMOVE	1.75	2.00	2.50	3.00	3.50	4.00			5.00	SHSM	PROJECT SHEET #	STANDARD SHEET #																			
																	(LB / FT)			(LB / FT)																											
NB BETHEL VT 12							FY-FLUORESCENT YELLOW FYG-FLUORESCENT YELLOW GREEN															"SHSM"-STANDARD HIGHWAY SIGNS AND MARKINGS																									
NB	0.000	C	VD-024	72	10			5.00						2	14.0'	14.0'	X								10																						
		C	VD-700	6	10			0.42																		E-138																					
		C	VD-700	6	10			0.42																		E-138																					
NB	0.389	A	W7-1	30	30			6.25						1	14.0'		X							X																							
NB	0.946	A	W5-2	30	30		NARROW BRIDGE			+											ALREADY REMOVED																										
NB	1.196	A	M2-1	21	15		JCT			1																																					
		A	M1-5	30	24		VT ROUTE 107			1																																					
NB	1.233	A	W3-1	36	36		STOP AHEAD			1																																					
NB	1.263	A	M3-1	24	12		NORTH			1																																					
		A	M1-5	24	24		VT ROUTE 12			1																																					
		A	M5-1R	21	15		RIGHT ARROW (90 DEG)			1																																					
NB	1.287	A	VD1-1A	72	12		<--- RUTLAND 30			1																																					
		A	VD1-1A	72	12		BETHEL 2 --->			1																																					
		A	VD1-1A	72	12		RANDOLPH 10 --->			1																																					
NB	1.337	A	M3-4	24	12		WEST (CONT. ON NEXT PAGE)			1																																					
SIGN SUMMARY SHEET								SHEET TOTALS		12.09	0.00	10	0	0	0	0	0	0	0	0	0	0	0	0	0	0	0	0	0																		
VERMONT AGENCY OF TRANSPORTATION								SF	SF	EA	EA	EA	EA	EA	EA	EA	EA	EA	EA	EA	EA	EA	EA	EA	EA	EA	EA	EA	EA																		
TOWN DIRECTIONAL TOTALS								210.3	0.0	27	1	1	38	0	0	45	675.0	0	0.0	0.0	0.0	0.0	0.0	0.0	0.0	0.0	0.0	0.0	0.0	0.0																	
PROJECT NAME: HARTLAND-BETHEL												PROJECT NUMBER: STPG SIGN (40)												FILE NAME: BETHEL VT ROUTE 12 NB												PLOT DATE: 8/1/2012											
DESIGNED BY: M. MILLER												CHECKED: AMY GAMBLE												DRAWN BY: M. MILLER												CHECKED: AMY GAMBLE											
BETHEL VT-12 NORTHBOUND 1												SHEET 69												OF 86																							