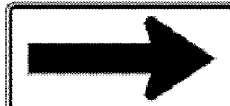


DIRECTION	MILEPOINT	LOCATION CODE (SHEET 2)	SIGN CODE	WIDTH (IN)	HEIGHT (IN)	SHEETING REMARKS	SIGN LEGEND	NEW SIGNS		EXISTING SIGNS			EXIST POST		NUMBER OF NEW POSTS	SQUARE STEEL (IN)			TUBULAR STEEL Ø (IN)				SIGN FRAME REQUIRED	REMARKS	SIGN DETAIL LOCATION			
								"A"	"B"	RETAIN	SALVAGE FROM	SALVAGE TO	REMOVE	RETAIN		REMOVE	1.75	2.00	2.50	3.00	3.50	4.00			5.00	SHSM	PROJECT SHEET #	STANDARD SHEET #
																	(LB / FT)			(LB / FT)								
NB BETHEL VT 12							FY-FLUORESCENT YELLOW FYG-FLUORESCENT YELLOW GREEN															"SHSM"-STANDARD HIGHWAY SIGNS AND MARKINGS						
NB	6.441	B	W1-6R	48	24		 (CONT.)	8.00						2	15.0' / 16.0' X										X			
SIGN SUMMARY SHEET							SHEET TOTALS	8.00	0.00	0	0	0	0	0	0	2	31.0 30.0	0	0.0	0.0	0.0	0.0						
VERMONT AGENCY OF TRANSPORTATION							TOWN DIRECTIONAL TOTALS	210.3	0.0	27	1	1	38	0	0	45	675.0	0		0.0								
															PROJECT NAME: HARTLAND-BETHEL													
															PROJECT NUMBER: STPG SIGN (40)													
															FILE NAME: BETHEL VT ROUTE 12 NB						PLOT DATE: 8/1/2012							
															PROJECT MANAGER: AMY GAMBLE						DRAWN BY: M. MILLER							
															DESIGNED BY: M. MILLER						CHECKED: AMY GAMBLE							
															BETHEL VT-12 NORTHBOUND 8						SHEET 76	OF 88						