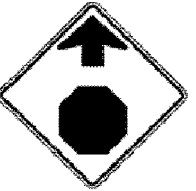
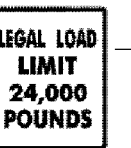
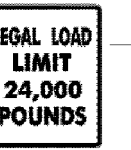



DIRECTION	MILEPOINT	LOCATION CODE (SHEET 2)	SIGN CODE	WIDTH (IN)	HEIGHT (IN)	SHEETING REMARKS	SIGN LEGEND	NEW SIGNS		EXISTING SIGNS			EXIST POST		NUMBER OF NEW POSTS	SQUARE STEEL (IN)			TUBULAR STEEL Ø (IN)				SIGN FRAME REQUIRED	REMARKS	SIGN DETAIL LOCATION				
								"A"	"B"	RETAIN	SALVAGE FROM	SALVAGE TO	REMOVE	RETAIN		REMOVE	1.75	2.00	2.50	FOUNDATION	3.00	3.50			4.00	5.00	SHSM	PROJECT SHEET #	STANDARD SHEET #
SB BETHEL VT 12							FY-FLUORESCENT YELLOW FYG-FLUORESCENT YELLOW GREEN																"SHSM"-STANDARD HIGHWAY SIGNS AND MARKINGS						
SB	4.060	G	W3-1	36	36		STOP AHEAD SYMBOL																						
		F	D3-1	24	10		CAMP BROOK RD ROCHESTER 10																						
		G	W3-1	36	36			9.00																					
SB	4.060	H	R1-1	30	30		STOP																						
		F	D3-1	60	12		Camp Brook Rd <span style="border: 1px solid red; padding: 2px;">0120 1404 0406</span>	5.00																					
		H	R1-1	30	30		STOP	6.25																					
SB	4.049	G	VR-017	24	30																								
		G	VR-017	24	30			5.00																					
SB	4.025	F	D3-1	24	10		CAMP BROOK RD ROCHESTER 10																						
		F	D3-1	60	12		Camp Brook Rd	5.00																					
SB	4.024	G	VR-017	24	30																								
		G	VR-017	24	30			5.00																					
SB	4.013	H	R1-1	30	30																								
		H	R1-1	30	30		STOP <span style="border: 1px solid red; padding: 2px;">0120 1404 0401</span>	6.25																					
SB	3.998	F	W1-2R	30	30		RIGHT CURVE (CONT. ON NEXT PAGE)																						
<b>SIGN SUMMARY SHEET</b>								<b>SHEET TOTALS</b>		41.50	0.00	0	2	2	9	0	0	9	136.0	0	0.0	0.0	0.0	0.0	0.0	0.0			
								35.25		SF	SF	EA	EA	EA	EA	EA	EA	EA	EA	EA	EA	EA	EA	EA	EA	EA			
VERMONT AGENCY OF TRANSPORTATION								TOWN DIRECTIONAL TOTALS		237.8	0.0	8	9	9	52	0	0	53	795.0	0	0.0	0.0	0.0	0.0	0.0	0.0			
												PROJECT NAME: HARTLAND-BETHEL				PROJECT NUMBER: STPG SIGN (40)				FILE NAME: BETHEL VT ROUTE 12 SB				PLOT DATE: 8/1/2012					
																				PROJECT MANAGER: AMY GAMBLE				DRAWN BY: M. MILLER					
																				DESIGNED BY: M. MILLER				CHECKED BY: AMY GAMBLE					
																				BETHEL VT-12 SOUTHBOUND 4				SHEET 80 OF 85					