



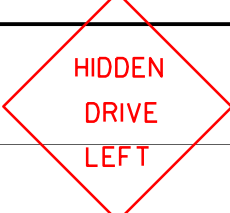


DIRECTION	MILEPOINT	LOCATION CODE (SHEET 2)	SIGN CODE	WIDTH (IN)	HEIGHT (IN)	SHEETING REMARKS	SIGN LEGEND	NEW SIGNS		EXISTING SIGNS			EXIST POST		NUMBER OF NEW POSTS	SQUARE STEEL (IN)			TUBULAR STEEL Ø (IN)				SIGN FRAME REQUIRED	REMARKS	SIGN DETAIL LOCATION				
								"A"	"B"	RETAIN	SALVAGE FROM	SALVAGE TO REMOVE	RETAIN	REMOVE		1.75	2.00	2.50	(LB / FT)						SHSM	PROJECT SHEET #	STANDARD SHEET #		
																			3.00	3.50	4.00	5.00							
SB BETHEL VT 12							FY-FLUORESCENT YELLOW FYG-FLUORESCENT YELLOW GREEN															"SHSM"-STANDARD HIGHWAY SIGNS AND MARKINGS							
SB	1.263	F	R2-1	24	30																		SIGN AND POST MISSING						
		F	R2-1	24	30			0.00 5.00																	X				
SB	1.154	F	W5-2	30	30		NARROW BRIDGE			0 +													SIGN WAS ALREADY REMOVED.	THE ONGOING BRIDGE PROJECT JUST AHEAD WILL REMOVE THIS SIGN AFTER THAT PROJECT IS COMPLETED IN LATE 2012					
SB	0.895	G	VR-017	24	30																			1	X				
		G	VR-017	24	30			5.00																1		X		6	
SB	0.891	F	D3-1	24	5		OLD ROUTE 12																	1	X				
		F	D3-1	54	12			4.50																2			X		13
SB	0.891	H	R1-1	30	30																			1	X				
		H	R1-1	30	30			6.25																0 +		X			X
SB	0.000	G	VD-024	60	7.5		BARNARD I BETHEL																	1	X				
		G	VD-700	6	8		0120 / 1404 / 0000 (BETHEL MM)																	1					
		G	VD-700	6	8		0120 / 1403 / 0962 (BARNARD MM)																	1					
SB	1.127	F	VW-054L	30	30																			1	X				
SIGN SUMMARY SHEET							SHEET TOTALS	15.75 20.75	0.00	1	0	0	6	0	0	5	42.0 75.0	0	0.0	0.0	0.0	0.0							
VERMONT AGENCY OF TRANSPORTATION							TOWN DIRECTIONAL TOTALS	237.8	0.0	8	9	9	52	0	0	53	795.0	0											
															PROJECT NAME:	HARTLAND-BETHEL													
															PROJECT NUMBER:	STPG SIGN (40)													
															FILE NAME:	BETHEL VT ROUTE 12 SB													
															PROJECT MANAGER:	AMY GAMBLE													
															DESIGNED BY:	M. MILLER													
																BETHEL VT-12 SOUTHBOUND 8													
															PLOT DATE:	8/1/2012													
															DRAWN BY:	M. MILLER													
															CHECKED:	AMY GAMBLE													
															SHEET:	84 OF 86													