


STATE OF VERMONT AGENCY OF TRANSPORTATION

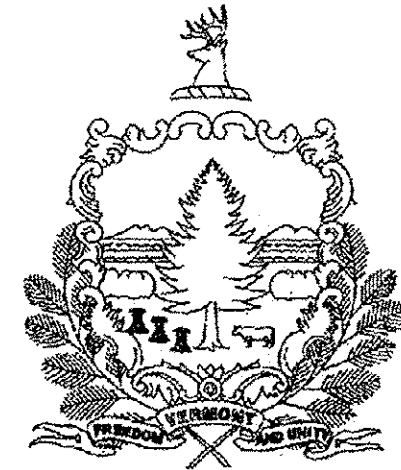

PROPOSED IMPROVEMENT SIGN REPLACEMENT PROJECT

TOWNS OF HARTLAND, WOODSTOCK, POMFRET, BARNARD AND BETHEL COUNTY OF WINDSOR VT ROUTE 12 (MAJOR COLLECTOR)




BEGINNING IN THE TOWN OF HARTLAND AT THE INTERSECTION OF VT ROUTE 12 AND US ROUTE 5 AT MILE MARKER 0.000 AND EXTENDING NORTHERLY ALONG VT ROUTE 12 FOR 7.705 MILES TO A STOPPING POINT AT THE INTERSECTION OF US ROUTE 4 AT MILE MARKER 7.705; RESUMING IN THE TOWN OF WOODSTOCK ON VT ROUTE 12 (EXCLUDES THE CLASS 1 SECTION OF VT ROUTE 12 IN WOODSTOCK) AT THE BEGINNING OF THE STATE HIGHWAY LIMITS AT MILE MARKER 0.710 AND EXTENDING NORTHERLY 20.353 MILES THROUGH THE TOWNS OF WOODSTOCK, POMFRET, BARNARD AND BETHEL (EXCLUDES 1.847 MILES CO-JOINED ALONG VT ROUTE 107 IN BETHEL AND EXCLUDES THE CLASS 1 SECTION OF VT ROUTE 12 IN BETHEL) TO THE BETHEL-RANDOLPH TOWN LINE.

LENGTH OF ROADWAY = 29.731 MILES
LENGTH OF PROJECT = 28.058 MILES

WORK TO BE PERFORMED UNDER THIS PROJECT INCLUDES THE REMOVAL OF EXISTING SIGNS AND POSTS AND THE INSTALLATION OF NEW SIGNS, SIGN POSTS AND OTHER RELATED HIGHWAY ITEMS.

RECORD PLANS	
CONTRACTOR:	L&D SAFETY MARKINGS CORP.-BERLIN, VT
RESIDENT ENGINEER:	MARK HAUGHWOUT
CONSTRUCTION BEGAN:	APRIL 15, 2013
CONSTRUCTION COMPLETE:	JULY 12, 2013
RECORD PLANS BY:	MARK HAUGHWOUT & CRAIG PIERCE
I HEREBY CERTIFY THAT ALL THE CONSTRUCTION REQUIRED BY THIS SET OF DRAWINGS HAS BEEN ACCOMPLISHED AS INDICATED HEREIN.	
BY	<i>Mark W. Haughwout</i> RESIDENT ENGINEER
DATE	3/12/14
NOTE: Any further information concerning final quantities, amounts or other details relative to this project may be found at Central Files in the electronic archives.	

VT ROUTE 12	HARTLAND	-	7.705	MILES
	WOODSTOCK	-	3.298	MILES
	POMFRET	-	1.383	MILES
	BARNARD	-	9.615	MILES
	BETHEL	-	6.057	MILES
LENGTH OF PROJECT	=		28.058	MILES

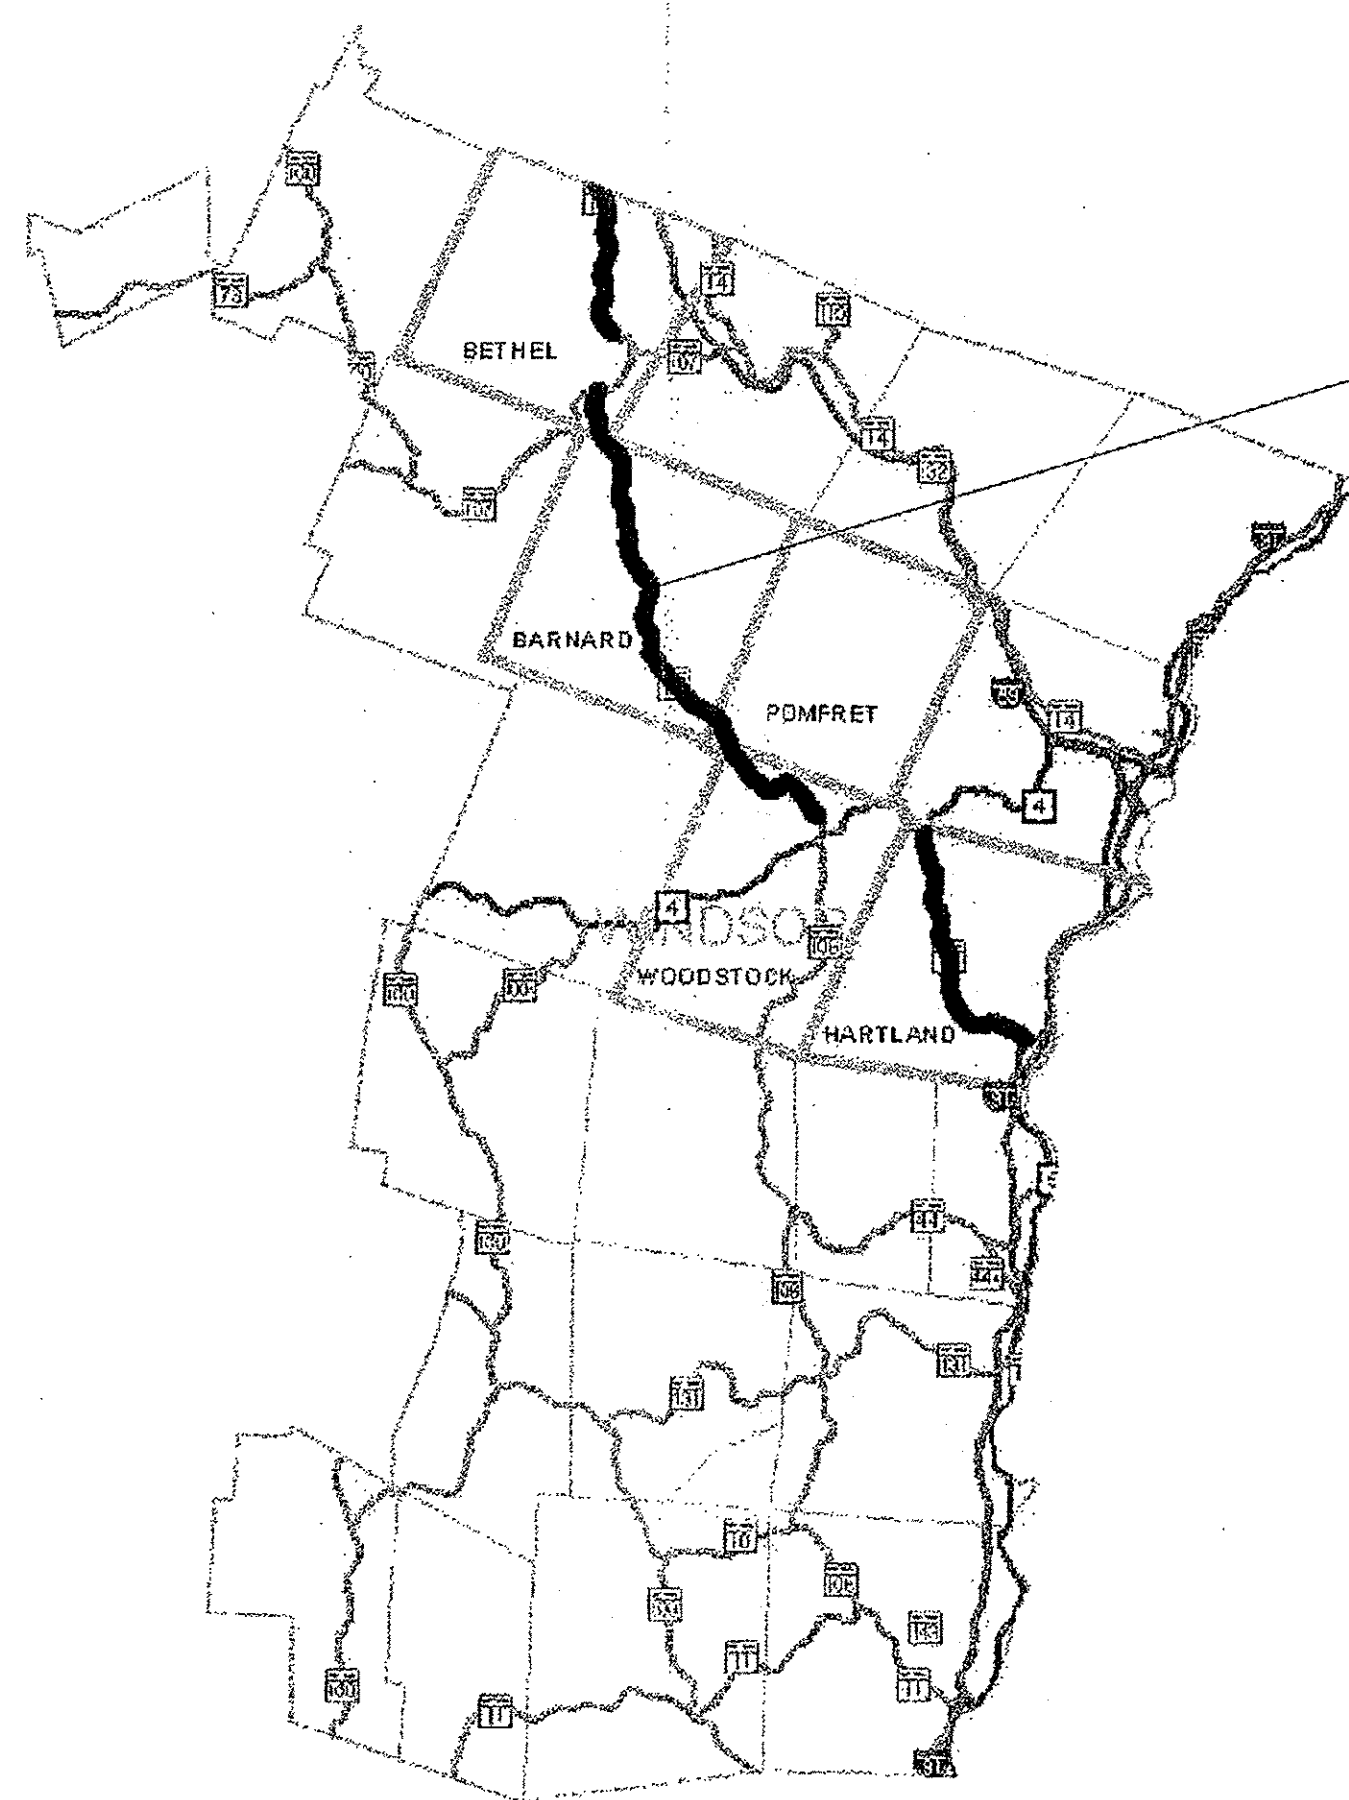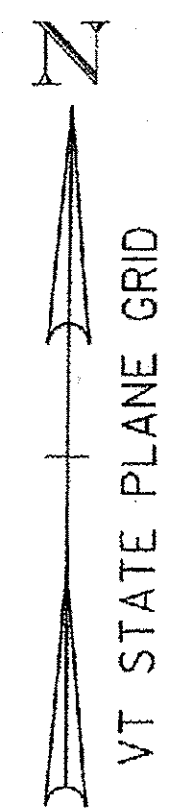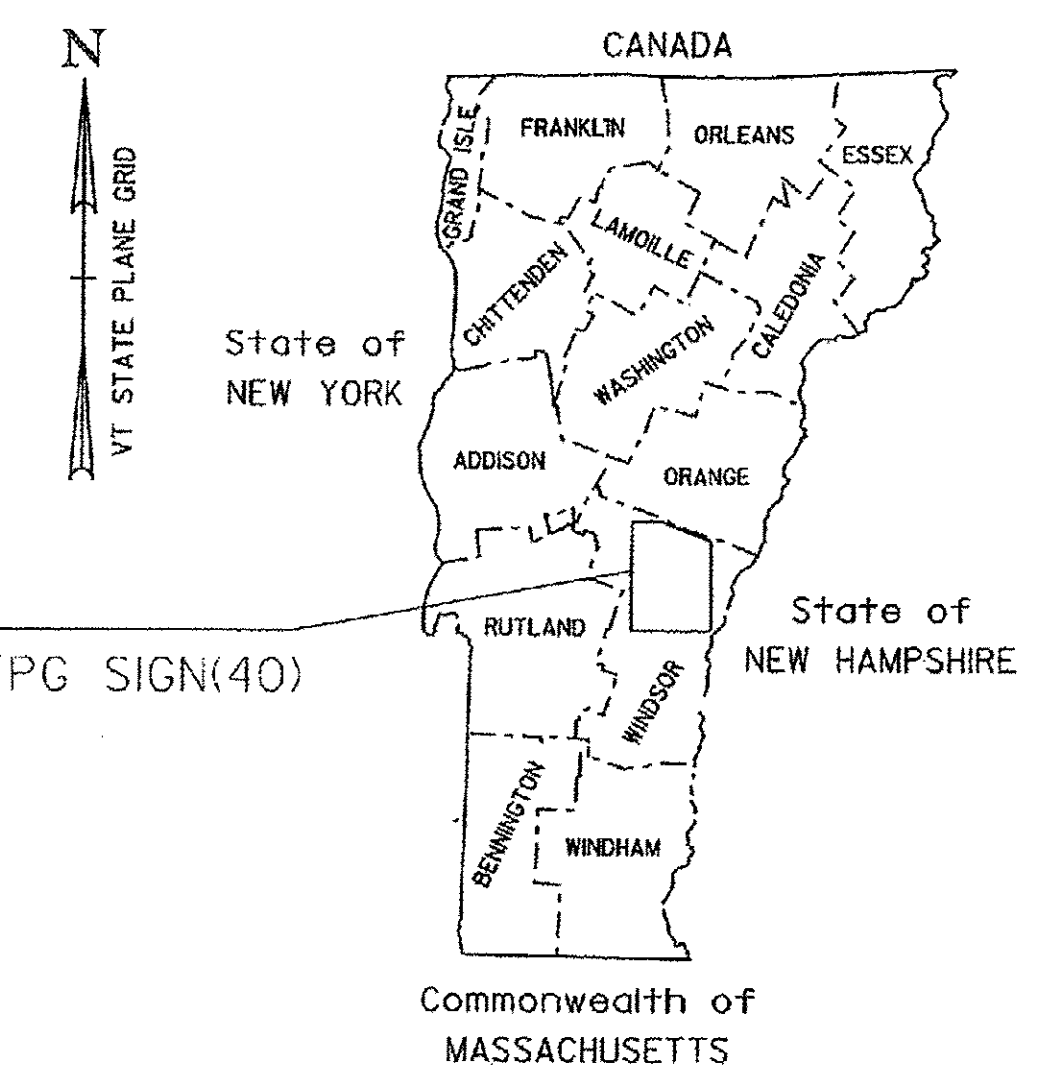

VT ROUTE 12 PROJECT LOCATIONS:

HARTLAND	MM 0.000-7.705
WOODSTOCK	MM 0.710-4.008 (EXCLUDES CLASS 1, MM 0.000-0.710)
POMFRET	MM 0.000-1.383
BARNARD	MM 0.000-9.615
BETHEL	MM 0.000-7.019 (EXCLUDES CLASS 1, MM 1.383-2.345) (EXCLUDES 1.847 MILES CO-LOCATED WITH VT ROUTE 107 IN BETHEL)

QUALITY ASSURANCE PROGRAM: LEVEL 3

CONVENTIONAL SYMBOLS	
COUNTY LINE	
TOWN LINE	
LIMITS OF ACCESS	
POINT OF ACCESS	
FENCE LINE	
STONE WALL	
TRAVELED WAY	
GUARD RAIL	
RAILROAD	
SURVEY LINE	
CULVERT	
POWER POLE	
TELEPHONE POLE	
TREES	
CONTROL OF ACCESS	
PROPERTY LINE	
R.O.W. TAKING LINE	
SLOPE RIGHTS	
TOP OF CUT	
TOE OF SLOPE	

SURVEYED BY :	N/A
SURVEYED DATE :	N/A
DATUM	
VERTICAL	N/A
HORIZONTAL	N/A

NOT TO SCALE

THESE PLANS ARE SUBJECT TO SUCH ENGINEERING CHANGES AS MAY BE REQUIRED BY THE FEDERAL HIGHWAY ADMINISTRATION OR THE DIRECTOR OF PROGRAM DEVELOPMENT.

CONSTRUCTION IS TO BE CARRIED ON IN ACCORDANCE WITH THESE PLANS AND THE STANDARD SPECIFICATIONS FOR CONSTRUCTION DATED 2011, AS APPROVED BY THE FEDERAL HIGHWAY ADMINISTRATION ON JULY 20, 2011 FOR USE ON THIS PROJECT, INCLUDING ALL SUBSEQUENT REVISIONS AND SUCH REVISED SPECIFICATIONS AND SPECIAL PROVISIONS AS ARE INCORPORATED IN THESE PLANS.

DIRECTOR OF PROGRAM DEVELOPMENT	
APPROVED <i>Richard Johnson</i>	DATE 8/6/12
PROJECT MANAGER : AMY GAMBLE	
PROJECT NAME :	HARTLAND-BETHEL
PROJECT NUMBER :	STPG SIGN (40)
SHEET 1 OF 85 SHEETS	

INDEX OF SHEETS:

1	TITLE SHEET
2	PROJECT NOTES
3	QUANTITY SHEET I
4-14	SIGN DETAILS
15-25	HARTLAND VT-12 NORTHBOUND TRAFFIC SIGN SUMMARY SHEETS
26-34	HARTLAND VT-12 SOUTHBOUND TRAFFIC SIGN SUMMARY SHEETS
35-39	WOODSTOCK VT-12 NORTHBOUND TRAFFIC SIGN SUMMARY SHEETS
40-44	WOODSTOCK VT-12 SOUTHBOUND TRAFFIC SIGN SUMMARY SHEETS
45	POMFRET VT-12 NORTHBOUND TRAFFIC SIGN SUMMARY SHEETS
46-47	POMFRET VT-12 SOUTHBOUND TRAFFIC SIGN SUMMARY SHEETS
48-56	BARNARD VT-12 NORTHBOUND TRAFFIC SIGN SUMMARY SHEETS
57-68	BARNARD VT-12 SOUTHBOUND TRAFFIC SIGN SUMMARY SHEETS
69-76	BETHEL VT-12 NORTHBOUND TRAFFIC SIGN SUMMARY SHEETS
77-84	BETHEL VT-12 SOUTHBOUND TRAFFIC SIGN SUMMARY SHEETS
85	TOWN TOTAL SIGN SUMMARY SHEET

STANDARDS:

E-121	STANDARD SIGN PLACEMENT CONVENTIONAL ROAD	08/08/1995
E-136B	STATE ROUTE MARKER SIGN DETAILS	08/08/1995
E-138	MILE MARKER DETAILS STATE AND TOWN HIGHWAYS	05/30/2003
E-164	SQUARE STEEL SIGN POST	06/08/2009

**2-1/2" SOIL BEARING SLIP BASE LOCATIONS
(ITEM 900.620 SPECIAL PROVISION):**

TOWN:	DIRECTION:	MILE POINT:	NO. REQ.:	SHEET:
HARTLAND	NB	7.602	2	23
HARTLAND	NB	7.664	2	24
HARTLAND	SB	7.682	2	26

- THE LOCATIONS SHOWN IN THE TABLE ABOVE WILL REQUIRE THAT EACH 2-1/2" SQUARE STEEL SIGN POST, AS SPECIFIED ON THE APPLICABLE SIGN SUMMARY SHEET, BE INSTALLED USING A SOIL BEARING SLIP BASE WITH ANCHOR SLEEVE. AT THESE SPECIFIED LOCATIONS THE 2-1/2" POSTS ARE NOT PROTECTED BY GUARD RAIL OR CURBING, THUS REQUIRING THE USE OF SOIL BEARING SLIP BASES FOR THIS SIZE POST.
- PAYMENT FOR SOIL BEARING SLIP BASE (EACH) WILL BE MADE UNDER CONTRACT ITEM 900.620 SPECIAL PROVISION (SOIL BEARING SLIP BASE) (2-1/2").

TEMPORARY TRAFFIC CONTROL NOTES:

- THE CONTRACTOR SHALL SUBMIT A SITE-SPECIFIC TRAFFIC CONTROL PLAN CONFORMING TO THE MANUAL ON UNIFORM TRAFFIC CONTROL DEVICES (MUTCD), DATED 2009, AND ITS LATEST REVISIONS, TO THE ENGINEER AT THE PRE-CONSTRUCTION MEETING, FOR REVIEW AND APPROVAL BY THE ENGINEER.
- WHEN WORKING IN THE VICINITY OF EXISTING PEDESTRIAN FACILITIES, AMERICAN WITH DISABILITIES ACT (A.D.A.) ACCESSIBLE PEDESTRIAN ACCOMMODATIONS SHALL BE MAINTAINED AT ALL TIMES. PAYMENT SHALL BE INCLUDED IN THE UNIT BID PRICE FOR CONTRACT ITEM 641.10 TRAFFIC CONTROL.
- THE CONTRACTOR SHALL PROVIDE ACCESS THROUGH THE WORK ZONE FOR EMERGENCY VEHICLES AT ALL TIMES.
- THE CONTRACTOR SHALL CONDUCT THE WORK AT ALL TIMES IN SUCH A MANNER AND IN SUCH SEQUENCE SO AS TO ENSURE THAT THE LEAST INTERFERENCE WITH TRAFFIC OCCURS.
- TEMPORARY TRAFFIC CONTROL SIGNS SHALL ONLY BE VISIBLE TO MOTORISTS AT THE TIMES WHEN THE MESSAGE IS PERTINENT, I.E. A "FLAGGER AHEAD" SIGN SHALL ONLY BE VISIBLE TO MOTORISTS WHEN THE FLAGGER IS ACTUALLY PRESENT AND PERFORMING THEIR DUTIES.
- PAYMENT FOR CONSTRUCTION SIGNING WILL BE MADE UNDER CONTRACT ITEM 641.10 TRAFFIC CONTROL.
- TEMPORARY TRAFFIC CONTROL SIGNS SHALL BE MOVED AS THE WORK AREA MOVES. AT NO TIME SHALL THE FLAGGER SIGN BE GREATER THAN 1000 FEET IN ADVANCE OF THE FLAGGER STATION.

SIGN DESIGN AND FABRICATION:

- THE MANUAL ON UNIFORM TRAFFIC CONTROL DEVICES (MUTCD) SIGN CODES PROVIDED IN THESE PLANS REFER TO THE 2009 MUTCD. DESIGN DETAILS FOR SIGNS INDICATED ON THE PLANS, AS FOUND IN THE STANDARD HIGHWAY SIGNS AND MARKINGS BOOK (SHSM), SHALL BE PER THE 2004 SHSM AND THE 2012 SUPPLEMENT TO THE 2004 EDITION.
- SIGN SHEETING FOR FLUORESCENT YELLOW (FY) AND FLUORESCENT YELLOW-GREEN (FYG) SHALL BE ASTM D4956 TYPE VII, VIII OR IX. ALL OTHER SIGN SHEETING SHALL BE TYPE III OR IV.
- SHEETING TYPES AND SHEETING FABRICATED BY DIFFERENT MANUFACTURERS SHALL NOT BE MIXED ON A SINGLE SIGN ASSEMBLY. SHEETING COLOR/TYPE SHOULD BE BY THE SAME MANUFACTURER AND SHOULD BE CONSISTENT THROUGHOUT THE PROJECT.
- SIGN BASE MATERIAL FOR ALL STREET NAME SIGNS SHALL BE EITHER 0.125 INCH THICK FLAT SHEET ALUMINUM OR EXTRUDED ALUMINUM WITH A 0.250 INCH THICK FLANGE AND 0.090 INCH MINIMUM WEB THICKNESS.
- UNLESS OTHERWISE NOTED ON THE PLANS, ALL SIGNS SHALL BE FLAT SHEET ALUMINUM WITH THE FOLLOWING MINIMUM THICKNESSES:

SIGN SIZE	12" X 12"		
	18" X 18"		
21" X 15"			
24" X 8"			
24" X 10"		48" X 18"	
24" X 12"	36" X 12"	48" X 24"	
24" X 18"	36" X 15"	48" X 30"	
24" X 24"	36" X 18"	48" X 42"	
24" X 30"	36" X 24"	48" X 48"	
30" X 15"	36" X 36"	48" X 60"	
30" X 18"	36" X 42"	72" X 10"	
30" X 30"	36" X 48"	72" X 12"	
30" X 42"	36" X 54"	72" X 20"	
THICKNESS	0.080"	0.100"	0.125"

SIGN POSTS:


- ALL SQUARE STEEL SIGN POSTS SHALL BE INSTALLED IN A NEW ANCHOR. ALL SIGNS INSTALLED IN PAVED OR CONCRETE ISLANDS OR SIDEWALKS SHALL ALSO BE INSTALLED WITH AN 18" SLEEVE. PAYMENT FOR SLEEVE SHALL BE INCIDENTAL TO CONTRACT ITEM 675.341 SQUARE TUBE SIGN POST AND ANCHOR.
- THE 1.75" SQUARE STEEL POSTS SHALL BE 14 GAGE STEEL. THE 2.0" AND 2.5" SQUARE STEEL POSTS SHALL BE 12 GAGE STEEL.

SIGN INSTALLATION:

- THE CONTRACTOR SHALL BE RESPONSIBLE FOR REPAIRING ANY DAMAGE TO PRIVATE OR PUBLIC PROPERTY CAUSED BY THE CONTRACTOR, AT THE CONTRACTOR'S EXPENSE AND AT NO EXPENSE TO THE STATE.
- ALL SIGNS WITHIN THE PROJECT LIMITS ARE TO BE REPLACED, UNLESS OTHERWISE NOTED ON THE PLANS OR AS DIRECTED BY THE ENGINEER. SIGN LOCATIONS AS SHOWN ON THE PLANS ARE APPROXIMATE; EXACT LOCATIONS TO BE DETERMINED IN THE FIELD.
- ALL SIGN PLACEMENT SHALL BE IN CONFORMANCE WITH VAOT STANDARD E-121 STANDARD SIGN PLACEMENT CONVENTIONAL ROADS, UNLESS OTHERWISE NOTED.
- ALL SIGNS, FRAMES, MOUNTING HARDWARE, POSTS, AND ANCHORS FOR ANY SIGN ASSEMBLY SHALL BE REPLACED AT THE SAME TIME. MIXING OF OLD AND NEW SIGNS ON THE SAME ASSEMBLY WILL NOT BE ALLOWED.
- NEW SIGNS, WITH THEIR GREATER NIGHTTIME RETROREFLECTIVITY, CAN OBSCURE OLDER SIGNS MOUNTED IN CLOSE PROXIMITY TO THEM. TO AVOID CONFUSION OF ROAD USERS, WORK SHALL BE COORDINATED SUCH THAT ALL SIGNS ASSOCIATED WITH A CURVE, INTERSECTION OR SPEED LIMIT CHANGE SHALL BE REPLACED ON THE SAME DAY AND NOT LEFT INCOMPLETE OR WITH A MIXTURE OF OLD AND NEW SIGNS WITHIN A GROUP OF ASSOCIATED SIGNS.
- ALL NEW SIGN INSTALLATIONS, IF NEAR A UTILITY POLE, SHALL BE NO CLOSER THAN 10 FEET FROM THE UTILITY POLE.

STREET NAME SIGN INSTALLATION:

- SIDE ROAD STREET NAME SIGNS, COMMONLY INSTALLED PERPENDICULAR TO APPROACHING MAINLINE TRAFFIC, SHALL BE POSITIONED IN SUCH A WAY AS TO ENSURE THE BEST POSSIBLE VISIBILITY TO APPROACHING MAINLINE TRAFFIC FROM EACH DIRECTION. IN MOST CASES, STREET NAME SIGNS MAY BE INSTALLED ABOVE THE SIDE ROAD STOP SIGN. IN CASES WHERE THE SIDE ROAD STOP SIGN POSITION WOULD NOT BE SUITABLE FOR A TOP-MOUNTED STREET NAME SIGN, OR OTHER SITE-SPECIFIC CONSTRAINTS, THE STREET NAME SIGN MAY BE INSTALLED INDEPENDENTLY ON EITHER CORNER OF THE INTERSECTION. THE STREET NAME SIGNS SHALL BE INSTALLED A MINIMUM OF SIX FEET FROM THE EDGE OF PAVEMENT ON THE MAINLINE ROUTE TO THE NEAREST EDGE OF THE SIGN.
- STREET NAME SIGNS WITH A LENGTH EXCEEDING 42-INCHES SHALL BE INSTALLED ON TWO POSTS. UNLESS PROTECTED BY BARRIER, THIS TWO POST SIGN ASSEMBLY SHALL BE LATERALLY OFFSET A MINIMUM OF TWO FEET (IN THE DIRECTION OF MAINLINE TRAFFIC) FROM ANY OTHER SIGN POST; NO MORE THAN TWO POSTS SHALL OCCUPY AN EIGHT FOOT TRAVEL PATH, UNLESS PROTECTED BY BARRIER.
- TOP-MOUNTED STREET NAME SIGNS SHALL REQUIRE 12-INCH MOUNTING BRACKETS. ALL MOUNTING HARDWARE IS INCIDENTAL TO PAY ITEM 675.20 (TRAFFIC SIGN, TYPE A).
- IF EXISTING STREET NAME SIGNS ARE SALVAGED THEY SHALL BE RE-INSTALLED PER THE ABOVE NOTES OR AS DIRECTED BY THE ENGINEER.
- STREET NAME SIGNS FOR PRIVATE ROADS SHALL BE RETAINED, UNLESS OTHERWISE NOTED OR AS DIRECTED BY THE ENGINEER.

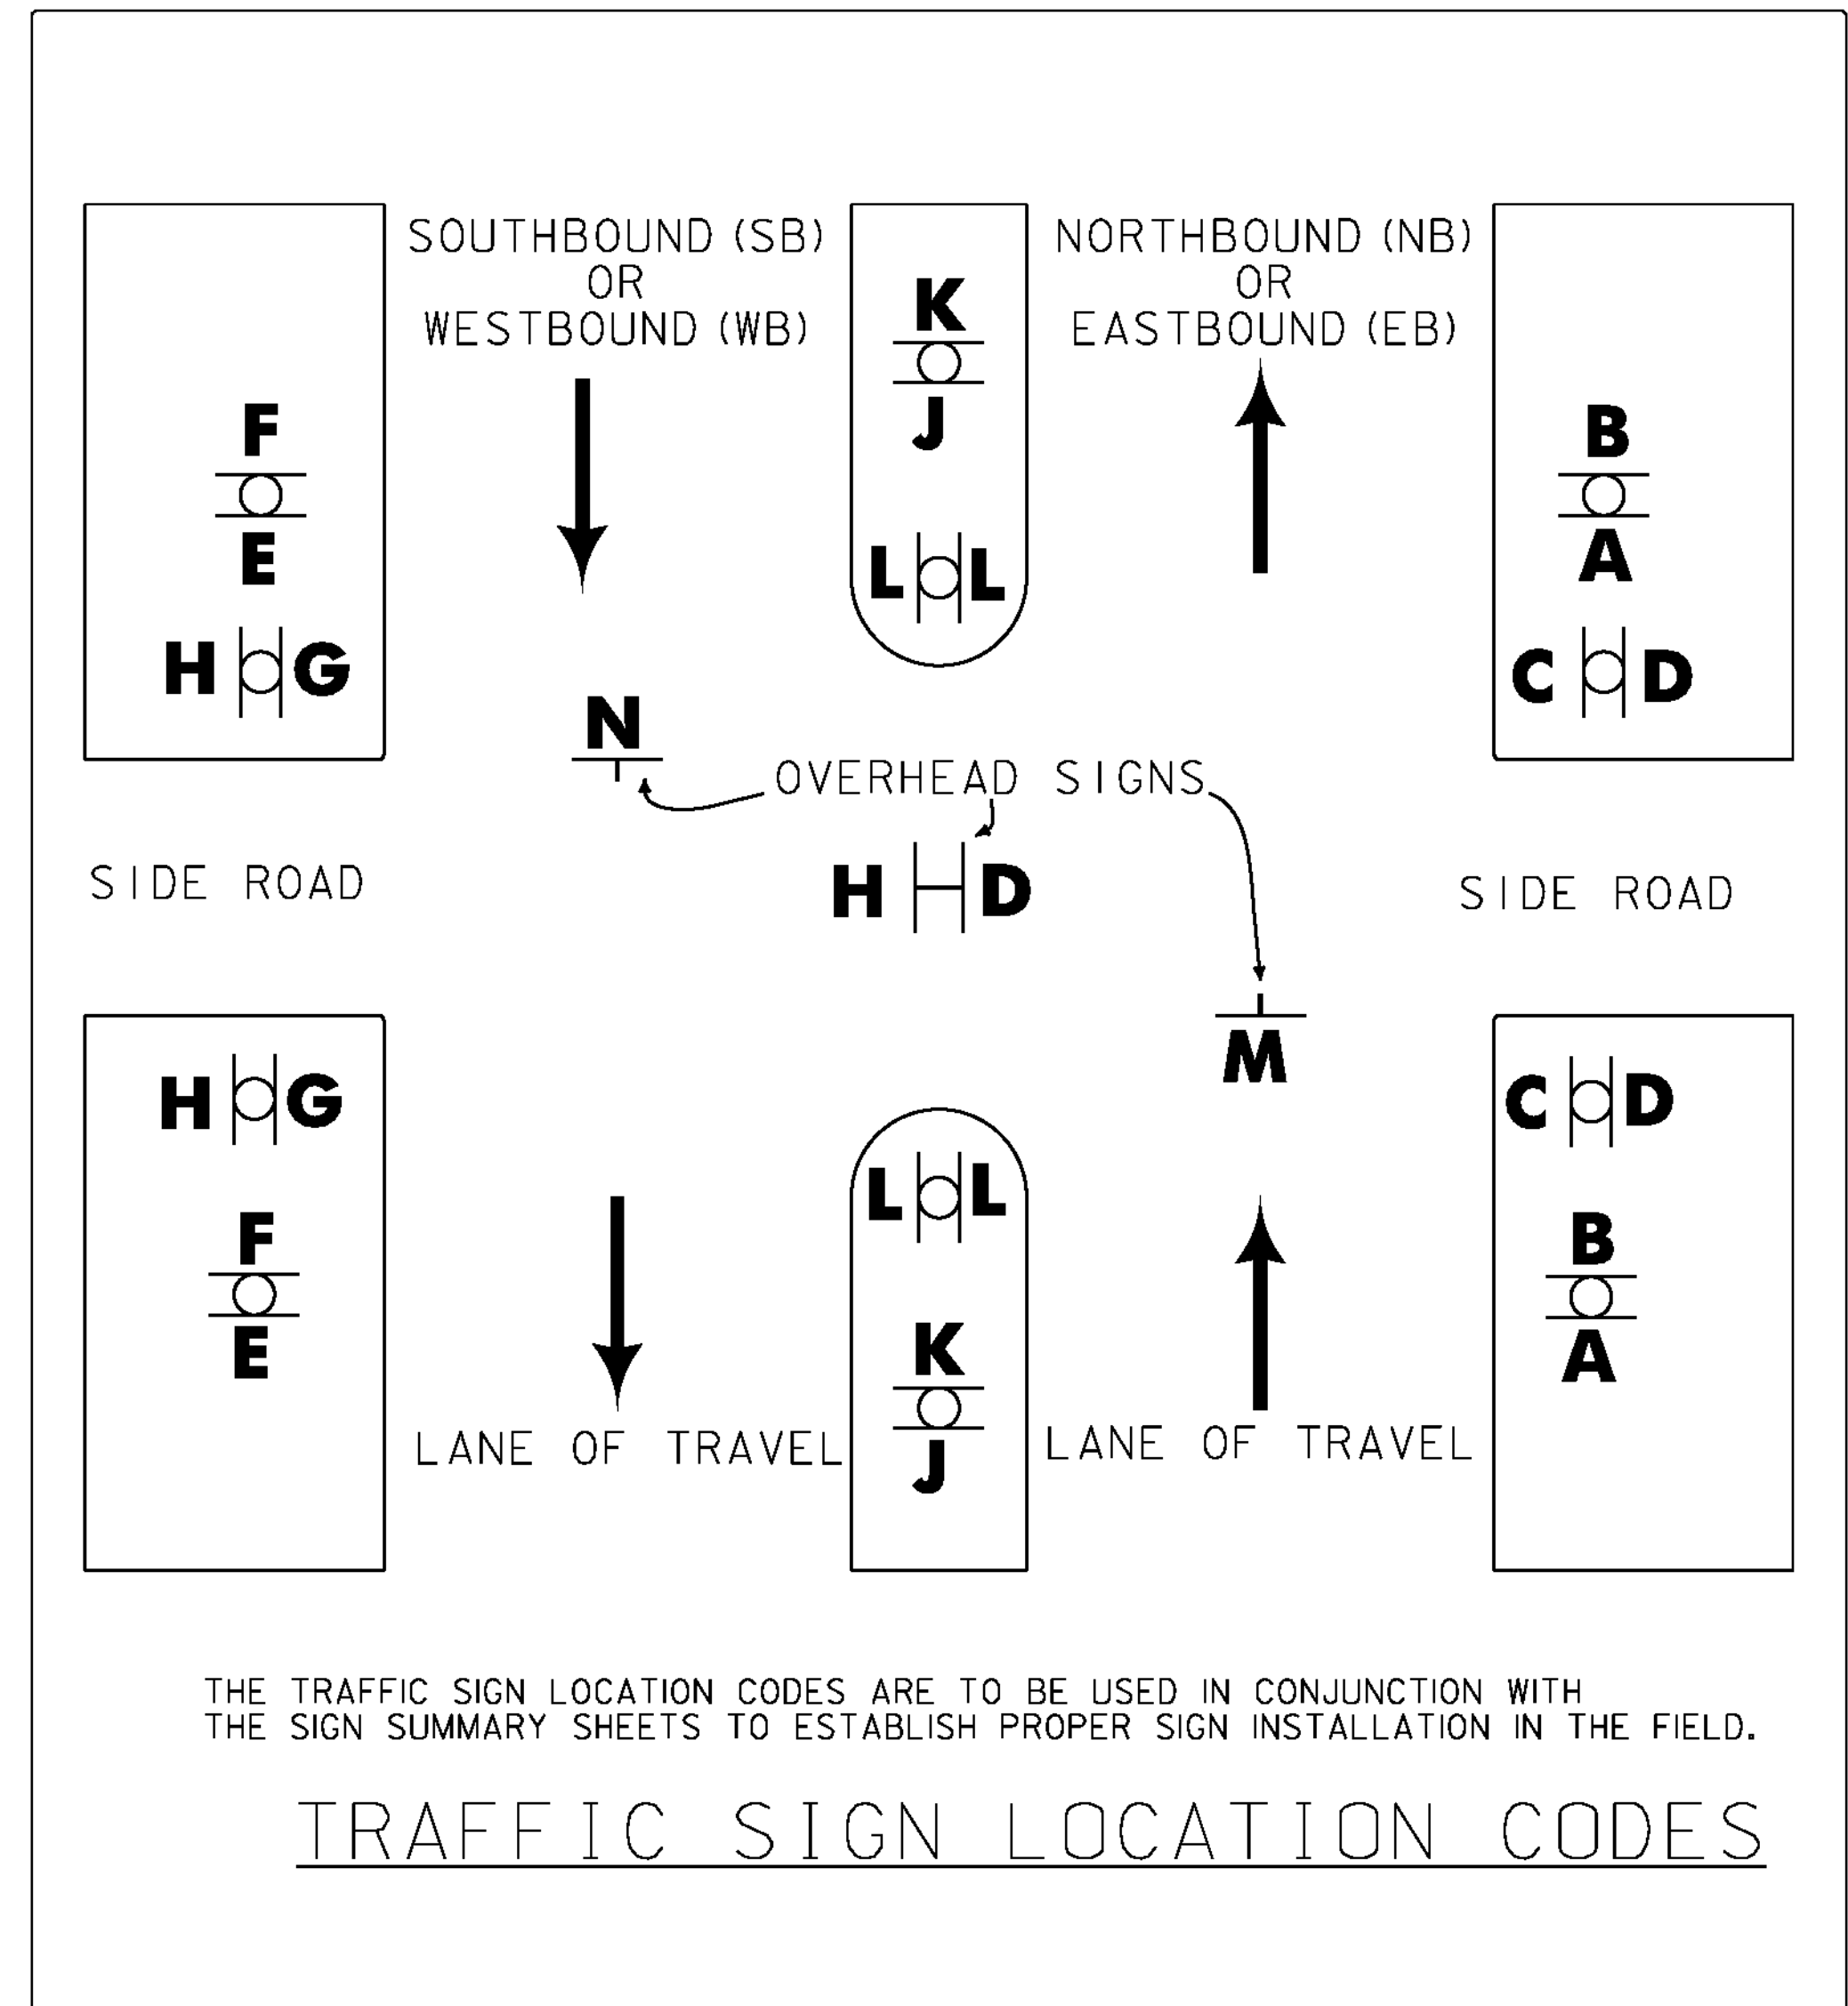

GENERAL NOTES:


- EXISTING STAND-ALONE MILE MARKER SIGNS, OR MILE MARKER SIGNS ATTACHED TO A RETAINED SIGN POST ASSEMBLY, SHALL BE RETAINED.
- EXISTING MILE MARKER SIGNS ON SIGN POSTS BEING REPLACED SHALL BE REMOVED AND SALVAGED ONTO THE NEW SIGN POST, UNLESS OTHERWISE NOTED ON THE APPLICABLE SIGN SUMMARY SHEET OR AS DIRECTED BY THE ENGINEER.
- EXISTING MILE MARKER SIGNS ATTACHED TO A SIGN ASSEMBLY THAT IS TO BE REMOVED OR RELOCATED SHALL BE REMOVED AND DISPOSED OF, UNLESS OTHERWISE NOTED ON THE APPLICABLE SIGN SUMMARY SHEET OR AS DIRECTED BY THE ENGINEER.
- ESTIMATED QUANTITIES OF CONTRACT ITEMS 675.50 REMOVING SIGNS AND 675.60 ERECTING SALVAGED SIGNS HAVE BEEN INCLUDED FOR MILE MARKER AND STREET NAME SIGNS.
- SELECTIVE CUTTING OF BRUSH OR TREE BRANCHES IN THE IMMEDIATE VICINITY OF A SIGN MAY BE NECESSARY TO PROVIDE FULL VISIBILITY FOR ANY EXISTING (RETAINED) OR NEW SIGN LOCATION. THIS WORK WILL BE PERFORMED AT THE DIRECTION OF THE ENGINEER AND PAID FOR UNDER CONTRACT ITEM 201.31 THINNING AND TRIMMING FOR SIGNS. THIS WORK SHALL BE DONE AT THE SAME TIME THE SIGN IS INSTALLED, OR AS DIRECTED BY THE ENGINEER.

PROJECT NAME:	HARTLAND - BETHEL	PLOT DATE:	01-AUG-2012
PROJECT NUMBER:	STPG SIGN (40)	DRAWN BY:	M. MILLER
FILE NAME:	I2C116.GN	CHECKED BY:	A. GAMBLE
PROJECT LEADER:	A. GAMBLE	DESIGNED BY:	M. MILLER
PROJECT NOTES		SHEET 2	OF 85


QUANTITY SHEET 1

SUMMARY OF ESTIMATED QUANTITIES												TOTALS		DESCRIPTIONS				DETAILED SUMMARY OF QUANTITIES		
											ROADWAY	GRAND TOTAL	FINAL	UNIT	ITEMS	ITEM NUMBER	ROUND	QUANTITIES	UNIT	ITEMS
											35	35		EACH	THINNING AND TRIMMING FOR SIGNS	201.31	EST			
											1	1		CY	TRENCH EXCAVATION OF EARTH, EXPLORATORY (N.A.B.I.)	204.22				
											50	50		HR	UNIFORMED TRAFFIC OFFICERS	630.10	EST			
											650	650		HR	FLAGGERS	630.15	EST			
											1	1		LS	MOBILIZATION/DEMOBILIZATION	635.11				
											1	1		LS	TRAFFIC CONTROL	641.10				
											2141.2	2141.2		SF	TRAFFIC SIGNS, TYPE A	675.20				
											6225	6225		LF	SQUARE TUBE SIGN POST AND ANCHOR	675.341	EST			
											458	458		EACH	REMOVING SIGNS	675.50	EST			
											51	51		EACH	ERECTING SALVAGED SIGNS	675.60	EST			
											6	6		EACH	SPECIAL PROVISION (SOIL BEARING SLIP BASE)(2 1/2")	900.620				

PROJECT NAME: HARTLAND - BETHEL
 PROJECT NUMBER: STPG SIGN (40)
 FILE NAME: I2CI16.QS
 PROJECT LEADER: A. GAMBLE
 DESIGNED BY: M. MILLER
 QUANTITY SHEET 1
 PLOT DATE: 01-AUG-2012
 DRAWN BY: M.MILLER
 CHECKED BY: A. GAMBLE
 SHEET 3 OF 85

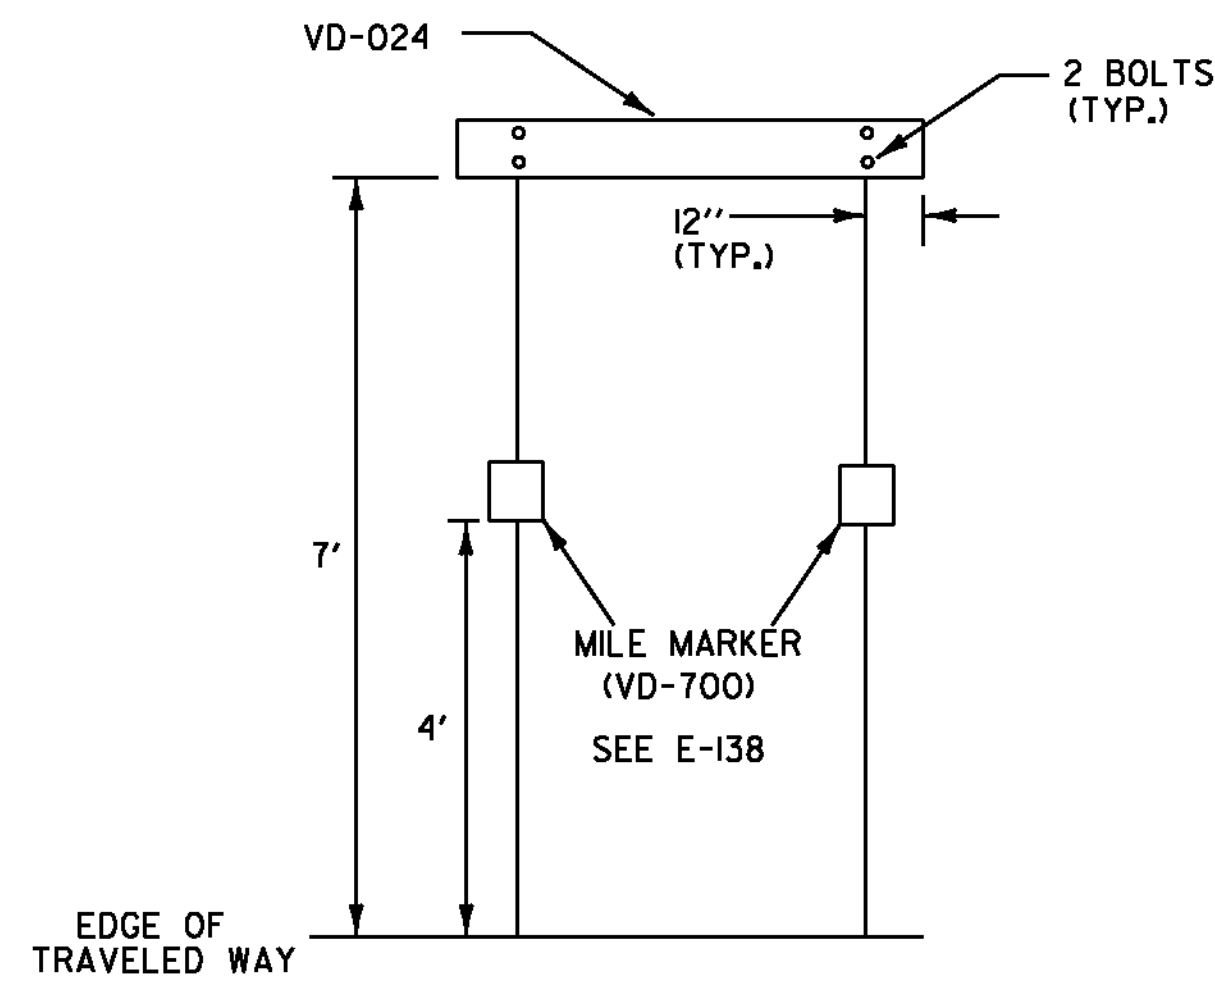


WHEN CROSSING COUNTY BOUNDARIES, AN ADDITIONAL COUNTY LINE SIGN (VD-025) SHALL BE MOUNTED BELOW THE TOWN LINE SIGN (VD-024), MAINTAINING A SEVEN FOOT CLEARANCE.

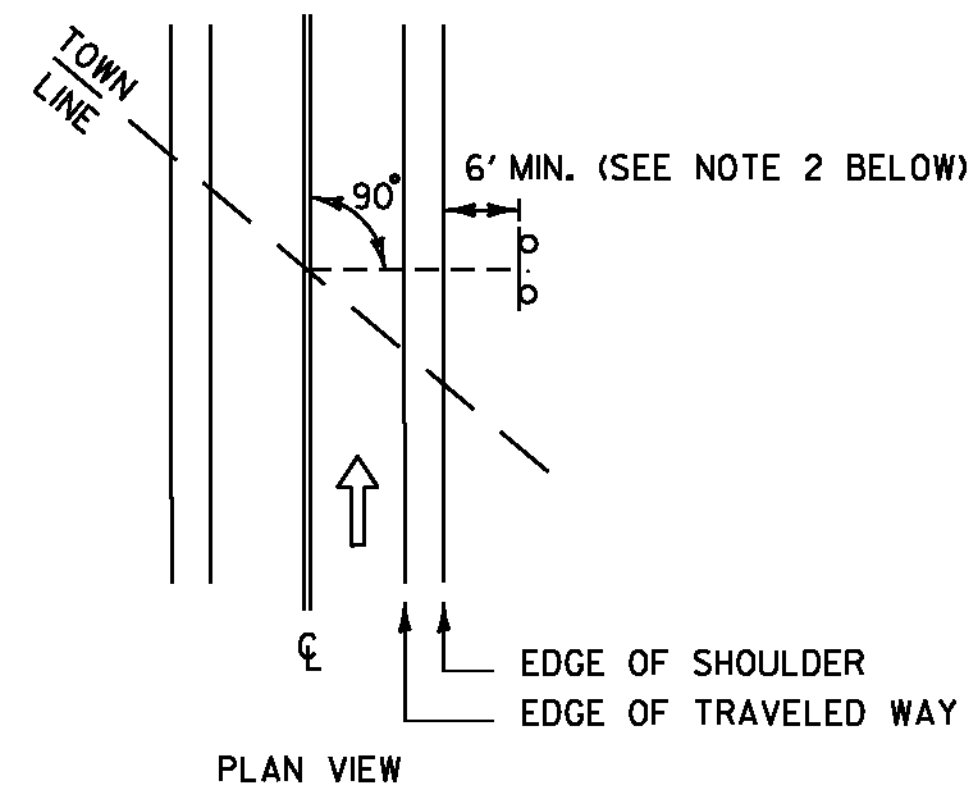


TOWN /COUNTY LINE (VD-024 /VD-025) INSTALLATION:

1. THE SIGN SHALL BE MOUNTED PARALLEL WITH THE ROADWAY, NORMALLY ON THE RIGHT SIDE TRAVELING WEST TO EAST OR SOUTH TO NORTH.
2. FOR POST-MOUNTED SIGNS, THE MINIMUM LATERAL OFFSET SHOULD BE TWELVE FEET FROM THE EDGE OF THE TRAVELED WAY. IF A SHOULDER WIDER THAN SIX FEET EXISTS, THE MINIMUM LATERAL OFFSET FOR POST-MOUNTED SIGNS SHOULD BE SIX FEET FROM THE EDGE OF SHOULDER.

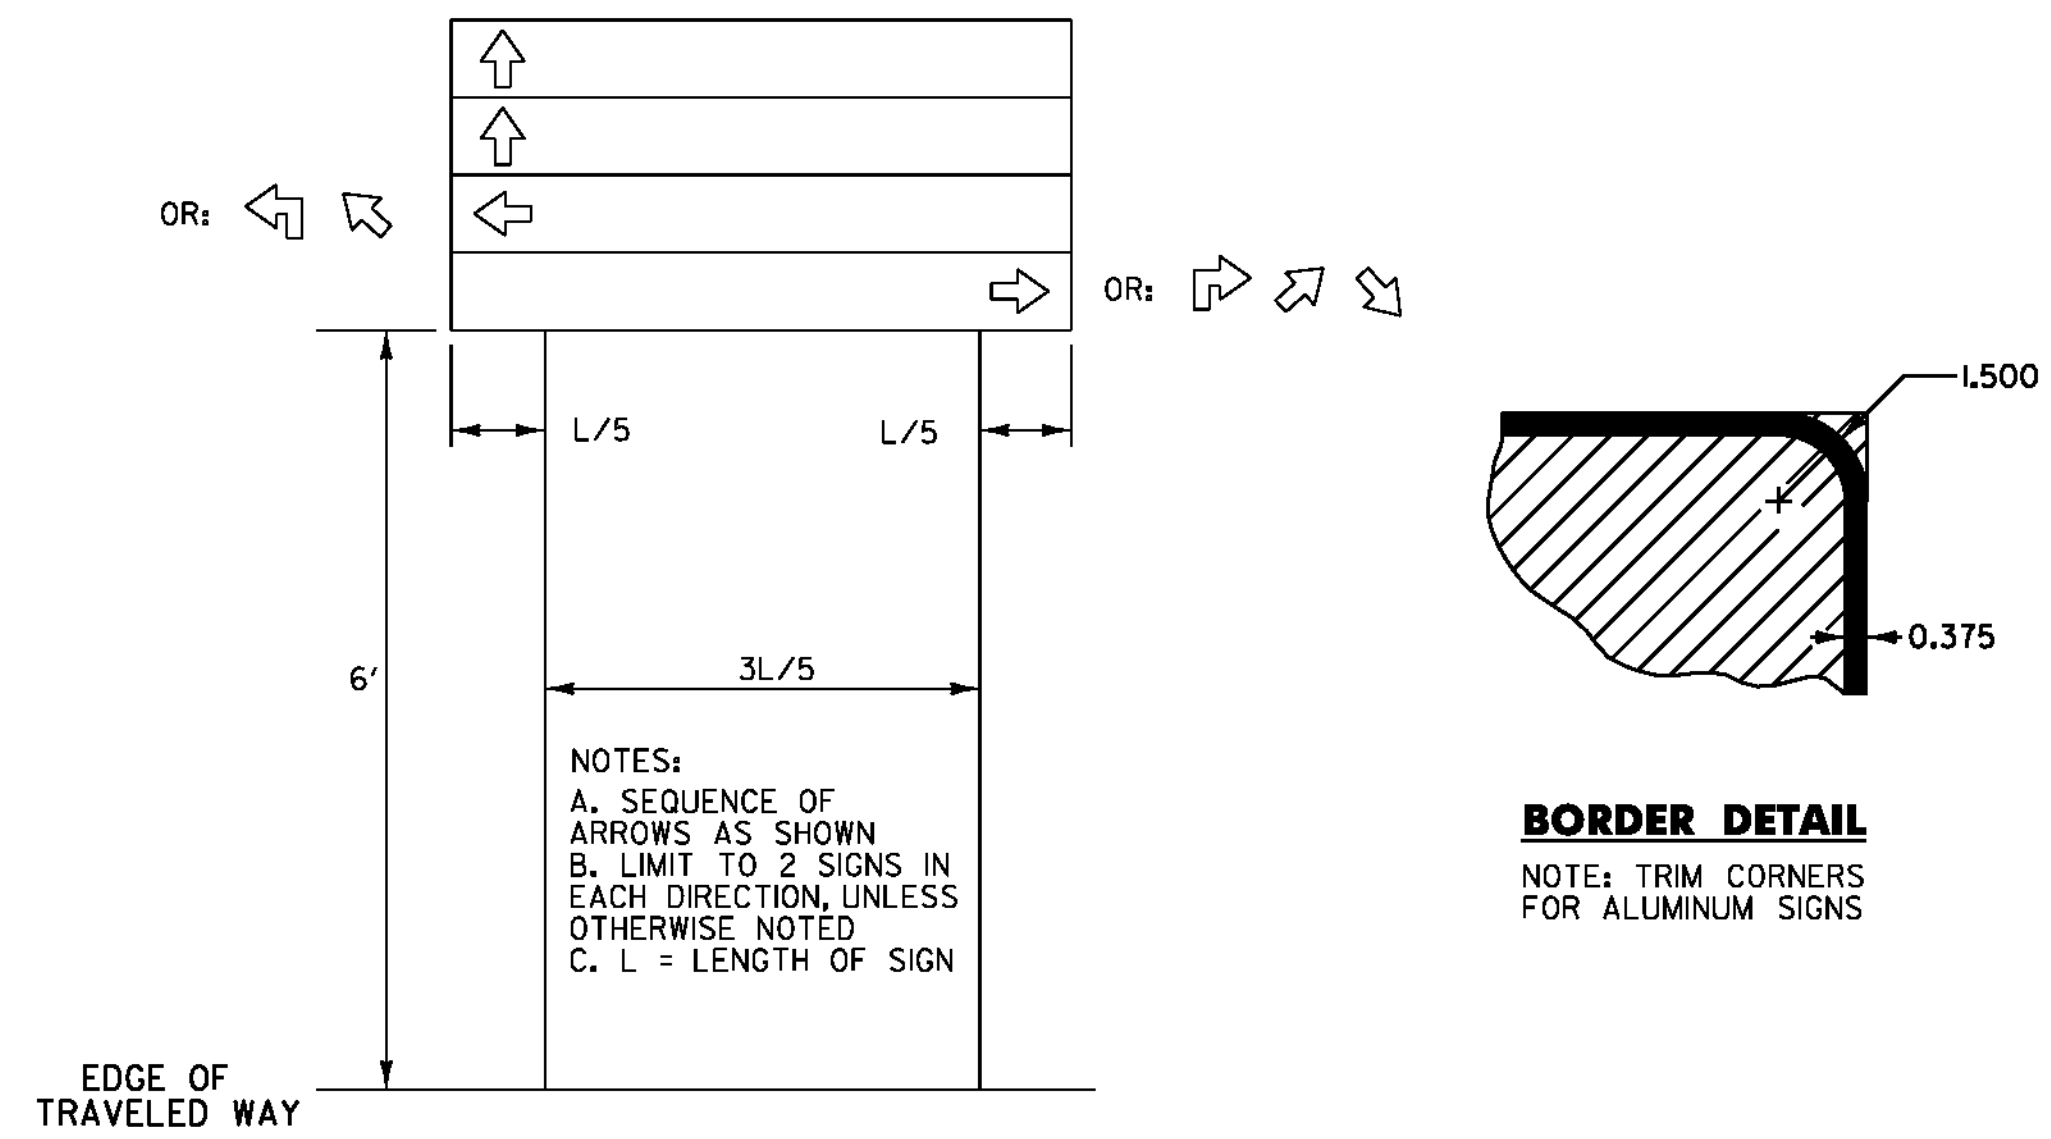


DESTINATION SIGNS (VD1-1, VD1-1A, VD1-2, VD2-1) ASSEMBLY:


1. THE DESTINATION SIGN DETAILS SHOWN ON SHEETS 9 AND 10 SHALL HAVE WHITE RETROREFLECTIVE ASTM D 4956 TYPE III OR IV TEXT, ARROWS AND BORDERS ON A GREEN RETROREFLECTIVE ASTM D 4956 TYPE III OR IV BACKGROUND.
2. FONT SPACING SHOWN ON AN INDIVIDUAL SIGN DETAIL MAY BE ADJUSTED SLIGHTLY TO MEET DIMENSION REQUIREMENT(S).
3. DIMENSIONS SHOWN ON THE INDIVIDUAL SIGN DETAILS MAY BE ADJUSTED SLIGHTLY TO ACCOMMODATE VARIOUS MANUFACTURER'S LETTER WIDTHS.

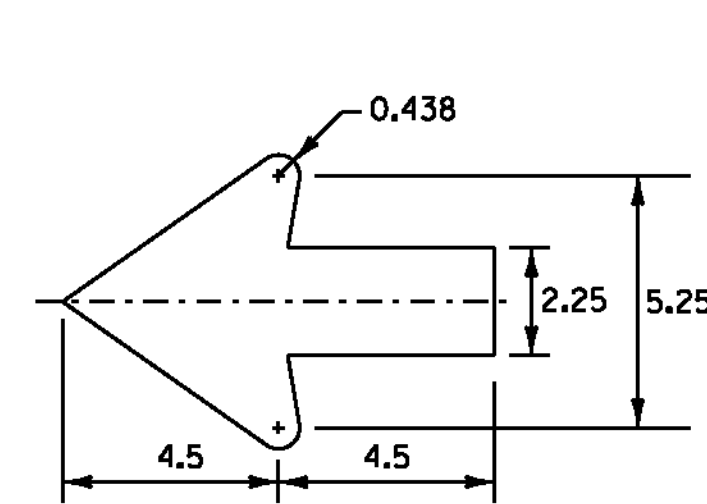

STANDARD SHSM 2.25" ARROW

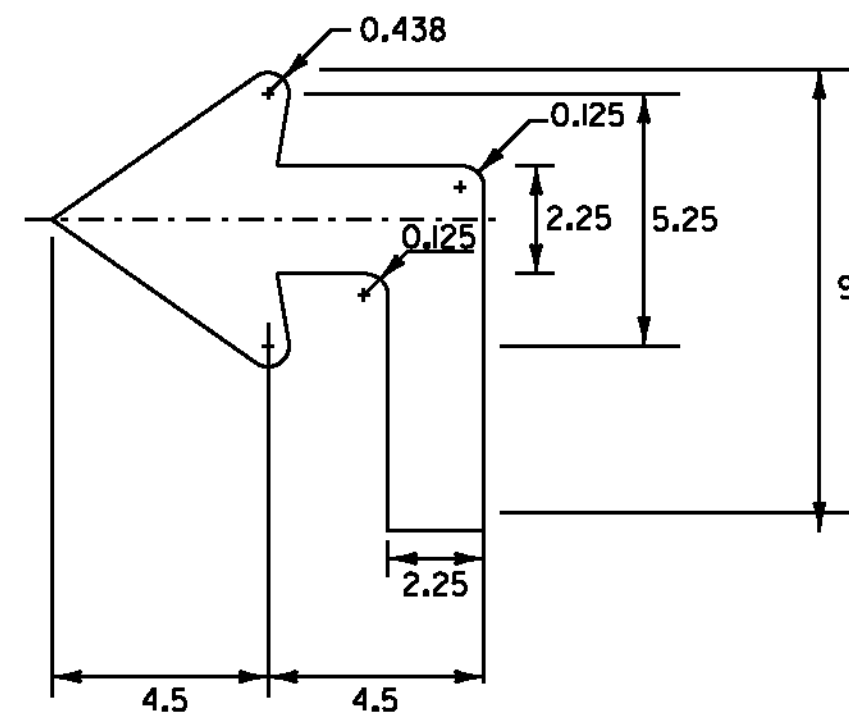

ADVANCE 2.25" ARROW

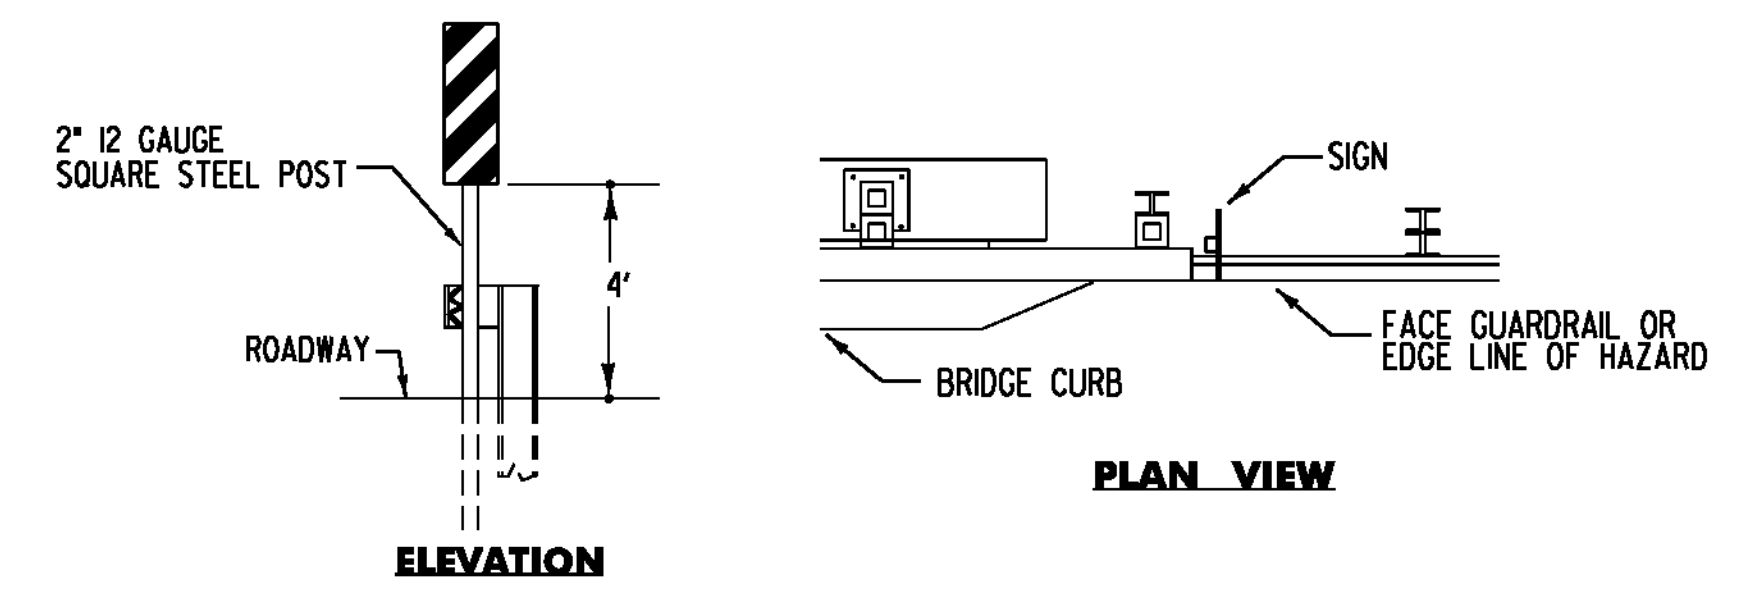





OBJECT MARKER (OM3-L or OM3-R) INSTALLATION:

1. OBJECT MARKER SHOULD BE INSTALLED SO THAT THE INSIDE EDGE OF THE SIGN IS AS CLOSE AS POSSIBLE TO THE FACE OF GUARDRAIL OR INSIDE EDGE OF THE HAZARD.
2. THE SIGN SHALL BE MOUNTED SO THE DIAGONAL STRIPES SLOPE DOWNWARDS TOWARD THE ROAD CENTERLINE.
3. ASSEMBLY HARDWARE SHALL CONFORM TO SUBSECTION 750.12 (a). RIVETS SHALL NOT BE USED.
4. SIGN BASE MATERIAL SHALL BE 0.100" FLAT SHEET ALUMINUM.
5. MOUNTING HARDWARE FOR SIGNS ATTACHED TO ABUTMENTS OR HAZARDS SHALL BE APPROVED BY THE ENGINEER.
6. PAYMENT FOR ALL MATERIALS AND LABOR NECESSARY TO ATTACH AN OBJECT MARKER SIGN TO ANYTHING OTHER THAN A SIGN POST WILL BE PAID FOR AS ONE 15 FT LONG 2.0" SQUARE STEEL SIGN POST.

ALL DIMENSIONS SHOWN IN INCHES, EXCEPT WHERE NOTED.

NOT TO SCALE


PROJECT NAME: HARTLAND - BETHEL	
PROJECT NUMBER: STPG SIGN (40)	
FILE NAME: I2C116.SD.1	PLOT DATE: 01-AUG-2012
PROJECT LEADER: A. GAMBLE	DRAWN BY: M. MILLER
DESIGNED BY: M. MILLER	CHECKED BY: A. GAMBLE
SIGN DETAILS I	SHEET 4 OF 85

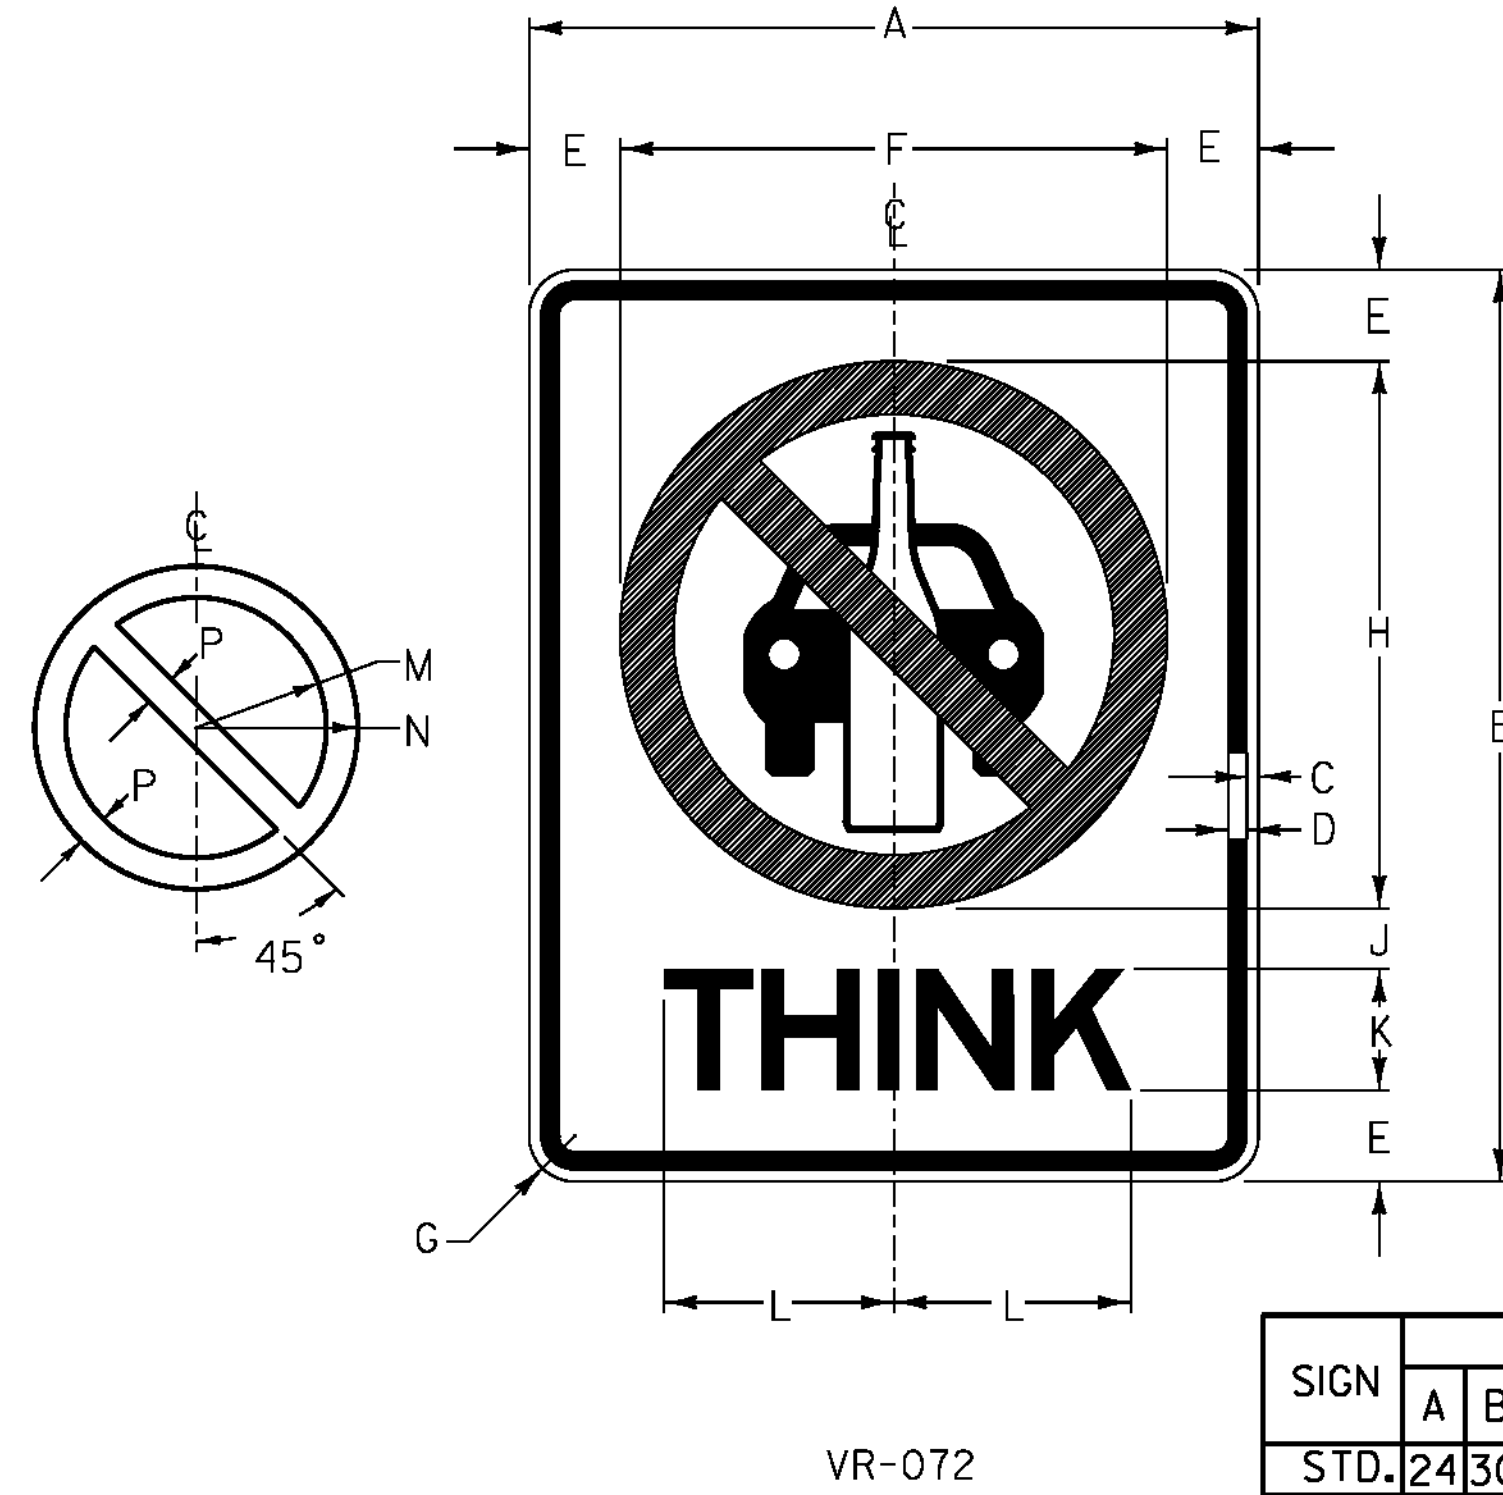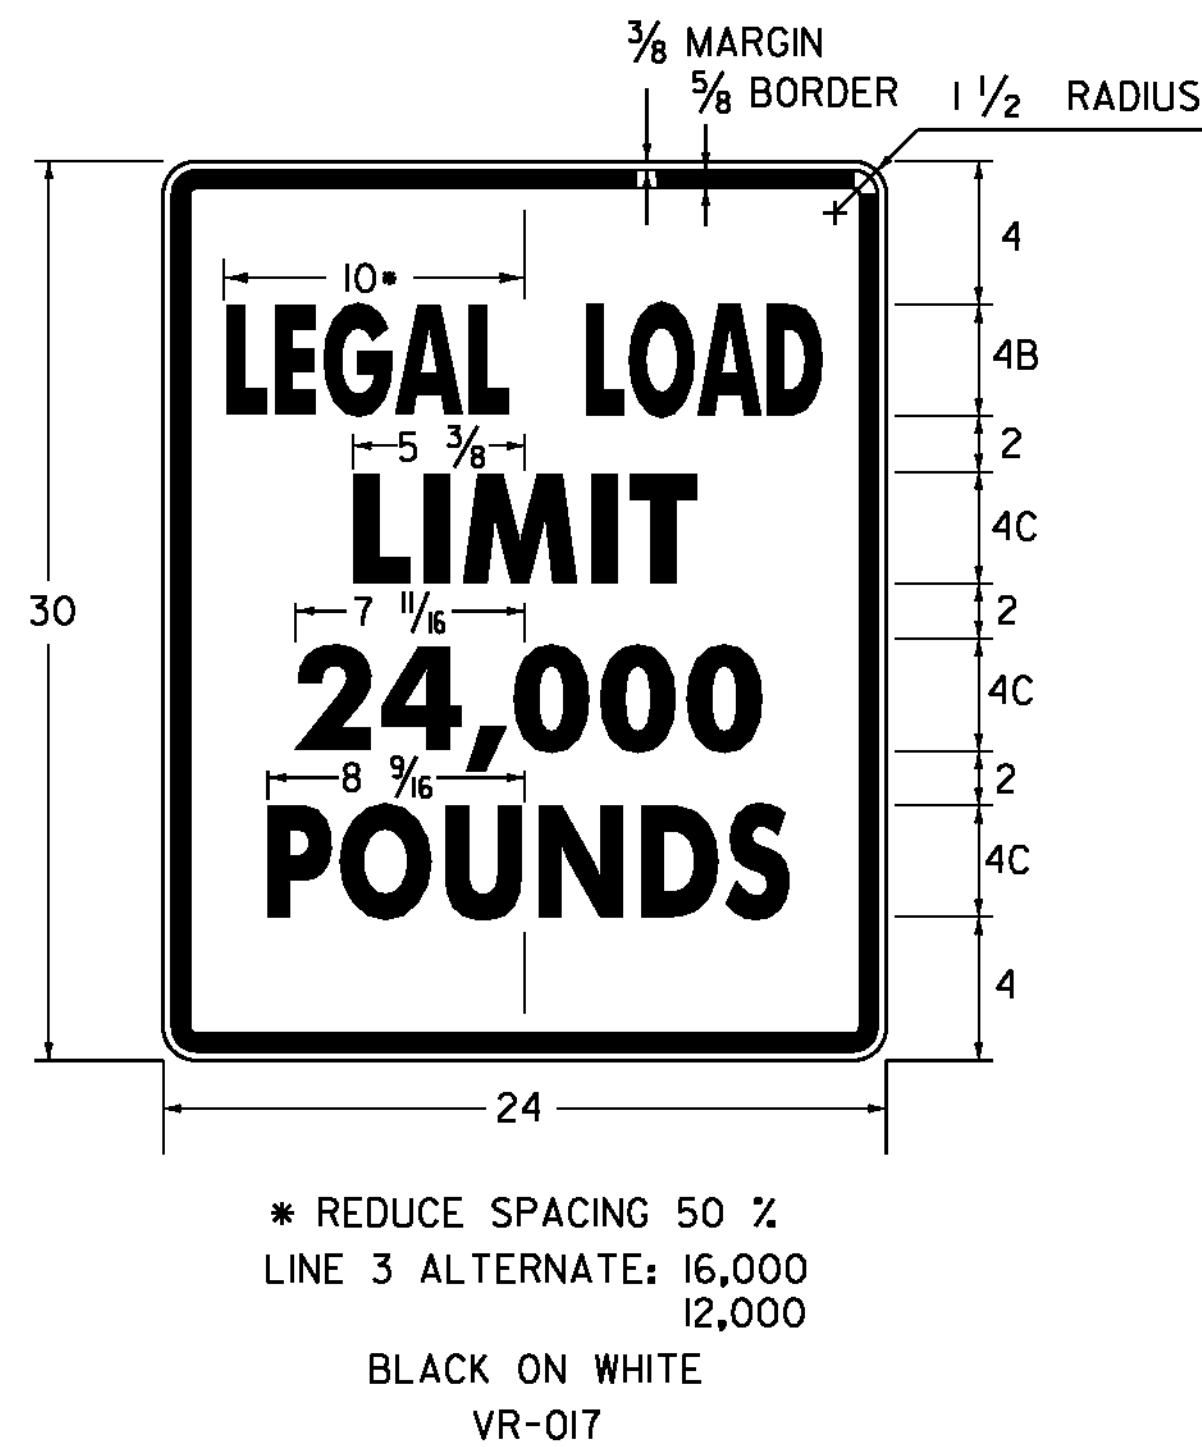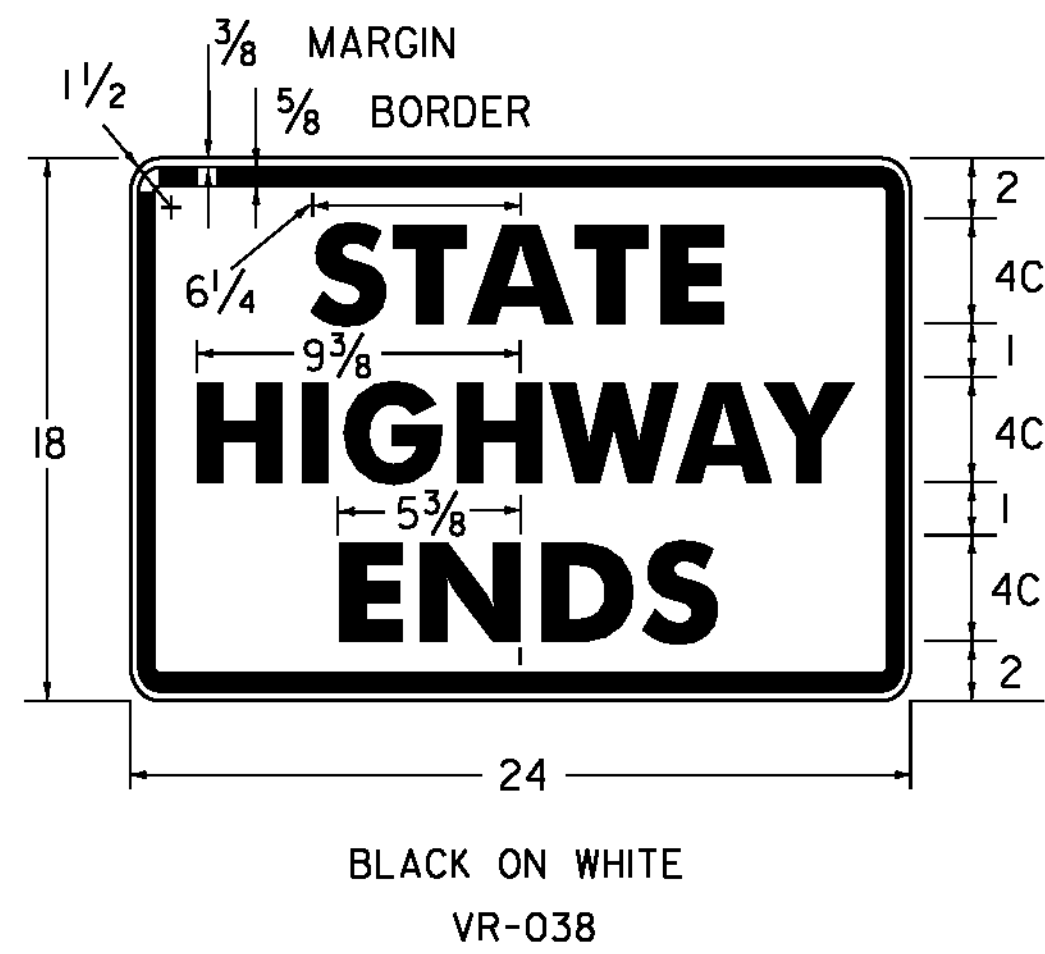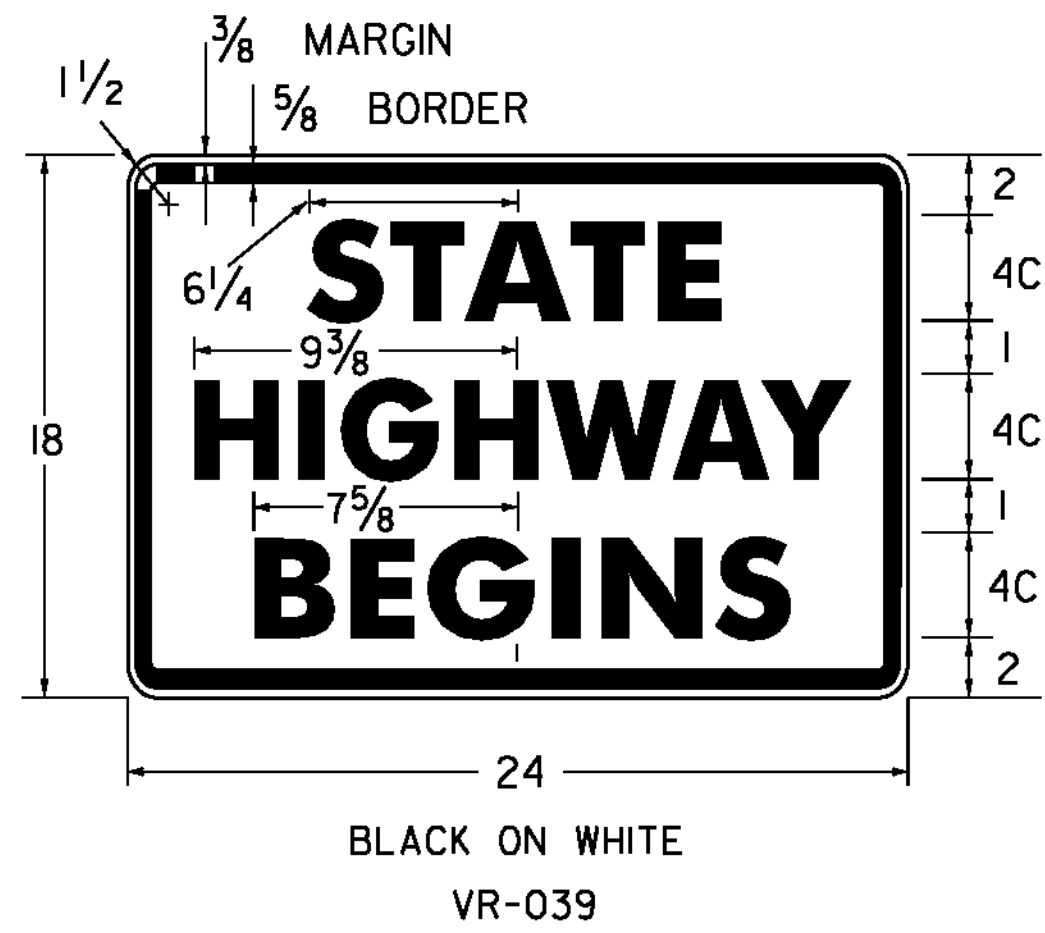

1 SQUARE = 1 INCH



SIGN	DIMENSIONS (INCHES)													
	A	B	C	D	E	F	G	H	J	K	L	M	N	P
STD.	24	30	3/8	5/8	3	18	1 1/2	18	2	4E	1 1/4	1 1/4	9	1 3/4

TEXT & BORDER - BLACK
CAR & BOTTLE SYMBOL - BLACK
PROHIBITED SYMBOL - RED
BACKGROUND - WHITE RETROREFLECTIVE

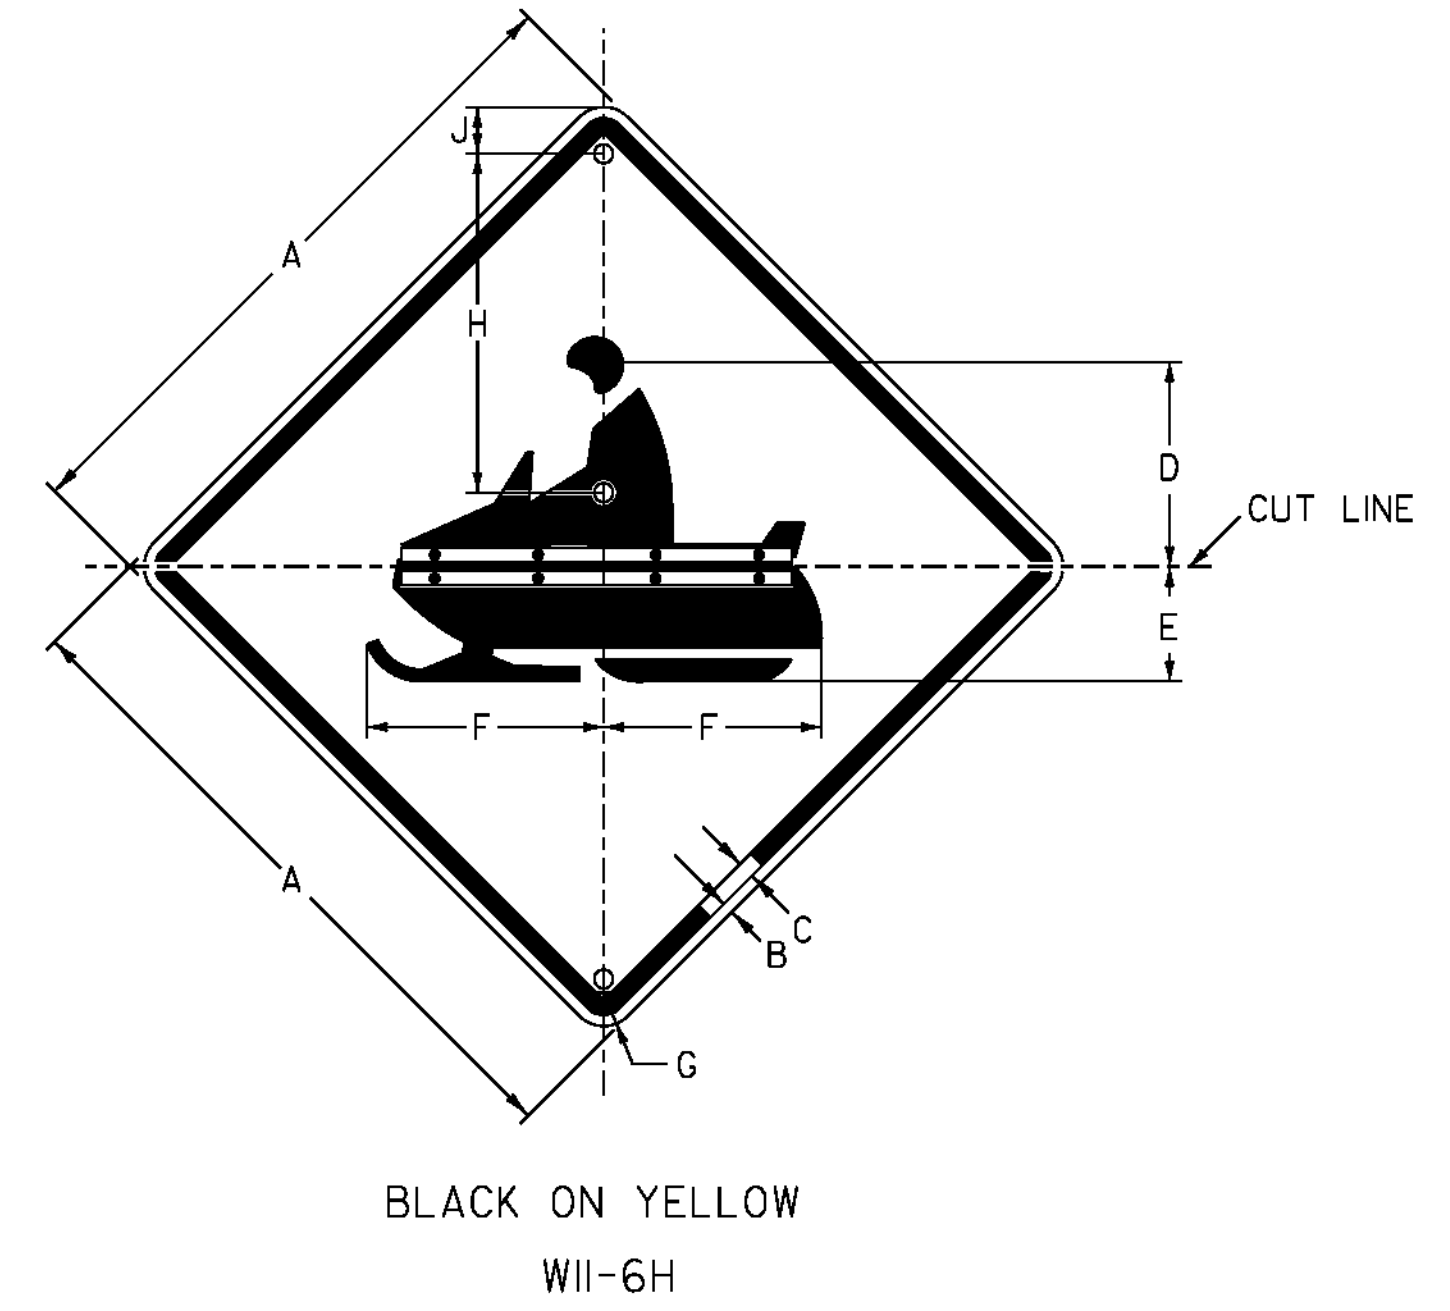

SIGN	DIMENSIONS (INCHES)									
	A	B	C	D	E	F	G	H	J	
STD.	30	1/2	3/4	1 1/16	5/16	12 1/16	1 3/8	14	2 1/2	


USE STANDARD 2" (BLACK) PIANO HINGE

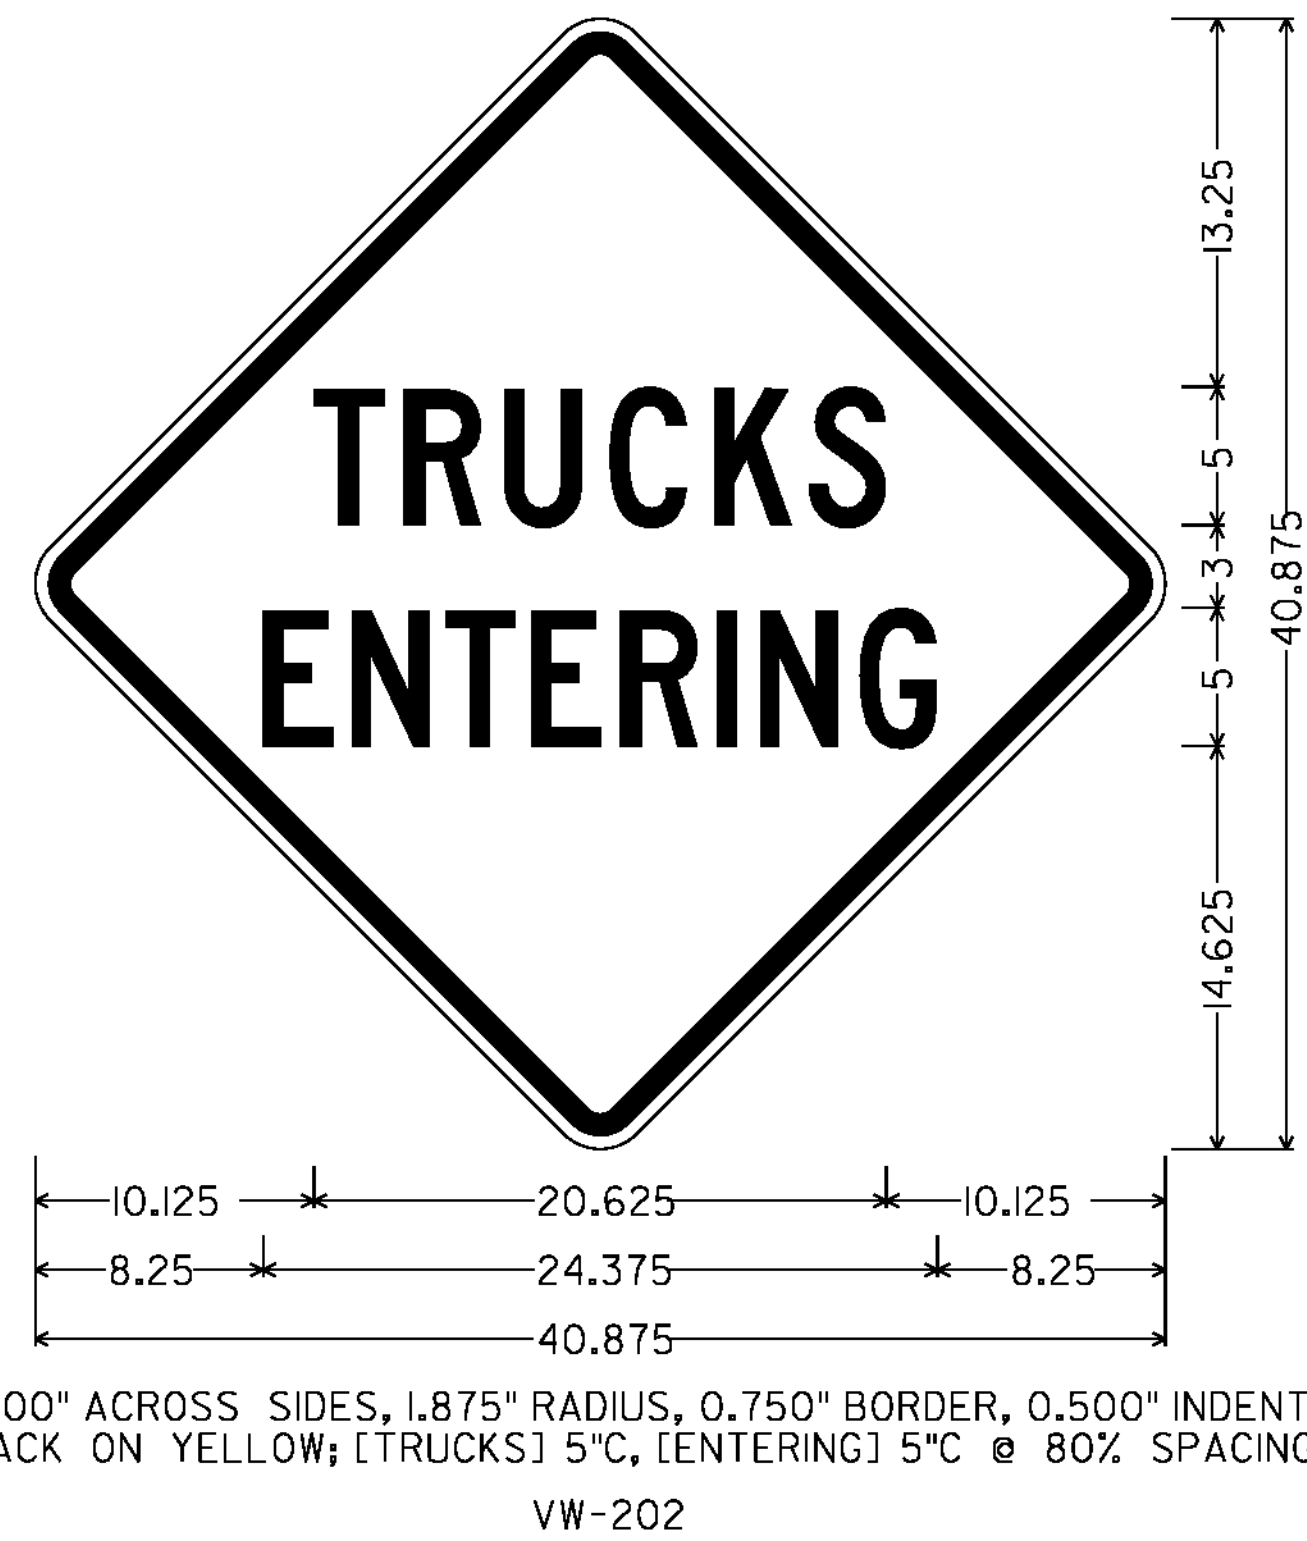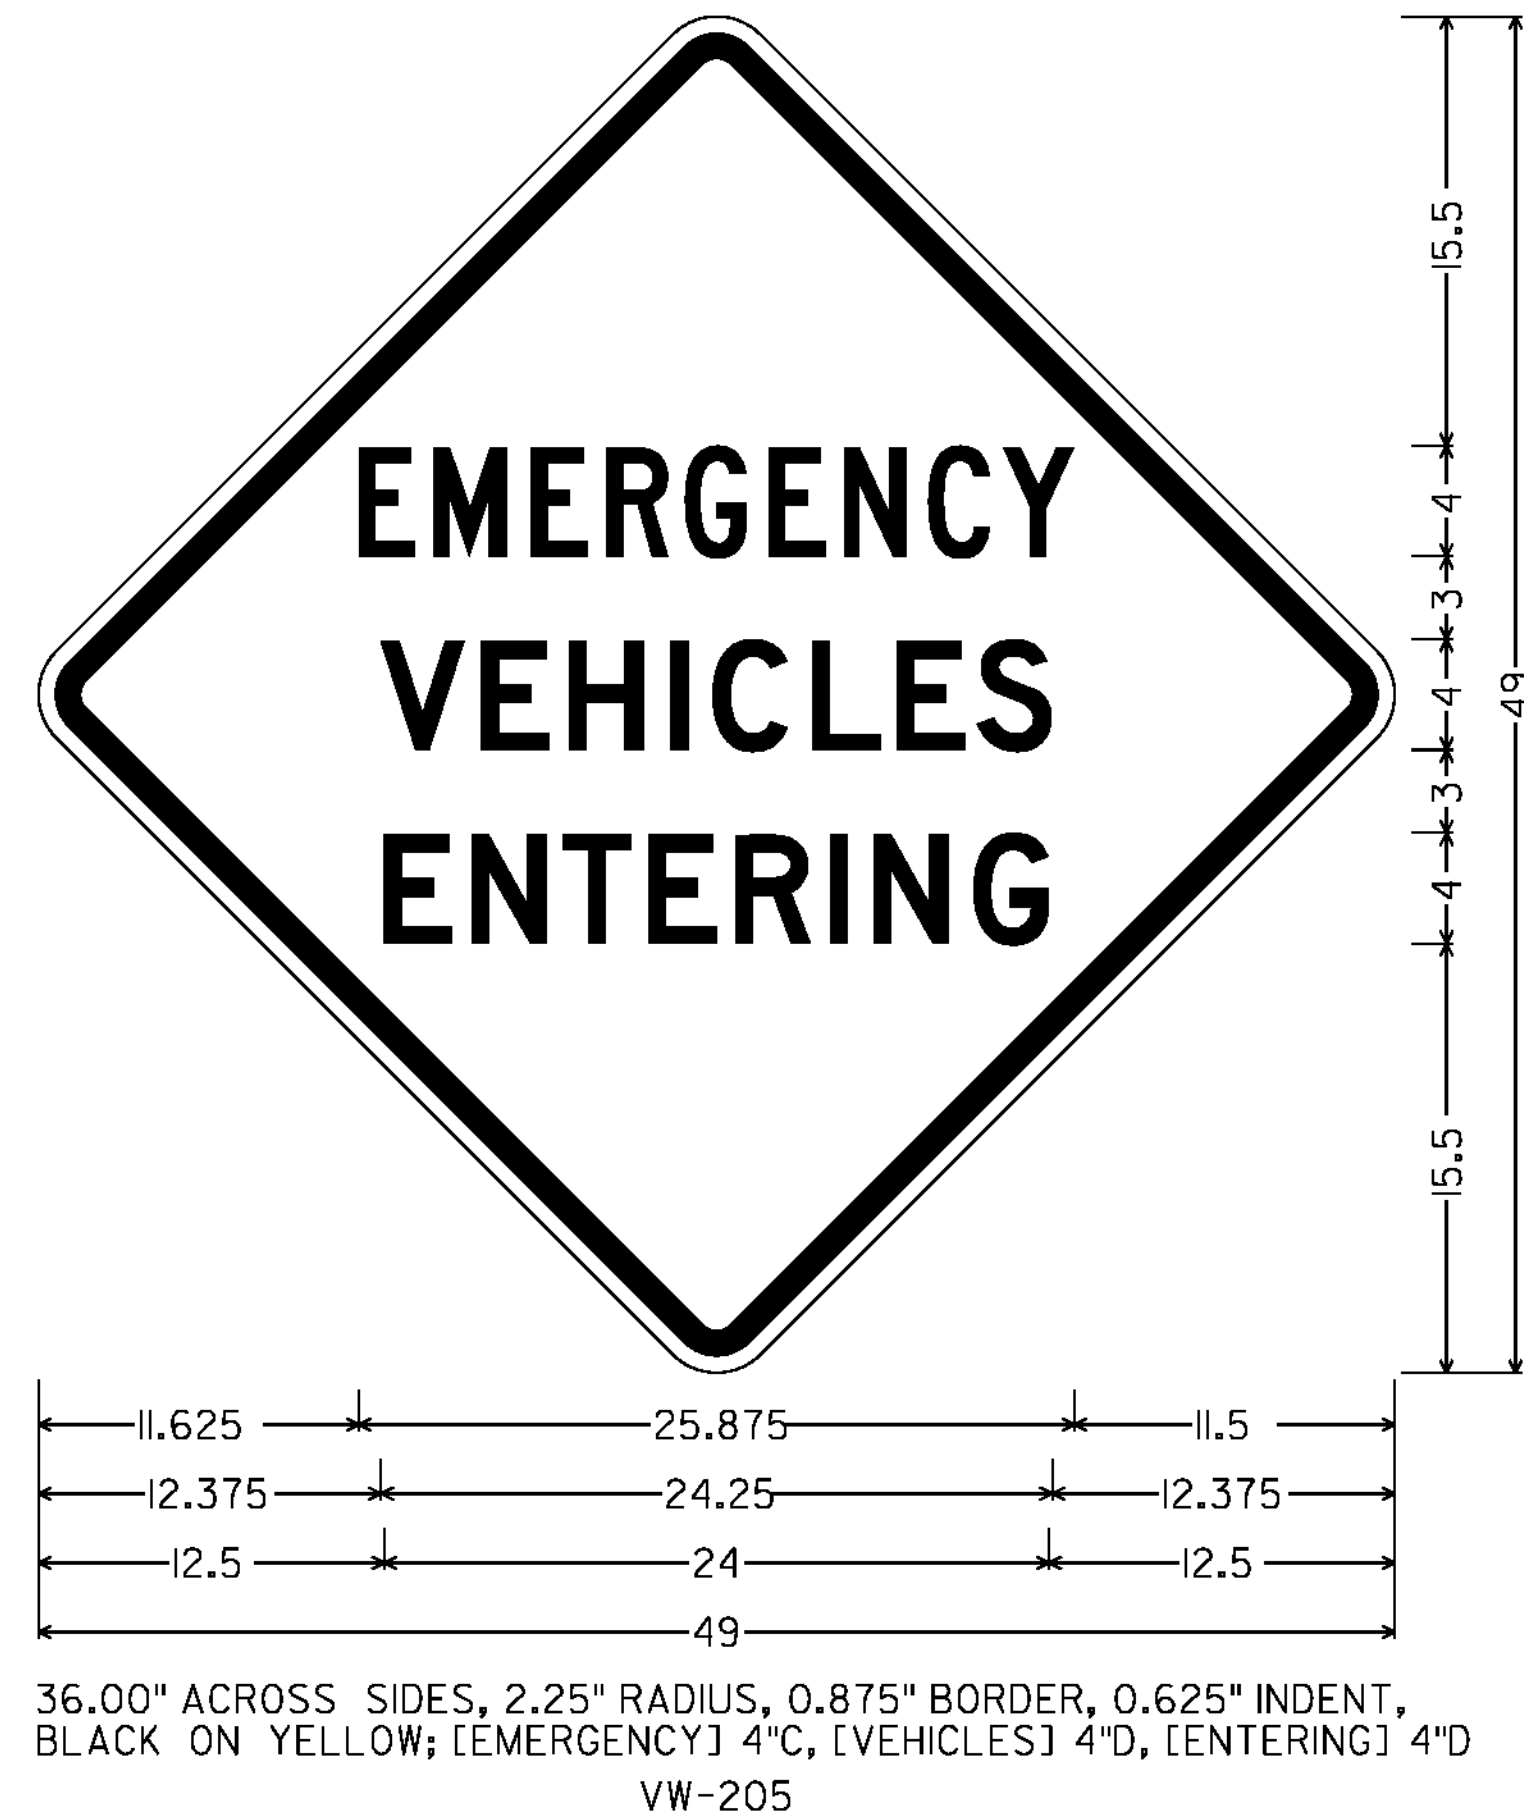

ALL DIMENSIONS SHOWN IN INCHES, EXCEPT WHERE NOTED.


PROJECT NAME:	HARTLAND - BETHEL	FILE NAME:	I2CI16.SD.3	PLOT DATE:	26-JUN-2012
PROJECT NUMBER:	STPG SIGN (40)	PROJECT LEADER:	A. GAMBLE	DRAWN BY:	M. MILLER
		DESIGNED BY:	M. MILLER	CHECKED BY:	A. GAMBLE
		SIGN DETAILS	3	SHEET	6 OF 85

NOT TO SCALE

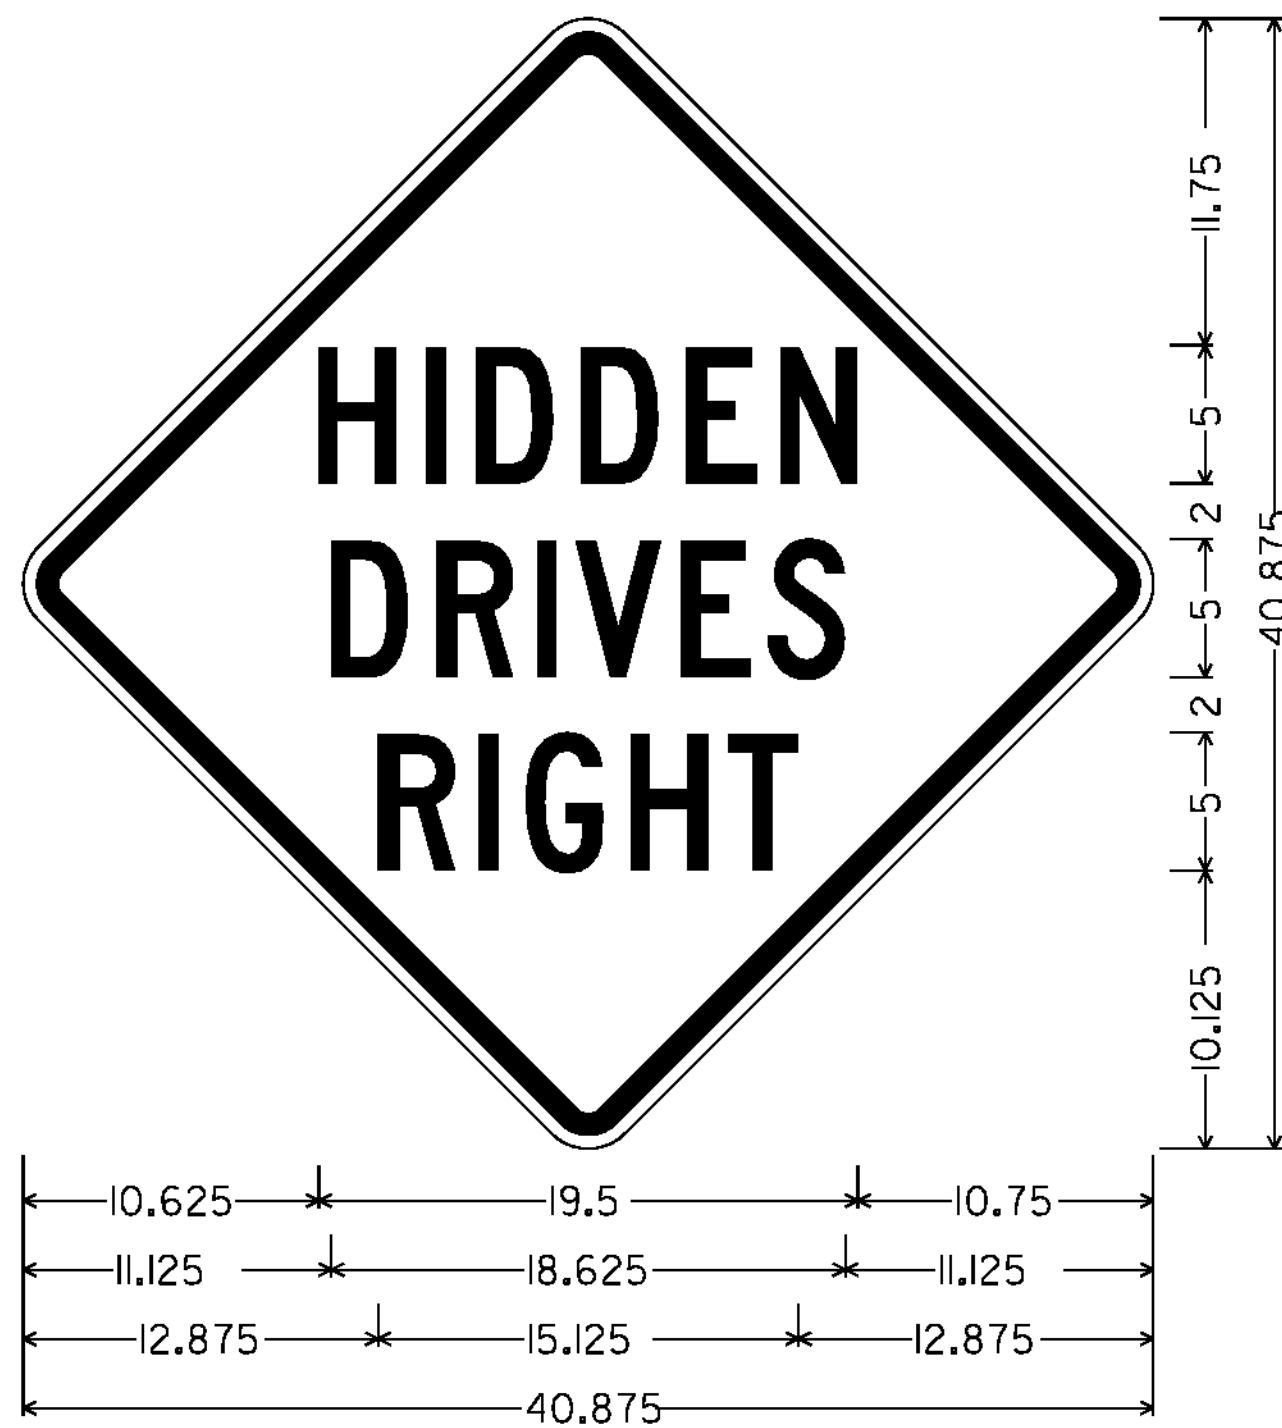


30.00" ACROSS SIDES, 1.875" RADIUS, 0.750" BORDER, 0.500" INDENT, BLACK ON YELLOW; [HIDDEN] 5"C, [DRIVES] 5"C, [RIGHT] 5"C

VW-133R

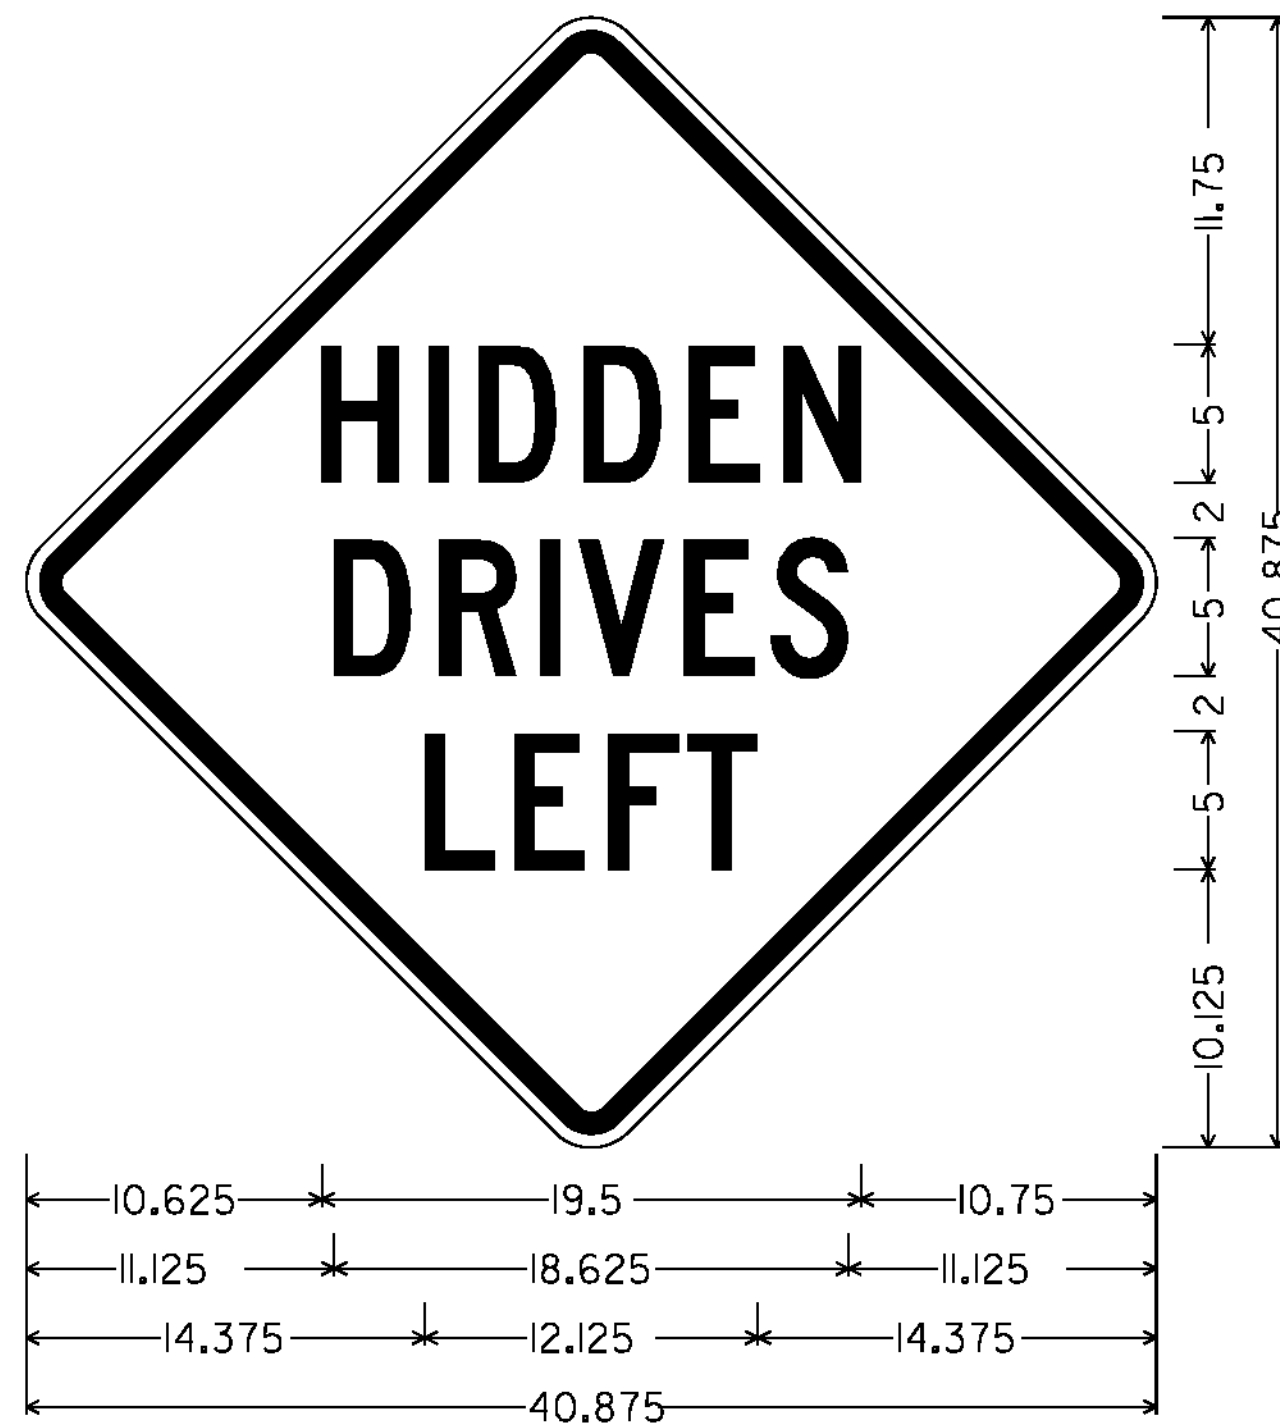


30.00" ACROSS SIDES, 1.875" RADIUS, 0.750" BORDER, 0.500" INDENT, BLACK ON YELLOW; [HIDDEN] 5"C, [DRIVES] 5"C, [LEFT] 5"C

VW-133L

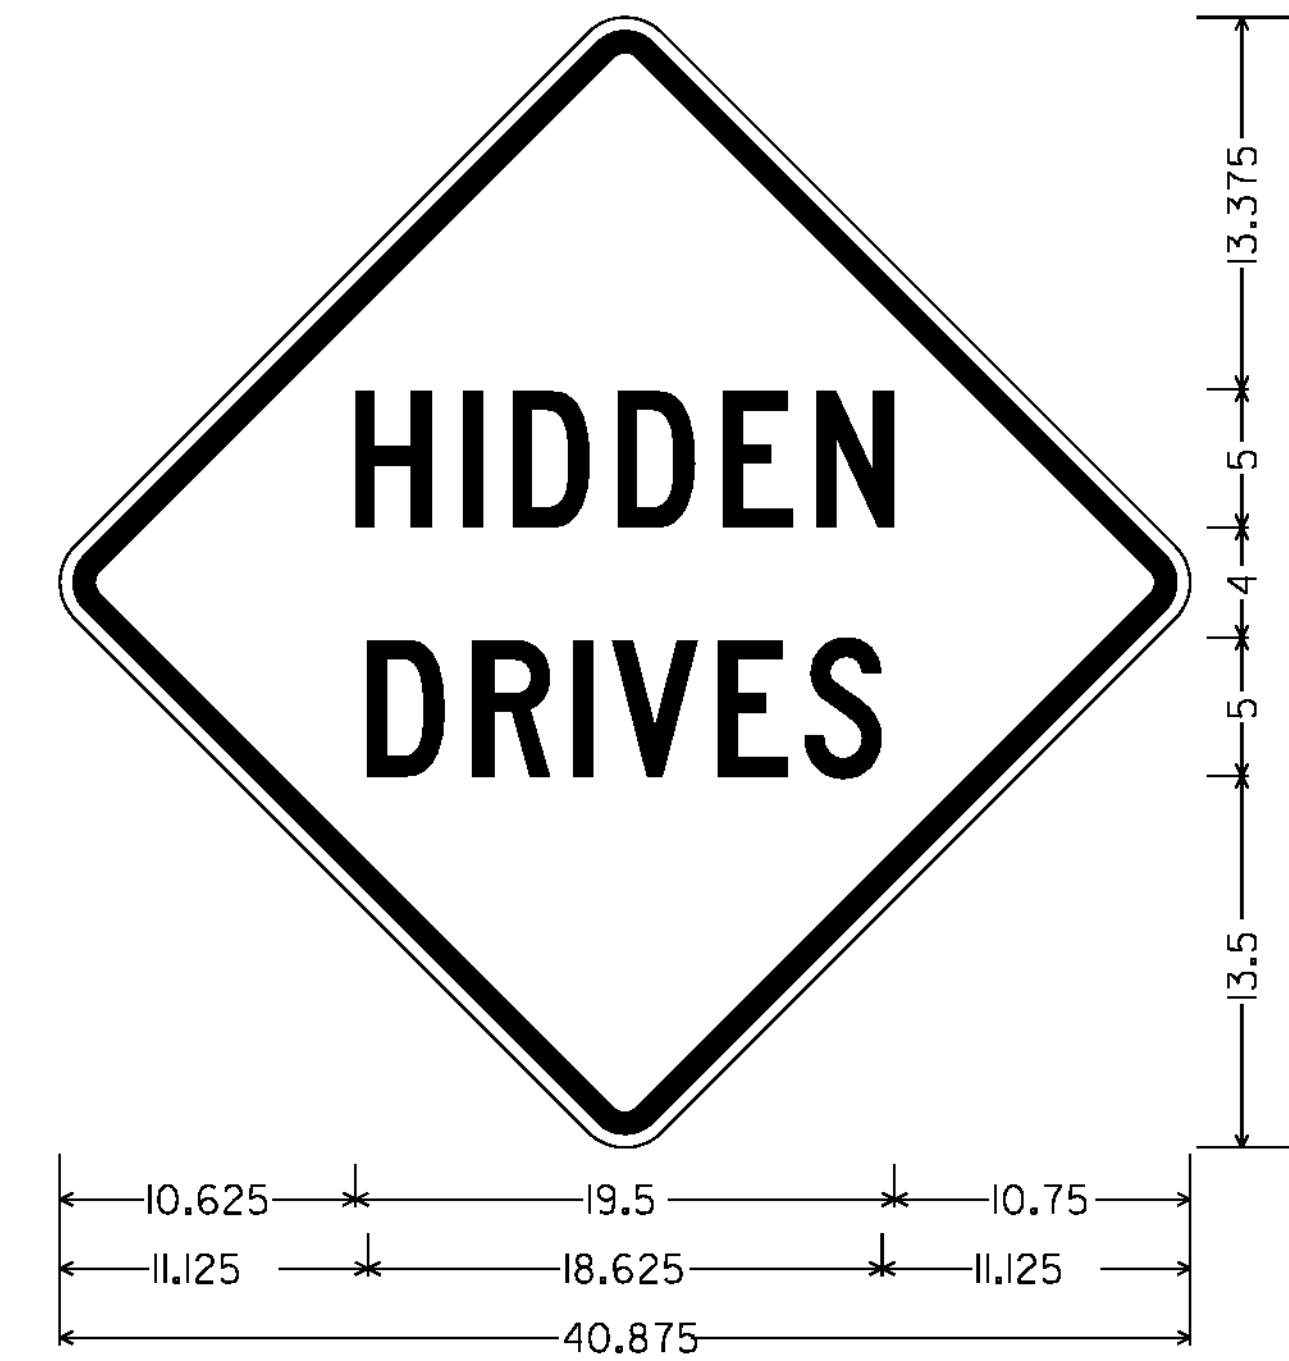


30.00" ACROSS SIDES, 1.875" RADIUS, 0.750" BORDER, 0.500" INDENT, BLACK ON YELLOW; [HIDDEN] 5"C, [DRIVES] 5"C

VW-060

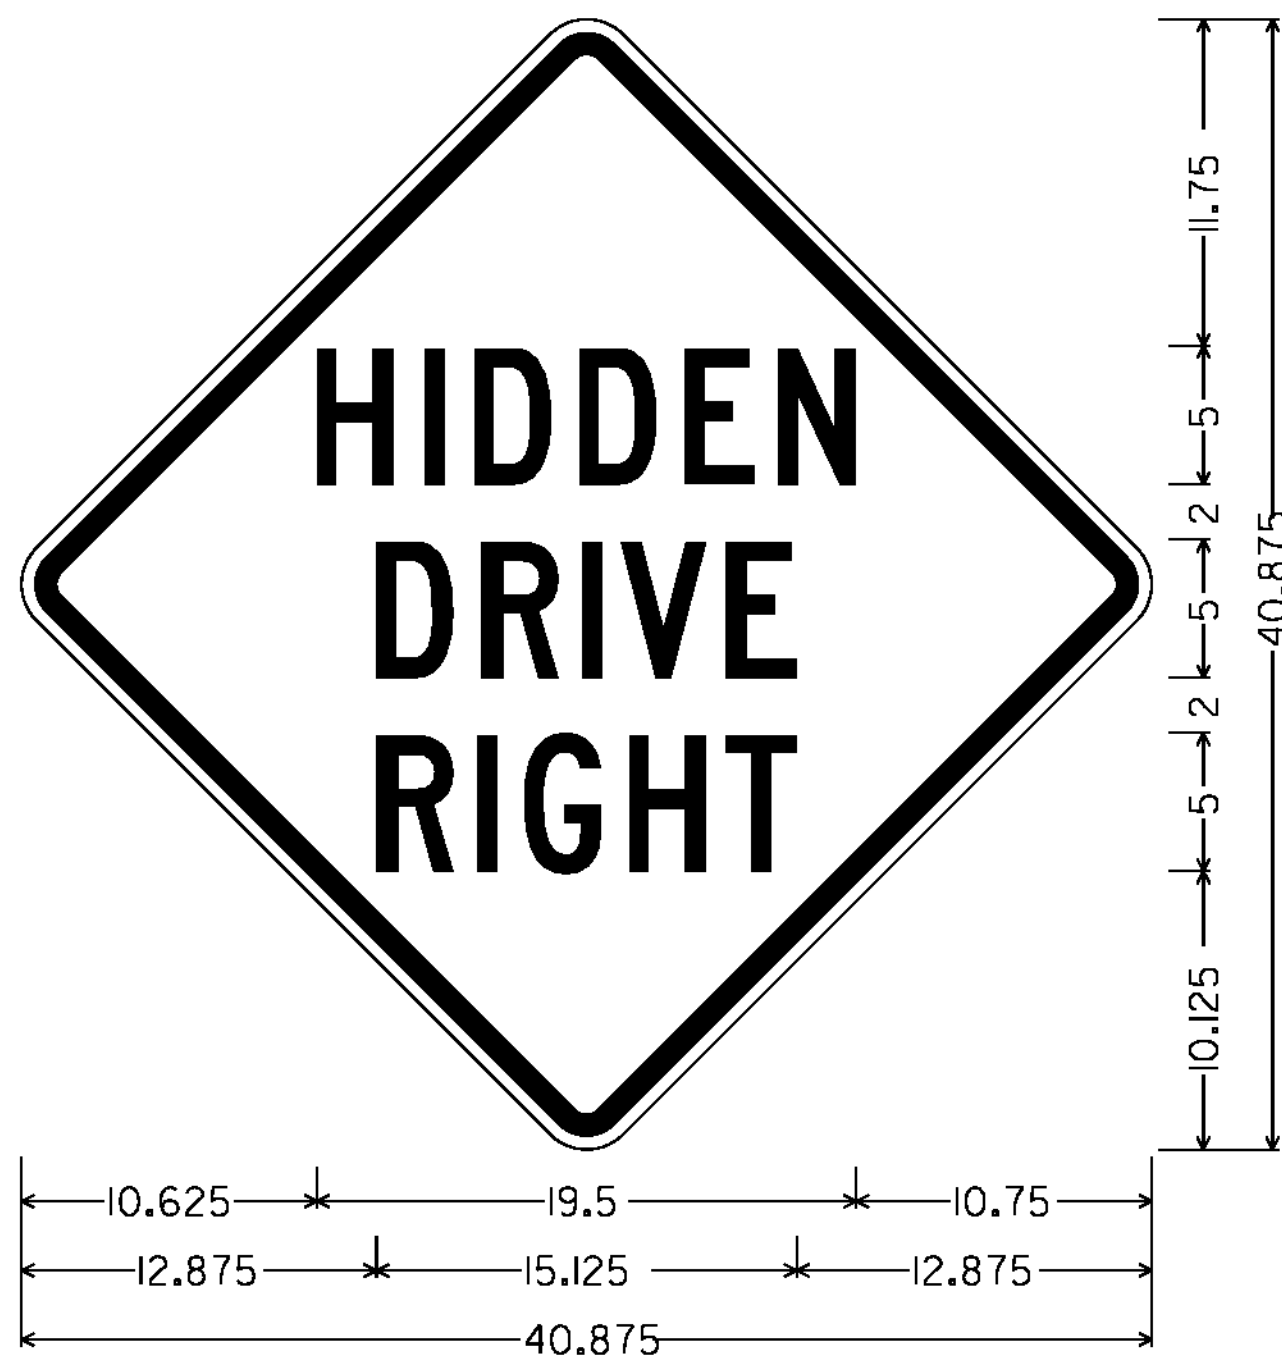


30.00" ACROSS SIDES, 1.875" RADIUS, 0.750" BORDER, 0.500" INDENT, BLACK ON YELLOW; [HIDDEN] 5"C, [DRIVE] 5"C, [RIGHT] 5"C

VW-054R

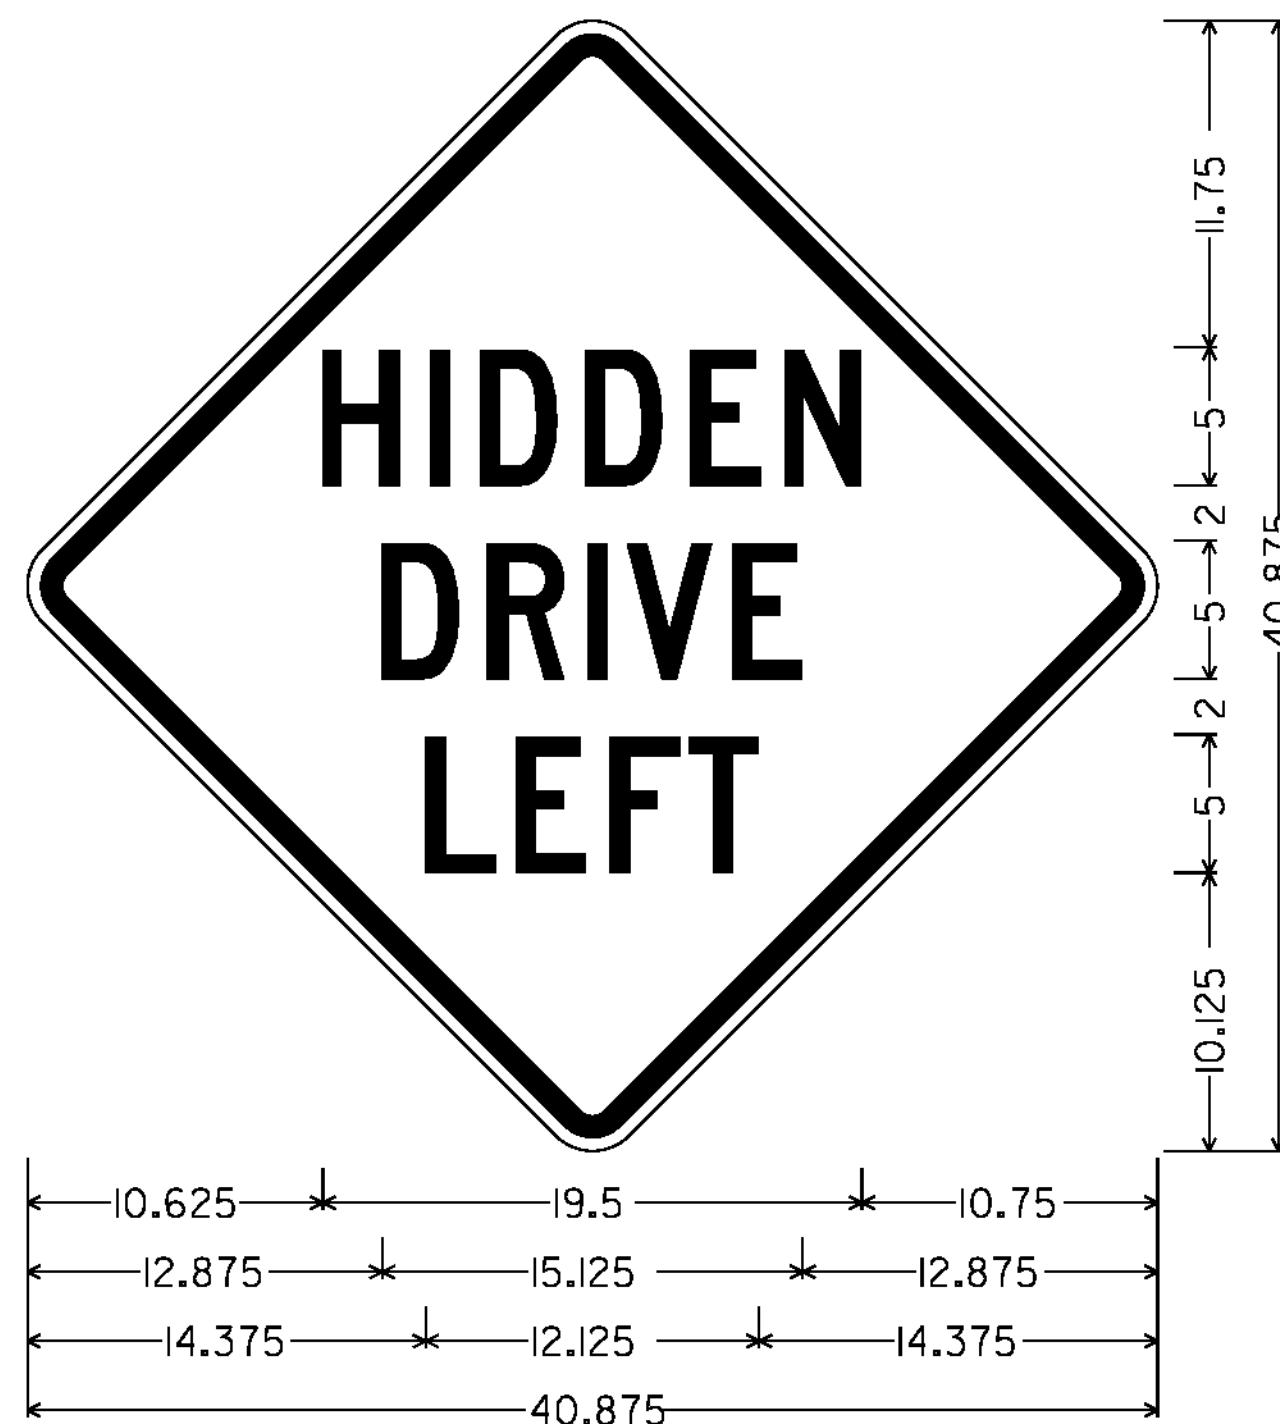

30.00" ACROSS SIDES, 1.875" RADIUS, 0.750" BORDER, 0.500" INDENT, BLACK ON YELLOW; [HIDDEN] 5"C, [DRIVE] 5"C, [LEFT] 5"C

VW-054L

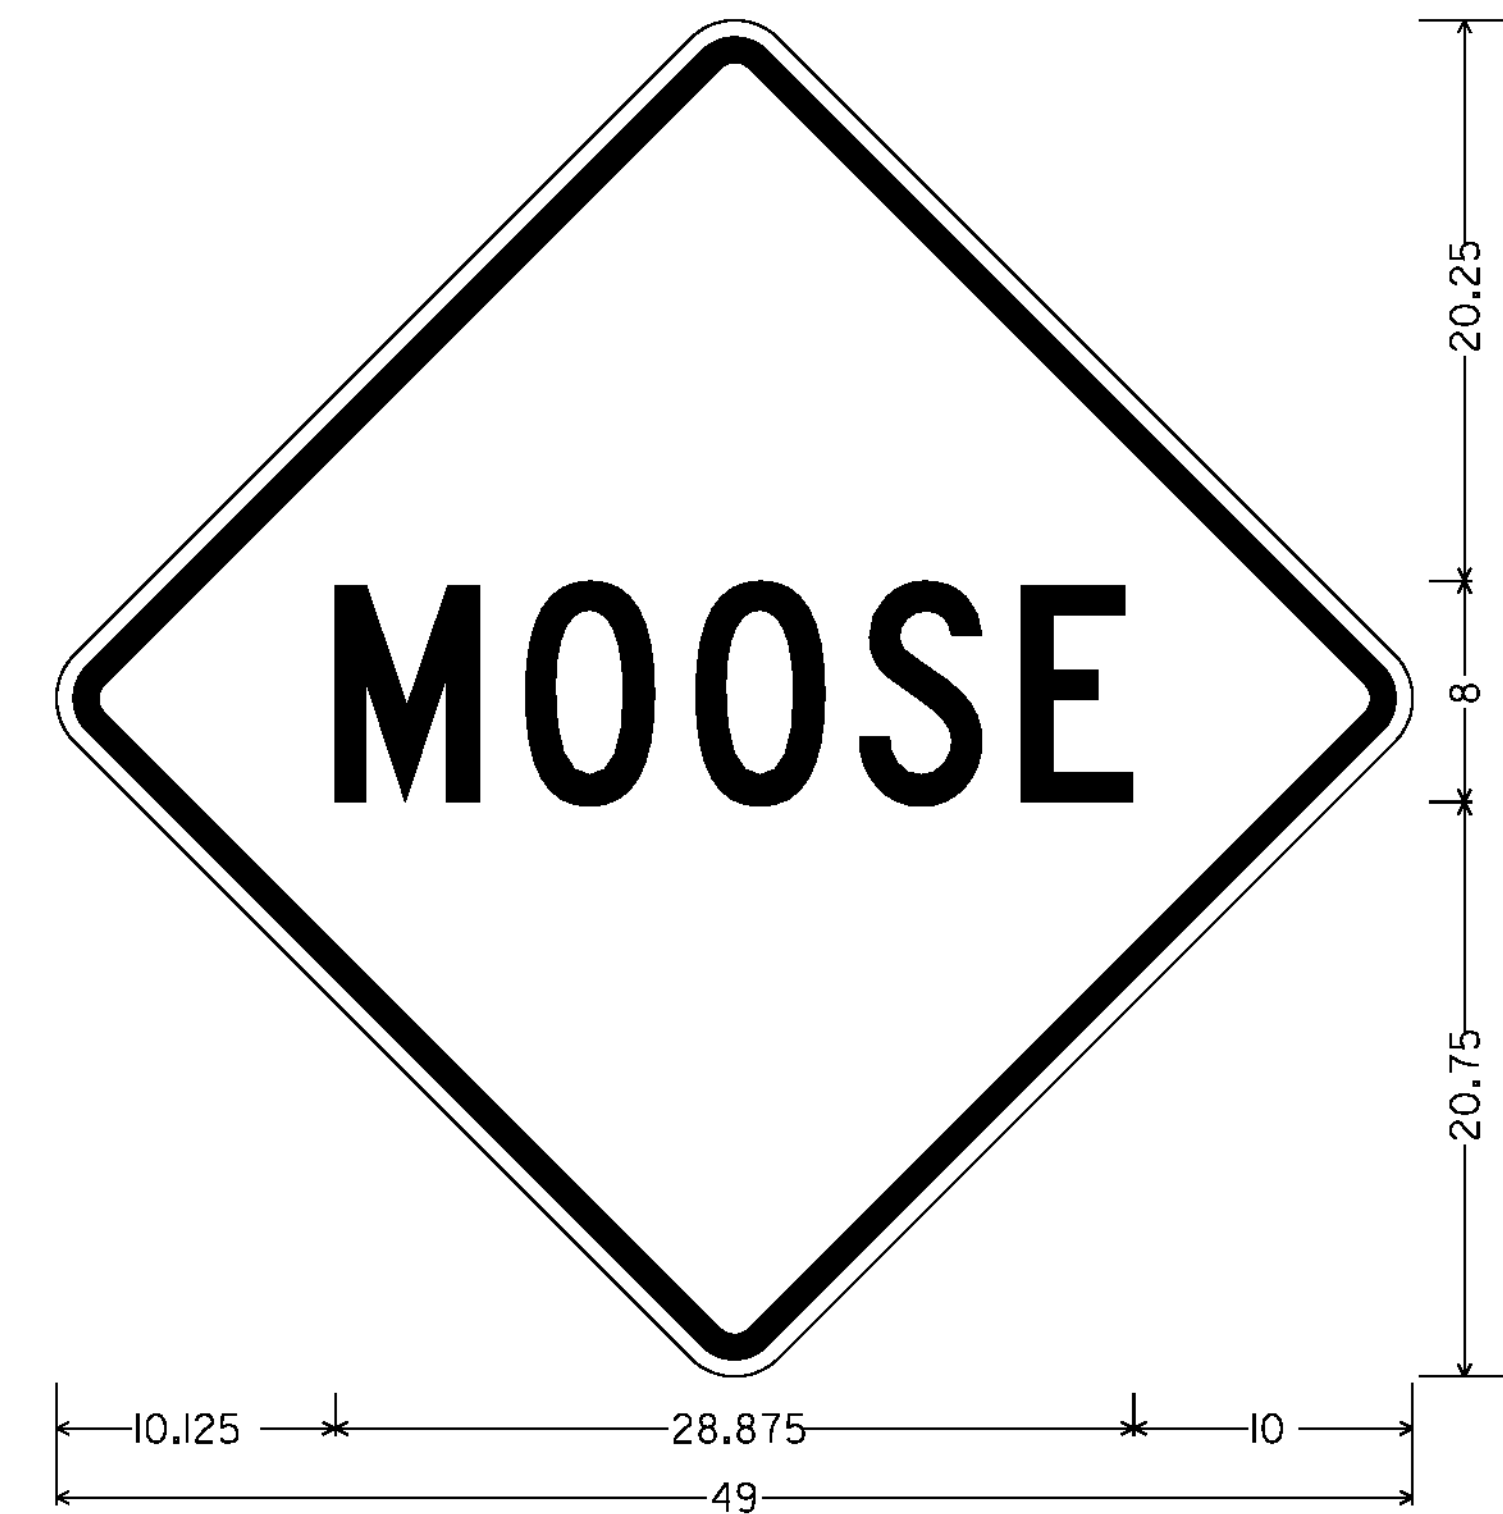


36.00" ACROSS SIDES, 2.250" RADIUS, 0.875" BORDER, 0.625" INDENT, BLACK ON YELLOW; [MOOSE] 8"C

VW-001


ALL DIMENSIONS SHOWN IN INCHES, EXCEPT WHERE NOTED.

NOT TO SCALE


PROJECT NAME:	HARTLAND - BETHEL	FILE NAME:	I2CI16.SD_4	PLOT DATE:	27-JUN-2012
PROJECT NUMBER:	STPG SIGN (40)	PROJECT LEADER:	A. GAMBLE	DRAWN BY:	M. MILLER
		DESIGNED BY:	M. MILLER	CHECKED BY:	A. GAMBLE
		SIGN DETAILS 4		SHEET 7	OF 85

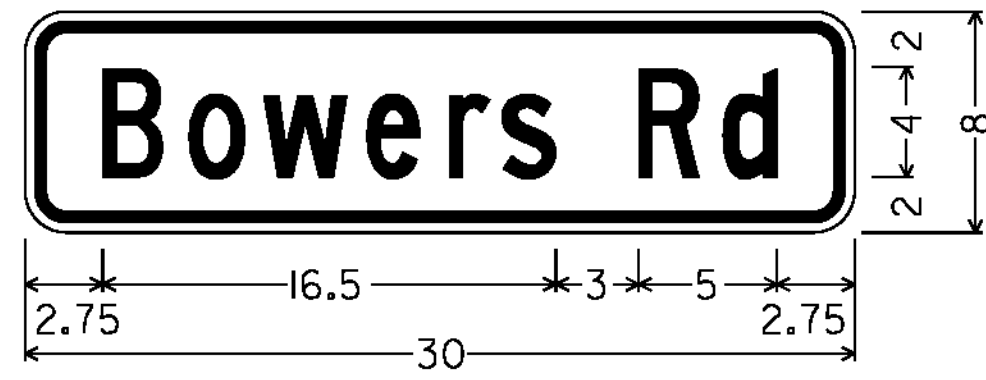


1,500" RADIUS, 0.375" BORDER, 0.375" INDENT,
BLACK ON YELLOW; [Bowers] 4"C, [Rd] 4"C
W16-8P

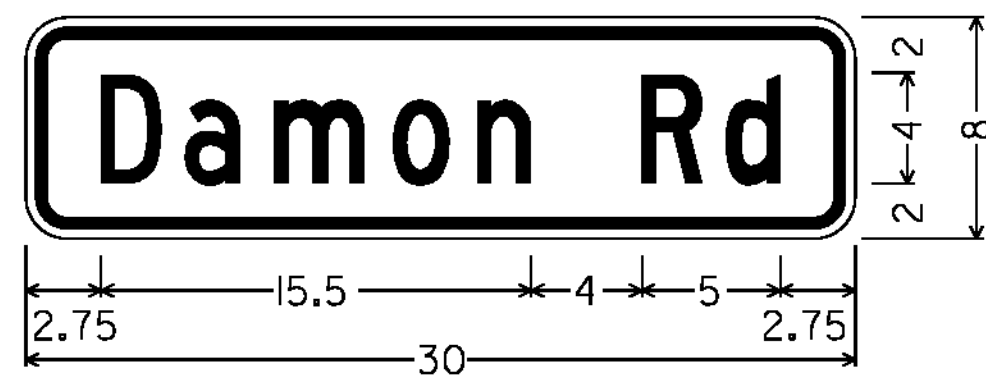


1,500" RADIUS, 0.375" BORDER, 0.375" INDENT,
BLACK ON YELLOW; [Damon] 4"C, [Rd] 4"C
W16-8P

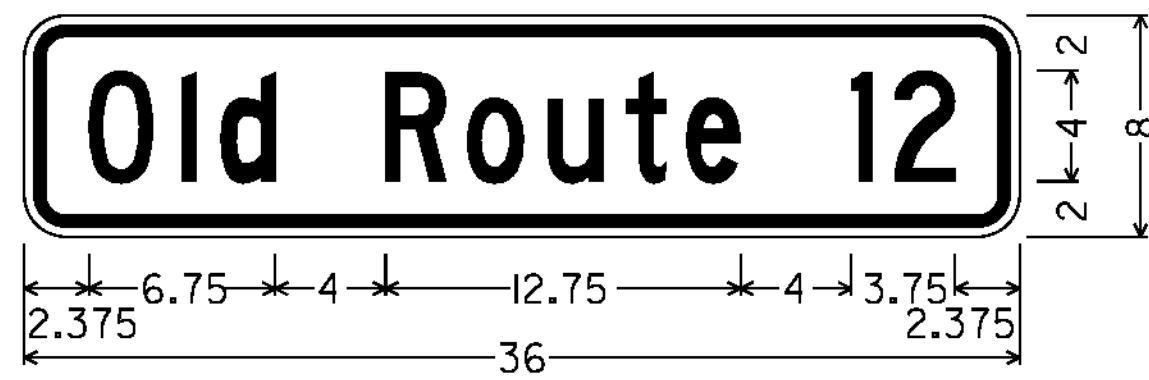

1,500" RADIUS, 0.375" BORDER, 0.375" INDENT,
BLACK ON YELLOW; [Old] 4"C, [Route] 4"C,
[12] 4"C @ 90% SPACING
W16-8P

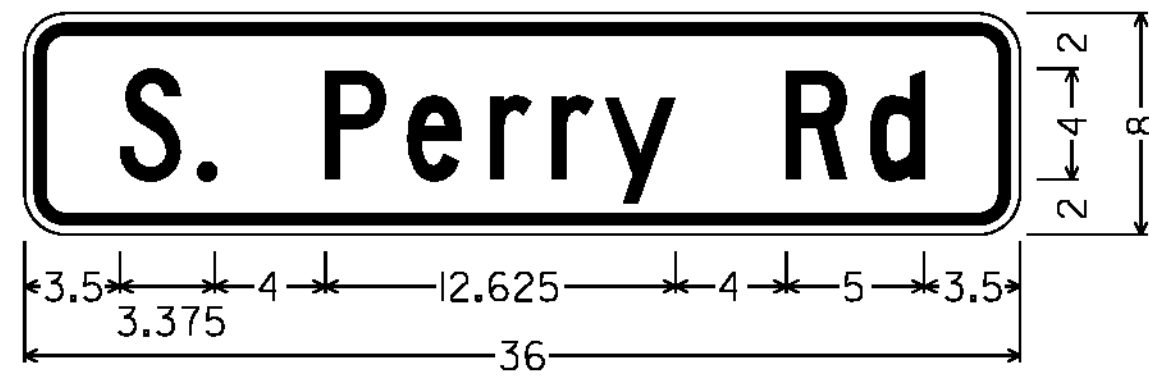


1,500" RADIUS, 0.375" BORDER, 0.375" INDENT,
BLACK ON YELLOW; [S.] 4"C, [Perry] 4"C,
[Rd] 4"C
W16-8P

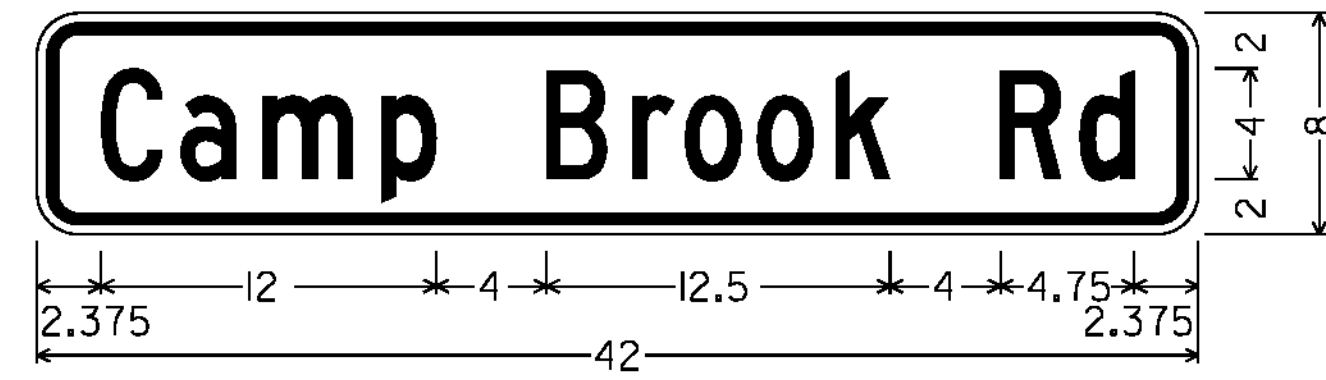


1,500" RADIUS, 0.375" BORDER, 0.375" INDENT,
BLACK ON YELLOW; [Camp] 4"C, [Brook] 4"C,
[Rd] 4"C @ 80% SPACING
W16-8P



1,875" RADIUS, 0.500" BORDER, 0.500" INDENT,
BLACK ON YELLOW; [Rhoades] 4"C @ 90%
SPACING, [Hill] 4"C
W16-8aP

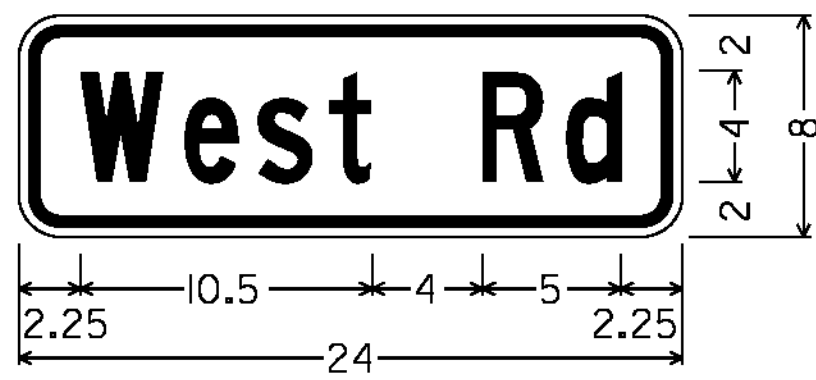


1,500" RADIUS, 0.375" BORDER, 0.375" INDENT,
BLACK ON YELLOW; [West] 4"C, [Rd] 4"C
W16-8P

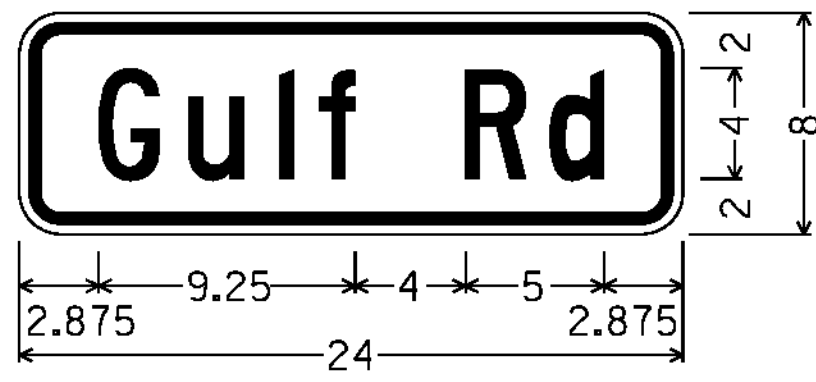


1,500" RADIUS, 0.375" BORDER, 0.375" INDENT,
BLACK ON YELLOW; [Gulf] 4"C, [Rd] 4"C
W16-8P



1,875" RADIUS, 0.500" BORDER, 0.500" INDENT,
BLACK ON YELLOW; [Hartland] 4"C, [Hill] 4"C,
[Rd] 4"C
W16-8aP

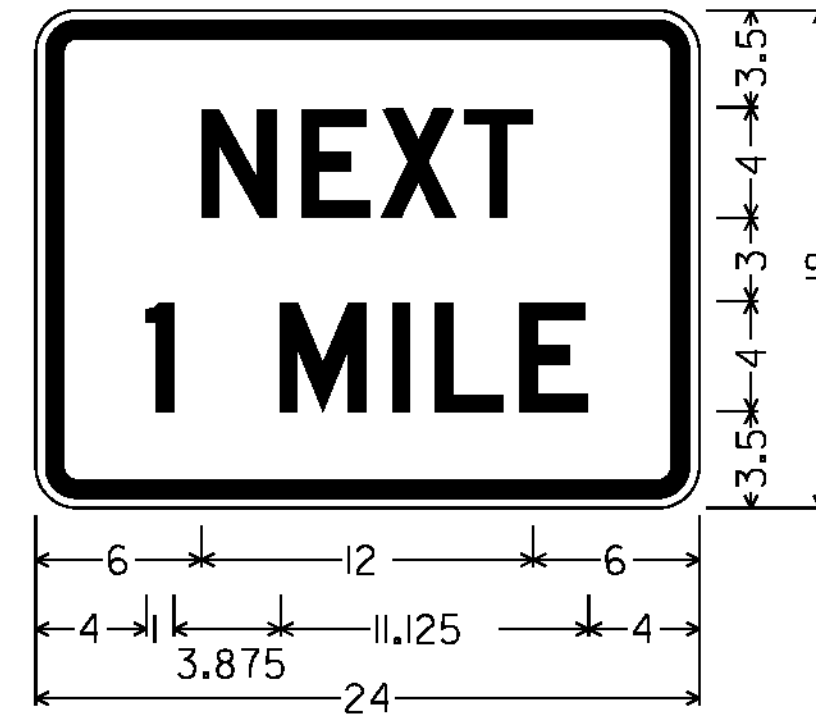


1,500" RADIUS, 0.625" BORDER, 0.375" INDENT,
BLACK ON YELLOW; [NEXT] 4"D; [1 MILE] 4"D
@ 96% SPACING
W7-3aP

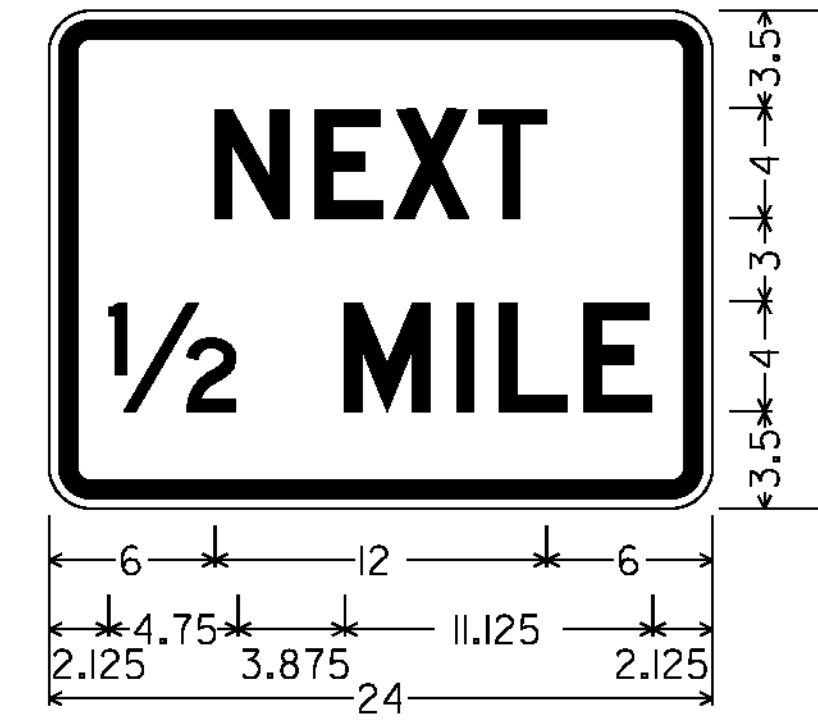


1,500" RADIUS, 0.625" BORDER, 0.375" INDENT,
BLACK ON YELLOW; [NEXT] 4"D; [1/2 MILE] 4"D
@ 96% SPACING
W7-3aP



1,500" RADIUS, 0.625" BORDER, 0.375" INDENT,
BLACK ON YELLOW; [STAY] 4"D, [ALERT] 4"D
VW-249

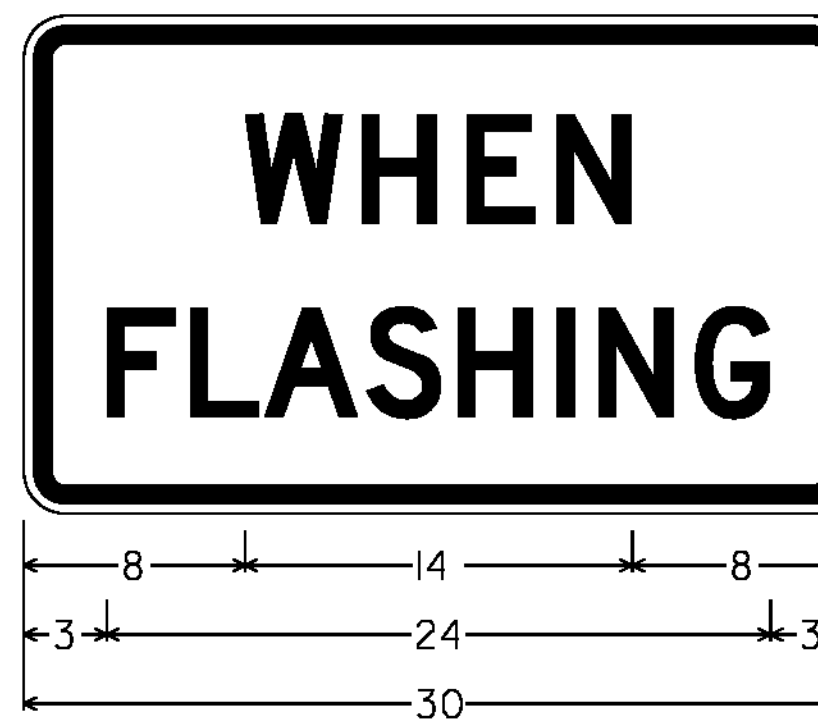

1,500" RADIUS, 0.625" BORDER, 0.375" INDENT,
BLACK ON YELLOW; [WHEN] 4"D, [FLASHING] 4"D
VW-158

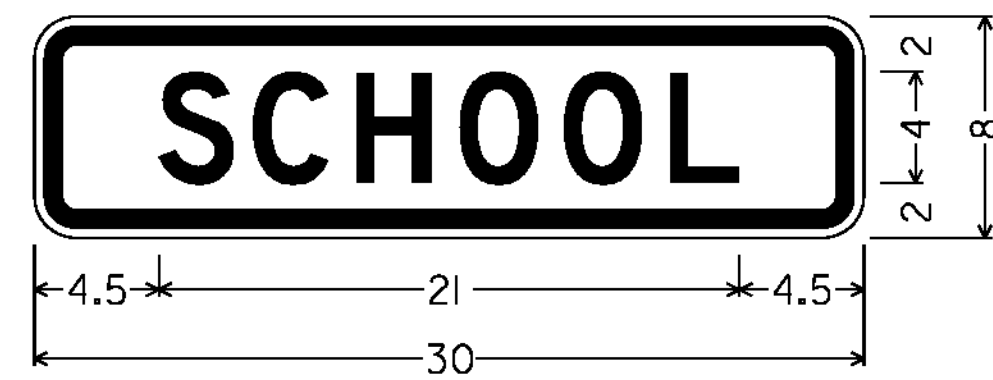

1,500" RADIUS, 0.625" BORDER, 0.375" INDENT,
BLACK ON FLUORESCENT YELLOW-GREEN;
[SCHOOL] 4"D
S4-3P


ALL DIMENSIONS SHOWN IN INCHES, EXCEPT WHERE NOTED.

NOT TO SCALE


PROJECT NAME: HARTLAND - BETHEL	
PROJECT NUMBER: STPG SIGN (40)	
FILE NAME: I2CI16.SD_5	PLOT DATE: 26-JUN-2012
PROJECT LEADER: A. GAMBLE	DRAWN BY: M. MILLER
DESIGNED BY: M. MILLER	CHECKED BY: A. GAMBLE
SIGN DETAILS 5	SHEET 8 OF 85




1,500" RADIUS, 0.375" BORDER, WHITE ON GREEN;
STANDARD ARROW 9.000" X 6.125" @ 180 DEG, [Rochester] 6"C, [10] 6"C

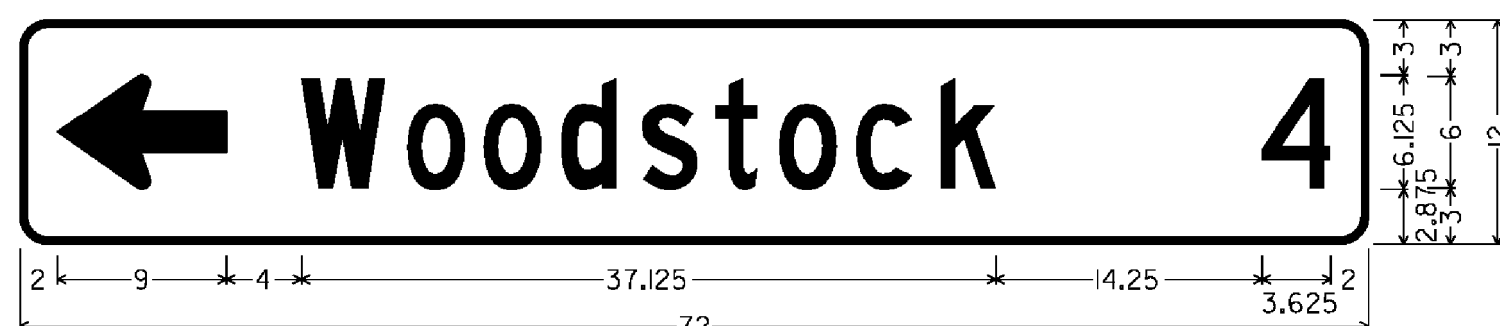

1,500" RADIUS, 0.375" BORDER, WHITE ON GREEN;
STANDARD ARROW 9.000" X 6.125" @ 180 DEG, [Woodstock] 6"C, [4] 6"C

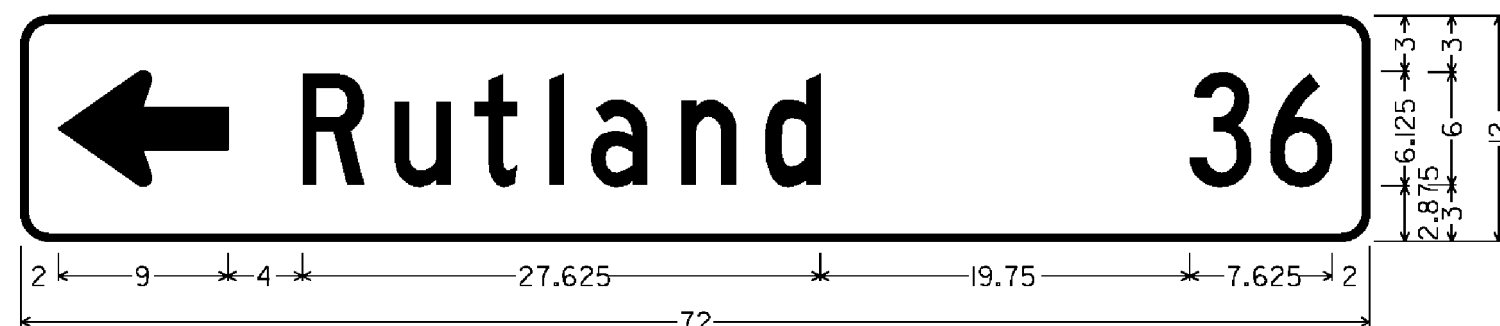


1,500" RADIUS, 0.375" BORDER, WHITE ON GREEN;
STANDARD ARROW 9.000" X 6.125" @ 180 DEG, [Rutland] 6"C, [36] 6"C

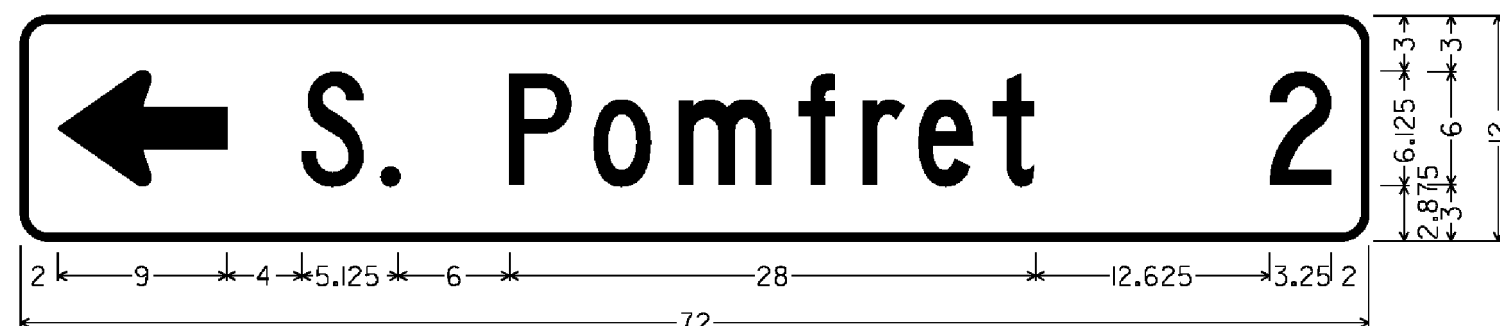

1,500" RADIUS, 0.375" BORDER, WHITE ON GREEN;
STANDARD ARROW 9.000" X 6.125" @ 180 DEG, [S. Pomfret] 6"C, [2] 6"C




1,500" RADIUS, 0.375" BORDER, WHITE ON GREEN;
STANDARD ARROW 9.000" X 6.125" @ 180 DEG, [W. Woodstock] 6"C @ 90% SPACING, [2] 6"C

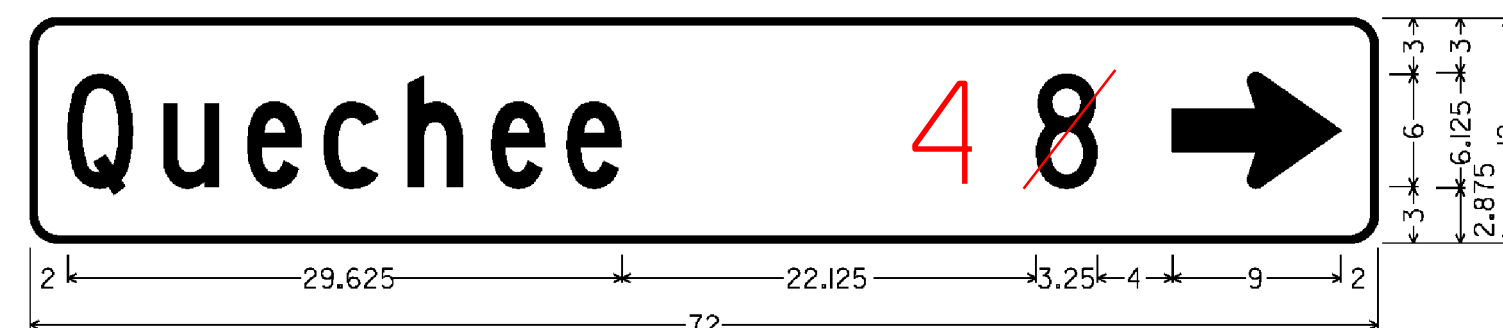

1,500" RADIUS, 0.375" BORDER, WHITE ON GREEN;
[Quechee] 6"C, [8] 6"C, STANDARD ARROW 9.000" X 6.125" @ 0 DEG


SEE NOTE ON SHEET #24
FOR NB MM 7.602

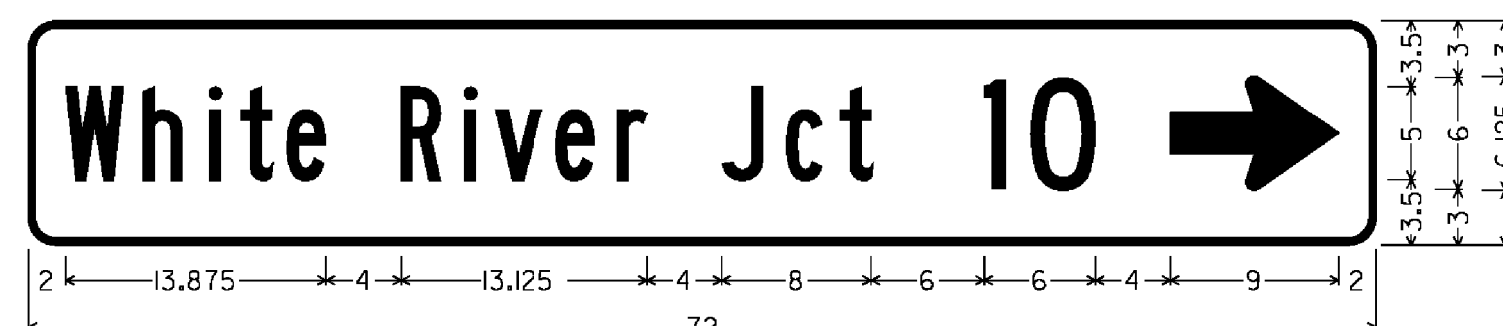


1,500" RADIUS, 0.375" BORDER, WHITE ON GREEN;
[White] 5"B, [River] 5"B, [Jct] 5"B, [10] 6"C, STANDARD ARROW 9.000" X 6.125" @ 0 DEG



1,500" RADIUS, 0.375" BORDER, WHITE ON GREEN;
[W. Woodstock] 6"C @ 86% SPACING, [2] 6"C, STANDARD ARROW 9.000" X 6.125" @ 0 DEG

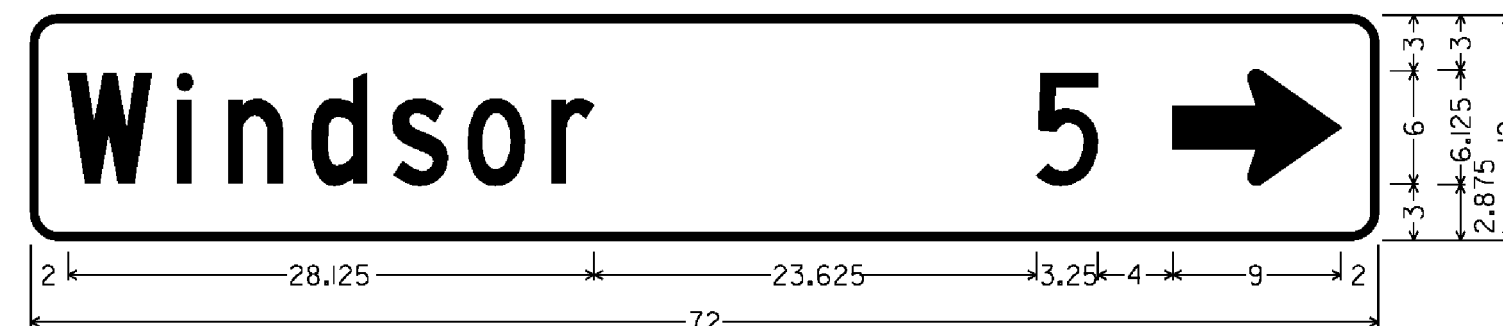

1,500" RADIUS, 0.375" BORDER, WHITE ON GREEN;
[Windsor] 6"C, [5] 6"C, STANDARD ARROW 9.000" X 6.125" @ 0 DEG

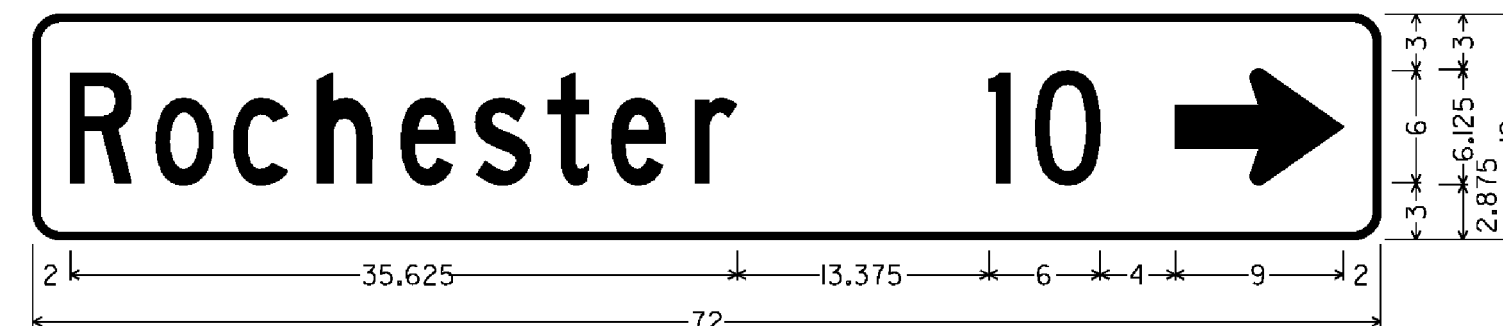


1,500" RADIUS, 0.375" BORDER, WHITE ON GREEN;
[Rochester] 6"C, [10] 6"C, STANDARD ARROW 9.000" X 6.125" @ 0 DEG

ALL DIMENSIONS SHOWN IN INCHES, EXCEPT WHERE NOTED.


ALL SIGNS ON THIS PAGE ARE SIGN CODE VDI-1A

NOT TO SCALE


PROJECT NAME:	HARTLAND - BETHEL	FILE NAME:	I2CH6.SD_6	PLOT DATE:	27-JUN-2012
PROJECT NUMBER:	STPG SIGN (40)	PROJECT LEADER:	A. GAMBLE	DRAWN BY:	M. MILLER
DESIGNED BY:	M. MILLER	CHECKED BY:	A. GAMBLE	SHEET	9 OF 85
SIGN DETAILS	6				

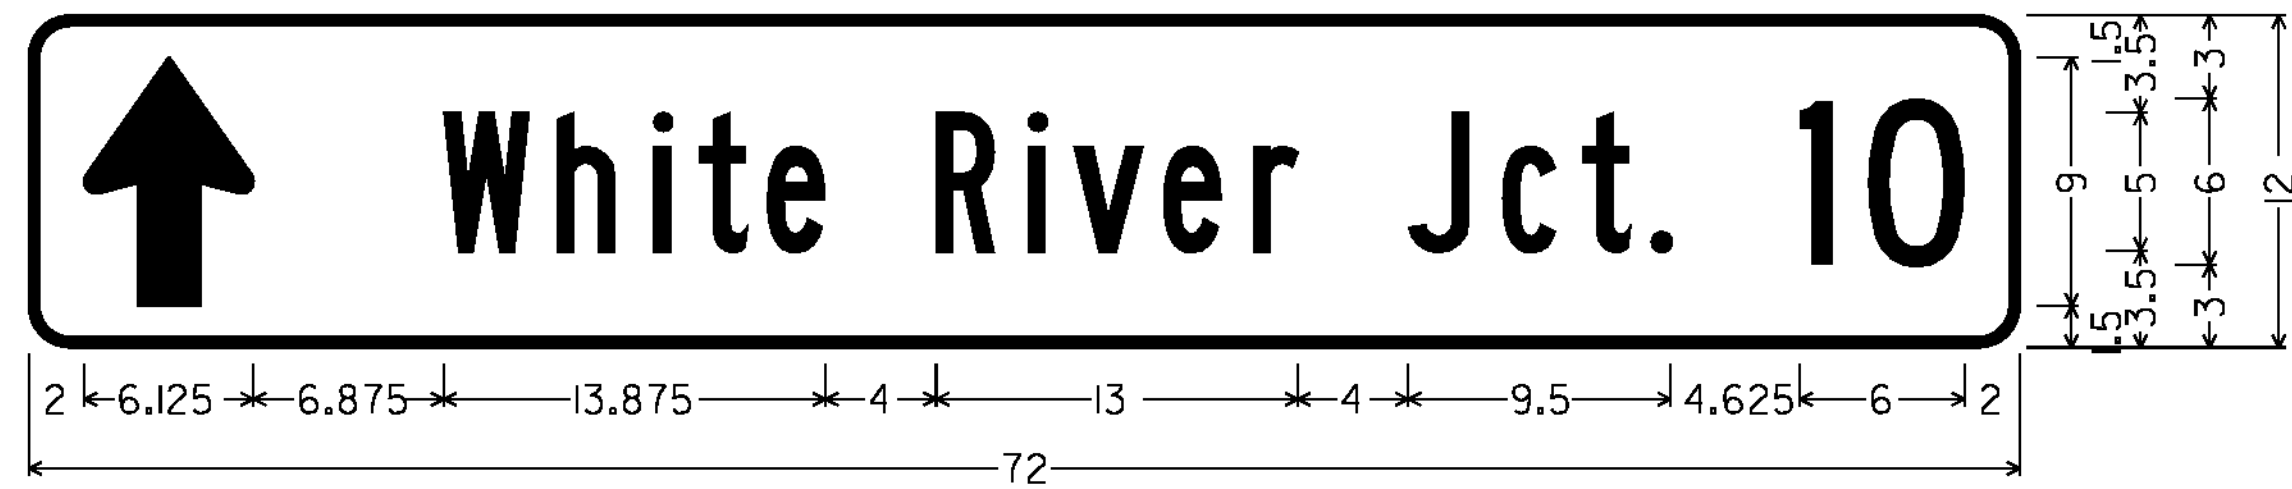


1.500" RADIUS, 0.375" BORDER, WHITE ON GREEN;
STANDARD ARROW 9.000" X 6.125" @ 90 DEG, [White River Jct.] 5"B, [10] 6"C
VDI-1A

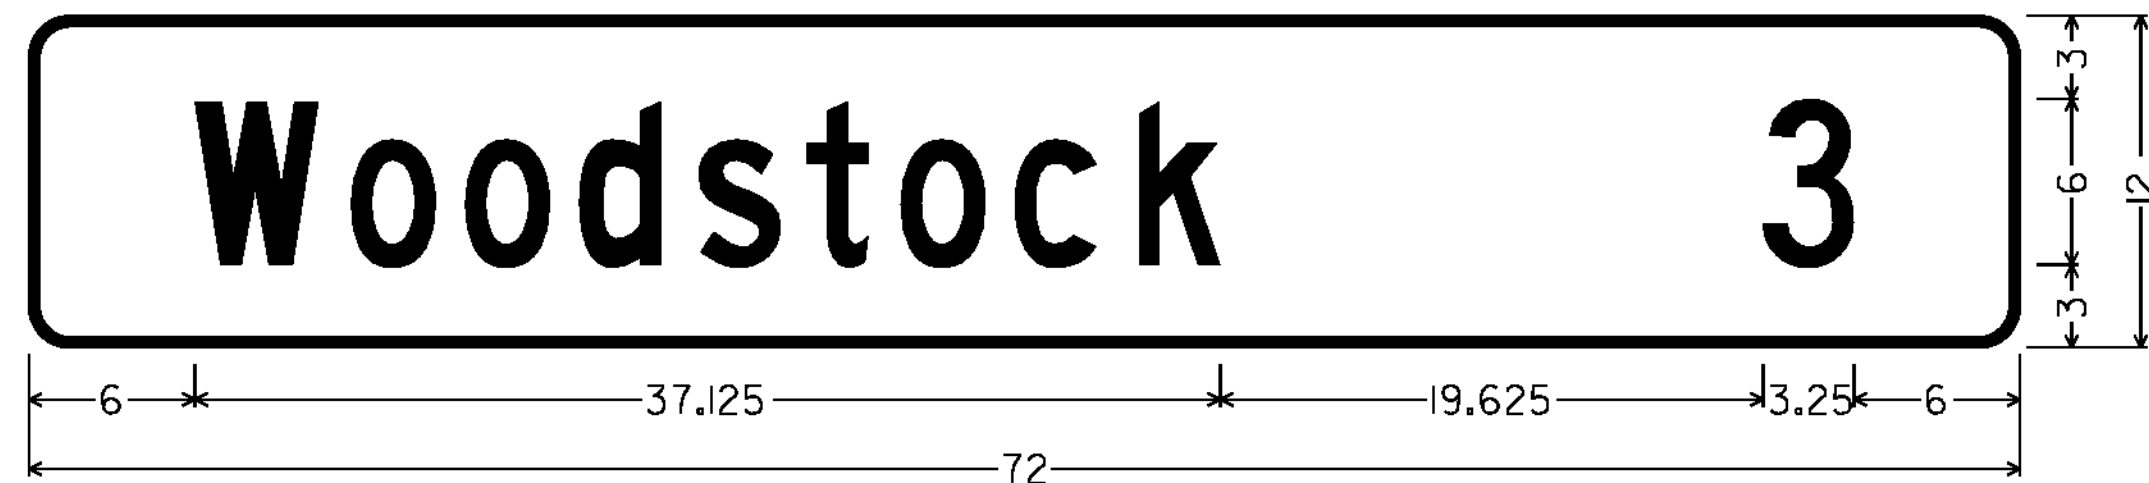


1.500" RADIUS, 0.375" BORDER, WHITE ON GREEN;
[Woodstock] 6"C, [3] 6"C
VD2-1

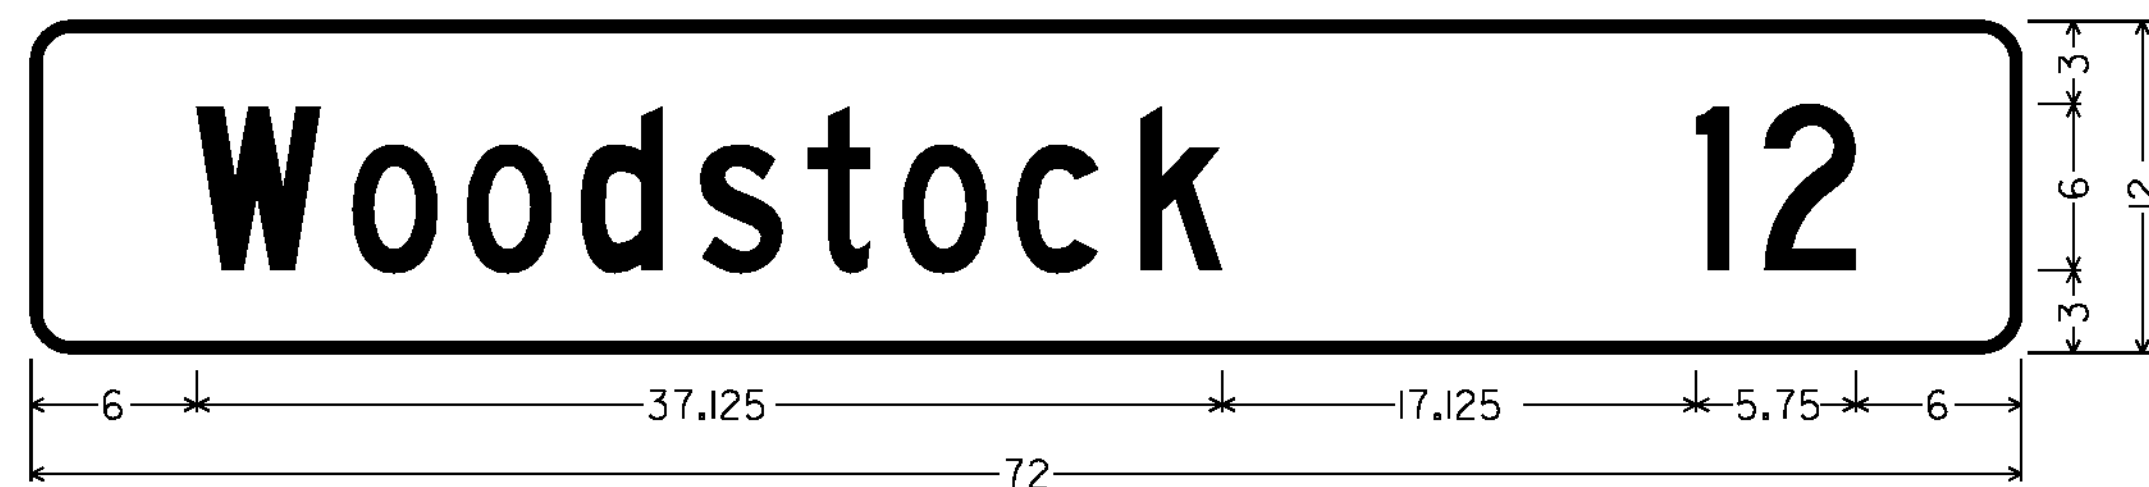


1.500" RADIUS, 0.375" BORDER, WHITE ON GREEN;
[Woodstock] 6"C, [12] 6"C
VD2-1

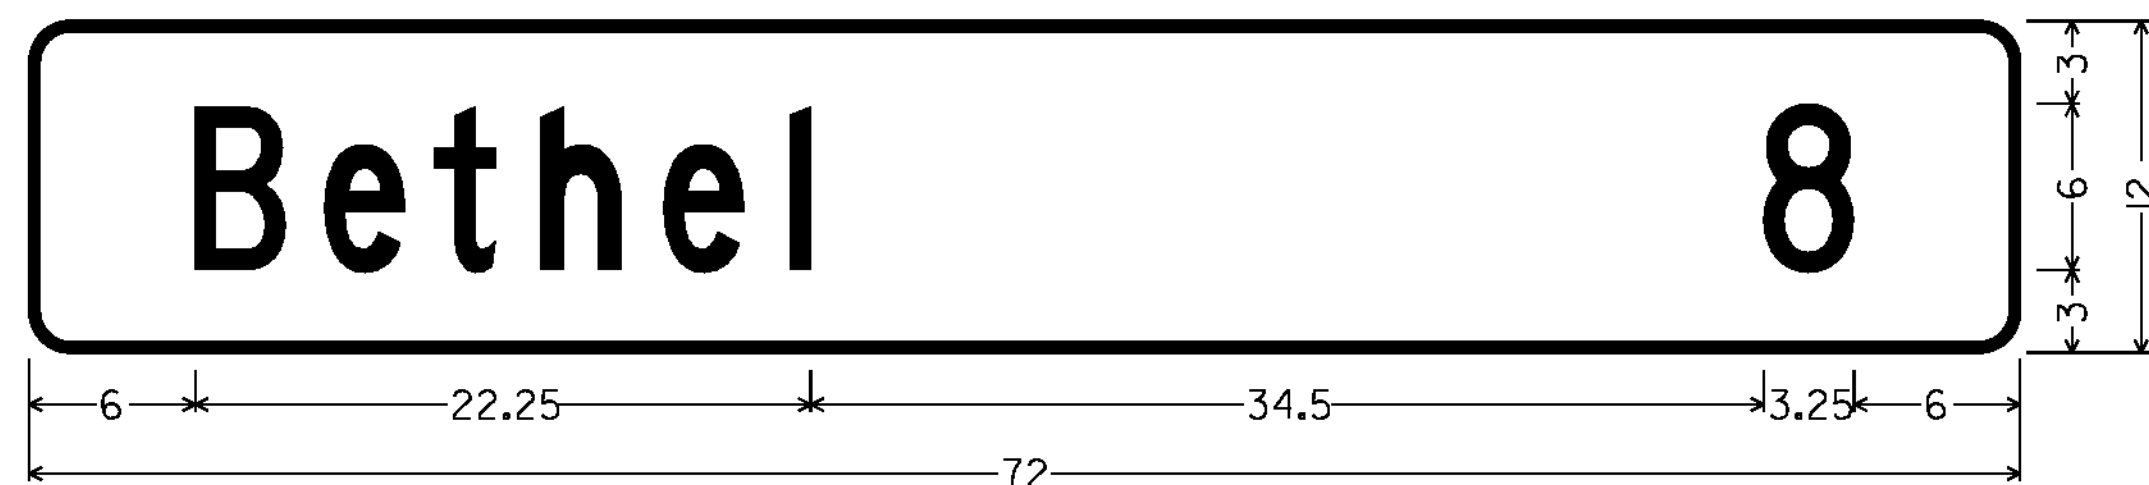


1.500" RADIUS, 0.375" BORDER, WHITE ON GREEN;
[Bethel] 6"C, [8] 6"C
VD2-1

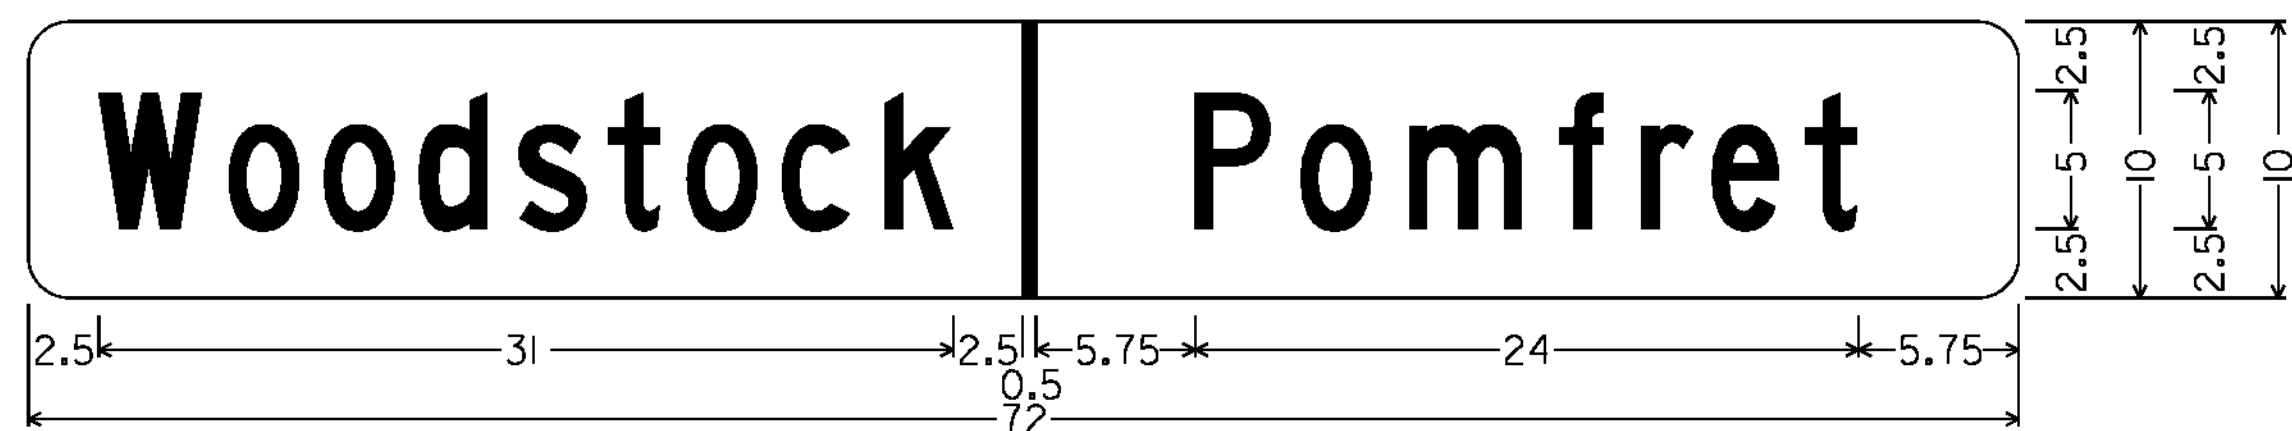


1.500" RADIUS, NO BORDER, WHITE ON GREEN;
[Woodstock] 5"C, [Pomfret] 5"C
VD-024

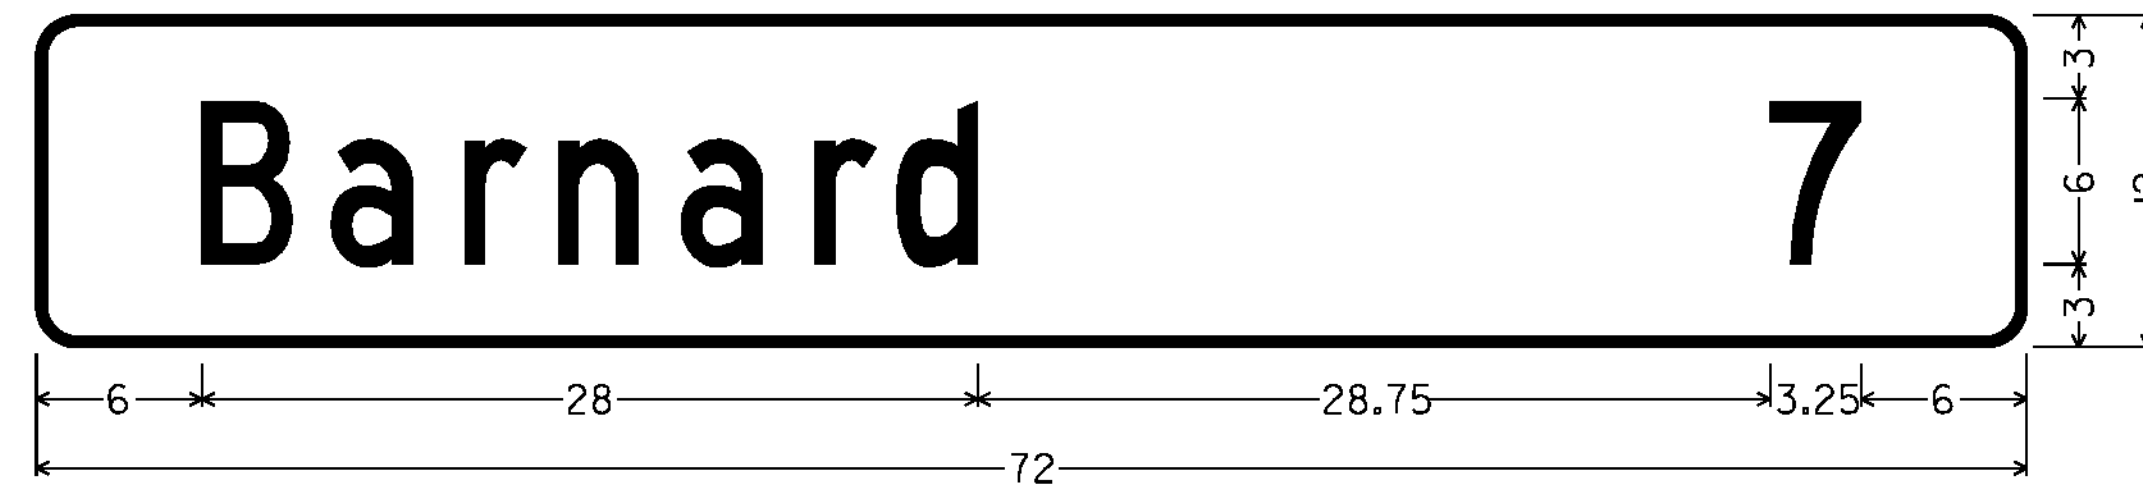


1.500" RADIUS, 0.375" BORDER, WHITE ON GREEN;
[Barnard] 6"C, [7] 6"C
VD2-1

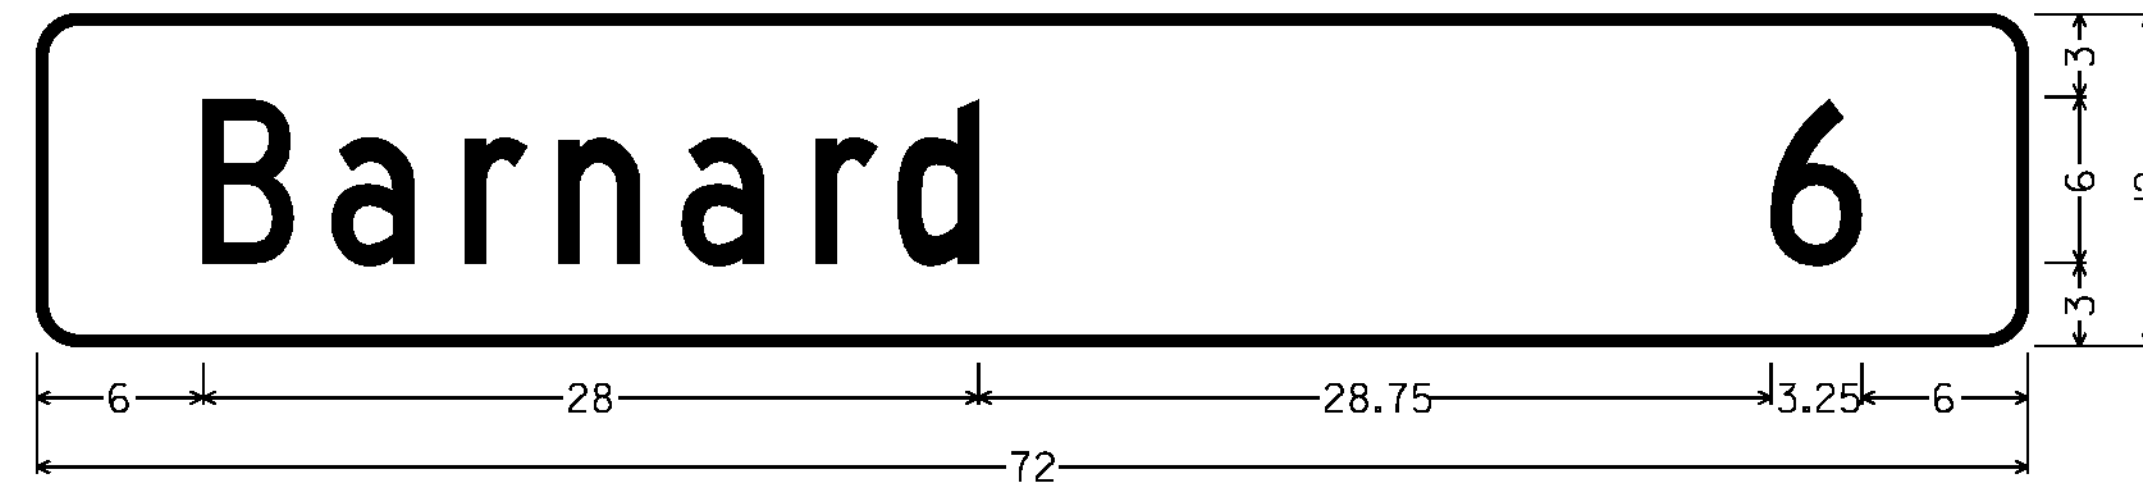


1.500" RADIUS, 0.375" BORDER, WHITE ON GREEN;
[Barnard] 6"C, [6] 6"C
VD2-1

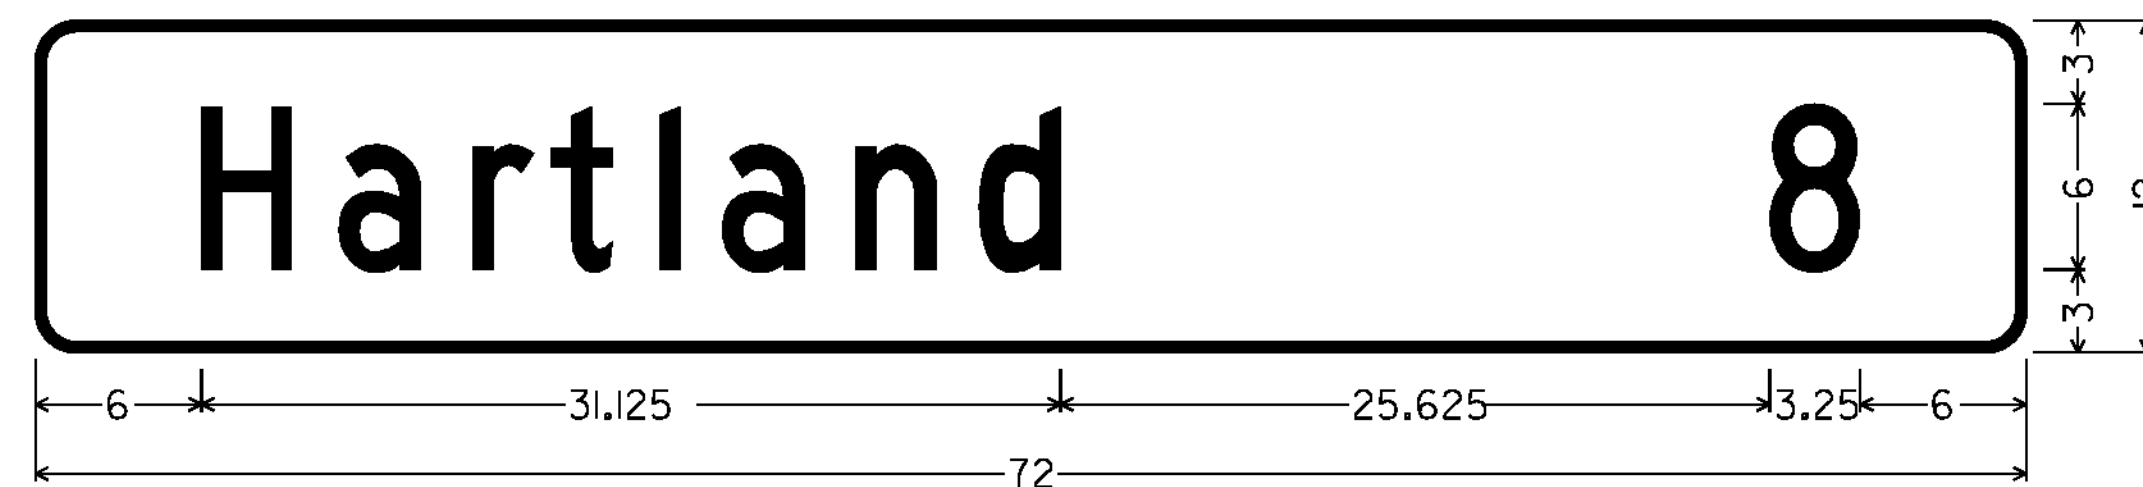

1.500" RADIUS, 0.375" BORDER, WHITE ON GREEN;
[Hartland] 6"C, [8] 6"C
VD2-1

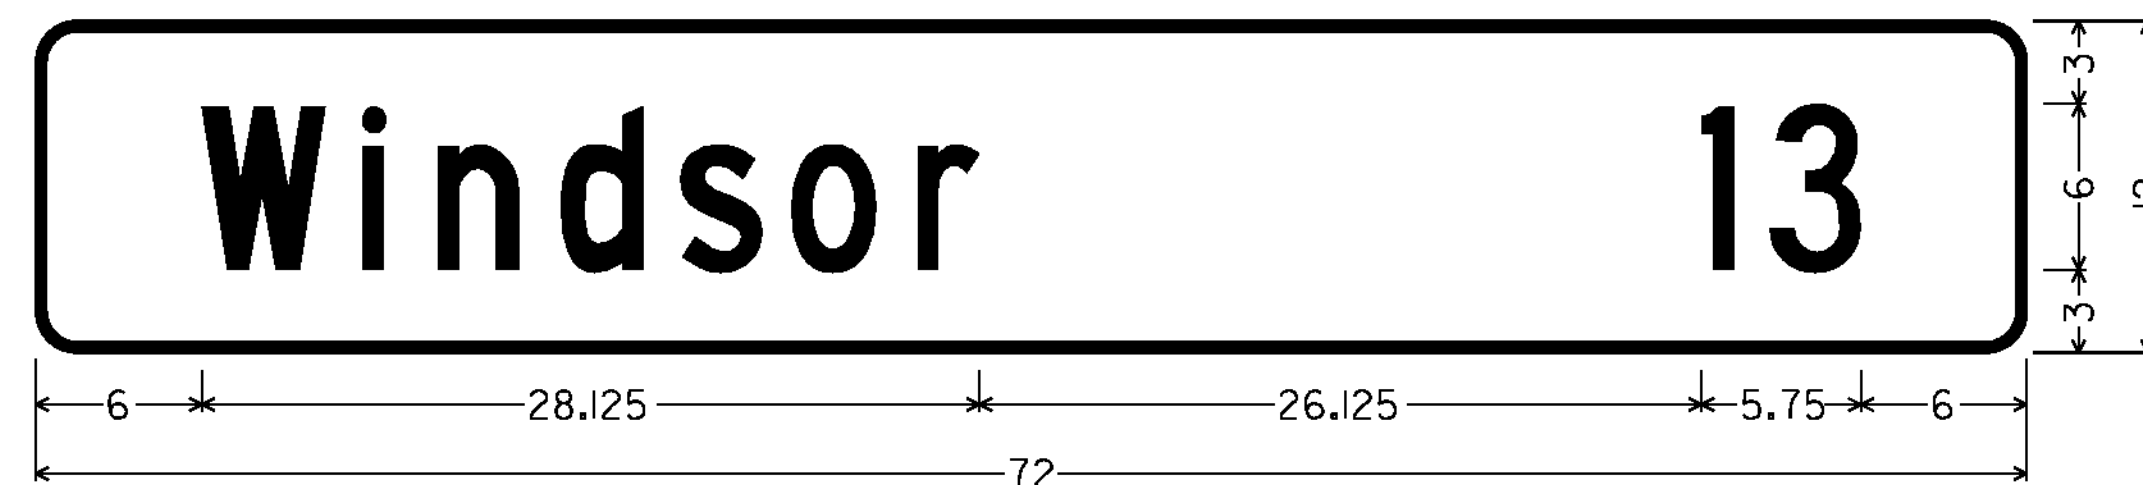

1.500" RADIUS, 0.375" BORDER, WHITE ON GREEN;
[Windsor] 6"C, [13] 6"C
VD2-1

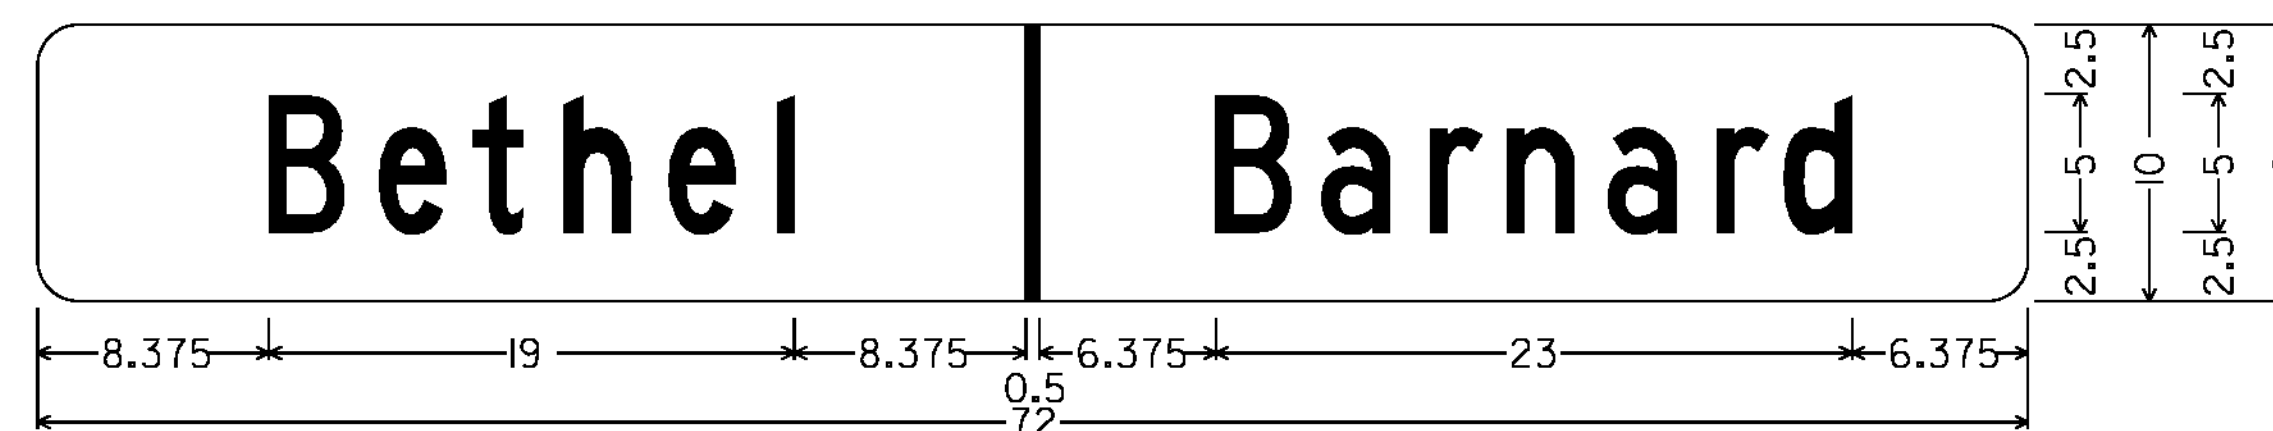


1.500" RADIUS, NO BORDER, WHITE ON GREEN;
[Bethel] 5"C, [Barnard] 5"C
VD-024

ALL DIMENSIONS SHOWN IN INCHES, UNLESS OTHERWISE NOTED.

NOT TO SCALE

PROJECT NAME: HARTLAND - BETHEL	
PROJECT NUMBER: STPG SIGN (40)	
FILE NAME: I2CI6.SD.7	PLOT DATE: 26-JUN-2012
PROJECT LEADER: A. GAMBLE	DRAWN BY: M. MILLER
DESIGNED BY: M. MILLER	CHECKED BY: A. GAMBLE
SIGN DETAILS 7	SHEET 10 OF 85

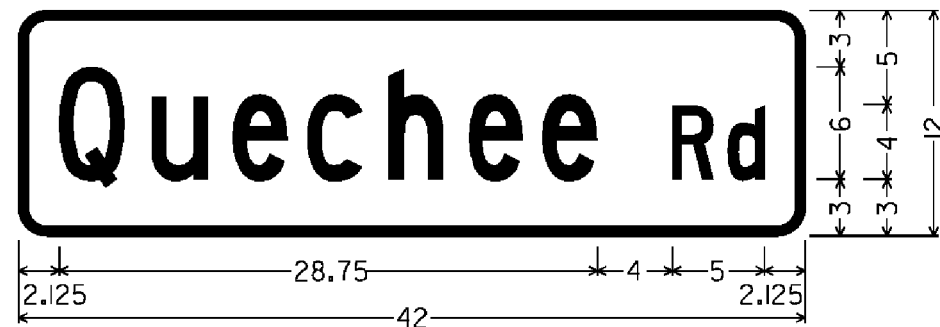


1.500" RADIUS, 0.500" BORDER, WHITE ON GREEN;
[Quechee] 6"C, [Rd] 4"C @ 90% SPACING


THIS SIGN WAS RE-DESIGNED WITH THE NEW SPELLING.
SEE SHEET #17.




1.500" RADIUS, 0.500" BORDER, WHITE ON GREEN;
[Bishoff] 6"C, [Ln] 4"C

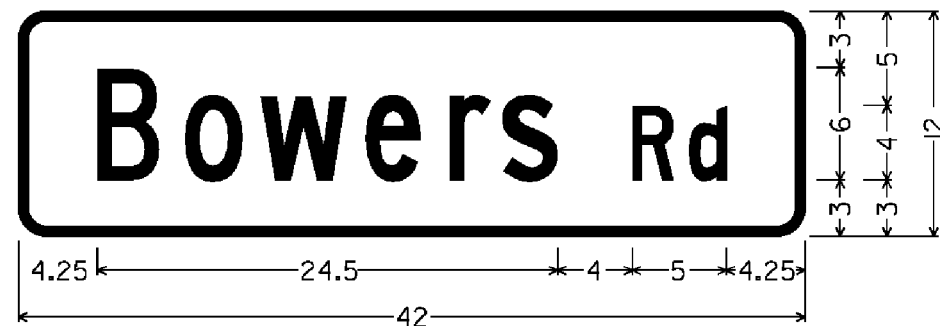


1.500" RADIUS, 0.500" BORDER, WHITE ON GREEN;
[Bowers] 6"C, [Rd] 4"C

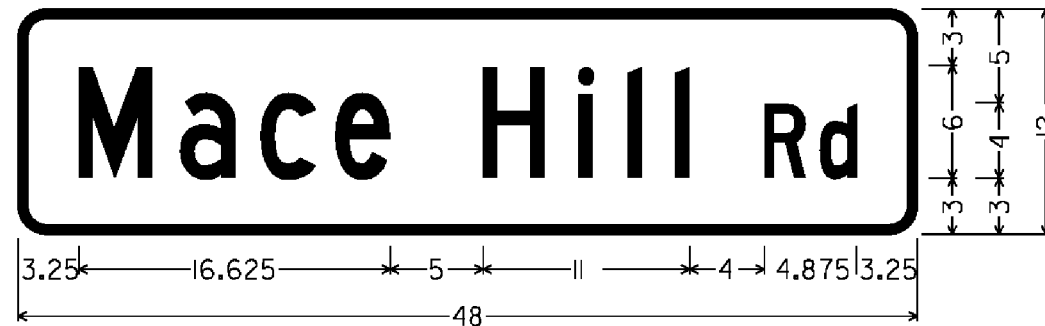


1.500" RADIUS, 0.500" BORDER, WHITE ON GREEN;
[Mace Hill] 6"C, [Rd] 4"C @ 90% SPACING

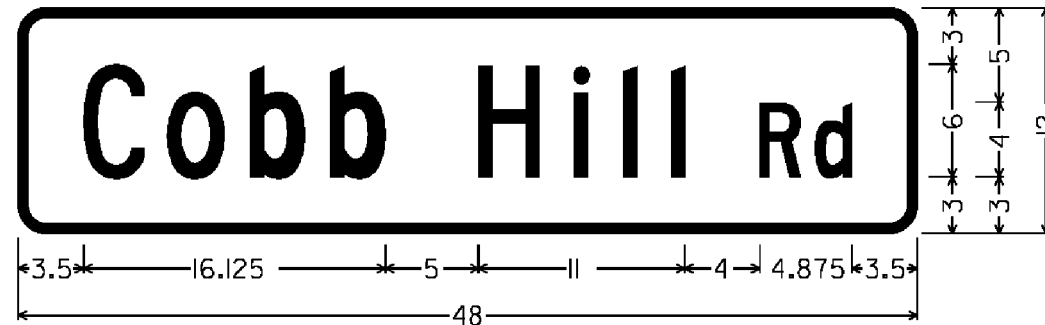


1.500" RADIUS, 0.500" BORDER, WHITE ON GREEN;
[Cobb Hill] 6"C, [Rd] 4"C @ 90% SPACING

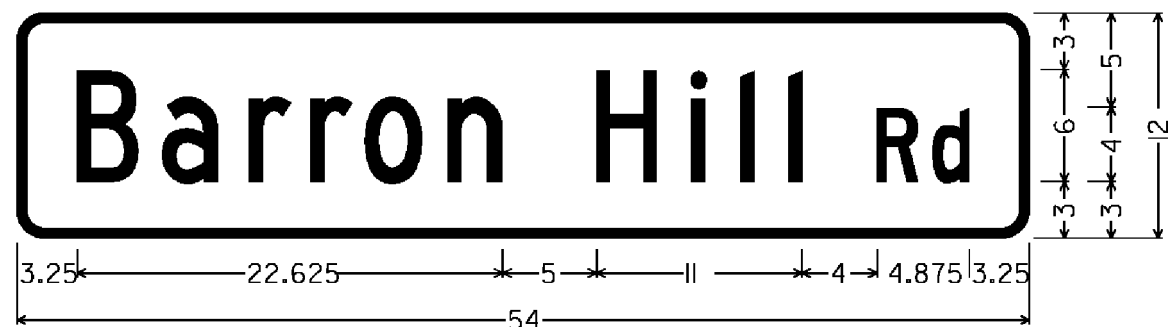


1.500" RADIUS, 0.500" BORDER, WHITE ON GREEN;
[Barron Hill] 6"C, [Rd] 4"C @ 90% SPACING

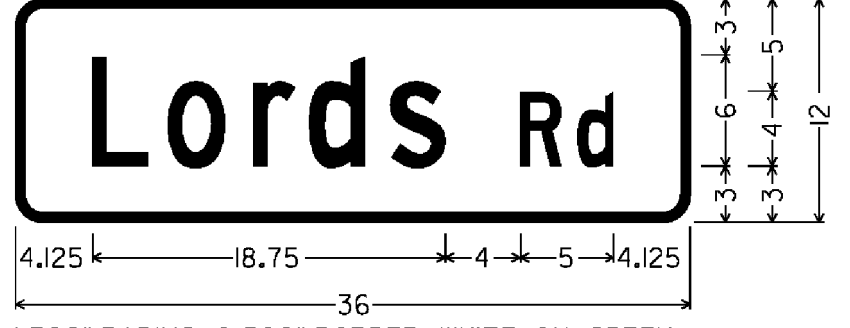


1.500" RADIUS, 0.500" BORDER, WHITE ON GREEN;
[Lords] 6"C, [Rd] 4"C

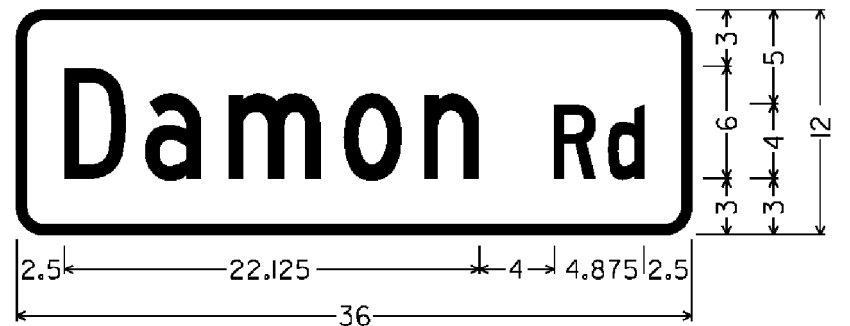

1.500" RADIUS, 0.500" BORDER, WHITE ON GREEN;
[Damon Rd] 6"C @ 80% SPACING

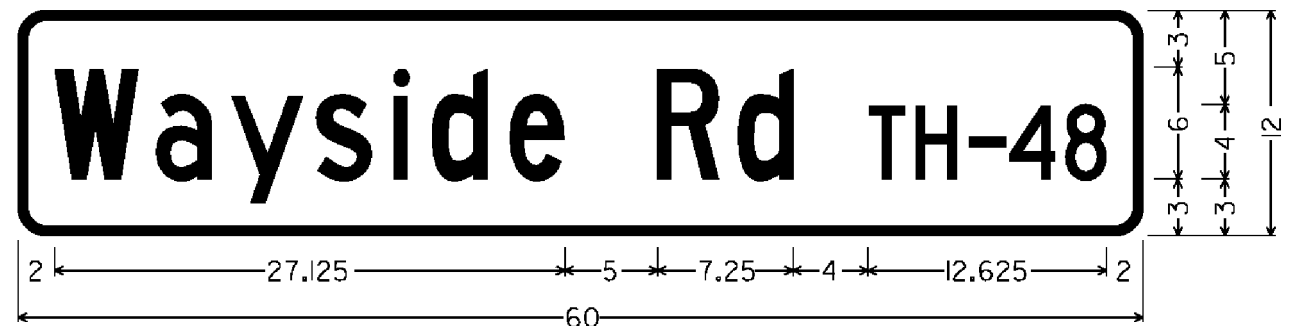


1.500" RADIUS, 0.500" BORDER, WHITE ON GREEN;
[Wayside Rd] 6"C, [TH-48] 4"C @ 80% SPACING

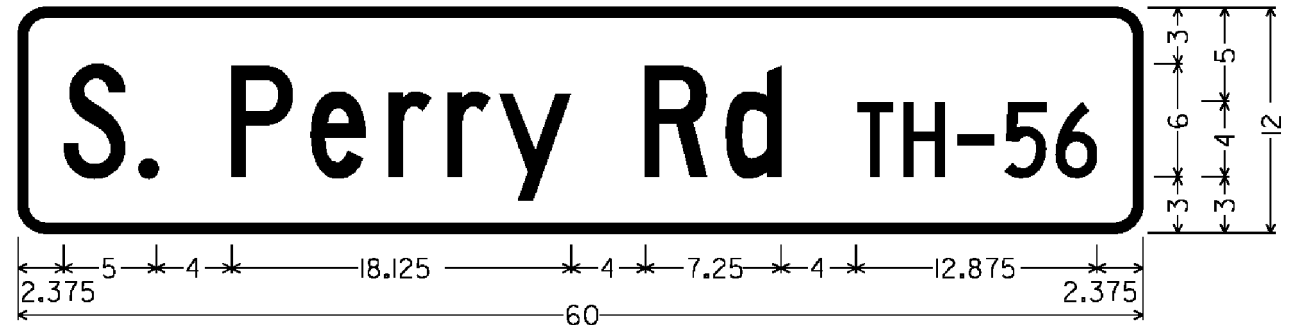


1.500" RADIUS, 0.500" BORDER, WHITE ON GREEN;
[S. Perry Rd] 6"C, [TH-56] 4"C @ 80% SPACING




1.500" RADIUS, 0.500" BORDER, WHITE ON GREEN;
[Hartland Hill] 6"C, [Rd] 4"C @ 80% SPACING

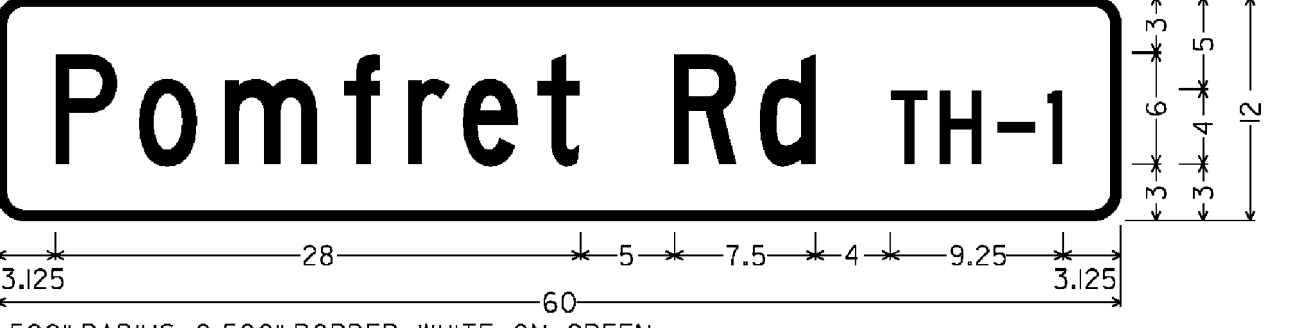


1.500" RADIUS, 0.500" BORDER, WHITE ON GREEN;
[Pomfret Rd] 6"C, [TH-1] 4"C

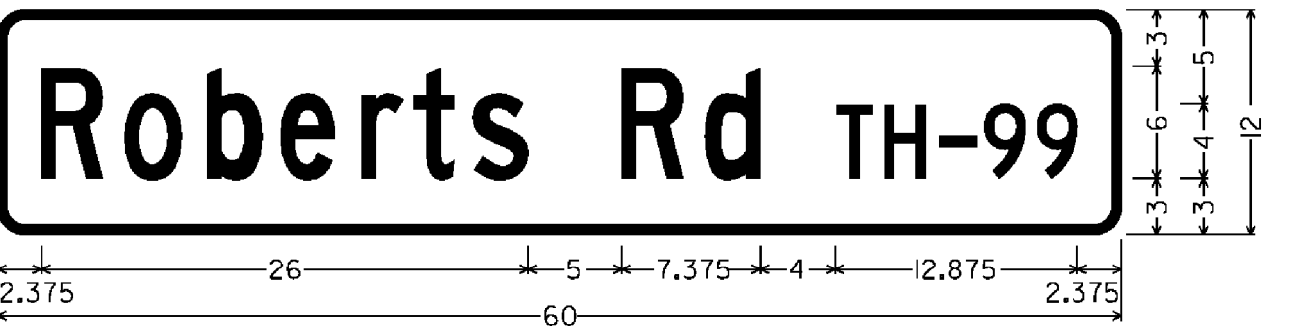

1.500" RADIUS, 0.500" BORDER, WHITE ON GREEN;
[Roberts Rd] 6"C, [TH-99] 4"C @ 90% SPACING

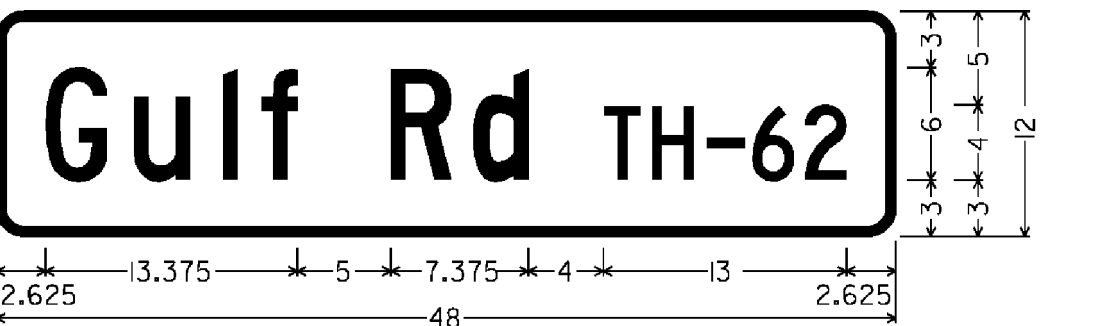

1.500" RADIUS, 0.500" BORDER, WHITE ON GREEN;
[Gulf Rd] 6"C, [TH-62] 4"C @ 90% SPACING

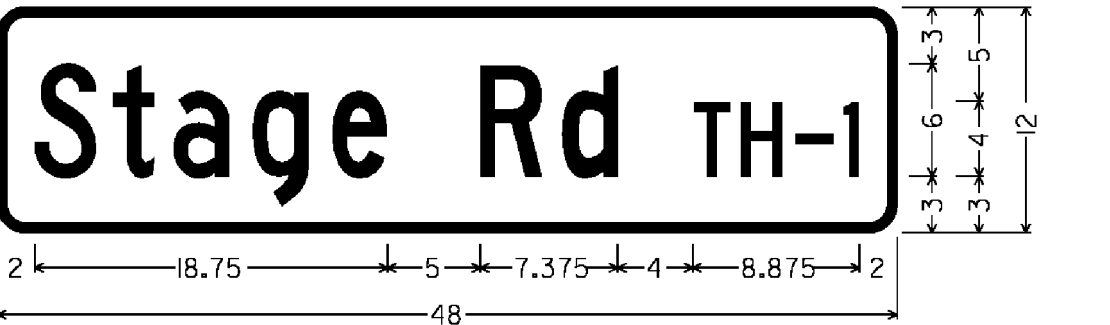


1.500" RADIUS, 0.500" BORDER, WHITE ON GREEN;
[Stage Rd] 6"C, [TH-1] 4"C @ 85% SPACING


ALL SIGNS ON THIS PAGE ARE SIGN CODE D3-1
(ALL SIGNS ARE DOUBLE-SIDED)

NOT TO SCALE


ALL DIMENSIONS SHOWN IN INCHES, EXCEPT WHERE NOTED.	
PROJECT NAME: HARTLAND - BETHEL	
PROJECT NUMBER: STPG SIGN (40)	
FILE NAME: I2C16.SD.8	PLOT DATE: 26-JUN-2012
PROJECT LEADER: A. GAMBLE	DRAWN BY: M. MILLER
DESIGNED BY: M. MILLER	CHECKED BY: A. GAMBLE
SIGN DETAILS 8	SHEET 11 OF 85

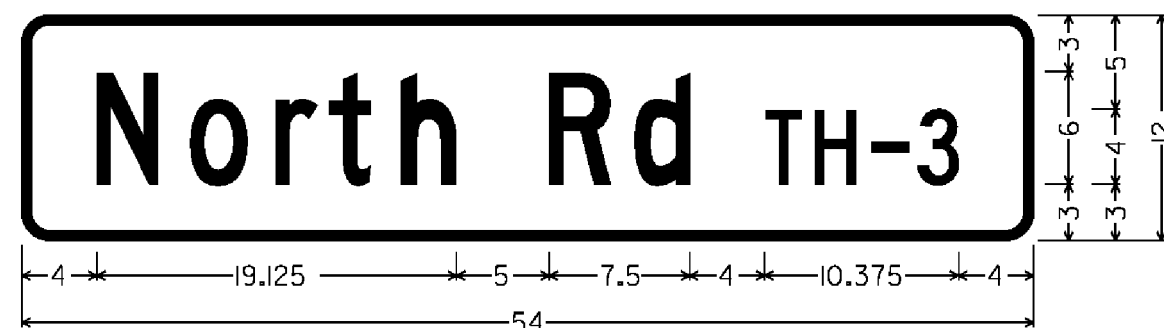


1,500" RADIUS, 0,500" BORDER, WHITE ON GREEN;
[North Rd] 6"C, [TH-3] 4"C

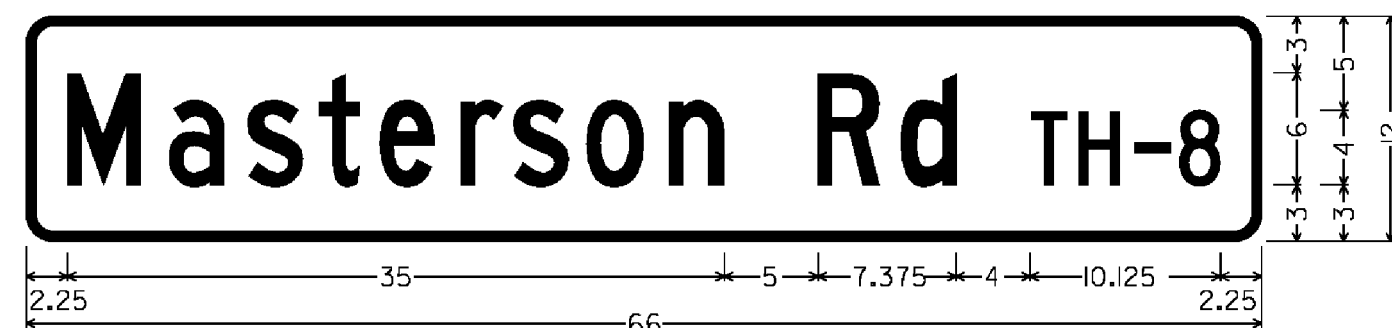


1,500" RADIUS, 0,500" BORDER, WHITE ON GREEN; [Masterson Rd] 6"C, [TH-8] 4"C @ 90% SPACING
1,500" RADIUS, 0,500" BORDER, WHITE ON GREEN; [Masterson Rd] 6"C, [TH-8] 4"C @ 90% SPACING

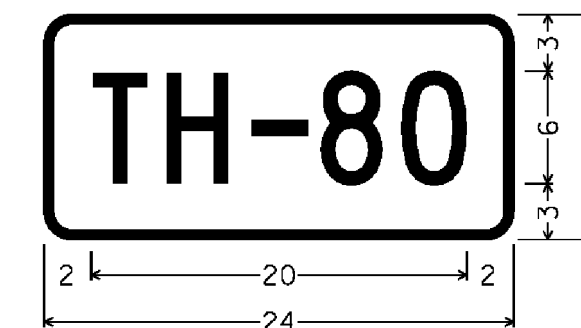


1,500" RADIUS, 0,500" BORDER, WHITE ON GREEN;
[TH-80] 6"C

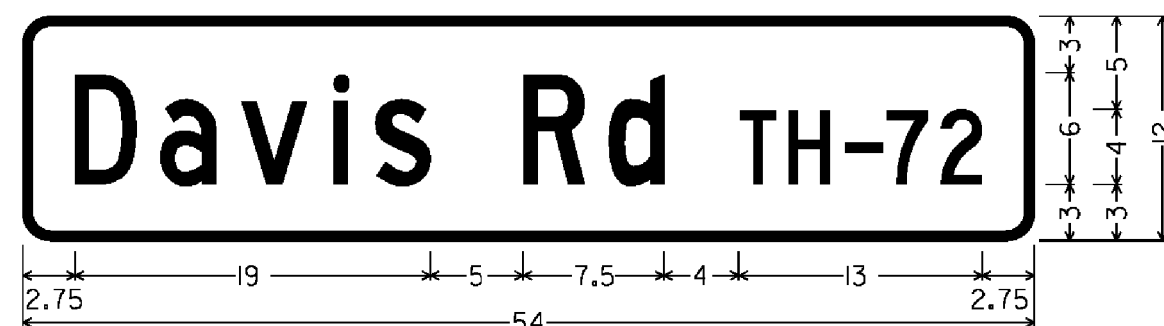


1,500" RADIUS, 0,500" BORDER, WHITE ON GREEN;
[Davis Rd] 6"C, [TH-72] 4"C

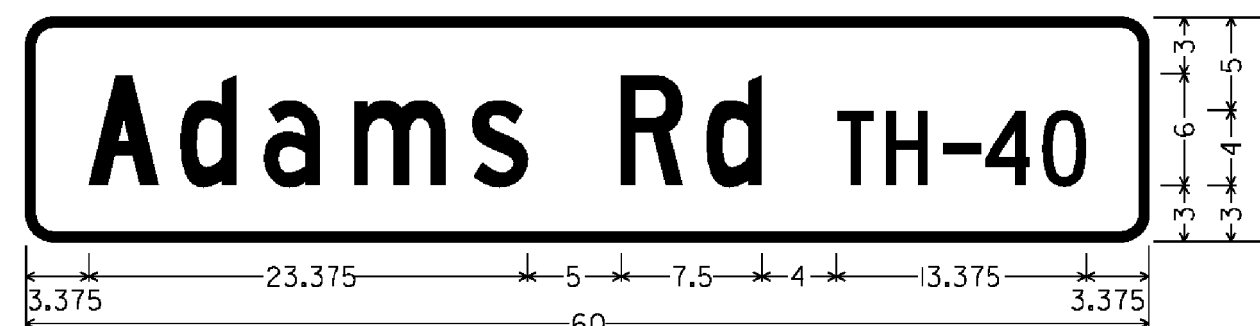


1,500" RADIUS, 0,500" BORDER, WHITE ON GREEN;
[Adams Rd] 6"C, [TH-40] 4"C

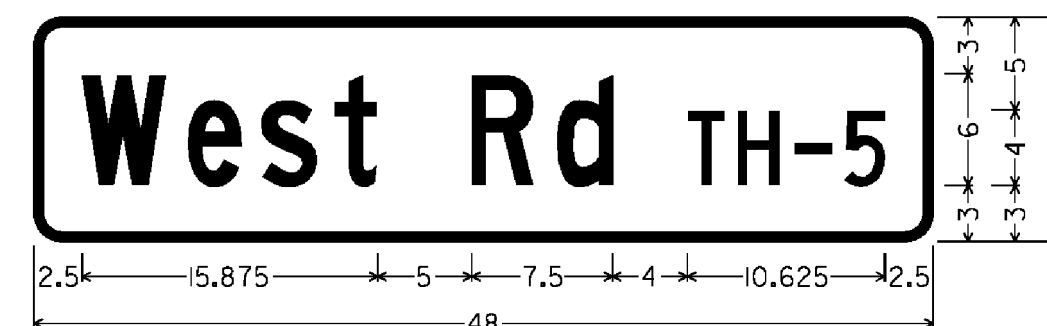


1,500" RADIUS, 0,500" BORDER, WHITE ON GREEN;
[West Rd] 6"C, [TH-5] 4"C

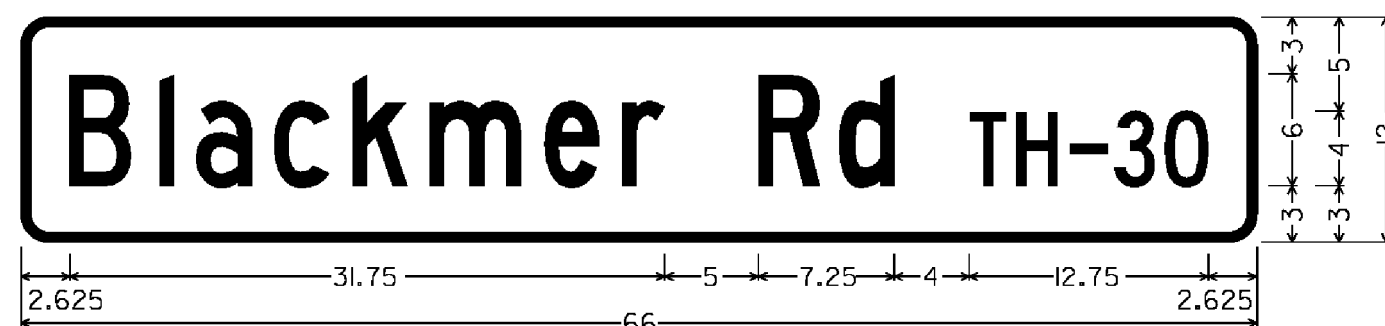


1,500" RADIUS, 0,500" BORDER, WHITE ON GREEN;
[Blackmer Rd] 6"C, [TH-30] 4"C @ 80% SPACING

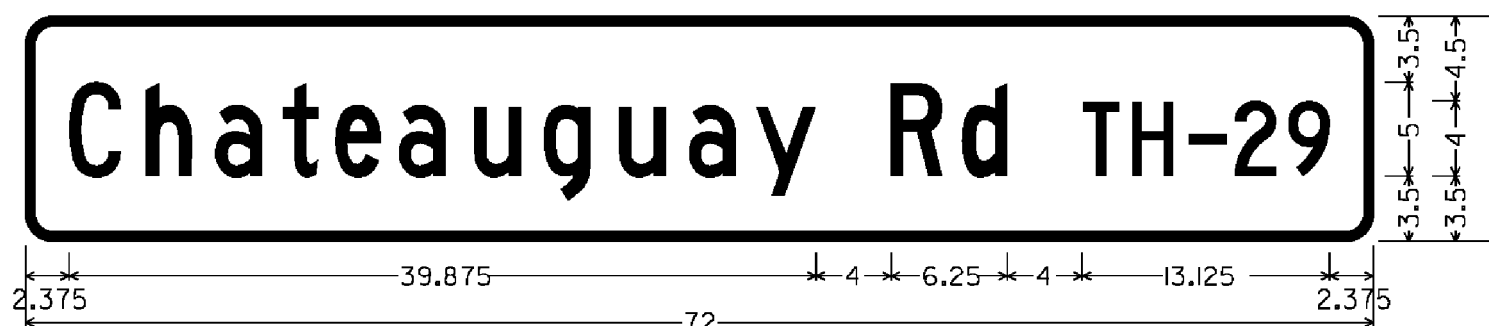


1,500" RADIUS, 0,500" BORDER, WHITE ON GREEN;
[Chateauguay Rd] 5"C, [TH-29] 4"C

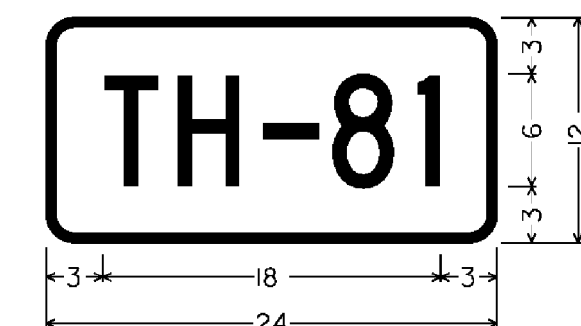


1,500" RADIUS, 0,500" BORDER, WHITE ON GREEN;
[TH-81] 6"C

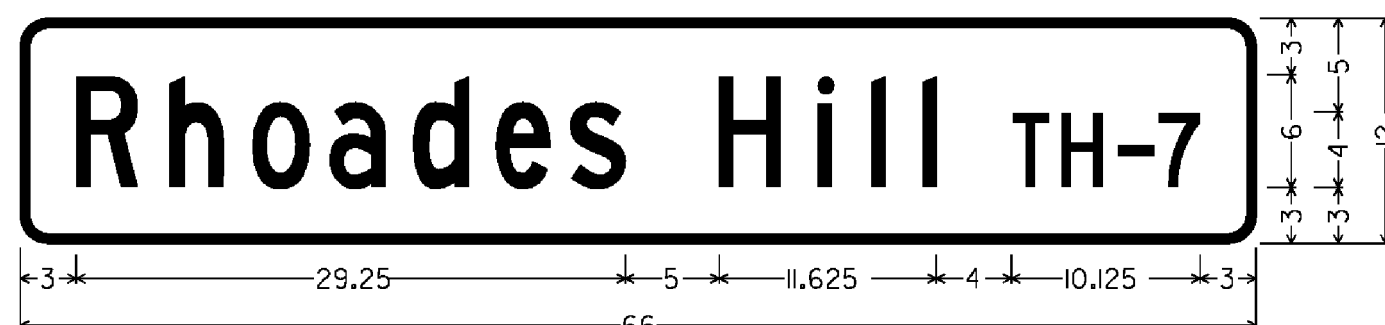

1,500" RADIUS, 0,500" BORDER, WHITE ON GREEN;
[Rhoades Hill] 6"C, [TH-7] 4"C

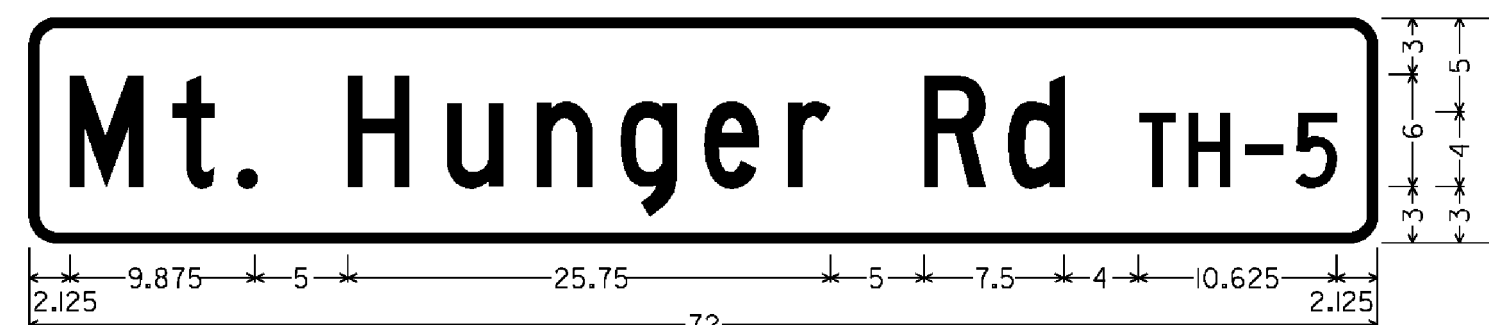


1,500" RADIUS, 0,500" BORDER, WHITE ON GREEN;
[Mt. Hunger Rd] 6"C, [TH-5] 4"C

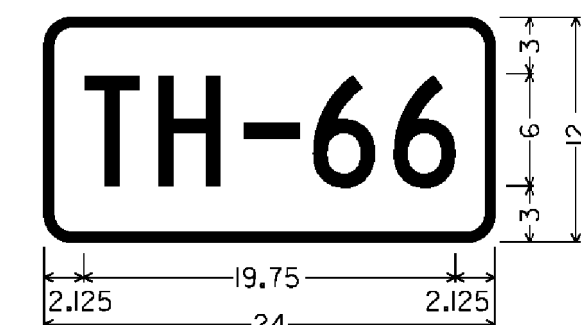

1,500" RADIUS, 0,500" BORDER, WHITE ON GREEN;
[TH-66] 6"C

THIS SIGN WAS NOT INSTALLED.
SEE SHEET #55.

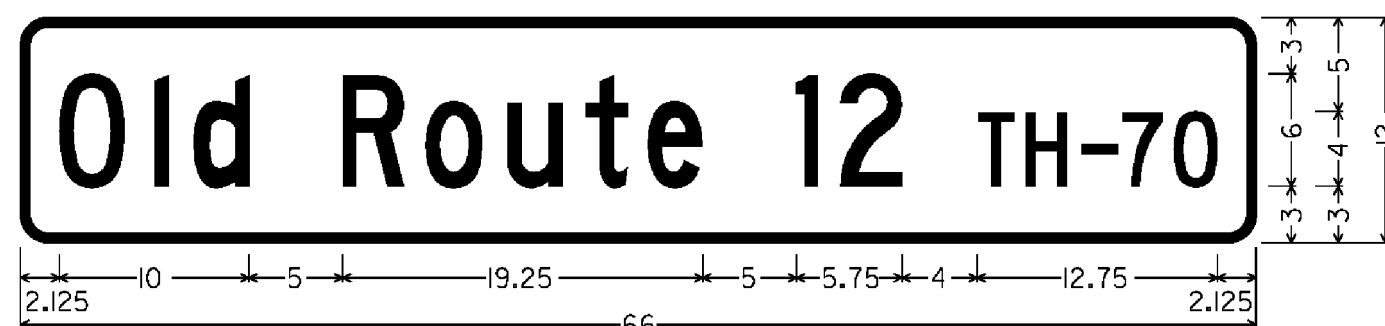

1,500" RADIUS, 0,500" BORDER, WHITE ON GREEN;
[Old Route 12] 6"C, [TH-70] 4"C @ 90% SPACING




1,500" RADIUS, 0,500" BORDER, WHITE ON GREEN;
[Fort Defiance Hill] 5"C, [TH-28] 4"C @ 80% SPACING

ALL DIMENSIONS SHOWN IN INCHES, EXCEPT WHERE NOTED.


PROJECT NAME:	HARTLAND - BETHEL	PLOT DATE:	01-AUG-2012
PROJECT NUMBER:	STPG SIGN (40)	DRAWN BY:	M. MILLER
FILE NAME:	I2C116.SD.9	CHECKED BY:	A. GAMBLE
PROJECT LEADER:	A. GAMBLE	SHEET	12 OF 85
DESIGNED BY:	M. MILLER		
SIGN DETAILS	9		

ALL SIGNS ON THIS PAGE ARE SIGN CODE D3-1
(ALL SIGNS ARE DOUBLE-SIDED)


NOT TO SCALE

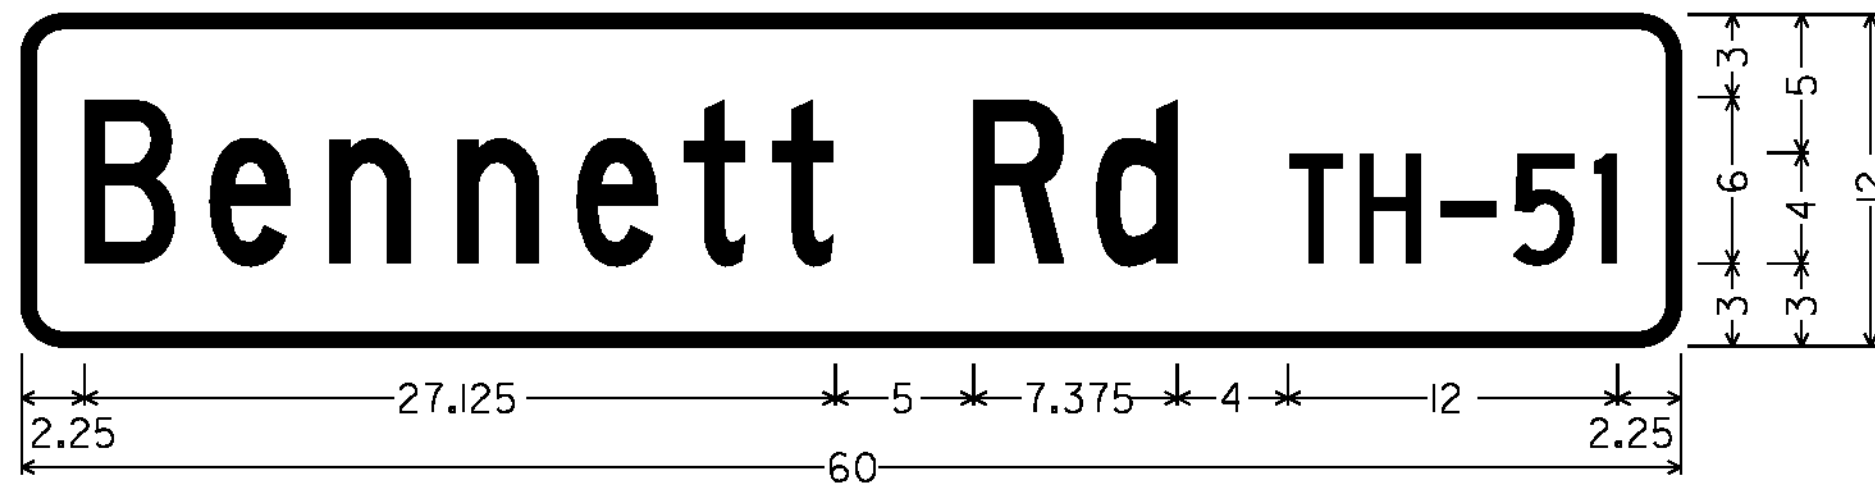


1.500" RADIUS, 0.500" BORDER, WHITE ON GREEN;
 [Bennett Rd] 6"C, [TH-51] 4"C @ 90% SPACING

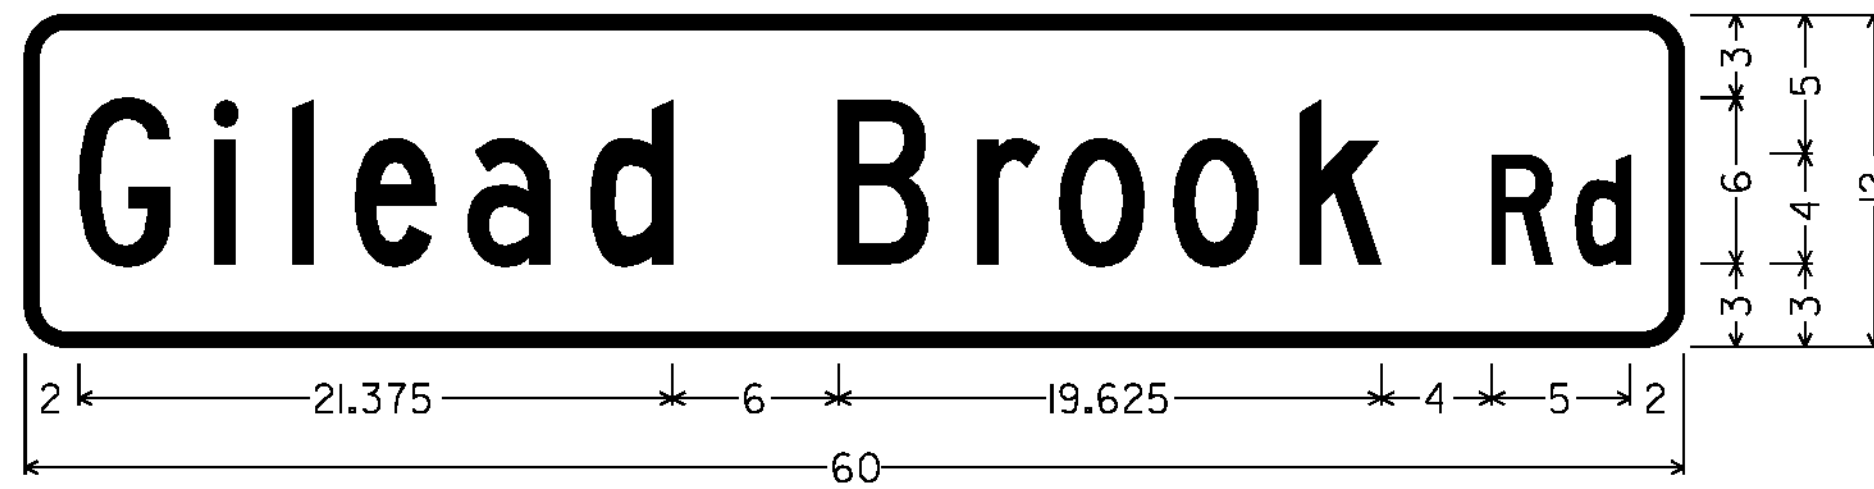


1.500" RADIUS, 0.500" BORDER, WHITE ON GREEN;
 [Gilead Brook] 6"C, [Rd] 4"C

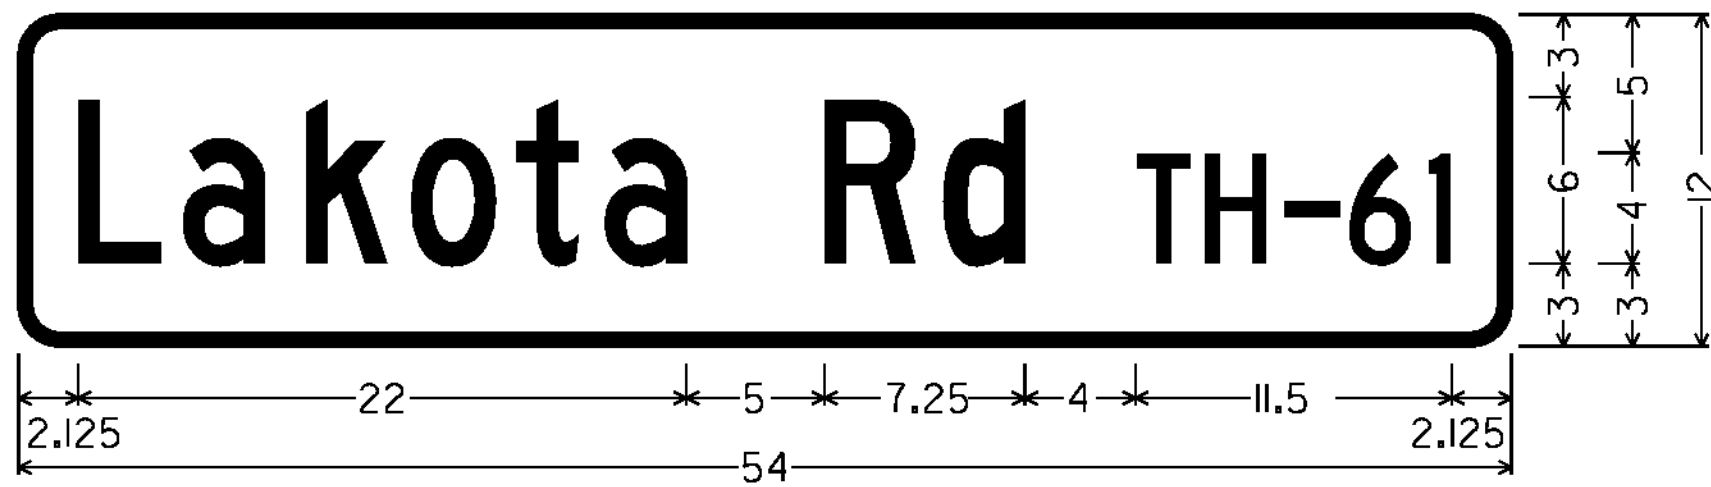


1.500" RADIUS, 0.500" BORDER, WHITE ON GREEN;
 [Lakota Rd] 6"C, [TH-61] 4"C @ 80% SPACING

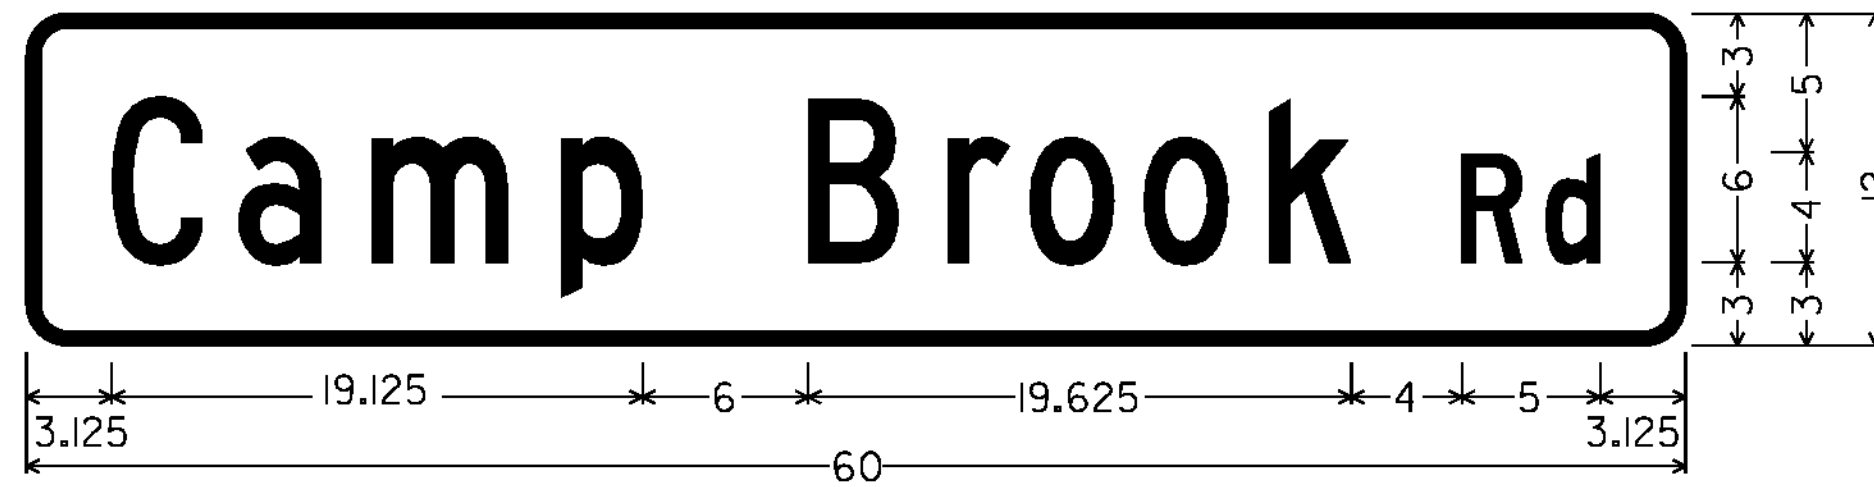


1.500" RADIUS, 0.500" BORDER, WHITE ON GREEN;
 [Camp Brook] 6"C, [Rd] 4"C

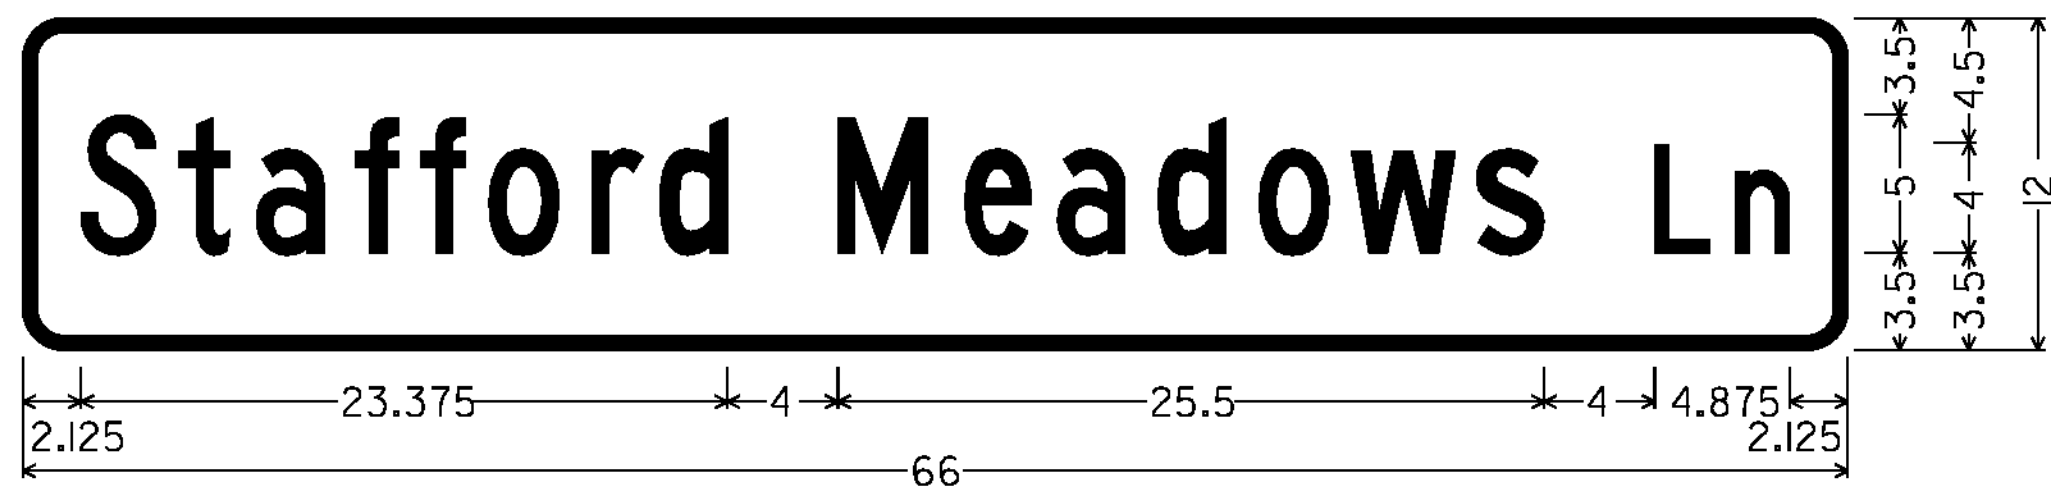


1.500" RADIUS, 0.500" BORDER, WHITE ON GREEN;
 [Stafford Meadows] 5"C, [Ln] 4"C @ 95% SPACING

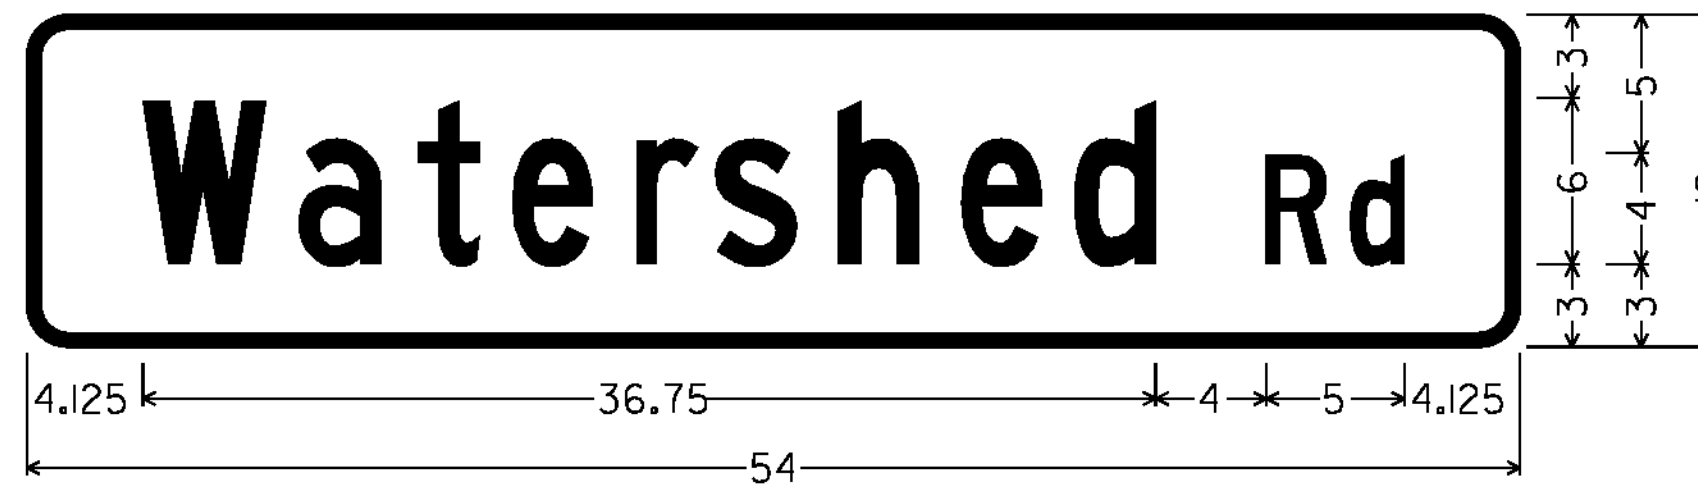


1.500" RADIUS, 0.500" BORDER, WHITE ON GREEN;
 [Watershed] 6"C, [Rd] 4"C

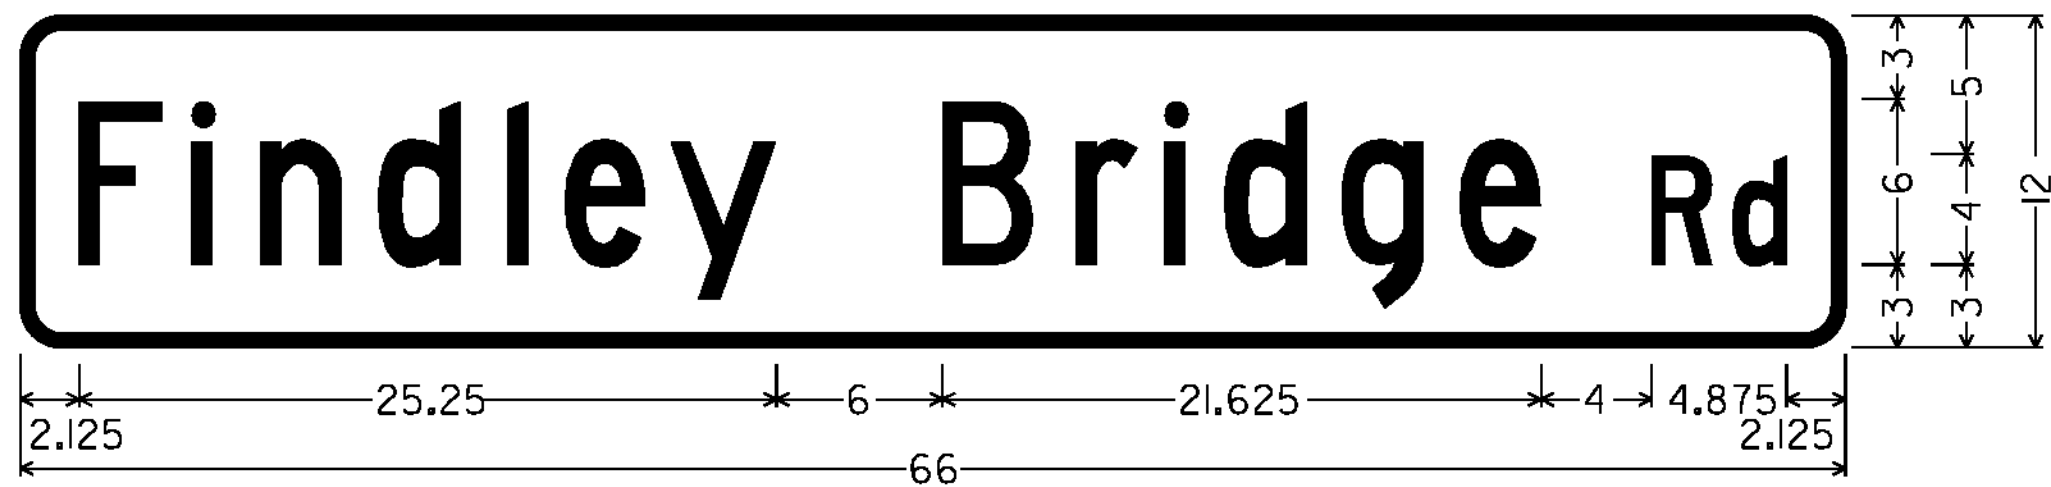

1.500" RADIUS, 0.500" BORDER, WHITE ON GREEN;
 [Findley Bridge] 6"C, [Rd] 4"C @ 87% SPACING

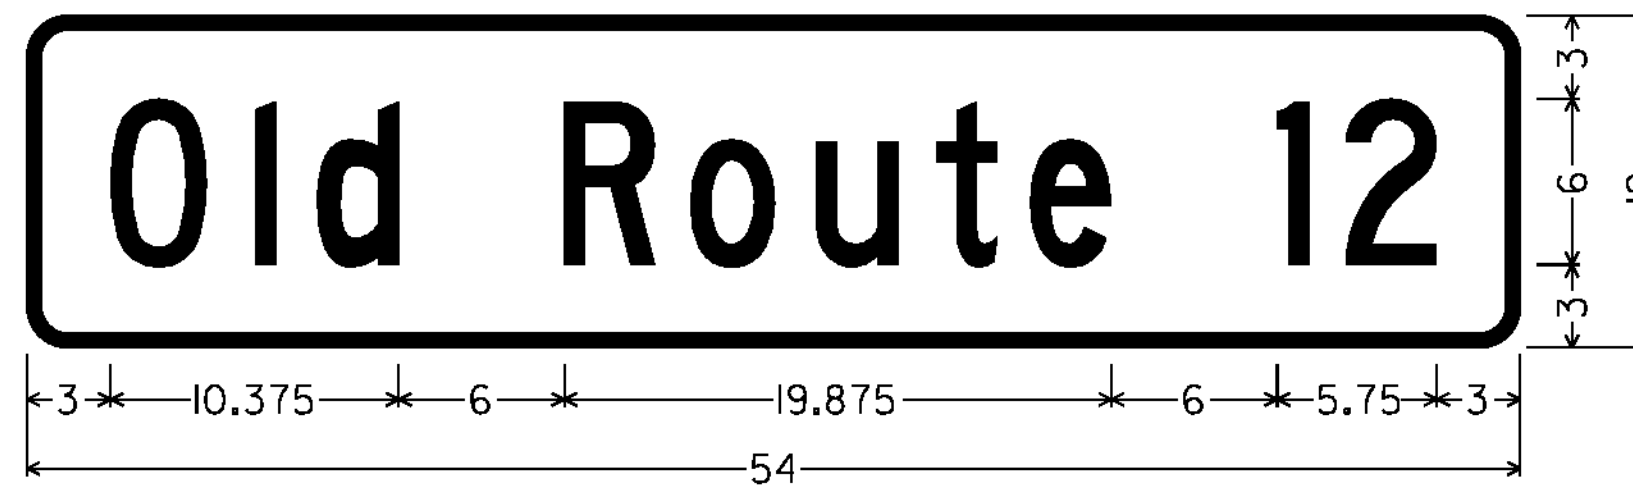

1.500" RADIUS, 0.500" BORDER, WHITE ON GREEN;
 [Old Route 12] 6"C

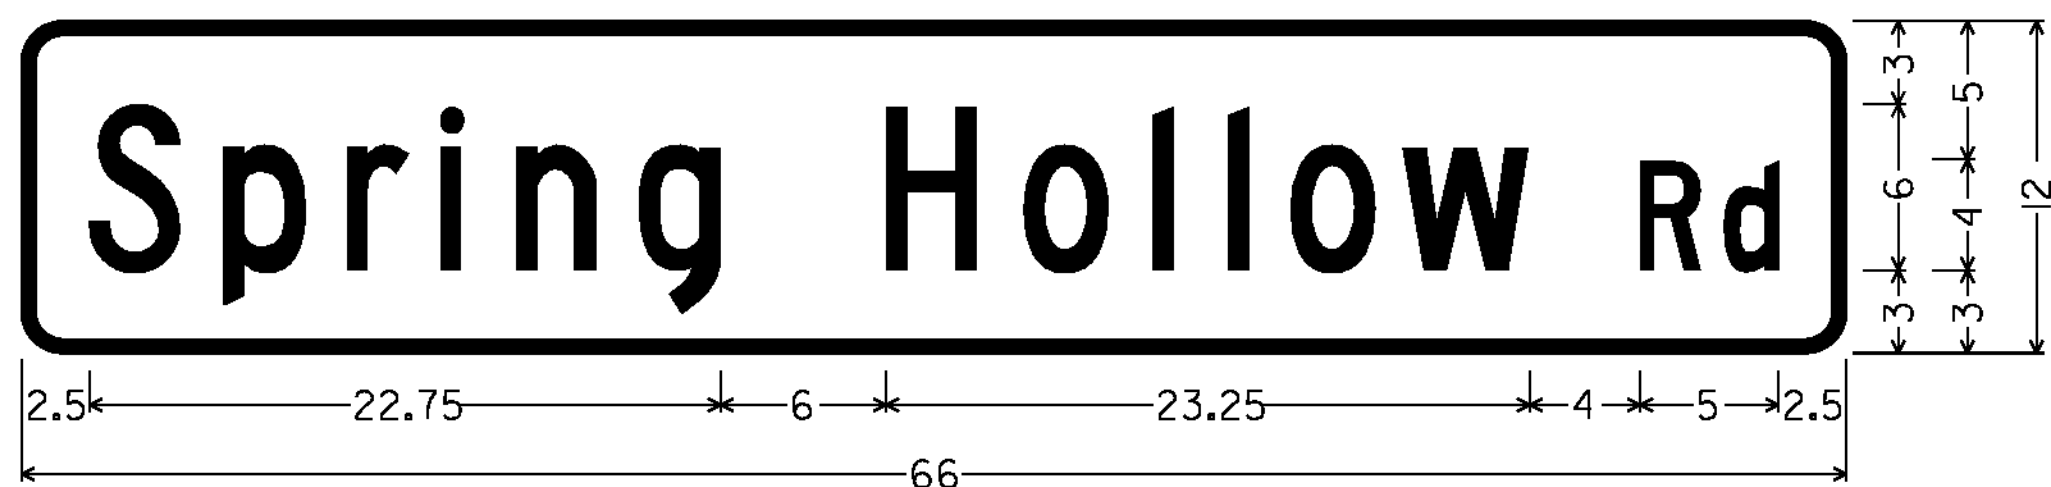


1.500" RADIUS, 0.500" BORDER, WHITE ON GREEN;
 [Spring Hollow] 6"C, [Rd] 4"C

ALL DIMENSIONS SHOWN IN INCHES, EXCEPT WHERE NOTED.


PROJECT NAME: HARTLAND - BETHEL	
PROJECT NUMBER: STPG SIGN (40)	
FILE NAME: I2CI16.SD_I0	PLOT DATE: 27-JUN-2012
PROJECT LEADER: A. GAMBLE	DRAWN BY: M. MILLER
DESIGNED BY: M. MILLER	CHECKED BY: A. GAMBLE
SIGN DETAILS I0	SHEET I3 OF 85

ALL SIGNS ON THIS PAGE ARE SIGN CODE D3-1
 (ALL SIGNS ARE DOUBLE-SIDED)


NOT TO SCALE

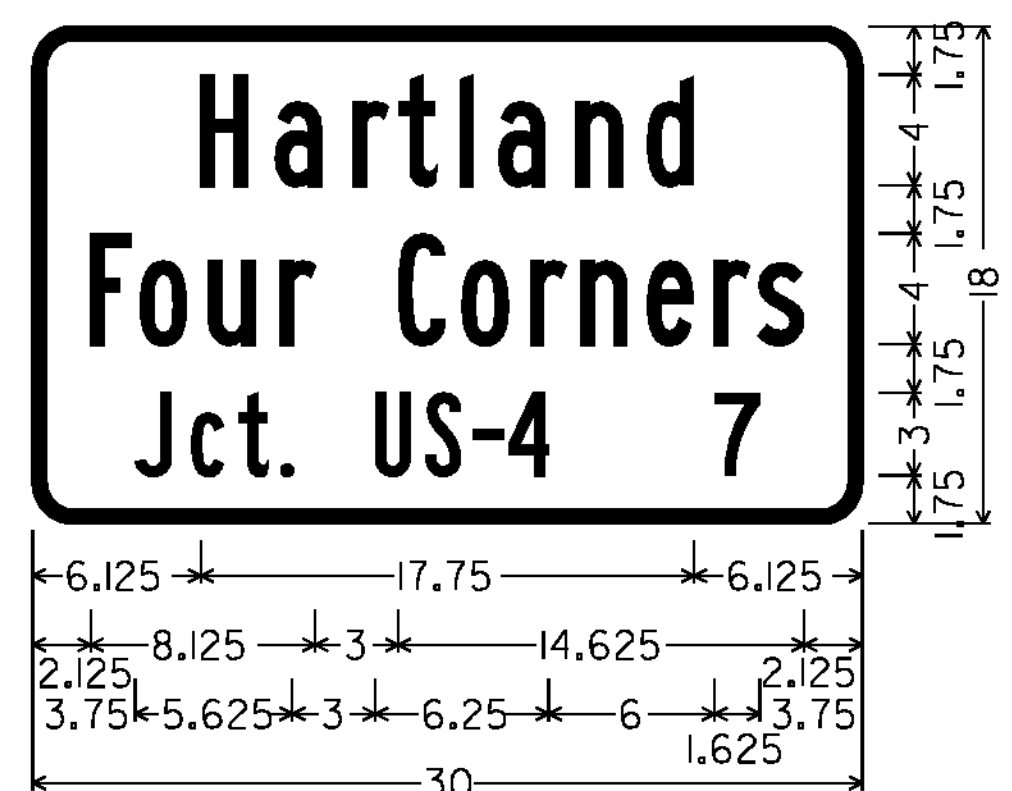


1.500" RADIUS, 0.500" BORDER, WHITE ON GREEN;
 [Hartland] 4"B,
 [Four Corners] 4"B @ 80% SPACING,
 [Jct. US-4] 3"B, [7] 3"C

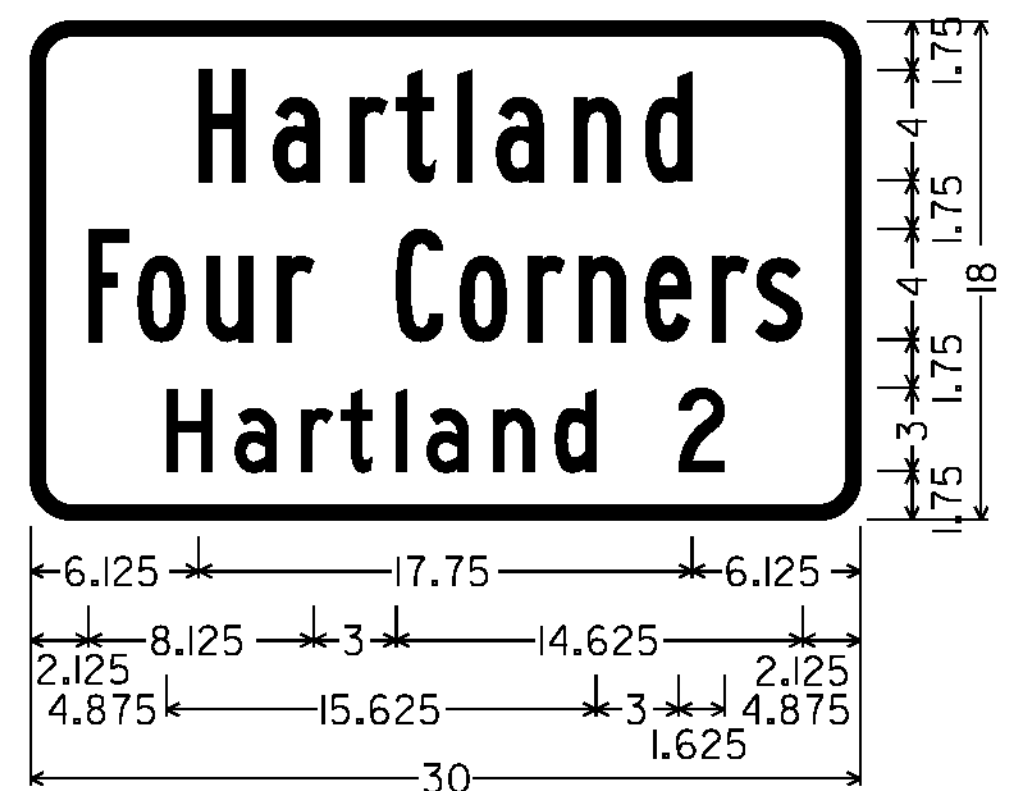


1.500" RADIUS, 0.500" BORDER, WHITE ON GREEN;
 [Hartland] 4"B,
 [Four Corners] 4"B @ 80% SPACING,
 [Hartland 2] 3"C

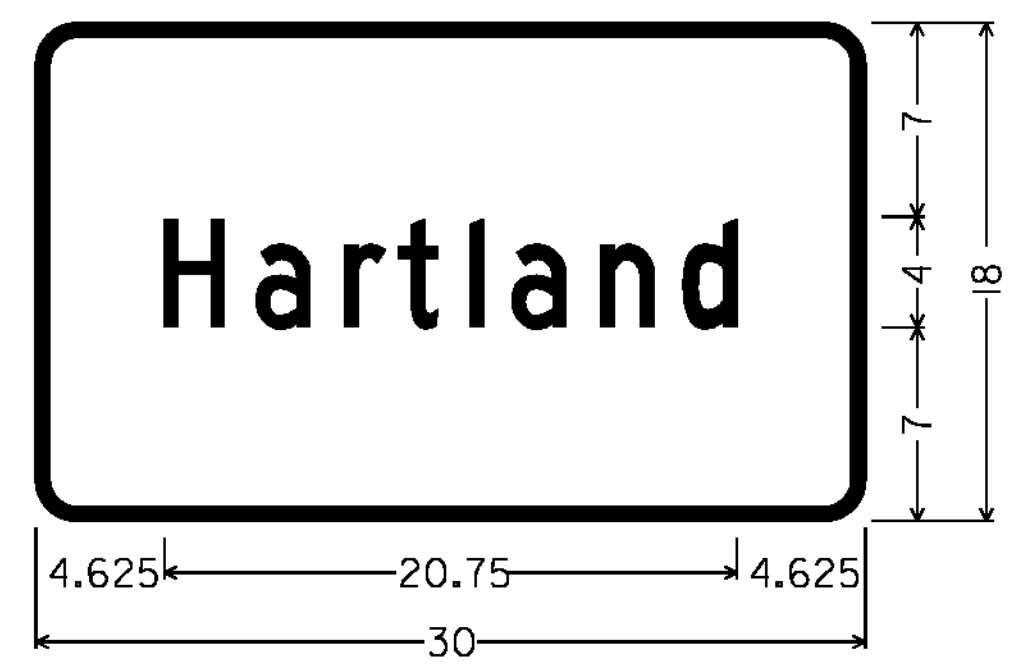


1.500" RADIUS, 0.500" BORDER, WHITE ON GREEN;
 [Hartland] 4"C

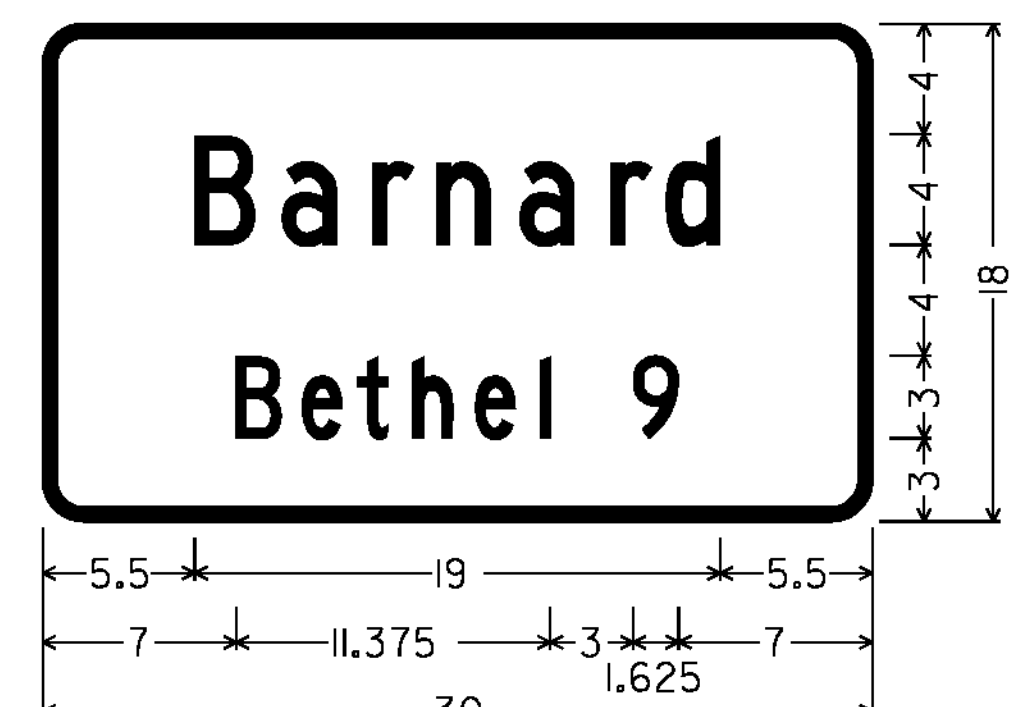

1.500" RADIUS, 0.500" BORDER, WHITE ON GREEN;
 [Barnard] 4"C,
 [Bethel 9] 3"C

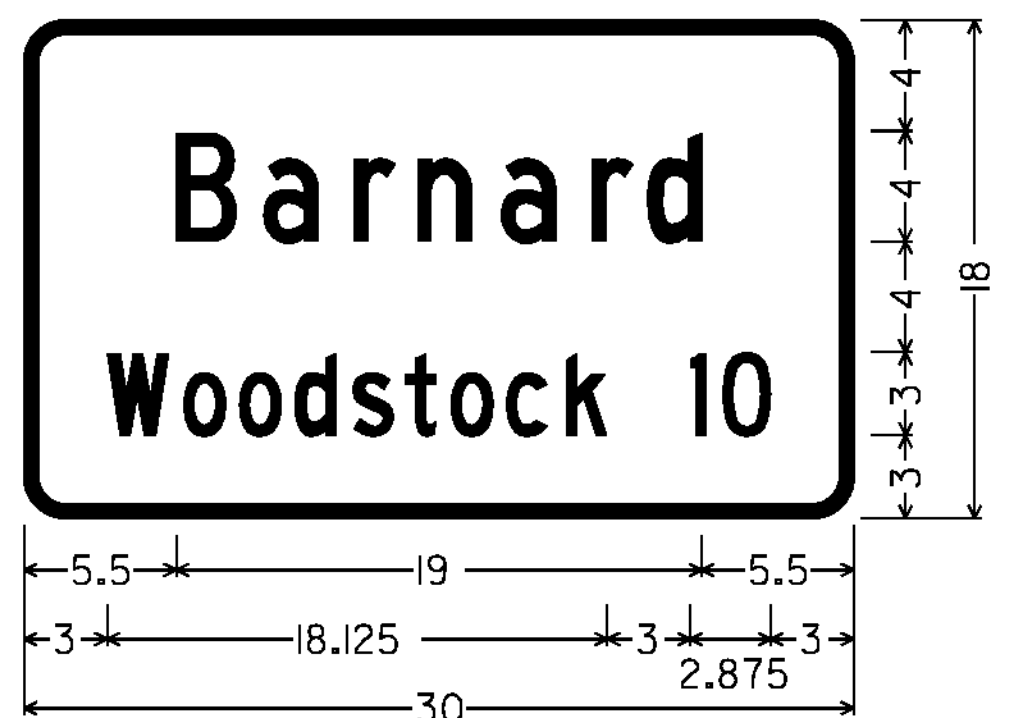

1.500" RADIUS, 0.500" BORDER, WHITE ON GREEN;
 [Barnard] 4"C,
 [Woodstock 10] 3"C

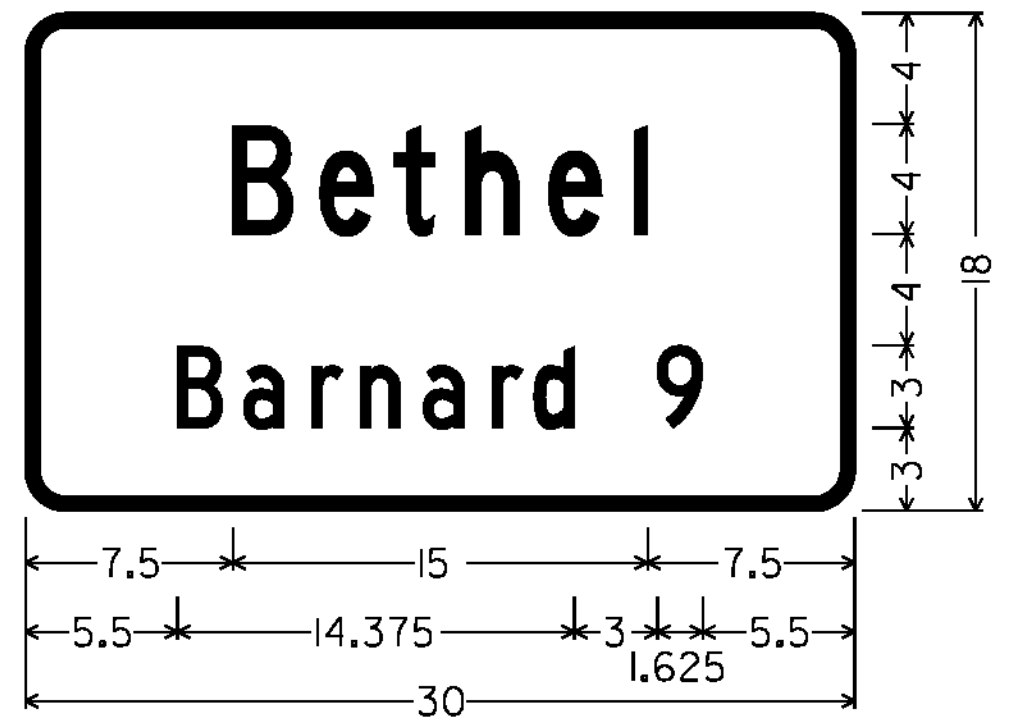


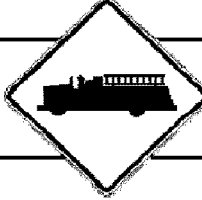
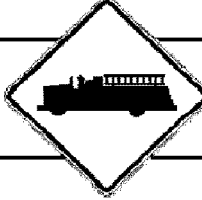


1.500" RADIUS, 0.500" BORDER, WHITE ON GREEN;
 [Bethel] 4"C,
 [Barnard 9] 3"C

ALL DIMENSIONS SHOWN IN INCHES, EXCEPT WHERE NOTED.




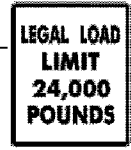

ALL SIGNS ON THIS PAGE ARE SIGN CODE VD-018

NOT TO SCALE

PROJECT NAME: HARTLAND - BETHEL	
PROJECT NUMBER: STPG SIGN (40)	
FILE NAME: I2CI16.SD.II	PLOT DATE: 26-JUN-2012
PROJECT LEADER: A. GAMBLE	DRAWN BY: M. MILLER
DESIGNED BY: M. MILLER	CHECKED BY: A. GAMBLE
SIGN DETAILS II	SHEET 14 OF 85




DIRECTION	MILEPOINT	LOCATION CODE (SHEET 2)	SIGN CODE	WIDTH (IN)	HEIGHT (IN)	SHEETING REMARKS	SIGN LEGEND	NEW SIGNS		EXISTING SIGNS				EXIST POST		NUMBER OF NEW POSTS	SQUARE STEEL (IN)			TUBULAR STEEL Ø (IN)				SIGN FRAME REQUIRED	REMARKS	SIGN DETAIL LOCATION			
								"A"	"B"	RETAIN	SALVAGE FROM	SALVAGE TO	REMOVE	RETAIN	REMOVE		1.75	2.00	2.50	FOUNDATION	3.00	3.50	4.00			5.00	SHSM	PROJECT SHEET #	STANDARD SHEET #
																	(LB / FT)				(LB / FT)								
NB HARTLAND VT 12							FY-FLUORESCENT YELLOW FYG-FLUORESCENT YELLOW GREEN																"SHSM"-STANDARD HIGHWAY SIGNS AND MARKINGS						
NB	0.318	A	D3-1	30	5		BISCHOFF BISHOFF LN																						
NB	0.339	A	VD2-1	72	10																								
		A	VD2-1	72	12		Woodstock 12	6.00						2	11.5'	12.5'									10				
NB	0.375	A	R2-1	24	30																								
		A	R2-1	24	30			5.00																X					
NB	0.426	A	W11-8	30	30			6.25																	X				
NB	0.590	A	W11-6	30	30		0120 1409 0060 SNOWMOBILE CROSSING SYMBOL																						
NB	0.725	A	R2-1	24	30																								
		A	R2-1	24	30			5.00																	X				
NB	0.753	A	VD-062B	72	16		OFFICIAL BUSINESS DIRECTIONAL SIGN			1																			
NB	0.807	A	S3-1	30	30		0120 1409 0080 SCHOOL BUS STOP AHEAD																						
NB	0.829	A	W2-2R	30	30			6.25																					
		A	W16-8P	30	8		Bowers Rd	1.67																		8			
NB	0.844	A	W1-3MR	30	30		MODIFIED RIGHT REVERSE TURN SYMBOL																						
		A	W13-1P	18	18		25 MPH (PLAQUE)																						
SIGN SUMMARY SHEET							SHEET TOTALS	30.17	0.00	1	0	0	10	0	0	6	83.0	0	0.0	0.0	0.0	0.0							
VERMONT AGENCY OF TRANSPORTATION							TOWN DIRECTIONAL TOTALS	339.4	0.0	18	1	1	68	0	0	58	870.0	0	0.0	0.0	0.0	0.0							
															PROJECT NAME:	HARTLAND-BETHEL													
															PROJECT NUMBER:	STPG SIGN (40)													
															FILE NAME:	HARTLAND VT ROUTE 12 NB													
															PROJECT MANAGER:	AMY GAMBLE													
															DESIGNED BY:	M. MILLER													
															PLOT DATE:	8/1/2012													
															DRAWN BY:	M. MILLER													
															CHECKED:	AMY GAMBLE													
															SHEET	18 OF 86													




DIRECTION	MILEPOINT	LOCATION CODE (SHEET 2)	SIGN CODE	WIDTH (IN)	HEIGHT (IN)	SHEETING REMARKS	SIGN LEGEND	NEW SIGNS		EXISTING SIGNS			EXIST POST		NUMBER OF NEW POSTS	SQUARE STEEL (IN)			TUBULAR STEEL Ø (IN)				SIGN FRAME REQUIRED	REMARKS	SIGN DETAIL LOCATION				
								"A"	"B"	RETAIN	SALVAGE FROM	SALVAGE TO	REMOVE	RETAIN		REMOVE	1.75	2.00	2.50	FOUNDATION	3.00	3.50			4.00	5.00	SHSM	PROJECT SHEET #	STANDARD SHEET #
NB HARTLAND VT 12							FY-FLUORESCENT YELLOW FYG-FLUORESCENT YELLOW GREEN																"SHSM"-STANDARD HIGHWAY SIGNS AND MARKINGS						
NB	0.892	C	VR-017	24	30																								
		C	VR-017	24	30			5.00		I	I	I					13.5'									6			
NB	0.898	A	D3-1	30	5		BOWERS RD																						
		D	R1-1	30	30					I	I	I																	
		A	D3-1	42	12			3.50								15.0'									11				
		D	R1-1	30	30			6.25																X					
NB	0.859 0.905	A	S1-1	36	36	FYG		9.00								15.5' / 15.5'							X		ASSEMBLY AT 0.829 ON SHEET 18				
NB	0.939	A	R2-1	24	30			5.00								15.0'								X					
NB	1.093	A	R2-5A	24	30		REDUCED SPEED AHEAD																						
NB	1.208	A	VD-018	30	18		HARTLAND FOUR CORNS.																						
		A	VD-018	30	18			3.75								16.0'									14				
NB	1.255	A	R2-1	24	30																								
		A	R2-1	30	36			7.50								17.0'								X		NOTE: 30x36" SIGN AT TRANSITION TO LOWER POSTED SPEED (TYP)			
NB	1.345	A	W1-10R	30	30		MODIFIED CURVE RIGHT SYMBOL																						
		A	S3-1	30	30		SCHOOL BUS STOP AHEAD (CONT. ON NEXT PAGE)																						
SIGN SUMMARY SHEET							SHEET TOTALS	40.00	0.00	0	2	2	10	0	0	7	107.5	0	0.0	0.0	0.0	0.0	PROJECT NAME: HARTLAND-BETHEL PROJECT NUMBER: STPG SIGN (40)						
VERMONT AGENCY OF TRANSPORTATION							TOWN DIRECTIONAL TOTALS	339.4	0.0	18	1	1	68	0	0	58	870.0	0		0.0			FILE NAME: HARTLAND VT ROUTE 12 NB PROJECT MANAGER: AMY GAMBLE DESIGNED BY: M. MILLER HARTLAND VT-12 NORTHBOUND 5	PLOT DATE: 8/1/2012 DRAWN BY: M. MILLER CHECKED BY: AMY GAMBLE SHEET 19 OF 85					





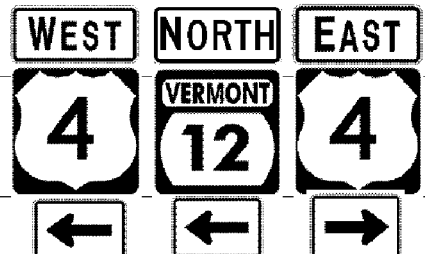


DIRECTION	MILEPOINT	LOCATION CODE (SHEET 2)	SIGN CODE	WIDTH (IN)	HEIGHT (IN)	SHEETING REMARKS	SIGN LEGEND	NEW SIGNS		EXISTING SIGNS			EXIST POST		NUMBER OF NEW POSTS	SQUARE STEEL (IN)			TUBULAR STEEL Ø (IN)				SIGN FRAME REQUIRED	REMARKS	SIGN DETAIL LOCATION				
								"A"	"B"	RETAIN	SALVAGE FROM	SALVAGE TO	REMOVE	RETAIN		REMOVE	1.75	2.00	2.50	FOUNDATION	3.00	3.50			4.00	5.00	SHSM	PROJECT SHEET #	STANDARD SHEET #
																	(LB / FT)				(LB / FT)								
NB HARTLAND VT 12							FY-FLUORESCENT YELLOW FYG-FLUORESCENT YELLOW GREEN																"SHSM"-STANDARD HIGHWAY SIGNS AND MARKINGS						
NB	1.345	A	W1-10aR	36	36		 (CONT.)	9.00						2	15.0'	15.0'								X					
NB	1.403	A	OM3-R	12	36		 BRIDGE 3 VT 12	3.00		I	I	I		1	11.0'								X				INSTALL AT 4 FT VERTICAL CLEARANCE; SIGN IS BEHIND RAIL		
NB	1.417	B	OM3-L	12	36			3.00				I		1	11.0'								X				THIS SIGN FACES SB TRAFFIC		
NB	1.466	C	VR-017	24	30		 LEGAL LOAD LIMIT 24,000 POUNDS	5.00				I		1	15.0'												6	MACE HILL RD (TH-18); SIGN AND POST MISSING	
NB	1.472	D	R1-1	30	30		 STOP	6.25				I											X				MACE HILL RD (TH-18)		
NB	1.472	A	D3-1	30	5		MACE HILL RD	4.00				I		2	15.0'	15.0'												REMOVE THE INDEPENDENTLY INSTALLED STREET NAME SIGN AND POST	
NB	1.499	A	M3-1	24	12		NORTH	2.00						1	15.0'								X				NORTH, GREEN ON WHITE		
		A	M1-5	24	24		VT ROUTE 12	4.00																			E-136B		
SIGN SUMMARY SHEET							SHEET TOTALS	36.25	0.00	0	2	2	9	0	0	8	112.0	120.0	0	0.0	0.0	0.0	0.0						
VERMONT AGENCY OF TRANSPORTATION							TOWN DIRECTIONAL TOTALS	339.4	0.0	18	1	1	68	0	0	58	870.0	0	0.0	0.0	0.0	0.0							
PROJECT NAME: HARTLAND-BETHEL STPG SIGN (40)															FILE NAME: HARTLAND VT ROUTE 12 NB														
PROJECT NUMBER:															PROJECT MANAGER: AMY GAMBLE														
DESIGNED BY: M. MILLER															PLOT DATE: 8/1/2012														
HARTLAND VT-12 NORTHBOUND 6															DRAWN BY: M. MILLER														
															CHECKED: AMY GAMBLE														
															SHEET 20 OF 85														





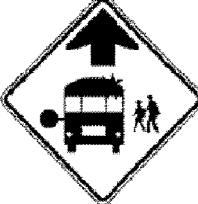


DIRECTION	MILEPOINT	LOCATION CODE (SHEET 2)	SIGN CODE	WIDTH (IN)	HEIGHT (IN)	SHEETING REMARKS	SIGN LEGEND	NEW SIGNS		EXISTING SIGNS			EXIST POST		NUMBER OF NEW POSTS	SQUARE STEEL (IN)			TUBULAR STEEL Ø (IN)				SIGN FRAME REQUIRED	REMARKS	SIGN DETAIL LOCATION				
								"A"	"B"	RETAIN	SALVAGE FROM	SALVAGE TO	REMOVE	RETAIN		REMOVE	1.75	2.00	2.50	FOUNDATION	3.00	3.50			4.00	5.00	SHSM	PROJECT SHEET #	STANDARD SHEET #
NB HARTLAND VT 12							FY-FLUORESCENT YELLOW FYG-FLUORESCENT YELLOW GREEN															"SHSM"-STANDARD HIGHWAY SIGNS AND MARKINGS							
NB	1.534	A	W11-6H	30	30																								
		A	W11-6H	30	30			6.25																6					
NB	1.553	A	R2-1	24	30		SPEED LIMIT 50			1																			
NB	1.564	A	R2-1	24	30		SPEED LIMIT 50																						
NB	1.653	A	S3-1	30	30		SCHOOL BUS STOP AHEAD																						
NB	1.741	A	W1-2R	30	30			6.25																					
NB	3.216	A	W2-3MR	30	30		MODIFIED RIGHT ANGLE SIDE ROAD SYMBOL			1																			
		A	W16-8A	24	18		COBB HILL RD (PLAQUE)			1																			
NB	3.291	C	VR-017	24	30																								
		C	VR-017	24	30			5.00																6					
NB	3.291	A	D3-1	48	12			4.00																					
NB	3.306	A	D3-1	30	5		COBB HILL RD																						
		D	R1-1	30	30		STOP																						
		D	R1-1	30	30			6.25																					
NB	3.447	A	W1-4R	30	30		RIGHT REVERSE CURVE																						
SIGN SUMMARY SHEET							SHEET TOTALS	27.75	0.00	2	2	2	8	0	0	7	97.0	0	0.0	0.0	0.0	0.0	0.0	PROJECT NAME: HARTLAND-BETHEL PROJECT NUMBER: STPG SIGN (40)					
VERMONT AGENCY OF TRANSPORTATION							TOWN DIRECTIONAL TOTALS	339.4	0.0	18	1	1	68	0	0	58	870.0	0	0.0	0.0	0.0	0.0	FILE NAME: HARTLAND VT ROUTE 12 NB PROJECT MANAGER: AMY GAMBLE DESIGNED BY: M. MILLER HARTLAND VT-12 NORTHBOUND 7	PLOT DATE: 8/1/2012 DRAWN BY: M. MILLER CHECKED BY: AMY GAMBLE SHEET 21 OF 86					


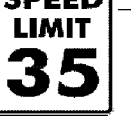




DIRECTION	MILEPOINT	LOCATION CODE (SHEET 2)	SIGN CODE	WIDTH (IN)	HEIGHT (IN)	SHEETING REMARKS	SIGN LEGEND	NEW SIGNS		EXISTING SIGNS			EXIST POST		NUMBER OF NEW POSTS	SQUARE STEEL (IN)			TUBULAR STEEL Ø (IN)				SIGN FRAME REQUIRED	REMARKS	SIGN DETAIL LOCATION			
								"A"	"B"	RETAIN	SALVAGE FROM	SALVAGE TO	REMOVE	RETAIN		REMOVE	1.75 (LB / FT)	2.00	2.50	3.00	3.50	4.00			5.00	SHSM	PROJECT SHEET #	STANDARD SHEET #
NB HARTLAND VT 12							FY-FLUORESCENT YELLOW FYG-FLUORESCENT YELLOW GREEN															"SHSM"-STANDARD HIGHWAY SIGNS AND MARKINGS						
NB	3.517	A	W1-4R	30	30			6.25						1	16.0' X								INSTALL 370 FT± NORTH OF THE SIGN REMOVED AT MP 3.447	X				
NB	4.245	A	VW-133R	30	30			6.25						1	15.0' X								INSTALL BEHIND RAIL 3845 FT± NORTH OF THE SIGN AT MP 3.517		7			
NB	4.389	A	S3-1	36	36	FYG		9.00						2	15.0'/16.0' X								INSTALL BEHIND RAIL 340 FT± SOUTH OF THE RIGHT CURVE SIGN AT MP 4.453	X				
NB	4.453	A	W1-2R	30	30		RIGHT CURVE																					
		A	W1-10R	36	36			9.00						2	15.0'/15.0' X										X			
		A	W16-8aP	24	15			2.50															INSTALL THE PLAQUE ON THE LEFT SIDE POST		8			
NB	4.524	A	VW-060	30	30		HIDDEN DRIVES																NOTE LOCATION AS REFERENCE FOR THE NEXT SIGN					
NB	4.534	A	VW-060	30	30			6.25						1	16.0' X								INSTALL 50 FT± NORTH OF THE HIDDEN DRIVES SIGN REMOVED AT MP 4.524		7			
NB	4.570	A	S3-1	36	36	FYG		9.00						2	15.0'/15.0' X								INSTALL 190 FT± NORTH OF THE HIDDEN DRIVES SIGN INSTALLED AT MP 4.534	X				
NB	5.154	A	S3-1	30	30		SCHOOL BUS STOP AHEAD																NO LONGER WARRANTED					
NB	5.996	C	VR-017	24	30																		BARRON HILL RD (TH-8)					
		C	VR-017	24	30			5.00						1	13.5' X										6			
NB	6.004	A	D3-1	36	5		BARRON HILL RD																2 SIGNS FOR THE STREET NAME					
		D	R1-1	30	30																							
		D	R1-1	30	30			6.25							0 +	0 X								STOP SIGN WAS INSTALLED ON STREET SIGN POST. SEE NEXT SHEET.	X			
SIGN SUMMARY SHEET							SHEET TOTALS	59.50	0.00	0	2	2	9	0	0	10	151.5	0	0.0	0.0	0.0	0.0		PROJECT NAME: HARTLAND-BETHEL PROJECT NUMBER: STPG SIGN (40)				
VERMONT AGENCY OF TRANSPORTATION							TOWN DIRECTIONAL TOTALS	339.4	0.0	18	1	1	68	0	0	58	870.0	0	0.0	0.0	0.0	0.0		FILE NAME: HARTLAND VT ROUTE 12 NB PROJECT MANAGER: AMY GAMBLE DESIGNED BY: M. MILLER HARTLAND VT-12 NORTHBOUND 8				
																							PLOT DATE: 8/1/2012 DRAWN BY: M. MILLER CHECKED: AMY GAMBLE SHEET 22 OF 86					







DIRECTION	MILEPOINT	LOCATION CODE (SHEET 2)	SIGN CODE	WIDTH (IN)	HEIGHT (IN)	SHEETING REMARKS	SIGN LEGEND	NEW SIGNS		EXISTING SIGNS			EXIST POST		NUMBER OF NEW POSTS	SQUARE STEEL (IN)			TUBULAR STEEL Ø (IN)				SIGN FRAME REQUIRED	REMARKS	SIGN DETAIL LOCATION				
								"A"	"B"	RETAIN	SALVAGE FROM	SALVAGE TO	REMOVE	RETAIN		REMOVE	1.75	2.00	2.50	FOUNDATION	3.00	3.50			4.00	5.00	SHSM	PROJECT SHEET #	STANDARD SHEET #
																	(LB / FT)				(LB / FT)								
NB HARTLAND VT 12							FY-FLUORESCENT YELLOW FYG-FLUORESCENT YELLOW GREEN																"SHSM"-STANDARD HIGHWAY SIGNS AND MARKINGS						
NB	7.602	A	VD1-1A	72	12		 (CONT.)	6.00																	9				
		A	VD1-1A	72	12		 ← 8 CHANGED TO 4	2.00																MILEAGE CHANGED TO 4 AFTER A VALID COMPLAINT BY MOTORIST. PAY 2.0 S.F.		9			
		A	VD1-1A	72	12			6.00																		9			
NB	7.641	A	VR-040	24	24		THROUGH WAY ENDS HERE					1		X										NO LONGER REQUIRED					
NB	7.664	A	M3-4	24	12		WEST					1		X															
		A	M1-4	24	24		US ROUTE 4					1																	
		A	M6-1L	21	15		LEFT ARROW					1																	
		A	M3-1	24	12		NORTH					1																	
		A	M1-5	24	24		VT ROUTE 12					1																	
		A	M6-1L	21	15		LEFT ARROW					1																	
		A	M3-2	24	12		EAST					1																	
		A	M1-4	24	24		US ROUTE 4					1																	
		A	M6-1R	21	15		RIGHT ARROW					1																	
		A	M3-4	24	12		(WEST: SEE NEXT PAGE)	2.00							2	12.0' / 13.0'								WEST, BLACK ON WHITE; THIS ASSEMBLY WILL REQUIRE 2.5 INCH POSTS AND A NEW SIGN FRAME	X				
		A	M1-4	24	24		(US ROUTE 4: SEE NEXT PAGE)	4.00																US ROUTE 4	X				
SIGN SUMMARY SHEET							SHEET TOTALS	26.00 24.00	0.00	0	0	0	10	0	0	2	25.0 30.0	0	0.0	0.0	0.0	0.0		PROJECT NAME: HARTLAND-BETHEL PROJECT NUMBER: STPG SIGN (40)					
VERMONT AGENCY OF TRANSPORTATION							TOWN DIRECTIONAL TOTALS	339.4	0.0	18	1	1	68	0	0	58	870.0	0		0.0				FILE NAME: HARTLAND VT ROUTE 12 NB PROJECT MANAGER: AMY GAMBLE DESIGNED BY: M. MILLER HARTLAND VT-12 NORTHBOUND 10	PLOT DATE: 8/1/2012 DRAWN BY: M. MILLER CHECKED: AMY GAMBLE SHEET 24 OF 86				





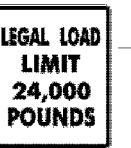


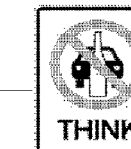
DIRECTION	MILEPOINT	LOCATION CODE (SHEET 2)	SIGN CODE	WIDTH (IN)	HEIGHT (IN)	SHEETING REMARKS	SIGN LEGEND	NEW SIGNS		EXISTING SIGNS			EXIST POST		NUMBER OF NEW POSTS	SQUARE STEEL (IN)			TUBULAR STEEL Ø (IN)				SIGN FRAME REQUIRED	REMARKS	SIGN DETAIL LOCATION					
								"A"	"B"	RETAIN	SALVAGE FROM	SALVAGE TO	REMOVE	RETAIN		REMOVE	1.75	2.00	2.50	3.00	3.50	4.00			5.00	SHSM	PROJECT SHEET #	STANDARD SHEET #		
																	(LB / FT)			(LB / FT)										
NB HARTLAND VT 12							FY-FLUORESCENT YELLOW FYG-FLUORESCENT YELLOW GREEN															"SHSM"-STANDARD HIGHWAY SIGNS AND MARKINGS								
NB	7.664	A	M6-1L	21	15		 (CONT.)	2.19															LEFT ARROW, BLACK ON WHITE	X						
		A	M3-1	24	12			2.00															NORTH, GREEN ON WHITE	X						
		A	M1-5	24	24			4.00															VT ROUTE 12			E-138B				
		A	M6-1L	21	15			2.19															LEFT ARROW, GREEN ON WHITE	X						
		A	M3-2	24	12			2.00															EAST, BLACK ON WHITE	X						
		A	M1-4	24	24			4.00															US ROUTE 4	X						
		A	M6-1R	21	15			2.19															RIGHT ARROW, BLACK ON WHITE	X						
NB	7.696	A	R1-1	36	36			9.00						2	16.0' / 16.0'	X							NOTE: NEW SIGN IS LARGER. INSTALL 15 FT± IN ADVANCE OF THE EXISTING STOP SIGN AT MP 7.699	X						
NB	7.699	A	R1-1	30	30			STOP																						
SIGN SUMMARY SHEET								SHEET TOTALS		27.57	0.00	0	0	0	2	0	0	2	32.0	0	0.0	0.0	0.0	0.0	PROJECT NAME: HARTLAND-BETHEL PROJECT NUMBER: STPG SIGN (40)					
VERMONT AGENCY OF TRANSPORTATION								SF	SF	EA	EA	EA	EA	EA	EA	EA	EA	EA	EA	EA	EA	EA	EA	EA	EA	EA	EA	EA	EA	EA
TOWN DIRECTIONAL TOTALS								339.4	0.0	18	1	1	68	0	0	58	870.0	0	0.0	0.0	0.0	0.0	0.0	0.0	FILE NAME: HARTLAND VT ROUTE 12 NB PROJECT MANAGER: AMY GAMBLE DESIGNED BY: M. MILLER HARTLAND VT-12 NORTHBOUND 11				PLOT DATE: 8/1/2012 DRAWN BY: M. MILLER CHECKED BY: AMY GAMBLE SHEET 26 OF 86	
















DIRECTION	MILEPOINT	LOCATION CODE (SHEET 2)	SIGN CODE	WIDTH (IN)	HEIGHT (IN)	SHEETING REMARKS	SIGN LEGEND	NEW SIGNS		EXISTING SIGNS				EXIST POST		NUMBER OF NEW POSTS	SQUARE STEEL (IN)			TUBULAR STEEL Ø (IN)				SIGN FRAME REQUIRED	REMARKS	SIGN DETAIL LOCATION			
								"A"	"B"	RETAIN	SALVAGE FROM	SALVAGE TO	REMOVE	RETAIN	REMOVE		1.75 (LB / FT)	2.00	2.50	FOUNDATION	3.00	3.50	4.00			5.00	SHSM	PROJECT SHEET #	STANDARD SHEET #
SB HARTLAND VT 12							FY-FLUORESCENT YELLOW FYG-FLUORESCENT YELLOW GREEN																"SHSM"-STANDARD HIGHWAY SIGNS AND MARKINGS						
SB	4.942	F	D3-1	30	5		DAMON RD																DAMON RD (TH NUMBER UNKNOWN 26)						
		H	R1-1	30	30		STOP																INSTALL THE STREET SIGN ON TOP OF THE POST PERPENDICULAR TO THE STOP SIGN		11				
		F	D3-1	36	12		 0120 1409 0495	3.00															15.0' X						
		H	R1-1	30	30			6.25															15.0'		X				
SB	4.734	F	W1-2L	30	30		LEFT CURVE																						
SB	4.699	F	S3-1	30	30		SCHOOL BUS STOP AHEAD																						
		F	W1-10L	36	36			9.00															16.0' / 18.0' X		X				
		F	W16-8aP	24	15			2.50																		8			
SB	4.650	F	S3-1	36	36	FYG		9.00															17.0' / 17.0' X		X				
SB	4.541	G	VR-017	24	30		LEGAL LOAD LIMIT 24,000 POUNDS																						
		G	VR-017	24	30		NOTICE WEIGHT LIMIT	5.00															15.0' X			6			
SB	4.535	F	D3-1	36	5		HARTLAND HILL RD																						
		H	R1-1	30	30		STOP																						
		H	R1-1	30	30			6.25																	X				
SB	4.535	F	D3-1	60	12			5.00															16.0' / 16.0' X			11			
SIGN SUMMARY SHEET							SHEET TOTALS	46.00	0.00	0	3	3	10	0	0	8													
VERMONT AGENCY OF TRANSPORTATION							TOWN DIRECTIONAL TOTALS	277.6	0.0	12	3	3	64	0	0	49	735.0	0			0.0								
								SF	SF	EA	EA	EA	EA	EA	EA	EA	FT	EA	LB	LB	LB	LB							
																									PROJECT NAME: HARTLAND, BETH EL PROJECT NUMBER: STPG SIGN (40)				
																									FILE NAME: HARTLAND VT ROUTE 12 SB PROJECT MANAGER: AMY GAMBLE DESIGNED BY: M. MILLER HARTLAND VT-12 SOUTHBOUND 3	PLOT DATE: 8/1/2012 DRAWN BY: M. MILLER CHECKED: AMY GAMBLE SHEET 28 OF 86			







DIRECTION	MILEPOINT	LOCATION CODE (SHEET 2)	SIGN CODE	WIDTH (IN)	HEIGHT (IN)	SHEETING REMARKS	SIGN LEGEND	NEW SIGNS		EXISTING SIGNS			EXIST POST		NUMBER OF NEW POSTS	SQUARE STEEL (IN)			TUBULAR STEEL Ø (IN)				SIGN FRAME REQUIRED	REMARKS	SIGN DETAIL LOCATION											
								"A"	"B"	RETAIN	SALVAGE FROM	SALVAGE TO	REMOVE	RETAIN		REMOVE	1.75	2.00	2.50	3.00	3.50	4.00			5.00	SHSM	PROJECT SHEET #	STANDARD SHEET #								
																	(LB / FT)			(LB / FT)																
SB HARTLAND VT 12							FY-FLUORESCENT YELLOW FYG-FLUORESCENT YELLOW GREEN																"SHSM"-STANDARD HIGHWAY SIGNS AND MARKINGS													
SB	0.714	F	R2-1	24	30		 (CONT.)	5.00						1	13.0'	X									X											
SB	0.652	F	W11-8	30	30		FIRE STATION SYMBOL					1		X														NOT NEEDED; FIRE STATION IS CLEARLY VISIBLE JUST AHEAD								
SB	0.460	F	W3-5	36	36							1		X																						
		F	W3-5	36	36			9.00						2	17.0'/17.0'	X									X											
SB	0.420	F	VD-018	30	18							1		X																						
		F	VD-018	30	18			3.75						1	15.0'	X											14									
SB	0.385	F	R2-1	24	30		SPEED LIMIT 30					1		X														TO BE REPLACED 50 FT± SOUTH OF THIS POSITION								
SB	0.375	F	R2-1	30	36			7.50						1	14.0'	X									X			INSTALL ACROSS FROM THE NB-FACING SPEED LIMIT 40 SIGN								
SB	0.328	F	W11-2	30	30		PEDESTRIAN SYMBOL					1		X																						
		F	W7-3aP	24	18		NEXT 1/2 MILE (PLAQUE)					1																								
		F	W11-2	30	30	FYG		6.25						1	15.5'	X									X											
		F	W7-3aP	24	18	FYG		3.00																			8									
SB	0.248	F	R2-1	24	30							1		X																						
		F	R2-1	24	30			5.00						1	13.5'	X									X											
SB	0.198	F	M2-1	21	15		JCT (CONT. ON NEXT PAGE)					1	X	X														EXISTING POST WAS RETAINED DUE TO A BURIED CABLE IN THE VICINITY.								
SIGN SUMMARY SHEET								SHEET TOTALS		39.50	0.00	0	0	0	8	0	0	7	105.0	0	0.0	0.0	0.0	0.0	PROJECT NAME: HARTLAND-BETHEL STPG SIGN (40)											
VERMONT AGENCY OF TRANSPORTATION								SF	SF	EA	EA	EA	EA	EA	EA	EA	EA	EA	EA	EA	EA	EA	EA	EA	EA	EA	EA	EA	EA	EA	EA	FILENAME: HARTLAND VT ROUTE 12 SB				
TOWN DIRECTIONAL TOTALS								277.6	0.0	12	3	3	64	0	0	49	735.0	0	0.0	0.0	0.0	0.0	PROJECT NUMBER: HARTLAND-VT-12 SOUTHBOUND 7													
																															DESIGNED BY: M. MILLER					
																																HARTLAND-VT-12 SOUTHBOUND 7				
																																	PROJECT MANAGER: AMY GAMBLE			
																																	DESIGNED BY: M. MILLER			
																																	DRAWN BY: M. MILLER			
																																	CHECKED BY: AMY GAMBLE			
																																	SHEET 32 OF 86			


DIRECTION	MILEPOINT	LOCATION CODE (SHEET 2)	SIGN CODE	WIDTH (IN)	HEIGHT (IN)	SHEETING REMARKS	SIGN LEGEND	NEW SIGNS		EXISTING SIGNS			EXIST POST		NUMBER OF NEW POSTS	SQUARE STEEL (IN)			TUBULAR STEEL Ø (IN)				SIGN FRAME REQUIRED	REMARKS	SIGN DETAIL LOCATION					
								"A"	"B"	RETAIN	SALVAGE FROM	SALVAGE TO	REMOVE	RETAIN		REMOVE	(LB / FT)			(LB / FT)					SHSM	PROJECT SHEET #	STANDARD SHEET #			
																	1.75	2.00	2.50	3.00	3.50	4.00						5.00		
NB WOODSTOCK VT 12							FY-FLUORESCENT YELLOW FYG-FLUORESCENT YELLOW GREEN																"SHSM"-STANDARD HIGHWAY SIGNS AND MARKINGS							
NB	0.717	A	VR-039	24	18		STATE HIGHWAY BEGINS																							
		A	R2-1	24	30		SPEED LIMIT 35																							
		A	VR-039	24	18			3.00																		6				
		A	R2-1	24	30			5.00																	X					
NB	0.907	A	W11-2	30	30		PEDESTRIAN SYMBOL																							
		A	W16-9P	24	10		AHEAD (PLAQUE)																							
		A	W11-2	30	30	FYG		6.25																		X				
		A	W16-9P	24	12	FYG		2.00																	X					
NB	1.009	A	W11-2	30	30		PEDESTRIAN SYMBOL																							
		A	W16-7PL	24	10		DIAGONAL DOWN ARROW LEFT																							
		A	W11-2	30	30	FYG		6.25																		X				
		A	W16-7PL	24	12	FYG		2.00																	X					
NB	1.114	A	VD1-1A	72	12		<--- (45 DEG) BARNARD 9			1																				
		A	VD1-1A	72	12		<--- (45 DEG) BETHEL 17			1																				
		A	VD1-1A	72	12		S. POMFRET 2 ---> (45 DEG) (CONT. ON NEXT PAGE)			1																				
SIGN SUMMARY SHEET								SHEET TOTALS		24.50	0.00	3	0	0	6	0	0	3	46.0	0	0.0	0.0	0.0	0.0	PROJECT NAME: HARTLAND-BETHEL PROJECT NUMBER: STPG SIGN (40)					
VERMONT AGENCY OF TRANSPORTATION								SF	SF	EA	EA	EA	EA	EA	EA	EA	EA	EA	EA	EA	EA	EA	EA	EA	EA	EA	EA	EA	EA	FILE NAME: WOODSTOCK VT ROUTE 12 NE PROJECT MANAGER: AMY GAMBLE DESIGNED BY: M. MILLER WOODSTOCK VT-12 NORTHBOUND 1
TOWN DIRECTIONAL TOTALS								126.3	0.0	12	6	6	32	0	0	24	360.0	0	0.0	0.0	0.0	0.0	PLOT DATE: 8/1/2012 DRAWN BY: M. MILLER CHECKED: AMY GAMBLE SHEET 36 OF 85							

DIRECTION	MILEPOINT	LOCATION CODE (SHEET 2)	SIGN CODE	WIDTH (IN)	HEIGHT (IN)	SHEETING REMARKS	SIGN LEGEND	NEW SIGNS		EXISTING SIGNS			EXIST POST		NUMBER OF NEW POSTS	SQUARE STEEL (IN)			TUBULAR STEEL Ø (IN)				SIGN FRAME REQUIRED	REMARKS	SIGN DETAIL LOCATION				
								"A"	"B"	RETAIN	SALVAGE FROM	SALVAGE TO	REMOVE	RETAIN		REMOVE	1.75	2.00	2.50	3.00	3.50	4.00			5.00	SHSM	PROJECT SHEET #	STANDARD SHEET #	
																	(LB / FT)			(LB / FT)									
NB WOODSTOCK VT 12							FY-FLUORESCENT YELLOW FYG-FLUORESCENT YELLOW GREEN															"SHSM"-STANDARD HIGHWAY SIGNS AND MARKINGS							
NB	2.328	C	VR-017	24	30		 																GULLY RD (TH-87)						
		C	VR-017	24	30			5.00		I	I	I												ADJUST THE SIGN CLOSER TO THE JCT WITH VT ROUTE 12		6			
NB	2.334	A	D3-1	30	12																		GULLY RD TH87						
		C	D3-1	42	12																		BARNARD RD VT12						
		D	R1-1	30	30																		STOP						
		A	D3-1	30	12																		GULLY RD TH87						
		C	D3-1	42	12																		BARNARD RD VT12						
		D	R1-1	30	30			6.25																X					
NB	3.038	C	VR-017	24	30		 																AUSTIN RD (TH-21)						
		C	VR-017	24	30			5.00		I	I	I														6			
NB	3.044	A	D3-1	36	12																		AUSTIN RD TH21						
		C	D3-1	42	12																		BARNARD RD VT12						
NB	3.044	D	R1-1	30	30																		AUSTIN RD (TH-21)						
		D	R1-1	30	30			6.25																	X				
NB	3.134	A	VD1-1A	72	10		<--- W. Woodstock 2 (CONT. ON NEXT PAGE)																						
SIGN SUMMARY SHEET								SHEET TOTALS		22.50	0.00	2	4	4	9	0	0	4	55.0	0	0.0	0.0	0.0	0.0	PROJECT NAME: HARTLAND-BETHEL PROJECT NUMBER: STPG SIGN (40)				
VERMONT AGENCY OF TRANSPORTATION								SF	SF	EA	EA	EA	EA	EA	EA	EA	FT	EA	LB	LB	LB	LB	LB	FILE NAME: WOODSTOCK VT ROUTE 12 NE PROJECT MANAGER: AMY GAMBLE DESIGNED BY: M. MILLER WOODSTOCK VT-12 NORTHBOUND 4	8/1/2012	DRAWN BY: M. MILLER CHECKED: AMY GAMBLE SHEET 38 OF 86			
TOWN DIRECTIONAL TOTALS								126.3	0.0	12	6	6	32	0	0	24	360.0	0	0.0	0.0	0.0	0.0							

DIRECTION	MILEPOINT	LOCATION CODE (SHEET 2)	SIGN CODE	WIDTH (IN)	HEIGHT (IN)	SHEETING REMARKS	SIGN LEGEND	NEW SIGNS		EXISTING SIGNS			EXIST POST		NUMBER OF NEW POSTS	SQUARE STEEL (IN)			TUBULAR STEEL Ø (IN)				SIGN FRAME REQUIRED	REMARKS	SIGN DETAIL LOCATION				
								"A"	"B"	RETAIN	SALVAGE FROM	SALVAGE TO	REMOVE	RETAIN		REMOVE	1.75 (LB / FT)	2.00	2.50	FOUNDATION	3.00	3.50			4.00	5.00	SHSM	PROJECT SHEET #	STANDARD SHEET #
NB WOODSTOCK VT 12							FY-FLUORESCENT YELLOW FYG-FLUORESCENT YELLOW GREEN																"SHSM"-STANDARD HIGHWAY SIGNS AND MARKINGS						
NB	3.134	A	VD1-1A	72	12		 (CONT.)	6.00						2	12.0' / 12.0' X											9			
NB	3.173	C	M3-1	24	12		 NORTH																						
		C	M1-5	24	24		VT ROUTE 12																						
		C	M6-1L	21	15		<--- LEFT																						
		C	M3-3	24	12		SOUTH																						
		C	M1-5	24	24		VT ROUTE 12																						
		C	M6-1R	21	15		RIGHT --->																						
NB	3.191	A	VD2-1	72	12			6.00						2	13.5' / 14.0' X											10			
		C	M3-1	24	12			2.00																					
		C	M1-5	24	24			4.00																			E-136B		
NB	3.391	A	R2-1	24	30			5.00						1	14.0' X														
NB	3.436	A	VR-072	24	30		"DON'T DRINK AND DRIVE" SYMBOL WITH "THINK" TEXT																						
		A	VR-072	24	30		 (INSTALL BACK-TO-BACK) 	5.00						1	14.5' X											6			
		B	VR-072	24	30			5.00																		6			
SIGN SUMMARY SHEET							SHEET TOTALS	33.00	0.00	0	0	0	10	0	0	6	80.0	0	0.0	0.0	0.0	0.0							
VERMONT AGENCY OF TRANSPORTATION							TOWN DIRECTIONAL TOTALS	128.3	0.0	12	6	6	32	0	0	24	360.0	0	0.0	0.0	0.0	0.0							
PROJECT NAME: HARTLAND-BETHEL															PROJECT NUMBER: STPG SIGN (40)														
FILE NAME: WOODSTOCK VT ROUTE 12 NE															PLOT DATE: 8/1/2012														
PROJECT MANAGER: AMY GAMBLE															DRAWN BY: M. MILLER														
DESIGNED BY: M. MILLER															CHECKED: AMY GAMBLE														
WOODSTOCK VT-12 NORTHBOUND 5															SHEET 39 OF 86														

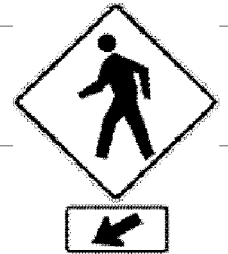

DIRECTION	MILEPOINT	LOCATION CODE (SHEET 2)	SIGN CODE	WIDTH (IN)	HEIGHT (IN)	SHEETING REMARKS	SIGN LEGEND	NEW SIGNS		EXISTING SIGNS					EXIST POST	NUMBER OF NEW POSTS	SQUARE STEEL (IN)			TUBULAR STEEL Ø (IN)				SIGN FRAME REQUIRED	REMARKS	SIGN DETAIL LOCATION							
								"A"	"B"	RETAIN	SALVAGE FROM	SALVAGE TO	REMOVE	RETAIN			REMOVE	1.75	2.00	2.50	FOUNDATION	3.00	3.50			4.00	5.00	SHSM	PROJECT SHEET #	STANDARD SHEET #			
																															(LB / FT)	(LB / FT)	(LB / FT)
SB WOODSTOCK VT 12							FY-FLUORESCENT YELLOW FYG-FLUORESCENT YELLOW GREEN															"SHSM"-STANDARD HIGHWAY SIGNS AND MARKINGS											
SB	1.423	F	W3-5	36	36																												
SB	1.366	F	W3-5	36	36			9.00																			X			NOTE: THE NEW SIGN IS LARGER			
SB	1.251	F	R2-1	24	30																												
		F	R2-1	30	36			7.50		I	I	I														X							
SB	1.211	F	W1-3R	30	30																												
		F	W13-1P	18	18																												
		F	W1-3R	30	30			6.25																		X							
		F	W13-1P	24	24			4.00																		X			NOTE: THE NEW PLAQUE IS LARGER				
SB	1.175	F	VD1-1A	54	7.5																												
		F	VD1-1A	72	12			6.00																									
SB	1.133	F	M3-3	24	12																												
		F	M1-5	24	24																												
		F	M3-3	24	12			2.00																		X			SOUTH, GREEN ON WHITE				
		F	M1-5	24	24			4.00																							E-136B		
SB	1.104	F	W11-2	30	30																												
SIGN SUMMARY SHEET							SHEET TOTALS	38.75	0.00	0	1	0	9	0	0	7	96.0	0	0.0	0.0	0.0	0.0	0.0										
								SF	SF	EA	EA	EA	EA	EA	EA	EA	EA	EA	EA	EA	EA	EA											
VERMONT AGENCY OF TRANSPORTATION							TOWN DIRECTIONAL TOTALS	141.5	0.0	7	1	1	25	0	0	26	390.0	0		0.0													
																											PROJECT NAME: HARTLAND-BETHEL PROJECT NUMBER: STPG SIGN (40)						
																											FILE NAME: WOODSTOCK VT ROUTE 12 SE PROJECT MANAGER: AMY GAMBLE DESIGNED BY: M. MILLER WOODSTOCK VT-12 SOUTHBOUND 3	PLOT DATE: 5/22/2012 DRAWN BY: M. MILLER CHECKED: AMY GAMBLE SHEET 42 OF 86					




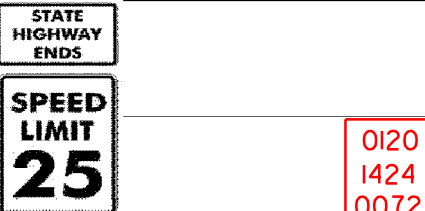


DIRECTION	MILEPOINT	LOCATION CODE (SHEET 2)	SIGN CODE	WIDTH (IN)	HEIGHT (IN)	SHEETING REMARKS	SIGN LEGEND	NEW SIGNS		EXISTING SIGNS				EXIST POST		NUMBER OF NEW POSTS	SQUARE STEEL (IN)			TUBULAR STEEL Ø (IN)				SIGN FRAME REQUIRED	REMARKS	SIGN DETAIL LOCATION						
								"A"	"B"	RETAIN	SALVAGE FROM	SALVAGE TO	REMOVE	RETAIN	REMOVE		1.75	2.00	2.50	3.00	3.50	4.00	5.00			SHSM	PROJECT SHEET #	STANDARD SHEET #				
																	(LB / FT)			(LB / FT)												
SB WOODSTOCK VT 12							FY-FLUORESCENT YELLOW FYG-FLUORESCENT YELLOW GREEN																"SHSM"-STANDARD HIGHWAY SIGNS AND MARKINGS									
SB	1.104	F	W16-9P	24	10		 AHEAD (PLAQUE) (CONT.)																									
		F	W11-2	30	30	FYG		6.25							1		16.0'									X						
		F	W16-9P	24	12	FYG		2.00																		X						
SB	1.064	F	R2-1	24	30		 SPEED LIMIT 35																									
		F	R2-1	24	30			5.00							1		14.0'									X						
SB	1.013	F	W11-2	30	30		 PEDESTRIAN SYMBOL  DIAGONAL DOWN ARROW LEFT																									
		F	W16-7PL	24	10																											
		F	W11-2	30	30	FYG		6.25							1		15.0'									X						
		F	W16-7PL	24	12	FYG	2.00																		X							
SB	0.857	F	VD-062B	72	16		OFFICIAL BUSINESS DIRECTIONAL SIGN			1				X																	BILLINGS FARM	
		F	VD-062AL	72	16			OFFICIAL BUSINESS DIRECTIONAL SIGN			1																					NATIONAL PARK
SB	0.822	F	R2-5A	24	30		 REDUCED SPEED AHEAD																								NOTE LOCATION AS REFERENCE FOR THE NEXT SIGN	
SB	0.810	F	W3-5	36	36			9.00							2		15.5'/15.5'								X					INSTALL 65 FT± SOUTH OF THE SIGN REMOVAL AT MP 0.822		
SB	0.717	F	VR-038	24	18		 STATE HIGHWAY ENDS																									
		F	R2-1	24	30			SPEED LIMIT 25 (CONT. ON NEXT PAGE)																								
SIGN SUMMARY SHEET							SHEET TOTALS	30.50	0.00	2	0	0	7	0	0	5	76.0	0	0.0	0.0	0.0	0.0		PROJECT NAME: HARTLAND-BETHEL								
VERMONT AGENCY OF TRANSPORTATION								SF	SF	EA	EA	EA	EA	EA	EA	EA	FT	EA	LB	LB	LB	LB		PROJECT NUMBER: STPG SIGN (40)								
TOWN DIRECTIONAL TOTALS							141.5	0.0	7	1	1	25	0	0	26	390.0	0	0.0	0.0	0.0	0.0		FILENAME: WOODSTOCK VT ROUTE 12 SE									
																						PROJECT MANAGER: AMY GAMBLE										
																						DESIGNED BY: M. MILLER										
																						WOODSTOCK VT-12 SOUTHBOUND 4										
																						PLOT DATE: 5/22/2012										
																						DRAWN BY: M. MILLER										
																						CHECKED BY: AMY GAMBLE										
																						SHEET: 43										
																						OF: 65										

DIRECTION	MILEPOINT	LOCATION CODE (SHEET 2)	SIGN CODE	WIDTH (IN)	HEIGHT (IN)	SHEETING REMARKS	SIGN LEGEND	NEW SIGNS		EXISTING SIGNS			EXIST POST		NUMBER OF NEW POSTS	SQUARE STEEL (IN)			TUBULAR STEEL Ø (IN)				SIGN FRAME REQUIRED	REMARKS	SIGN DETAIL LOCATION			
								"A"	"B"	RETAIN	SALVAGE FROM	SALVAGE TO	REMOVE	RETAIN		REMOVE	1.75	2.00	2.50	3.00	3.50	4.00			5.00	SHSM	PROJECT SHEET #	STANDARD SHEET #
																	(LB / FT)			(LB / FT)								
SB WOODSTOCK VT 12							FY-FLUORESCENT YELLOW FYG-FLUORESCENT YELLOW GREEN															"SHSM"-STANDARD HIGHWAY SIGNS AND MARKINGS						
SB	0.717	F	VR-038	24	18			3.00						1	14.0'											6		
		F	R2-1	30	36		0120 1424 0072	7.50		I	I	I													X			
SIGN SUMMARY SHEET							SHEET TOTALS	10.50	0.00	0	1	1	1	0	0	1	14.0'											
VERMONT AGENCY OF TRANSPORTATION							TOWN DIRECTIONAL TOTALS	141.5	0.0	7	1	1	25	0	0	26	390.0	0			0.0							


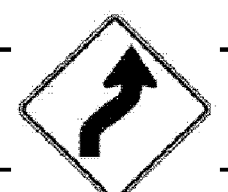

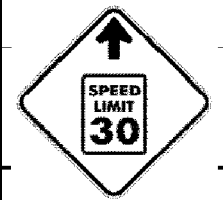
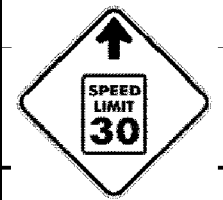

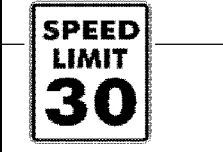
PROJECT NAME: HARTLAND-BETHEL
PROJECT NUMBER: STPG SIGN (40)
FILE NAME: WOODSTOCK VT ROUTE 12 SE
PROJECT MANAGER: AMY GAMBLE
DESIGNED BY: M. MILLER
WOODSTOCK VT-12 SOUTHBOUND 5



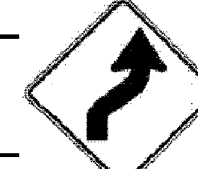
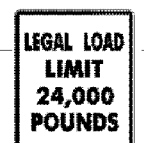






PLOT DATE: 5/22/2012
DRAWN BY: M. MILLER
CHECKED: AMY GAMBLE
SHEET 44 OF 86

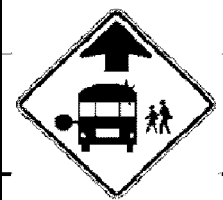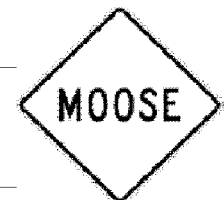


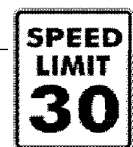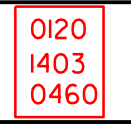

DIRECTION	MILEPOINT	LOCATION CODE (SHEET 2)	SIGN CODE	WIDTH (IN)	HEIGHT (IN)	SHEETING REMARKS	SIGN LEGEND	NEW SIGNS		EXISTING SIGNS			EXIST POST		NUMBER OF NEW POSTS	SQUARE STEEL (IN)			TUBULAR STEEL Ø (IN)					SIGN FRAME REQUIRED	REMARKS	SIGN DETAIL LOCATION			
								"A"	"B"	RETAIN	SALVAGE FROM	SALVAGE TO	REMOVE	RETAIN		REMOVE	1.75	2.00	2.50	(LB / FT)						SHSM	PROJECT SHEET #	STANDARD SHEET #	
																				3.00	3.50	4.00	5.00						
NB POMFRET VT 12							FY-FLUORESCENT YELLOW FYG-FLUORESCENT YELLOW GREEN																"SHSM"-STANDARD HIGHWAY SIGNS AND MARKINGS						
NB	0.353	A	W1-4R	30	30		RIGHT REVERSE CURVE																	NOTE LOCATION AS REFERENCE FOR THE NEXT SIGN					
NB	0.391	A	W1-4R	30	30			6.25																INSTALL ¹⁵⁰ 200 FT± NORTH OF THE REMOVAL AT MP 0.353	X				
NB	0.783	A	W1-5R	30	30		RIGHT WINDING CURVES																	NOTE LOCATION AS REFERENCE FOR THE NEXT SIGN					
NB	0.802	A	W1-5R	30	30		0120 1413 0080	6.25		I	I	I												INSTALL 100 FT± NORTH OF THE REMOVAL AT MP 0.783	X				
SIGN SUMMARY SHEET							SHEET TOTALS	12.50	0.00	0	0	0	0	0	0	2	30.0	0	0.0	0.0	0.0	0.0	0.0	PROJECT NAME: HARTLAND-BETHEL PROJECT NUMBER: STPG SIGN (40)					
VERMONT AGENCY OF TRANSPORTATION							TOWN DIRECTIONAL TOTALS	12.5	0.0	0	0	0	2	0	0	2	30.0	0	0.0	0.0	0.0	0.0	FILE NAME: POMFRET VT ROUTE 12 NB PROJECT MANAGER: AMY GAMBLE DESIGNED BY: M. MILLER POMFRET VT-12 NORTHBOUND 1	PLOT DATE: 6/24/2012 DRAWN BY: M. MILLER CHECKED BY: AMY GAMBLE SHEET 46 OF 86					




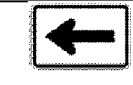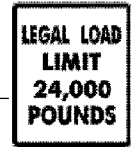

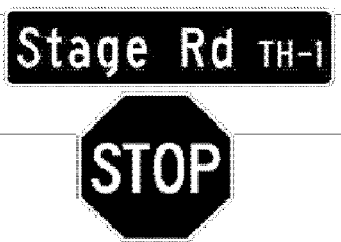DIRECTION	MILEPOINT	LOCATION CODE (SHEET 2)	SIGN CODE	WIDTH (IN)	HEIGHT (IN)	SHEETING REMARKS	SIGN LEGEND	NEW SIGNS		EXISTING SIGNS				EXIST POST		NUMBER OF NEW POSTS	SQUARE STEEL (IN)			TUBULAR STEEL Ø (IN)				SIGN FRAME REQUIRED	REMARKS	SIGN DETAIL LOCATION			
								"A"	"B"	RETAIN	SALVAGE FROM	SALVAGE TO	REMOVE	RETAIN	REMOVE		1.75	2.00	2.50	FOUNDATION						SHSM	PROJECT SHEET #	STANDARD SHEET #	
																				(LB / FT)									3.00
SB POMFRET VT 12							FY-FLUORESCENT YELLOW FYG-FLUORESCENT YELLOW GREEN																"SHSM"-STANDARD HIGHWAY SIGNS AND MARKINGS						
SB	1.022	F	S3-1	30	30		SCHOOL BUS STOP AHEAD																	SIGN IS NO LONGER WARRANTED					
SB	0.972	F	W11-4	30	30		CATTLE CROSSING (TEXT)																	RETAIN THE POST AND FLASHING BEACON ON TOP					
		F	VW-158	24	18		WHEN FLASHING (PLAQUE)																						
		F	W11-4	30	30			6.25																		X			
		F	VW-158	30	18			3.75																				8	
SB	0.627	F	W1-4R	30	30			6.25							1	13.0'	X								INSTALL BEHIND RAIL 120 FT+ NORTH OF (IN ADVANCE OF) MILE MARKER 0120 / 1413 / 0060 AT MP 0.604	X			
SB	0.253	G	VR-017	24	30																				WAYSIDE RD (TH-48)				
		G	VR-017	24	30			5.00			I	I	I					1	14.0'	X								6	
SB	0.247	H	R1-1	30	30		STOP			1															WAYSIDE RD (TH-48)				
SB	0.246	F	D3-1	30	9		WAYSIDE RD TH-8																	WHITE ON BLUE; NOTE: INCORRECT TOWN HIGHWAY NUMBER ON THIS SIGN					
		F	D3-1	60	12			5.00							1	14.5'	X							GREEN ON WHITE; DUE TO WIDTH INSTALL INDEPENDENTLY ON THE STOP SIGN SIDE OF THE INTERSECTION			11		
SB	0.000	G	VD-024	60	7.5		WOODSTOCK POMFRET																						
		G	VD-700	6	8		0120 / 1413 / 0000 (POMFRET MM)																						
		G	VD-700	6	8		0120 / 1424 / 0401 (Woodstock MM)																						
		G	VD-024	72	10		(SEE NEXT PAGE)	5.00							2	13.0' / 13.0'	X							INSTALL THIS ASSEMBLY BEHIND RAIL CENTERED IN THE EXACT POSITION AS THE REMOVAL			10		
SIGN SUMMARY SHEET							SHEET TOTALS	31.25	0.00	1	0	0	0	0	0	0	67.5	0	0.0	0.0	0.0	0.0	PROJECT NAME: HARTLAND-BETHEL PROJECT NUMBER: STPG SIGN (40)						
VERMONT AGENCY OF TRANSPORTATION							TOWN DIRECTIONAL TOTALS	32.1	0.0	1	0	0	8	0	0	6	90.0	0	0.0	0.0	0.0	FILE NAME: POMFRET VT ROUTE 12 SB PROJECT MANAGER: AMY GAMBLE DESIGNED BY: M. MILLER POMFRET VT-12 SOUTHBOUND 1							
																							PLOT DATE: 5/24/2012 DRAWN BY: M. MILLER CHECKED: AMY GAMBLE SHEET 46 OF 85						



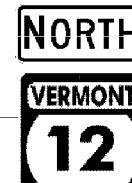

DIRECTION	MILEPOINT	LOCATION CODE (SHEET 2)	SIGN CODE	WIDTH (IN)	HEIGHT (IN)	SHEETING REMARKS	SIGN LEGEND	NEW SIGNS		EXISTING SIGNS				EXIST POST		NUMBER OF NEW POSTS	SQUARE STEEL (IN)			TUBULAR STEEL Ø (IN)				SIGN FRAME REQUIRED	REMARKS	SIGN DETAIL LOCATION			
								"A"	"B"	RETAIN	SALVAGE FROM	SALVAGE TO	REMOVE	RETAIN	REMOVE		1.75	2.00	2.50	FOUNDATION	3.00	3.50	4.00			5.00	SHSM	PROJECT SHEET #	STANDARD SHEET #
																	(LB / FT)				(LB / FT)								
SB POMFRET VT 12							FY-FLUORESCENT YELLOW FYG-FLUORESCENT YELLOW GREEN															"SHSM"-STANDARD HIGHWAY SIGNS AND MARKINGS							
SB	0.000	G	VD-700	6	10		Woodstock Pomfret (CONT.)	0.42															WOODSTOCK MILE MARKER; INSTALL ON THE LEFT POST UNDER WOODSTOCK			E-138			
		G	VD-700	6	10		<div style="display: flex; justify-content: space-around;"> <div style="border: 1px solid black; padding: 2px;">0120 1424 0401</div> <div style="border: 1px solid black; padding: 2px;">0120 1413 0000</div> </div>	0.42																	POMFRET MILE MARKER; INSTALL ON THE RIGHT POST UNDER POMFRET			E-138	
SIGN SUMMARY SHEET							SHEET TOTALS	0.84	0.00	0	0	0	0	0	0	0	0.0	0	0.0	0.0	0.0	0.0	PROJECT NAME: HARTLAND-BETHEL						
								SF	SF	EA	EA	EA	EA	EA	EA	EA	FT	EA	LB	LB	LB	LB	PROJECT NUMBER: STPG SIGN (40)						
VERMONT AGENCY OF TRANSPORTATION							TOWN DIRECTIONAL TOTALS	32.1	0.0	1	0	0	8	0	0	6	90.0	0		0.0			FILE NAME: POMFRET VT ROUTE 12 SB	PLOT DATE: 5/24/2012					
																						PROJECT MANAGER: AMY GAMBLE	DRAWN BY: M. MILLER						
																						DESIGNED BY: M. MILLER	CHECKED: AMY GAMBLE						
																						POMFRET VT-12 SOUTHBOUND 2	SHEET 47	OF 85					






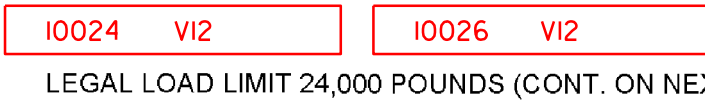
DIRECTION	MILEPOINT	LOCATION CODE (SHEET 2)	SIGN CODE	WIDTH (IN)	HEIGHT (IN)	SHEETING REMARKS	SIGN LEGEND	NEW SIGNS		EXISTING SIGNS				EXIST POST		NUMBER OF NEW POSTS	SQUARE STEEL (IN)			TUBULAR STEEL Ø (IN)				SIGN FRAME REQUIRED	REMARKS	SIGN DETAIL LOCATION		
								"A"	"B"	RETAIN	SALVAGE FROM	SALVAGE TO	REMOVE	RETAIN	REMOVE		1.75	2.00	2.50	3.00	3.50	4.00	5.00			SHSM	PROJECT SHEET #	STANDARD SHEET #
NB BARNARD VT 12							FY-FLUORESCENT YELLOW FYG-FLUORESCENT YELLOW GREEN																"SHSM"-STANDARD HIGHWAY SIGNS AND MARKINGS					
NB	2.605	A	S3-1	30	30			SCHOOL BUS STOP AHEAD (TEXT)																				
		A	S3-1	36	36	FYG		0.00 0.00																		X		
NB	2.661	A	VW-000	30	30			MOOSE CROSSING																				
		A	W7-3aP	24	18			NEXT 1 MILE (PLAQUE)																			7	
		A	VW-001	36	36			9.00																				
		A	VW-249	24	18			3.00																INSTALL THE PLAQUE ON THE LEFT SIDE POST			8	
NB	3.894	A	W11-6H	30	30			SNOWMOBILE CROSSING (HINGED SIGN)	6.25																			
																								THIS SIGN WAS IN POOR CONDITION. IT WAS REPLACED.				
NB	4.252	A	W3-5	36	36																							
		A	W3-5	36	36			9.00																	X			
NB	4.307	A	VD-018	30	18			Barnard Bethel 9																				
		A	VD-018	30	18			3.75																		14		
NB	4.413	A	R2-1	24	30																							
		A	R2-1	30	36			7.50																NOTE: THE NEW SIGN IS LARGER	X			
NB	4.463	A	S1-1	30	30			SCHOOL SYMBOL																				
		A	W16-9P	24	10			AHEAD (PLAQUE) (CONT. ON NEXT PAGE)																				
SIGN SUMMARY SHEET							SHEET TOTALS	38.50 41.25	0.00	0	0	0	9	0	0	8	89.0 120.0	0	0.0	0.0	0.0	0.0		PROJECT NAME: HARTLAND-BETHEL PROJECT NUMBER: STPG SIGN (40)				
VERMONT AGENCY OF TRANSPORTATION							TOWN DIRECTIONAL TOTALS	322.2	0.0	6	2	2	59	0	0	65	975.0	0		0.0				FILE NAME: BARNARD VT ROUTE 12 NB PROJECT MANAGER: AMY GAMBLE DESIGNED BY: M. MILLER BARNARD VT-12 NORTHBOUND 2	PLOT DATE: 8/1/2012 DRAWN BY: M. MILLER CHECKED: AMY GAMBLE SHEET 49 OF 86			




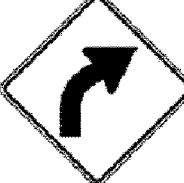
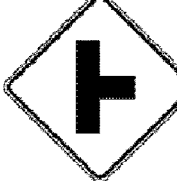
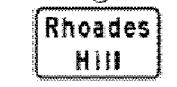


DIRECTION	MILEPOINT	LOCATION CODE (SHEET 2)	SIGN CODE	WIDTH (IN)	HEIGHT (IN)	SHEETING REMARKS	SIGN LEGEND	NEW SIGNS		EXISTING SIGNS				EXIST POST		NUMBER OF NEW POSTS	SQUARE STEEL (IN)			TUBULAR STEEL Ø (IN)				SIGN FRAME REQUIRED	REMARKS	SIGN DETAIL LOCATION						
								"A"	"B"	RETAIN	SALVAGE FROM	SALVAGE TO	REMOVE	RETAIN	REMOVE		1.75	2.00	2.50	FOUNDATION						SHSM	PROJECT SHEET #	STANDARD SHEET #				
																				(LB / FT)									3.00	3.50	4.00	5.00
NB BARNARD VT 12							FY-FLUORESCENT YELLOW FYG-FLUORESCENT YELLOW GREEN																"SHSM"-STANDARD HIGHWAY SIGNS AND MARKINGS									
NB	4.463	A	S1-1	36	36	FYG	 (CONT.)	9.00							2	16.0'	16.0'								NOTE: THE NEW SIGN IS LARGER	X						
		A	S4-3P	30	8	FYG		1.67																	SPAN THE PLAQUE ACROSS BOTH POSTS		8					
NB	4.550	A	R2-1	24	30							1																				
		A	R2-1	24	30			5.00							1	14.0'														X		
NB	4.581	A	VD-062BRN	36	8					1																						
NB	4.645	A	W1-1ML	30	30		MODIFIED LEFT TURN SYMBOL					1																				
		A	W13-1P	18	18							1																				
		A	W1-10L	36	36			9.00							2	15.0'	16.0'														X	
NB	4.740	A	M3-1	24	12			2.00							1	15.0'															X	
		A	M1-5	24	24			4.00																								
		A	M6-1L	21	15			2.19																							X	
NB	4.770	C	VR-017	24	30		LEGAL LOAD LIMIT 24,000 POUNDS					1																				
		C	R2-1	24	30		SPEED LIMIT 30			1		1																				
		C	VR-017	24	30			5.00							1	16.0'																6
		C	R2-1	24	30		SPEED LIMIT 30					1																				
SIGN SUMMARY SHEET							SHEET TOTALS	37.86	0.00	1	1	1	5	0	0	7	108.0	0	0.0	0.0	0.0	0.0										
VERMONT AGENCY OF TRANSPORTATION							TOWN DIRECTIONAL TOTALS	322.2	0.0	6	2	2	59	0	0	65	975.0	0		0.0												
															PROJECT NAME: HARTLAND-BETHEL PROJECT NUMBER: STPG SIGN (40)																	
															FILE NAME: BARNARD VT ROUTE 12 NB PROJECT MANAGER: AMY GAMBLE DESIGNED BY: M. MILLER BARNARD VT-12 NORTHBOUND 3																	
															PLOT DATE: 8/1/2012 DRAWN BY: M. MILLER CHECKED: AMY GAMBLE SHEET 60 OF 85																	





DIRECTION	MILEPOINT	LOCATION CODE (SHEET 2)	SIGN CODE	WIDTH (IN)	HEIGHT (IN)	SHEETING REMARKS	SIGN LEGEND	NEW SIGNS		EXISTING SIGNS			EXIST POST		NUMBER OF NEW POSTS	SQUARE STEEL (IN)			TUBULAR STEEL Ø (IN)				SIGN FRAME REQUIRED	REMARKS	SIGN DETAIL LOCATION				
								"A"	"B"	RETAIN	SALVAGE FROM	SALVAGE TO	REMOVE	RETAIN		REMOVE	1.75	2.00	2.50	FOUNDATION	3.00	3.50			4.00	5.00	SHSM	PROJECT SHEET #	STANDARD SHEET #
NB BARNARD VT 12							FY-FLUORESCENT YELLOW FYG-FLUORESCENT YELLOW GREEN																"SHSM"-STANDARD HIGHWAY SIGNS AND MARKINGS						
NB	4.774	D	R1-1	30	30		STOP				1		X																
		A	D3-1	48	12			4.00						1	14.0'	X									11				
		D	R1-1	30	30			6.25																X					
NB	4.775	C	D3-1	24	6		NORTH RD TH3				1		X																
		A	W1-6L	48	24		LARGE ARROW LEFT				1																		
		A	W1-6L	48	24			8.00						2	13.0'/13.0'	X								X					
NB	4.776	B	W1-6R	48	24						1		X																
		B	W1-6R	48	24			8.00			1			2	13.0'/13.0'	X								X					
NB	4.776	D	R1-1	30	30		STOP			1			1																
NB	4.776	C	VR-017	24	30		LEGAL LOAD LIMIT 24,000 POUNDS				1		X																
		C	R2-1	24	30		SPEED LIMIT 30			1																			
		C	VR-017	24	30			5.00						1	16.0'	X									6				
		C	R2-1	24	30		SPEED LIMIT 30				1																		
NB	4.784	D	R1-1	30	30						1		X																
		D	R1-1	30	30			6.25						1	14.0'	X								X					
SIGN SUMMARY SHEET								SHEET TOTALS		37.50	0.00	0	2	2	9	0	0	7	96.0	0	0.0	0.0	0.0	0.0	PROJECT NAME: HARTLAND-BETHEL PROJECT NUMBER: STPG SIGN (40)				
VERMONT AGENCY OF TRANSPORTATION								SF	SF	EA	EA	EA	EA	EA	EA	EA	EA	EA	EA	EA	EA	EA	EA	EA	FILE NAME: BARNARD VT ROUTE 12 NB PROJECT MANAGER: AMY GAMBLE DESIGNED BY: M. MILLER BARNARD VT-12 NORTHBOUND 4	PLOT DATE: 8/1/2012 DRAWN BY: M. MILLER CHECKED: AMY GAMBLE SHEET 61 OF 86			
TOWN DIRECTIONAL TOTALS								322.2	0.0	6	2	2	59	0	0	65	975.0	0	0.0	0.0	0.0	0.0							




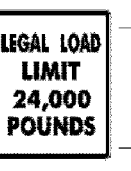

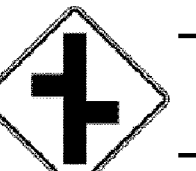
DIRECTION	MILEPOINT	LOCATION CODE (SHEET 2)	SIGN CODE	WIDTH (IN)	HEIGHT (IN)	SHEETING REMARKS	SIGN LEGEND	NEW SIGNS		EXISTING SIGNS				EXIST POST		NUMBER OF NEW POSTS	SQUARE STEEL (IN)			TUBULAR STEEL Ø (IN)				SIGN FRAME REQUIRED	REMARKS	SIGN DETAIL LOCATION			
								"A"	"B"	RETAIN	SALVAGE FROM	SALVAGE TO	REMOVE	RETAIN	REMOVE		1.75	2.00	2.50	FOUNDATION	3.00	3.50	4.00			5.00	SHSM	PROJECT SHEET #	STANDARD SHEET #
NB BARNARD VT 12							FY-FLUORESCENT YELLOW FYG-FLUORESCENT YELLOW/GREEN																"SHSM"-STANDARD HIGHWAY SIGNS AND MARKINGS						
NB	4.785	A	D3-1	54	12		North Rd TH-3	4.50							2	13.0'	14.0'	X									12		
NB	4.798	A	M3-1	24	12		NORTH																						
		A	M1-5	24	24		VT ROUTE 12																						
		A	VD2-1	72	12		Bethel 8	6.00							2	15.0'	16.0'	X									10		
		A	M3-1	24	12			2.00																	X				
		A	M1-5	24	24			4.00																				E-138B	
NB	4.816	A	R2-1	24	30																								
		A	R2-1	24	30			5.00							1	15.0'	X								X				
NB	5.047	A	R2-1	24	30																								
		A	R2-1	24	30			5.00							1	13.5'	X								X				
NB	5.164	A	D3-1	30	6		DAVIS RD TH72																						
NB	5.170	C	VR-017	24	30		LEGAL LOAD LIMIT 24,000 POUNDS																						
		C	VR-017	24	30			5.00							1	13.0'	X										6		
NB	5.174	D	R1-1	30	30																								
		D	R1-1	30	30			6.25							0	0	X								X				
SIGN SUMMARY SHEET							SHEET TOTALS	37.75	0.00	0	0	0	7	0	0	7	99.5	120.0		0	0.0	0.0	0.0	0.0	PROJECT NAME: HARTLAND-BETHEL PROJECT NUMBER: STPG SIGN (40)				
VERMONT AGENCY OF TRANSPORTATION							TOWN DIRECTIONAL TOTALS	322.2	0.0	6	2	2	59	0	0	65	975.0		0	0.0	0.0	0.0	0.0	FILE NAME: BARNARD VT ROUTE 12 NB PROJECT MANAGER: AMY GAMBLE DESIGNED BY: M. MILLER BARNARD VT-12 NORTHBOUND 5					PLOT DATE: 8/1/2012 DRAWN BY: M. MILLER CHECKED: AMY GAMBLE SHEET 62 OF 86



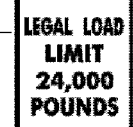


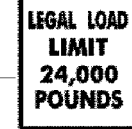

DIRECTION	MILEPOINT	LOCATION CODE (SHEET 2)	SIGN CODE	WIDTH (IN)	HEIGHT (IN)	SHEETING REMARKS	SIGN LEGEND	NEW SIGNS		EXISTING SIGNS				EXIST POST		NUMBER OF NEW POSTS	SQUARE STEEL (IN)			TUBULAR STEEL Ø (IN)				SIGN FRAME REQUIRED	REMARKS	SIGN DETAIL LOCATION			
								"A"	"B"	RETAIN	SALVAGE FROM	SALVAGE TO	REMOVE	RETAIN	REMOVE		1.75	2.00	2.50	FOUNDATION	3.00	3.50	4.00			5.00	SHSM	PROJECT SHEET #	STANDARD SHEET #
																	(LB / FT)				(LB / FT)								
NB BARNARD VT 12							FY-FLUORESCENT YELLOW FYG-FLUORESCENT YELLOW GREEN																"SHSM"-STANDARD HIGHWAY SIGNS AND MARKINGS						
NB	5.175	A	D3-1	54	12		Davis Rd TH-72	4.50						2	14.0' / 14.0'	X											12		
NB	5.441	C	VR-017	24	30							1		X		14.0'	X										6		
NB	5.447	D	R1-1	30	30							1		X		11.0'	X							X					
NB	5.451	A	D3-1	54	12		Davis Rd TH-72	4.50						2	14.0' / 14.0'	X											12		
NB	5.455	A	D3-1	30	6		DAVIS RD TH72					1		X															
NB	5.455	C	VR-017	24	30		LEGAL LOAD LIMIT 24,000 POUNDS					1		X															
NB	5.465	D	R1-1	30	30							1		X		14.0'	X							X					
NB	6.130	A	D3-1	36	6		BLACKMER RD TH-30					1		X															
NB	6.130	A	D3-1	66	12		Blackmer Rd TH-30	5.50				1			15.0' / 15.0'	X										12			
NB	6.132	C	VR-017	24	30							1		X		14.0'	X										6		
NB	6.140	D	R1-1	30	30		STOP (CONT. ON NEXT PAGE)					1		X															
SIGN SUMMARY SHEET							SHEET TOTALS			42.50	0.00	0	0	0	9	0	0	10	139.0	0	0.0	0.0	0.0	0.0	PROJECT NAME: HARTLAND-BETHEL PROJECT NUMBER: STPG SIGN (40)				
							SF	SF	EA	EA	EA	EA	EA	EA	EA	EA	EA	EA	EA	EA	EA	EA	EA	EA	EA	EA	EA	EA	EA
VERMONT AGENCY OF TRANSPORTATION							TOWN DIRECTIONAL TOTALS			322.2	0.0	6	2	2	59	0	0	65	975.0	0	0.0	0.0	0.0	0.0	FILE NAME: BARNARD VT ROUTE 12 NB PLOT DATE: 8/1/2012 PROJECT MANAGER: AMY GAMBLE DRAWN BY: M. MILLER DESIGNED BY: M. MILLER CHECKED BY: AMY GAMBLE BARNARD VT-12 NORTHBOUND 6 SHEET 63 OF 86				



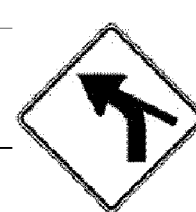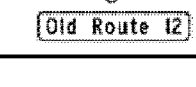


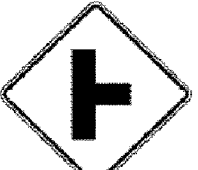


DIRECTION	MILEPOINT	LOCATION CODE (SHEET 2)	SIGN CODE	WIDTH (IN)	HEIGHT (IN)	SHEETING REMARKS	SIGN LEGEND	NEW SIGNS		EXISTING SIGNS				EXIST POST		NUMBER OF NEW POSTS	SQUARE STEEL (IN)			TUBULAR STEEL Ø (IN)				SIGN FRAME REQUIRED	REMARKS	SIGN DETAIL LOCATION			
								"A"	"B"	RETAIN	SALVAGE FROM	SALVAGE TO	REMOVE	RETAIN	REMOVE		1.75	2.00	2.50	FOUNDATION	3.00	3.50	4.00			5.00	SHSM	PROJECT SHEET #	STANDARD SHEET #
NB BARNARD VT 12							FY-FLUORESCENT YELLOW FYG-FLUORESCENT YELLOW GREEN																"SHSM"-STANDARD HIGHWAY SIGNS AND MARKINGS						
NB	6.140	D	R1-1	30	30		 (CONT.)	6.25							1	13.0' X									X				
NB	6.405	A	VW-133L	30	30							1					14.0' X										7		
NB	6.847	A	W2-2L	30	30			6.25							2	18.0' / 18.0' X									X			6	
NB	6.864	A	W2-2ML	30	30		MODIFIED LEFT SIDE ROAD					1																	
NB	7.180	A	M3-1	24	12			2.00							1	15.0' X									X			E-136B	
NB	7.221	A	M3-1	24	12		NORTH					1																	
NB	7.262	A	R2-1	24	30			5.00							1	14.0' X									X				
NB	7.739	A	R2-1	24	30		SPEED LIMIT 50					1																	
NB	7.878	A	W11-7	30	30		EQUESTRIAN SYMBOL					1																	
NB	8.642	C	VR-017	24	30		 NEXT 1/2 MILE					1																	
SIGN SUMMARY SHEET							SHEET TOTALS	36.00	0.00	0	2	2	10	0	0	6	92.0	0	0.0	0.0	0.0	0.0							
VERMONT AGENCY OF TRANSPORTATION							TOWN DIRECTIONAL TOTALS	322.2	0.0	6	2	2	59	0	0	65	975.0	0	0.0	0.0	0.0	0.0							
PROJECT NAME: HARTLAND-BETHEL															PROJECT NUMBER: STPG SIGN (40)														
FILE NAME: BARNARD VT ROUTE 12 NB															PLOT DATE: 8/1/2012														
PROJECT MANAGER: AMY GAMBLE															DRAWN BY: M. MILLER														
DESIGNED BY: M. MILLER															CHECKED: AMY GAMBLE														
BARNARD VT-12 NORTHBOUND 7															SHEET 64 OF 85														









DIRECTION	MILEPOINT	LOCATION CODE (SHEET 2)	SIGN CODE	WIDTH (IN)	HEIGHT (IN)	SHEETING REMARKS	SIGN LEGEND	NEW SIGNS		EXISTING SIGNS				EXIST POST		NUMBER OF NEW POSTS	SQUARE STEEL (IN)			TUBULAR STEEL Ø (IN)				SIGN FRAME REQUIRED	REMARKS	SIGN DETAIL LOCATION				
								"A"	"B"	RETAIN	SALVAGE FROM	SALVAGE TO	REMOVE	RETAIN	REMOVE		1.75	2.00	2.50	FOUNDATION	3.00	3.50	4.00			5.00	SHSM	PROJECT SHEET #	STANDARD SHEET #	
																														(LB/FT)
NB BARNARD VT 12							FY-FLUORESCENT YELLOW FYG-FLUORESCENT YELLOW GREEN																"SHSM"-STANDARD HIGHWAY SIGNS AND MARKINGS							
NB	8.642	C	VR-017	24	30		 (CONT.)	5.00							1	14.0'	X										6			
NB	8.648	D	R1-1	30	30		STOP																							
		A	D3-1	24	12		TH-66 NOT INSTALLED - SEE NOTE.								2	14.0'/14.0'	X										12			
		D	R1-1	30	30			6.25																			X			
NB	8.721	A	W1-2L	30	30																									
		A	W1-2L	30	30			6.25							1	15.0'	X										X			
NB	8.878	A	W1-2R	30	30			6.25							1	15.0'	X									X				
NB	8.890	A	W1-10R	30	30		MODIFIED RIGHT CURVE																							
		A	W16-8aP	24	18		RHAODES HILL (PLAQUE)																							
NB	8.918	A	W2-2R	30	30			6.25							1	15.0'	X										X			
		A	W16-8aP	24	15			2.50																				8		
NB	8.954	A	OM3-R	12	36																									
		A	OM3-R	12	36			3.00							1	11.0'	X									X				
NB	8.972	B	OM3-L	12	36																									
		B	OM3-L	12	36			3.00							1	11.0'	X									X				
SIGN SUMMARY SHEET								SHEET TOTALS		40.50	0.00	0	0	0	5	0	0	8	109.0		0	0.0	0.0	0.0	0.0	PROJECT NAME: HARTLAND-BETHEL PROJECT NUMBER: STPG SIGN (40)				
VERMONT AGENCY OF TRANSPORTATION								SF	SF	EA	EA	EA	EA	EA	EA	EA	FT	EA	LB	LB	LB	LB	FILE NAME: BARNARD VT ROUTE 12 NB PROJECT MANAGER: AMY GAMBLE DESIGNED BY: M. MILLER BARNARD VT-12 NORTHBOUND 8				PLOT DATE: 8/1/2012 DRAWN BY: M. MILLER CHECKED BY: AMY GAMBLE SHEET 65 OF 85			
TOWN DIRECTIONAL TOTALS								322.2	0.0	6	2	2	59	0	0	65	975.0	0				0.0								


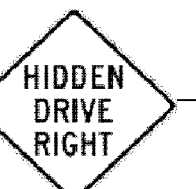
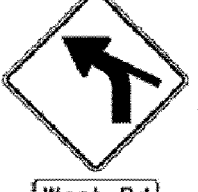
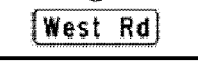
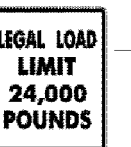

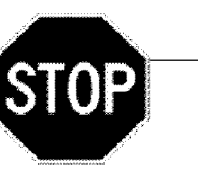



DIRECTION	MILEPOINT	LOCATION CODE (SHEET ?)	SIGN CODE	WIDTH (IN)	HEIGHT (IN)	SHEETING REMARKS	SIGN LEGEND	NEW SIGNS		EXISTING SIGNS				EXIST POST		NUMBER OF NEW POSTS	SQUARE STEEL (IN)			TUBULAR STEEL Ø (IN)				SIGN FRAME REQUIRED	REMARKS	SIGN DETAIL LOCATION			
								"A"	"B"	RETAIN	SALVAGE FROM	SALVAGE TO	REMOVE	RETAIN	REMOVE		1.75	2.00	2.50	FOUNDATION	3.00	3.50	4.00			5.00	SHSM	PROJECT SHEET #	STANDARD SHEET #
																	(LB / FT)				(LB / FT)								
NB BARNARD VT 12							FY-FLUORESCENT YELLOW FYG-FLUORESCENT YELLOW GREEN																"SHSM"-STANDARD HIGHWAY SIGNS AND MARKINGS						
NB	8.977	A	D3-1	66	12		Rhoades Hill TH-7	5.50							2	11.0' / 11.0' X									12				
NB	8.980	C	D3-1	30	6		RHOADES HILL TH7					1		X															
		C	VR-017	24	30		LEGAL LOAD LIMIT 24,000 POUNDS					1																	
		C	VR-017	24	30		 	5.00							1	14.0' X									6				
NB	8.986	D	R1-1	30	30							1		X															
		D	R1-1	30	30			6.25							1	13.0' X									X				
NB	9.357	A	VS3-4	36	36		SCHOOL BUS TURN AROUND			1			X																
NB	9.526 9.522	A	R2-1	24	30							1		X															
		A	R2-1	24	30			5.00							1	14.0' X									X				
NB	8.648	A	D3-1	66	12		HAMBSCH FARM RD. TH-66	5.50							2														
SIGN SUMMARY SHEET							SHEET TOTALS	27.25 24.76	0.00	1	0	0	5 4	0	0	5	63.0 75.0	0	0.0	0.0	0.0	0.0							
VERMONT AGENCY OF TRANSPORTATION							TOWN DIRECTIONAL TOTALS	322.2	0.0	6	2	2	59	0	0	65	975.0	0		0.0									
												PROJECT NAME: HARTLAND-BETHEL PROJECT NUMBER: STPG SIGN (40)				FILE NAME: BARNARD VT ROUTE 12 NB PROJECT MANAGER: AMY GAMBLE DESIGNED BY: M. MILLER BARNARD VT-12 NORTHBOUND 9				PLOT DATE: 8/1/2012 DRAWN BY: M. MILLER CHECKED: AMY GAMBLE SHEET 66 OF 86									




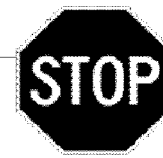

DIRECTION	MILEPOINT	LOCATION CODE (SHEET 2)	SIGN CODE	WIDTH (IN)	HEIGHT (IN)	SHEETING REMARKS	SIGN LEGEND	NEW SIGNS		EXISTING SIGNS			EXIST POST		NUMBER OF NEW POSTS	SQUARE STEEL (IN)			TUBULAR STEEL Ø (IN)				SIGN FRAME REQUIRED	REMARKS	SIGN DETAIL LOCATION				
								"A"	"B"	RETAIN	SALVAGE FROM	SALVAGE TO	REMOVE	RETAIN		REMOVE	1.75	2.00	2.50	3.00	3.50	4.00			5.00	SHSM	PROJECT SHEET #	STANDARD SHEET #	
																	(LB / FT)			(LB / FT)									
SB BARNARD VT 12							FY-FLUORESCENT YELLOW FYG-FLUORESCENT YELLOW GREEN															"SHSM"-STANDARD HIGHWAY SIGNS AND MARKINGS							
SB	9.569	F	VS3-4	36	36		SCHOOL BUS TURN AROUND		1																				
SB	9.480	F	W1-10cL	30	30		CURVE LEFT SIDE ROAD RIGHT				1																		
		F	W1-10cL	36	36			9.00							2	15.0'	15.0'								X				
		F	W16-8P	36	8			2.00																		8			
SB	9.261	F	D3-1	30	6		OLD ROUTE 12 TH70				1																		
		F	D3-1	66	12			5.50							2	11.0'	11.0'									12			
SB	9.261	G	VR-017	24	30		LEGAL LOAD LIMIT 24,000 POUNDS				1																		
		G	R2-1	18	24		SPEED LIMIT 25			1	1																		
		G	VR-017	24	30			5.00							1	14.0'										6			
		G	R2-1	18	24		SPEED LIMIT 25				1																		
SB	9.250	H	R1-1	30	30						1																		
		H	R1-1	30	30			6.25							1	14.0'									X				
SB	9.195	F	W2-7R	30	30		OFFSET 4-WAY INTERSECTION SYMBOL				1																		
		F	W2-7R	30	30			6.25							1	16.0'									X				
SB	9.087	G	VR-017	24	30		LEGAL LOAD LIMIT 24,000 POUNDS (CONT. ON NEXT PAGE)				1																		
SIGN SUMMARY SHEET							SHEET TOTALS	34.00	0.00	1	1	1	7	0	0	7	96.0												
								SF	SF	EA	EA	EA	EA	EA	EA	EA	FT	EA	LB	LB	LB	LB	LB						
VERMONT AGENCY OF TRANSPORTATION							TOWN DIRECTIONAL TOTALS	441.5	0.0	2	3	3	78	0	0	87	1305.0				0.0								
															PROJECT NAME: HARTLAND-BETHEL PROJECT NUMBER: STPG SIGN (40)														
															FILE NAME: BARNARD VT ROUTE 12 SB PROJECT MANAGER: AMY GAMBLE DESIGNED BY: M. MILLER BARNARD VT-12 SOUTHBOUND 1	PLOT DATE: 8/1/2012 DRAWN BY: M. MILLER CHECKED: AMY GAMBLE SHEET 67 OF 86													

DIRECTION	MILEPOINT	LOCATION CODE (SHEET 2)	SIGN CODE	WIDTH (IN)	HEIGHT (IN)	SHEETING REMARKS	SIGN LEGEND	NEW SIGNS		EXISTING SIGNS			EXIST POST		NUMBER OF NEW POSTS	SQUARE STEEL (IN)			TUBULAR STEEL Ø (IN)				SIGN FRAME REQUIRED	REMARKS	SIGN DETAIL LOCATION			
								"A"	"B"	RETAIN	SALVAGE FROM	SALVAGE TO	REMOVE	RETAIN		REMOVE	1.75	2.00	2.50	FOUNDATION					SHSM	PROJECT SHEET #	STANDARD SHEET #	
																				(LB / FT)								3.00
SB BARNARD VT 12							FY-FLUORESCENT YELLOW FYG-FLUORESCENT YELLOW GREEN																"SHSM"-STANDARD HIGHWAY SIGNS AND MARKINGS					
SB	9.087	G	VR-017	24	30		 10445 (CONT.)	5.00							1	14.0'										6		
SB	9.081	H	R1-1	30	30		10443 STOP																					
		F	D3-1	24	12		 0120 1403 0909	2.00							1	14.0'										12		
		H	R1-1	30	30			6.25																	X			
SB	8.979	F	OM3-R	12	36			3.00							1	11.0'									X			
SB	8.960	E	OM3-L	12	36			3.00							1	11.0'									X			
SB	8.920	G	R2-1	18	24		SPEED LIMIT 25			1		1																
		G	VR-017	24	30		LEGAL LOAD LIMIT 24,000 POUNDS																					
		G	VR-017	24	30			5.00							1	16.0'										6		
		G	R2-1	18	24		SPEED LIMIT 25					1																
SB	8.918	F	D3-1	36	6		MASTERTSON RD TH8																					
		F	D3-1	66	12			5.50							2	11.0'/11.0'										12		
SB	8.910	H	R1-1	30	30		STOP (CONT. ON NEXT PAGE)																					
SIGN SUMMARY SHEET							SHEET TOTALS	29.75	0.00	0	3	3	11	0	0	7	88.0	0	0.0	0.0	0.0	0.0	PROJECT NAME: HARTLAND-BETHEL PROJECT NUMBER: STPG SIGN (40)					
VERMONT AGENCY OF TRANSPORTATION							TOWN DIRECTIONAL TOTALS	441.5	0.0	2	3	3	78	0	0	87	1305.0	0	0.0	0.0	0.0	0.0	FILE NAME: BARNARD VT ROUTE 12 SB PROJECT MANAGER: AMY GAMBLE DESIGNED BY: M. MILLER BARNARD VT-12 SOUTHBOUND 2	PLOT DATE: 8/1/2012 DRAWN BY: M. MILLER CHECKED: AMY GAMBLE SHEET 58 OF 85				

DIRECTION	MILEPOINT	LOCATION CODE (SHEET 2)	SIGN CODE	WIDTH (IN)	HEIGHT (IN)	SHEETING REMARKS	SIGN LEGEND	NEW SIGNS		EXISTING SIGNS				EXIST POST		NUMBER OF NEW POSTS	SQUARE STEEL (IN)			TUBULAR STEEL Ø (IN)				SIGN FRAME REQUIRED	REMARKS	SIGN DETAIL LOCATION			
								"A"	"B"	RETAIN	SALVAGE FROM	SALVAGE TO	REMOVE	RETAIN	REMOVE		1.75	2.00	2.50	FOUNDATION	3.00	3.50	4.00			5.00	SHSM	PROJECT SHEET #	STANDARD SHEET #
SB BARNARD VT 12							FY-FLUORESCENT YELLOW FYG-FLUORESCENT YELLOW GREEN																"SHSM"-STANDARD HIGHWAY SIGNS AND MARKINGS						
SB	8.910	H	R1-1	30	30		 (CONT.)	6.25						1	14.0'	X									X				
SB	8.882	F	W1-2R	30	30			6.25						1	15.0'	X									X		INSTALL 150 FT± SOUTH OF THE STOP SIGN AT MP 8.910		
SB	8.516	F	W11-7	30	30		EQUESTRIAN SYMBOL							1													SIGNS NO LONGER WARRANTED		
		F	W7-3A	24	18		NEXT 1/2 MILE							1															
SB	7.456	G	VR-017	24	30																						FORT DEFIANCE HILL (TH-28)		
		G	VR-017	24	30			5.00						1	14.0'	X									6				
SB	7.450	H	R1-1	30	30																						FORT DEFIANCE HILL (TH-28)		
		H	R1-1	30	30			6.25						0	0	*									X		STOP SIGN WAS ATTACHED TO STREET SIGN POST.		
SB	7.449	F	D3-1	48	6																						*THIS SIGN WAS RETURNED TO THE TOWN ROAD CREW.		
		F	D3-1	72	12		Fort Defiance Hill TH-28	6.00						2	13.0'/13.5'	X									12		DUE TO SIGN WIDTH, INSTALL INDEPENDENTLY ON TWO POSTS BEHIND RAIL ON THE STOP SIGN SIDE OF THE INTERSECTION		
SB	7.152	F	W2-2MR	30	30																								
		F	W2-2R	30	30			6.25						1	14.0'	X									X				
SB	7.062	G	VR-017	24	30		  TH-5																				MT HUNGER RD (TH-5), NORTHERLY APPROACH; SIGN AND POST MISSING		
		G	VR-017	24	30			5.00						1	14.0'	X									6		INSTALL THE SIGN ON TH-5 JUST BEYOND THE CONVERGANCE OF THE TWO APPROACHES		
SB	7.055	H	R1-1	24	24		STOP (CONT. ON NEXT PAGE)																				MT HUNGER RD (TH-5), NORTHERLY APPROACH		
SIGN SUMMARY SHEET							SHEET TOTALS	41.00	0.00	0	1	1	7	0	0	8	37.5	120.0	0	0.0	0.0	0.0	0.0						PROJECT NAME: HARTLAND-BETHEL PROJECT NUMBER: STPG SIGN (40)
VERMONT AGENCY OF TRANSPORTATION							TOWN DIRECTIONAL TOTALS	441.5	0.0	2	3	3	78	0	0	87	1305.0	0		0.0									FILE NAME: BARNARD VT ROUTE 12 SB PROJECT MANAGER: AMY GAMBLE DESIGNED BY: M. MILLER BARNARD VT-12 SOUTHBOUND 3
																												PLOT DATE: 8/1/2012 DRAWN BY: M. MILLER CHECKED BY: AMY GAMBLE SHEET 69 OF 86	

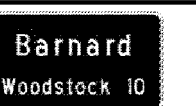







DIRECTION	MILEPOINT	LOCATION CODE (SHEET 2)	SIGN CODE	WIDTH (IN)	HEIGHT (IN)	SHEETING REMARKS	SIGN LEGEND	NEW SIGNS		EXISTING SIGNS				EXIST POST		NUMBER OF NEW POSTS	SQUARE STEEL (IN)			TUBULAR STEEL Ø (IN)					REMARKS	SIGN DETAIL LOCATION					
								"A"	"B"	RETAIN	SALVAGE FROM	SALVAGE TO	REMOVE	RETAIN	REMOVE		1.75	2.00	2.50	FOUNDATION						SHSM	PROJECT SHEET #	STANDARD SHEET #			
																				(LB / FT)									3.00	3.50	4.00
																								(LB / FT)							
																1.88	2.42	3.35	7.60	9.00	10.80	14.60									
SB BARNARD VT 12							FY-FLUORESCENT YELLOW FYG-FLUORESCENT YELLOW GREEN																"SHSM"-STANDARD HIGHWAY SIGNS AND MARKINGS								
SB	7.055	H	R1-1	30	30		 (CONT.)	6.25							2 1	11.0' / 11.0' X									X						
SB	7.037	H	R1-1	24	24																			X							
		H	R1-1	30	30			6.25							1	14.0' X									X						
SB	7.036	F	D3-1	30	6		MT HUNGER TH5																								
		F	D3-1	72	12			6.00							0 -2	0 *										12					
SB	6.974 6.988	F	D3-1	72	12			6.00		I					2	14.0' / 14.0' X										12					
SB	6.984	G	VR-017	24	30		 																								
		G	VR-017	24	30			5.00		I	I				1	14.0' X										6					
SB	6.974	H	R1-1	30	30																										
		H	R1-1	30	30			6.25							0 -	0 *										X					
SB	6.974	F	D3-1	54	6		CHATEAUGUAY RD TH-29																								
SB	6.924	F	M3-3	24	12		SOUTH																								
		F	M1-5	24	24		VT ROUTE 12																								
		F	M3-3	24	12			2.00									15.0' X								X						
		F	M1-5	24	24			4.00																			E-136B				
SIGN SUMMARY SHEET							SHEET TOTALS	41.75	0.00	0	1	1	6	0	0	7	93.0 136.0	0	0.0	0.0	0.0	0.0									
VERMONT AGENCY OF TRANSPORTATION							TOWN DIRECTIONAL TOTALS	441.5	0.0	2	3	3	78	0	0	87	1305.0	0		0.0											
PROJECT NAME: HARTLAND-BETHEL																PROJECT NUMBER: STPG SIGN (40)										PLOT DATE: 8/11/2012					
FILE NAME: BARNARD VT ROUTE 12 SB																PROJECT MANAGER: AMY GAMBLE										DRAWN BY: M. MILLER					
DESIGNED BY: M. MILLER																BARNARD VT-12 SOUTHBOUND 4										CHECKED: AMY GAMBLE					
																										SHEET 60 OF 86					




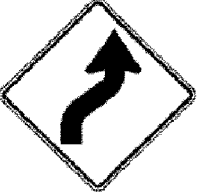



DIRECTION	MILEPOINT	LOCATION CODE (SHEET 2)	SIGN CODE	WIDTH (IN)	HEIGHT (IN)	SHEETING REMARKS	SIGN LEGEND	NEW SIGNS		EXISTING SIGNS					EXIST POST		NUMBER OF NEW POSTS	SQUARE STEEL (IN) (LB / FT)			TUBULAR STEEL Ø (IN) (LB / FT)					SIGN FRAME REQUIRED	REMARKS	SIGN DETAIL LOCATION		
								"A"	"B"	RETAIN	SALVAGE FROM	SALVAGE TO	REMOVE	RETAIN	REMOVE	1.75		2.00	2.50	3.00	3.50	4.00	5.00	SHSM	PROJECT SHEET #			STANDARD SHEET #		
SB BARNARD VT 12							FY-FLUORESCENT YELLOW FYG-FLUORESCENT YELLOW GREEN																"SHSM"-STANDARD HIGHWAY SIGNS AND MARKINGS							
SB	6.826	F	R2-1	24	30			5.00								1	14.0' X									INSTALL 190 FT+ NORTH OF (IN ADVANCE OF) THE SIGN AT MP 6.790	X			
SB	6.790	F	R2-1	24	30		SPEED LIMIT 50								1															
SB	6.496	F	VW-054R	30	30										1															
		F	VW-054R	30	30											1	15.0' X											7		
SB	5.277	F	W1-10cL	36	36			9.00								2	15.0' / 16.0' X									INSTALL 460 ⁵⁷⁵ FT+ NORTH OF (IN ADVANCE OF) THE JCT WITH WEST RD (TH-5)	X			
		F	W16-8P	24	8			1.33																		INSTALL THE PLAQUE ON THE RIGHT SIDE POST		8		
SB	5.192	G	VR-017	24	30									1												WEST RD (TH-5)				
		G	VR-017	24	30			5.00		1	1	2				1	16.0' X									THIS SIGN WAS IN POOR CONDITION. IT WAS DISCARDED.		6		
SB	5.176	H	R1-1	30	30									1												WEST RD (TH-5)				
		H	R1-1	30	30			6.25							1	14.0' X											X			
SB	5.175	F	D3-1	24	6		WEST RD TH-5									1														
		F	D3-1	48	12			4.00								2	11.0' / 11.0' X									INSTALL BEHIND RAIL INDEPENDENTLY ON TWO POSTS ON THE STOP SIGN SIDE OF THE INTERSECTION		12		
SB	5.158	F	W3-5	36	36									1																
		F	W3-5	36	36			9.00							2	15.0' / 15.0' X											X			
SB	5.105	F	VD-018	30	18			3.75							1	13.0' X										INSTALL 66 ²⁵ FT+ NORTH OF THE EXISTING VILLAGE SIGN AT MP 5.093		14		
SIGN SUMMARY SHEET							SHEET TOTALS		49.58	0.00	0	1	1	8	0	0	11	155.0	0.0	0.0	0.0	0.0	0.0	0.0	0.0	0.0	PROJECT NAME: HARTLAND-BETHEL PROJECT NUMBER: STPG SIGN (40)	FILE NAME: BARNARD VT ROUTE 12 SB PROJECT MANAGER: AMY GAMBLE DESIGNED BY: M. MILLER BARNARD VT-12 SOUTHBOUND 5	PLOT DATE: 8/1/2012 DRAWN BY: M. MILLER CHECKED: AMY GAMBLE SHEET 61 OF 86	
VERMONT AGENCY OF TRANSPORTATION							TOWN DIRECTIONAL TOTALS		441.5	0.0	2	3	3	78	0	0	87	1305.0	0	0.0	0.0	0.0	0.0							







DIRECTION	MILEPOINT	LOCATION CODE (SHEET 2)	SIGN CODE	WIDTH (IN)	HEIGHT (IN)	SHEETING REMARKS	SIGN LEGEND	NEW SIGNS		EXISTING SIGNS				EXIST POST		NUMBER OF NEW POSTS	SQUARE STEEL (IN)			TUBULAR STEEL Ø (IN)					SIGN FRAME REQUIRED	REMARKS	SIGN DETAIL LOCATION		
								"A"	"B"	RETAIN	SALVAGE FROM	SALVAGE TO	REMOVE	RETAIN	REMOVE		1.75	2.00	2.50	(LB / FT)							SHSM	PROJECT SHEET #	STANDARD SHEET #
																				3.00	3.50	4.00	5.00						
SB BARNARD VT 12							FY-FLUORESCENT YELLOW FYG-FLUORESCENT YELLOW GREEN																	"SHSM"-STANDARD HIGHWAY SIGNS AND MARKINGS					
SB	5.093	F	VD-018	30	18		BARNARD WOODSTOCK 10																						
SB	5.040	F	R2-1	24	30																								
		F	R2-1	30	36			7.50																					
SB	4.974	F	VD-062BRN	36	8		SILVER LAKE STATE PARK			1																			
SB	4.937	F	R2-1	24	30																								
		F	R2-1	24	30			5.00																					
SB	4.877	F	W1-1MR	30	30		MODIFIED RIGHT TURN																						
		F	W13-1P	18	18		25-MPH (PLAQUE)																						
SB	4.816	G	VR-017	24	30																								
		G	VR-017	24	30			5.00																					
SB	4.811	H	R1-1	30	30																								
		H	R1-1	30	30			6.25																					
SB	4.810	F	D3-1	24	6																								
		F	D3-1	60	12			5.00																					
SB	4.797	F	M3-3	24	12		(SEE NEXT PAGE)																						
SIGN SUMMARY SHEET								SHEET TOTALS		30.75	0.00	1	0	0	8	0	0	7	37.0	0	0.0	0.0	0.0	0.0	PROJECT NAME: HARTLAND-BETH EL PROJECT NUMBER: STPG SIGN (40)				
VERMONT AGENCY OF TRANSPORTATION								SF	SF	EA	EA	EA	EA	EA	EA	EA	EA	EA	FT	EA	LB	LB	LB	LB	FILE NAME: BARNARD VT ROUTE 12 SB PROJECT MANAGER: AMY GAMBLE DESIGNED BY: M. MILLER BARNARD VT-12 SOUTHBOUND 6	PLOT DATE: 8/1/2012 DRAWN BY: M. MILLER CHECKED: AMY GAMBLE SHEET 62 OF 86			
TOWN DIRECTIONAL TOTALS								441.5	0.0	2	3	3	78	0	0	87	1305.0	0	0.0	0.0	0.0	0.0							

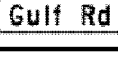







DIRECTION	MILEPOINT	LOCATION CODE (SHEET 2)	SIGN CODE	WIDTH (IN)	HEIGHT (IN)	SHEETING REMARKS	SIGN LEGEND	NEW SIGNS		EXISTING SIGNS			EXIST POST		NUMBER OF NEW POSTS	SQUARE STEEL (IN)			TUBULAR STEEL Ø (IN)					SIGN FRAME REQUIRED	REMARKS	SIGN DETAIL LOCATION			
								"A"	"B"	RETAIN	SALVAGE FROM	SALVAGE TO	REMOVE	RETAIN		REMOVE	1.75 (LB / FT)	2.00	2.50	FOUNDATION						SHSM	PROJECT SHEET #	STANDARD SHEET #	
																				3.00	3.50	4.00	5.00						7.60
SB BARNARD VT 12							FY-FLUORESCENT YELLOW FYG-FLUORESCENT YELLOW GREEN															"SHSM"-STANDARD HIGHWAY SIGNS AND MARKINGS							
SB	4.797	F	M1-5	24	24		(CONT.)	4.00															VT ROUTE 12			E-136B			
		F	M6-1R	21	15			2.19														X	RIGHT ARROW, GREEN ON WHITE						
SB	4.738	F	M3-3	24	12		SOUTH																						
		F	M1-5	24	24		VT ROUTE 12																						
		F	M3-3	24	12			2.00														X	SOUTH, GREEN ON WHITE						
		F	M1-5	24	24			4.00															VT ROUTE 12			E-136B			
SB	4.707	F	S1-1	30	30		SCHOOL SYMBOL																						
		F	W16-9P	24	10		AHEAD PLAQUE																						
		F	S1-1	36	36	FYG		9.00														X	NOTE: THE NEW SIGN IS LARGER						
		F	S4-3P	30	8	FYG		2.00															SPAN THE PLAQUE ACROSS BOTH POSTS		8				
		F	S4-3P	30	8	FYG		1.67																					
SB	4.670	F	R2-1	24	30																								
		F	R2-1	24	30			5.00														X							
SB	4.621	G	VR-017	24	30		LEGAL LOAD LIMIT 24,000 POUNDS																						
		F	R6-2R	18	24		ONE WAY RIGHT																						
		E	R6-2L	18	24		ONE WAY LEFT (CONT. ON NEXT PAGE)																						
SIGN SUMMARY SHEET							SHEET TOTALS	29.86 27.86	0.00	0	0	0	9 8	0	0	4	60.0	0	0.0	0.0	0.0	0.0		PROJECT NAME: HARTLAND-BETHEL PROJECT NUMBER: STPG SIGN (40)					
								SF	SF	EA	EA	EA	EA	EA	EA	EA	FT	EA	LB	LB	LB	LB		FILE NAME: BARNARD VT ROUTE 12 SB PROJECT MANAGER: AMY GAMBLE DESIGNED BY: M. MILLER BARNARD VT-12 SOUTHBOUND 7					
VERMONT AGENCY OF TRANSPORTATION							TOWN DIRECTIONAL TOTALS	441.5	0.0	2	3	3	78	0	0	87	1305.0	0		0.0					PLOT DATE: 8/1/2012 DRAWN BY: M. MILLER CHECKED: AMY GAMBLE SHEET 63 OF 86				





DIRECTION	MILEPOINT	LOCATION CODE (SHEET 2)	SIGN CODE	WIDTH (IN)	HEIGHT (IN)	SHEETING REMARKS	SIGN LEGEND	NEW SIGNS		EXISTING SIGNS			EXIST POST		NUMBER OF NEW POSTS	SQUARE STEEL (IN)			TUBULAR STEEL Ø (IN)				SIGN FRAME REQUIRED	REMARKS	SIGN DETAIL LOCATION			
								"A"	"B"	RETAIN	SALVAGE FROM	SALVAGE TO	REMOVE	RETAIN		REMOVE	1.75	2.00	2.50	FOUNDATION					SHSM	PROJECT SHEET #	STANDARD SHEET #	
																				(LB / FT)								3.00
SB BARNARD VT 12							FY-FLUORESCENT YELLOW FYG-FLUORESCENT YELLOW GREEN																"SHSM"-STANDARD HIGHWAY SIGNS AND MARKINGS					
SB	4.621	G	VR-017	24	30		BACK-TO-BACK (CONT.)	5.00						1	14.0'	X									6			
		H	R5-1a	36	24			6.00																X				
SB	4.615	H	R5-1	30	30		DO NOT ENTER																					
		F	R6-1R	36	12		BACK-TO-BACK	3.00						1	11.0'	X								X				
		E	R6-1L	36	12			3.00																X				
SB	4.584	F	R6-2L	18	24		ONE WAY LEFT																					
		E	R6-2R	18	24		ONE WAY RIGHT																					
		G	R5-1	30	30		DO NOT ENTER																					
		G	R5-1	30	30			6.25						1	14.0'	X								X				
		F	R6-1L	36	12		BACK-TO-BACK	3.00																X				
		E	R6-1R	36	12			3.00																X				
SB	4.576	H	R1-1	30	30		STOP																					
		F	D3-1	24	12			2.00						1	14.0'	X									12			
		H	R1-1	30	30			6.25																X				
SB	4.527	F	R2-1	24	30		SPEED LIMIT 30 (CONT. ON NEXT PAGE)																					
SIGN SUMMARY SHEET							SHEET TOTALS	37.50 37.51	0.00	0	1	0	7	0	0	4	53.0	46.0	0	0.0	0.0	0.0	0.0	0.0	PROJECT NAME: HARTLAND-BETHEL PROJECT NUMBER: STPG SIGN (40)			
VERMONT AGENCY OF TRANSPORTATION							TOWN DIRECTIONAL TOTALS	441.5	0.0	2	3	3	78	0	0	87	1305.0	0	0.0	0.0	0.0	0.0	0.0	FILENAME: BARNARD VT ROUTE 12 SB PROJECT MANAGER: AMY GAMBLE DESIGNED BY: M. MILLER BARNARD VT-12 SOUTHBOUND 8	PLOT DATE: 8/1/2012 DRAWN BY: M. MILLER CHECKED BY: AMY GAMBLE SHEET 64 OF 85			

DIRECTION	MILEPOINT	LOCATION CODE (SHEET 2)	SIGN CODE	WIDTH (IN)	HEIGHT (IN)	SHEETING REMARKS	SIGN LEGEND	NEW SIGNS		EXISTING SIGNS			EXIST POST		NUMBER OF NEW POSTS	SQUARE STEEL (IN)			TUBULAR STEEL Ø (IN)				SIGN FRAME REQUIRED	REMARKS	SIGN DETAIL LOCATION				
								"A"	"B"	RETAIN	SALVAGE FROM	SALVAGE TO	REMOVE	RETAIN		REMOVE	1.75	2.00	2.50	FOUNDATION	3.00	3.50			4.00	5.00	SHSM	PROJECT SHEET #	STANDARD SHEET #
SB BARNARD VT 12							FY-FLUORESCENT YELLOW FYG-FLUORESCENT YELLOW GREEN																"SHSM"-STANDARD HIGHWAY SIGNS AND MARKINGS						
SB	4.527	F	R2-1	24	30		 (CONT.)	5.00						1	14.0'	X									X				
SB	4.405	F	R2-1	24	30			5.00						1	14.0'	X									X				
SB	4.125	G	VR-017	24	30			5.00						1	14.0'	X										6			
SB	4.120	H	R1-1	30	30									0	0	*									X				
SB	4.119	F	D3-1	36	6			5.00						2	14.0'/14.0'	X										13			
SB	3.656	F	D3-1	24	6		GULF RD TH-62																						
SB	3.650	G	VR-017	24	30			5.00						1	14.0'	X										6			
SB	3.644	H	R1-1	30	30			0.00 -6.25						0	0	*									X				
SB	3.643	F	D3-1	48	12			4.00						2	14.0'/14.0'	X										11			
SIGN SUMMARY SHEET							SHEET TOTALS	35.25 -41.50	0.00	0	0	1	1	6	0	0	8	112.0 -150.0	0	0.0	0.0	0.0	0.0	0.0	PROJECT NAME: HARTLAND-BETHEL PROJECT NUMBER: STPG SIGN (40)				
VERMONT AGENCY OF TRANSPORTATION							TOWN DIRECTIONAL TOTALS	441.5	0.0	2	3	3	3	78	0	0	87	1305.0	0	0.0	0.0	0.0	0.0	0.0	FILE NAME: BARNARD VT ROUTE 12 SB PROJECT MANAGER: AMY GAMBLE DESIGNED BY: M. MILLER BARNARD VT-12 SOUTHBOUND 9				
																								PLOT DATE: 8/1/2012 DRAWN BY: M. MILLER CHECKED BY: AMY GAMBLE SHEET 65 OF 85					



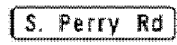


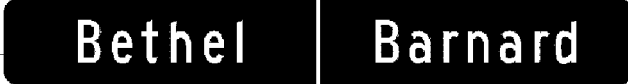




DIRECTION	MILEPOINT	LOCATION CODE (SHEET 2)	SIGN CODE	WIDTH (IN)	HEIGHT (IN)	SHEETING REMARKS	SIGN LEGEND	NEW SIGNS		EXISTING SIGNS			EXIST POST		NUMBER OF NEW POSTS	SQUARE STEEL (IN)			TUBULAR STEEL Ø (IN)				SIGN FRAME REQUIRED	REMARKS	SIGN DETAIL LOCATION			
								"A"	"B"	RETAIN	SALVAGE FROM	SALVAGE TO	REMOVE	RETAIN		REMOVE	1.75	2.00	2.50	3.00	3.50	4.00			5.00	SHSM	PROJECT SHEET #	STANDARD SHEET #
																	(LB / FT)			(LB / FT)								
SB BARNARD VT 12							FY-FLUORESCENT YELLOW FYG-FLUORESCENT YELLOW GREEN															"SHSM"-STANDARD HIGHWAY SIGNS AND MARKINGS						
SB	3.588	F	VW-000	30	30		MOOSE CROSSING (TEXT)																SIGNS AND POST MISSING					
		F	W7-3ap	24	18		NEXT 1 MILE (PLAQUE)																					
		F	VW-001	36	36			9.00						2	16.0'	17.0'							INSTALL ³⁰ 290 FT± SOUTH OF THE SIGN INSTALLED AT MP 3.643		7			
		F	VW-249	24	18			3.00															INSTALL THE PLAQUE ON THE LEFT SIDE POST		8			
SB	3.250	F	W7-1a	30	30		HILL SYMBOL 7%				1		X															
SB	3.133	F	W1-4R	30	30		RIGHT REVERSE CURVE				1		X															
		F	W7-1a	30	30			6.25						1	15.0'										X			
SB	3.017	F	W1-4R	30	30			6.25						1	15.0'								INSTALL ⁶⁵⁰ 416 FT± SOUTH OF THE PREVIOUS POSITION AT MP 3.133	X				
SB	2.924	F	S3-1	30	30		SCHOOL BUS STOP AHEAD (TEXT)				1		X										NOTE LOCATION AS REFERENCE FOR THE NEXT SIGN					
SB	2.916	F	S3-1	36	36	FYG		0.00 9.00						0 2	0 X						THIS IS NOT WARRANTED.	INSTALL 40 FT± SOUTH OF THE PREVIOUS POSITION AT MP 2.924	X					
SB	2.717	F	W11-7	30	30		EQUESTRIAN SYMBOL				1		X										SIGNS NO LONGER WARRANTED					
		F	W11-7P	24	18		EQUESTRIAN XING (PLAQUE)				1																	
SB	2.322	F	W1-10cL	36	36			9.00						2	15.0'	16.0'							INSTALL THIS ASSEMBLY 340 FT± NORTH OF THE LEGAL LOAD LIMIT SIGN AT MP 2.258	X				
		F	W16-8P	24	8			1.33															INSTALL THE PLAQUE ON THE RIGHT-SIDE POST UNDER THE CURVE LEFT SIGN		8			
SB	2.258	G	R2-1	24	30		SPEED LIMIT 25 (CONT. ON NEXT PAGE)			1		1		X									GULF RD (TH-62)					
SIGN SUMMARY SHEET							SHEET TOTALS	34.83 43.83	0.00	0	1	0	6	0	0	8	94.0 120.0	0	0.0	0.0	0.0	0.0	PROJECT NAME: HARTLAND-BETHEL PROJECT NUMBER: STPG SIGN (40)					
VERMONT AGENCY OF TRANSPORTATION							TOWN DIRECTIONAL TOTALS	441.5	0.0	2	3	3	78	0	0	87	1305.0	0	0.0	0.0	0.0	0.0	FILENAME: BARNARD VT ROUTE 12 SB PROJECT MANAGER: AMY GAMBLE DESIGNED BY: M. MILLER BARNARD VT-12 SOUTHBOUND 10	PLOT DATE: 8/1/2012 DRAWN BY: M. MILLER CHECKED: AMY GAMBLE SHEET 66 OF 85				

DIRECTION	MILEPOINT	LOCATION CODE (SHEET 2)	SIGN CODE	WIDTH (IN)	HEIGHT (IN)	SHEETING REMARKS	SIGN LEGEND	NEW SIGNS		EXISTING SIGNS				EXIST POST		NUMBER OF NEW POSTS	SQUARE STEEL (IN)			TUBULAR STEEL Ø (IN)				SIGN FRAME REQUIRED	REMARKS	SIGN DETAIL LOCATION			
								"A"	"B"	RETAIN	SALVAGE FROM	SALVAGE TO	REMOVE	RETAIN	REMOVE		1.75	2.00	2.50	FOUNDATION	3.00	3.50	4.00			5.00	SHSM	PROJECT SHEET #	STANDARD SHEET #
SB BARNARD VT 12							FY-FLUORESCENT YELLOW FYG-FLUORESCENT YELLOW GREEN															"SHSM"-STANDARD HIGHWAY SIGNS AND MARKINGS							
SB	2.258	G	VR-017	24	30		LEGAL LOAD LIMIT 24,000 POUNDS (CONT.)																						
		G	VR-017	24	30			0.00 5.00							1	16.0' X						SIGN WAS INSTALLED PRIOR TO THE PROJECT. IT WAS IN GOOD CONDITION.		6					
		G	R2-1	24	30		SPEED LIMIT 25					1										SALVAGE THE SPEED LIMIT SIGN TO BELOW THE NEW LEGAL LOAD LIMIT SIGN							
SB	2.258	F	D3-1	24	6		GULF RD TH62																						
		F	D3-1	48	12			4.00							2	11.0'/11.0' X						SEE ABOVE FOR LEGAL LOAD LIMIT SIGN.		11					
SB	2.248	H	R1-1	30	30			0.00 6.25							1	14.0' X								X					
		H	R1-1	30	30																								
SB	2.212	F	M3-3	24	12		SOUTH																						
		F	M1-5	24	24		VT ROUTE 12																						
		F	M3-3	24	12			2.00							1	14.0' X							X						
		F	M1-5	24	24			4.00																	E-136B				
SB	1.865	F	VW-054L	30	30			6.25							1	14.0' X								7					
		F	VW-054L	30	30		HIDDEN DRIVE LEFT																						
SB	1.803	F	D3-1	30	6		HIDDEN DRIVE LEFT																						
		F	D3-1	54	12			4.50							2	14.0'/14.0' X						OLD STREET SIGN AND POST WERE MISSING.		13					
SIGN SUMMARY SHEET							SHEET TOTALS	20.75 32.00	0.00	0	1	2	6	0	0	8	108.0 139.0	0	0.0	0.0	0.0	0.0	PROJECT NAME: HARTLAND-BETHEL PROJECT NUMBER: STPG SIGN (40)						
VERMONT AGENCY OF TRANSPORTATION							TOWN DIRECTIONAL TOTALS	441.5	0.0	2	3	3	78	0	0	87	1305.0	0	0.0	0.0	0.0	FILE NAME: BARNARD VT ROUTE 12 SB PROJECT MANAGER: AMY GAMBLE DESIGNED BY: M. MILLER BARNARD VT-12 SOUTHBOUND 11	PLOT DATE: 8/1/2012 DRAWN BY: M. MILLER CHECKED: AMY GAMBLE SHEET 67 OF 86						


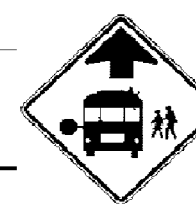


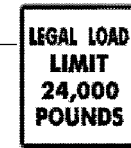
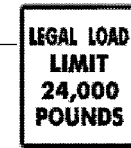
DIRECTION	MILEPOINT	LOCATION CODE (SHEET 2)	SIGN CODE	WIDTH (IN)	HEIGHT (IN)	SHEETING REMARKS	SIGN LEGEND	NEW SIGNS		EXISTING SIGNS				EXIST POST		NUMBER OF NEW POSTS	SQUARE STEEL (IN)			TUBULAR STEEL Ø (IN)				SIGN FRAME REQUIRED	REMARKS	SIGN DETAIL LOCATION			
								"A"	"B"	RETAIN	SALVAGE FROM	SALVAGE TO	REMOVE	RETAIN	REMOVE		1.75	2.00	2.50	FOUNDATION	3.00	3.50	4.00			5.00	SHSM	PROJECT SHEET #	STANDARD SHEET #
SB BARNARD VT 12							FY-FLUORESCENT YELLOW FYG-FLUORESCENT YELLOW GREEN																"SHSM"-STANDARD HIGHWAY SIGNS AND MARKINGS						
SB	0.848	G	VR-017	24	30		  																						
		G	VR-017	24	30			5.00		1	1	2					1	16.0'	X							6			
SB	0.842	H	R1-1	30	30																								
		H	R1-1	30	30			6.25									1	15.0'	X						X				
SB	0.685	F	W7-1	30	30			6.25									1	15.0'	X						X				
SB	0.667	F	W2-2L	30	30		SIDE ROAD LEFT																						
		F	S3-1	30	30		SCHOOL BUS STOP AHEAD																						
SB	0.643	F	W2-2L	30	30			6.25										1	15.0'	X						X			
		F	W16-8P	36	8			2.00																		8			
SB	0.096	F	W1-5R	30	30																								
SB	0.058	F	W1-5R	30	30			6.25										1	15.0'	X						X			
SIGN SUMMARY SHEET							SHEET TOTALS	32.00	0.00	0	1	1	7	0	0	5	76.0	0	0.0	0.0	0.0	0.0				PROJECT NAME: HARTLAND-BETHEL PROJECT NUMBER: STPG SIGN (40)			
VERMONT AGENCY OF TRANSPORTATION							TOWN DIRECTIONAL TOTALS	441.5	0.0	2	3	3	78	0	0	87	1305.0	0		0.0						FILE NAME: BARNARD VT ROUTE 12 SB PROJECT MANAGER: AMY GAMBLE DESIGNED BY: M. MILLER BARNARD VT-12 SOUTHBOUND 12			
																									PLOT DATE: 8/1/2012 DRAWN BY: M. MILLER CHECKED: AMY GAMBLE SHEET 68 OF 86				


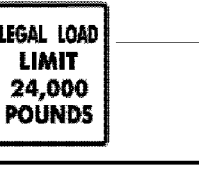





DIRECTION	MILEPOINT	LOCATION CODE (SHEET 2)	SIGN CODE	WIDTH (IN)	HEIGHT (IN)	SHEETING REMARKS	SIGN LEGEND	NEW SIGNS		EXISTING SIGNS			EXIST POST		NUMBER OF NEW POSTS	SQUARE STEEL (IN)			TUBULAR STEEL Ø (IN)				SIGN FRAME REQUIRED	REMARKS	SIGN DETAIL LOCATION					
								"A"	"B"	RETAIN	SALVAGE FROM	SALVAGE TO	REMOVE	RETAIN		REMOVE	1.75	2.00	2.50	FOUNDATION	3.00	3.50			4.00	5.00	SHSM	PROJECT SHEET #	STANDARD SHEET #	
																	(LB / FT)				(LB / FT)									
NB BETHEL VT 12							FY-FLUORESCENT YELLOW FYG-FLUORESCENT YELLOW GREEN																"SHSM"-STANDARD HIGHWAY SIGNS AND MARKINGS							
NB	0.000	C	VD-024	72	10			5.00						2	14.0'	14.0'	X									10				
		C	VD-700	6	10			0.42																			E-138			
		C	VD-700	6	10			0.42																			E-138			
NB	0.389	A	W7-1	30	30			6.25						1	14.0'		X							X						
NB	0.946	A	W5-2	30	30		NARROW BRIDGE			+																				
NB	1.196	A	M2-1	21	15		JCT			1																				
		A	M1-5	30	24		VT ROUTE 107			1																				
NB	1.233	A	W3-1	36	36		STOP AHEAD			1																				
NB	1.263	A	M3-1	24	12		NORTH			1																				
		A	M1-5	24	24		VT ROUTE 12			1																				
		A	M5-1R	21	15		RIGHT ARROW (90 DEG)			1																				
NB	1.287	A	VD1-1A	72	12		<--- RUTLAND 30			1																				
		A	VD1-1A	72	12		BETHEL 2 --->			1																				
		A	VD1-1A	72	12		RANDOLPH 10 --->			1																				
NB	1.337	A	M3-4	24	12		WEST (CONT. ON NEXT PAGE)			1																				
SIGN SUMMARY SHEET								SHEET TOTALS		12.09	0.00	10	0	0	0	0	0	0	0	0	0	0	0	0	0	0	0	0	0	
VERMONT AGENCY OF TRANSPORTATION								SF	SF	EA	EA	EA	EA	EA	EA	EA	EA	EA	EA	EA	EA	EA	EA	EA	EA	EA	EA	EA	EA	
TOWN DIRECTIONAL TOTALS								210.3	0.0	27	1	1	38	0	0	45	675.0	0	0.0	0.0	0.0	0.0	0.0	0.0	0.0	0.0	0.0	0.0	0.0	0.0
												PROJECT NAME: HARTLAND-BETHEL				PROJECT NUMBER: STPG SIGN (40)				FILE NAME: BETHEL VT ROUTE 12 NB				PLOT DATE: 8/1/2012						
												DESIGNED BY: M. MILLER				PROJECT MANAGER: AMY GAMBLE				DRAWN BY: M. MILLER				CHECKED: AMY GAMBLE						
												BETHEL VT-12 NORTHBOUND 1								SHEET 69 OF 86										




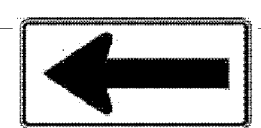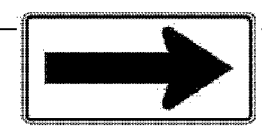








DIRECTION	MILEPOINT	LOCATION CODE (SHEET ?)	SIGN CODE	WIDTH (IN)	HEIGHT (IN)	SHEETING REMARKS	SIGN LEGEND	NEW SIGNS		EXISTING SIGNS				EXIST POST		NUMBER OF NEW POSTS	SQUARE STEEL (IN)			TUBULAR STEEL Ø (IN)				SIGN FRAME REQUIRED	REMARKS	SIGN DETAIL LOCATION		
								"A"	"B"	RETAIN	SALVAGE FROM	SALVAGE TO	REMOVE	RETAIN	REMOVE		1.75	2.00	2.50	FOUNDATION						SHSM	PROJECT SHEET #	STANDARD SHEET #
																	(LB / FT)			3.00	3.50	4.00	5.00					
NB BETHEL VT 12							FY-FLUORESCENT YELLOW FYG-FLUORESCENT YELLOW GREEN																"SHSM"-STANDARD HIGHWAY SIGNS AND MARKINGS					
NB	1.337	A	M1-5	30	24		VT ROUTE 107 (CONT.)			1																		
		A	M6-1L	21	15		LEFT ARROW			1																		
		A	M3-2	24	12		EAST			1																		
		A	M1-5	30	24		VT ROUTE 107			1																		
		A	M6-1R	21	15		RIGHT ARROW			1																		
		A	M3-1	24	12		NORTH			1																		
		A	M1-5	24	24		VT ROUTE 12			1																		
		A	M6-1R	21	15		RIGHT ARROW			1																		
NB	1.379	A	R1-1	36	36		STOP			1																	NOTE: PROJECT SUSPENDS HERE AT JCT WITH VT 107	
NB	2.345	A	VR-039	24	18		STATE HIGHWAY BEGINS			1																	PROJECT RESUMES HERE AT NORTH END OF BETHEL VILLAGE (ADJACENT TO WHITCOMB H.S.)	
		A	R2-1	24	30		SPEED LIMIT 35			1																		
NB	2.600	A	R2-1	24	30		SPEED LIMIT 50			1																		
NB	2.784	A	W1-2R	30	30		RIGHT CURVE			1																		
NB	3.061	A	VW-054R	30	30		HIDDEN DRIVE RIGHT	6.25		+								18.0	X	18.0							THESE SIGNS WERE DAMAGED IN A MOTOR VEHICLE ACCIDENT IN THE EARLY SPRING OF 2013.	
		A	W1-5R	30	30		RIGHT WINDING CURVES (MODIFIED) (CONT. ON NEXT PAGE)	6.25		+																	THE POSTS AND THE SIGNS WERE REPLACED.	
SIGN SUMMARY SHEET							SHEET TOTALS	12.50 -0.00	0.00	14 -15	0	0	2 -6	0	0	0		36.0 -0.0	0	0.0	0.0	0.0	0.0					PROJECT NAME: HARTLAND-BETHEL PROJECT NUMBER: STPG SIGN (40)
VERMONT AGENCY OF TRANSPORTATION							TOWN DIRECTIONAL TOTALS	210.3	0.0	27	1	1	38	0	0	45		675.0	0		0.0							FILE NAME: BETHEL VT ROUTE 12 NB PROJECT MANAGER: AMY GAMBLE DESIGNED BY: M. MILLER BETHEL VT-12 NORTHBOUND 2
																											PLOT DATE: 8/1/2012 DRAWN BY: M. MILLER CHECKED: AMY GAMBLE SHEET 70 OF 86	


DIRECTION	MILEPOINT	LOCATION CODE (SHEET 2)	SIGN CODE	WIDTH (IN)	HEIGHT (IN)	SHEETING REMARKS	SIGN LEGEND	NEW SIGNS		EXISTING SIGNS				EXIST POST		NUMBER OF NEW POSTS	SQUARE STEEL (IN)			TUBULAR STEEL Ø (IN)				SIGN FRAME REQUIRED	REMARKS	SIGN DETAIL LOCATION			
								"A"	"B"	RETAIN	SALVAGE FROM	SALVAGE TO	REMOVE	RETAIN	REMOVE		1.75 (LB / FT)	2.00	2.50	FOUNDATION	(LB / FT)					SHSM	PROJECT SHEET #	STANDARD SHEET #	
																					3.00	3.50	4.00						5.00
NB BETHEL VT 12							FY-FLUORESCENT YELLOW FYG-FLUORESCENT YELLOW GREEN																"SHSM"-STANDARD HIGHWAY SIGNS AND MARKINGS						
NB	3.061	A	W13-1P	18	18		35-MPH (PLAQUE) (CONT.)																						
		A	W13-1P	18	18		 40 MPH	2.25																	X				
NB	3.213	A	S3-1	36	36		 SCHOOL BUS STOP AHEAD (TEXT)																						
		A	S3-1	36	36	FYG	 SCHOOL BUS STOP AHEAD (TEXT)	9.00																	X				
NB	3.532	A	D3-1	30	5		STAFFORD MEADOWS LN																						
		A	D3-1	66	12		 Stafford Meadows Ln	5.50																		13			
NB	3.533	C	VR-017	24	30		 LEGAL LOAD LIMIT 24,000 POUNDS																						
		C	VR-017	24	30		 LEGAL LOAD LIMIT 24,000 POUNDS	5.00																		6			
NB	3.542	D	R1-1	30	30		 STOP																						
		D	R1-1	30	30		 STOP	6.25																	X				
NB	3.728	A	W1-2L	30	30		LEFT CURVE																						
		A	W13-1P	18	18		35-MPH (PLAQUE)																						
NB	3.778	A	W5-2	36	36		 NARROW BRIDGE	9.00																	X				
NB	3.797	A	W5-2	30	30		 NARROW BRIDGE																						
SB	3.797	E	W5-2	30	30		NARROW BRIDGE																						
SIGN SUMMARY SHEET								SHEET TOTALS		37.00	0.00	0	1	1	10	0	0	8	110.0	0	0.0	0.0	0.0	0.0					
VERMONT AGENCY OF TRANSPORTATION								SF	SF	EA	EA	EA	EA	EA	EA	EA	EA	EA	FT	EA	LB	LB	LB	LB					
TOWN DIRECTIONAL TOTALS								210.3	0.0	27	1	1	38	0	0	45	675.0	0	0.0	0.0	0.0	0.0	0.0						
												PROJECT NAME: HARTLAND-BETHEL PROJECT NUMBER: STPG SIGN (40)										FILE NAME: BETHEL VT ROUTE 12 NB PROJECT MANAGER: AMY GAMBLE DESIGNED BY: M. MILLER BETHEL VT-12 NORTHBOUND 3				PLOT DATE: 8/1/2012 DRAWN BY: M. MILLER CHECKED: AMY GAMBLE SHEET 71 OF 85			

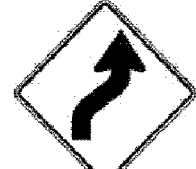DIRECTION	MILEPOINT	LOCATION CODE (SHEET 2)	SIGN CODE	WIDTH (IN)	HEIGHT (IN)	SHEETING REMARKS	SIGN LEGEND	NEW SIGNS		EXISTING SIGNS			EXIST POST		NUMBER OF NEW POSTS	SQUARE STEEL (IN)			TUBULAR STEEL Ø (IN)				SIGN FRAME REQUIRED	REMARKS	SIGN DETAIL LOCATION			
								"A"	"B"	RETAIN	SALVAGE FROM	SALVAGE TO	REMOVE	RETAIN		REMOVE	1.75	2.00	2.50	3.00	3.50	4.00			5.00	SHSM	PROJECT SHEET #	STANDARD SHEET #
																	(LB / FT)			(LB / FT)								
NB BETHEL VT 12							FY-FLUORESCENT YELLOW FYG-FLUORESCENT YELLOW GREEN															"SHSM"-STANDARD HIGHWAY SIGNS AND MARKINGS						
NB	3.837	A	W1-2L	30	30			6.25						1	15.0'								INSTALL 210 FT± NORTH OF THE SIGNS REMOVED AT MP 3.797	X				
		A	W13-1P	24	24			4.00															INSTALL THE PLAQUE UNDER THE CURVE LEFT SIGN	X				
NB	3.883	A	OM3-R	12	36							1																
		A	OM3-R	12	36			3.00		I	I	I		1	11.0'								INSTALL AT 4 FT VERTICAL CLEARANCE	X				
NB	3.893	B	OM3-L	12	36							1											THIS SIGN FACES SB TRAFFIC					
		B	OM3-L	12	36			3.00						1	11.0'								INSTALL AT 4 FT VERTICAL CLEARANCE	X				
NB	3.955	A	VD1-1A	72	12			6.00						2	11.0' / 12.0'								INSTALL 15 FT± SOUTH OF THE NARROW BRIDGE SIGN BEING REMOVED AT MP 3.958		9			
NB	3.958	B	W5-2	30	30		NARROW BRIDGE					1											THIS SIGN FACES SB TRAFFIC					
NB	3.971	A	D3-1	24	5							1											FINDLEY BRIDGE RD (TH-24)					
		A	D3-1	66	12			5.50						2	14.0' / 14.0'								DUE TO SIGN WIDTH, INSTALL INDEPENDENTLY ON THE LEGAL LOAD LIMIT SIGN SIDE OF THE INTERSECTION		13			
NB	3.972	C	VR-017	24	30		LEGAL LOAD LIMIT 24,000 POUNDS			0	I	I	I										COMBINED WITH (INSTALLED ON) STREET SIGN POST ABOVE.					
NB	3.987	D	R1-1	30	30							1											FINDLEY BRIDGE RD (TH-24)					
		D	R1-1	30	30			0.00 6.25						1	14.0'								THIS SIGN WAS RECENTLY REPLACED, IT WAS RE-INSTALLED ON A NEW POST.	X				
NB	4.090	A	M3-1	24	12		NORTH					1																
		A	M1-5	24	24		VT ROUTE 12 (CONT. ON NEXT PAGE)					1																
SIGN SUMMARY SHEET							SHEET TOTALS	27.75 34.00	0.00	0	3	3	9	0	0	8	102.0 126.0	0	0.0	0.0	0.0	0.0		PROJECT NAME: HARTLAND-BETHEL PROJECT NUMBER: STPG SIGN (40)				
VERMONT AGENCY OF TRANSPORTATION							TOWN DIRECTIONAL TOTALS	210.3	0.0	27	1	1	38	0	0	45	675.0	0	0.0	0.0	0.0	0.0		FILE NAME: BETHEL VT ROUTE 12 NB PROJECT MANAGER: AMY GAMBLE DESIGNED BY: M. MILLER BETHEL VT-12 NORTHBOUND 4				
																							PLOT DATE: 8/1/2012 DRAWN BY: M. MILLER CHECKED: AMY GAMBLE SHEET 72 OF 86					



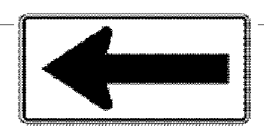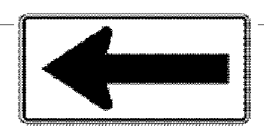

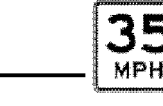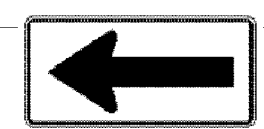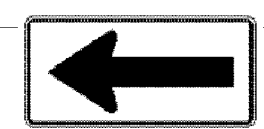
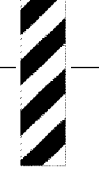


DIRECTION	MILEPOINT	LOCATION CODE (SHEET 2)	SIGN CODE	WIDTH (IN)	HEIGHT (IN)	SHEETING REMARKS	SIGN LEGEND	NEW SIGNS		EXISTING SIGNS				EXIST POST		NUMBER OF NEW POSTS	SQUARE STEEL (IN)			TUBULAR STEEL Ø (IN)				SIGN FRAME REQUIRED	REMARKS	SIGN DETAIL LOCATION			
								"A"	"B"	RETAIN	SALVAGE FROM	SALVAGE TO	REMOVE	RETAIN	REMOVE		1.75	2.00	2.50	FOUNDATION	3.00	3.50	4.00			5.00	SHSM	PROJECT SHEET #	STANDARD SHEET #
NB BETHEL VT 12							FY-FLUORESCENT YELLOW FYG-FLUORESCENT YELLOW GREEN																"SHSM"-STANDARD HIGHWAY SIGNS AND MARKINGS						
NB	4.090	A	M3-1	24	12		 (CONT.)	2.00							1	15.0'	X								X				
		A	M1-5	24	24			4.00																			E-136B		
NB	4.170	A	R2-1	24	30		SPEED LIMIT 50			1																			
NB	4.179	A	R2-1	24	30		SPEED LIMIT 50				1				1	14.0'	X												
NB	4.458	A	S3-1	30	30		SCHOOL BUS STOP AHEAD (TEXT)																						
		A	S3-1	36	36	FYG		9.00							2	13.0' / 14.0'	X								X				
NB	4.836	A	W1-2L	30	30		LEFT CURVE																						
		A	W13-1P	18	18		35-MPH (PLAQUE)																						
NB	4.929	A	W1-2L	30	30			6.25							1	15.0'	X								X				
		A	W13-1P	24	24			4.00																	X				
NB	5.007	A	W1-6L	48	24																								
		A	W1-6L	48	24			8.00							2	13.0' / 14.0'	X								X				
NB	5.042	A	VW-529	30	30		EMERGENCY VEHICLE ENTRANCE RIGHT																						
NB	5.051	B	W1-6R	48	24																								
		B	W1-6R	48	24			8.00							2	13.5' / 15.0'	X								X				
SIGN SUMMARY SHEET							SHEET TOTALS	41.25	0.00	0	1	1	7	0	0	9	126.5	135.0	0	0.0	0.0	0.0	0.0		PROJECT NAME: HARTLAND-BETHEL PROJECT NUMBER: STPG SIGN (40)				
VERMONT AGENCY OF TRANSPORTATION							TOWN DIRECTIONAL TOTALS	210.3	0.0	27	1	1	38	0	0	45	675.0	0	0.0	0.0	0.0	0.0		FILE NAME: BETHEL VT ROUTE 12 NB PROJECT MANAGER: AMY GAMBLE DESIGNED BY: M. MILLER BETHEL VT-12 NORTHBOUND 5	PLOT DATE: 8/1/2012 DRAWN BY: M. MILLER CHECKED BY: AMY GAMBLE SHEET 73 OF 86				



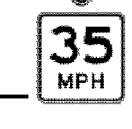




DIRECTION	MILEPOINT	LOCATION CODE (SHEET 2)	SIGN CODE	WIDTH (IN)	HEIGHT (IN)	SHEETING REMARKS	SIGN LEGEND	NEW SIGNS		EXISTING SIGNS				EXIST POST		NUMBER OF NEW POSTS	SQUARE STEEL (IN)			TUBULAR STEEL Ø (IN)				SIGN FRAME REQUIRED	REMARKS	SIGN DETAIL LOCATION					
								"A"	"B"	RETAIN	SALVAGE FROM	SALVAGE TO	REMOVE	RETAIN	REMOVE		1.75	2.00	2.50	FOUNDATION	3.00	3.50	4.00			5.00	SHSM	PROJECT SHEET #	STANDARD SHEET #		
																														(LB / FT)	
NB BETHEL VT 12							FY-FLUORESCENT YELLOW FYG-FLUORESCENT YELLOW GREEN															"SHSM"-STANDARD HIGHWAY SIGNS AND MARKINGS									
NB	5.255	A	VW-005	36	36								1	X																	
		A	W8-13	30	30			6.25							1		14.0'	X								X					
NB	5.337	A	D3-1	36	5																										
NB	5.341	C	VR-017	24	30																										
		C	VR-017	24	30			5.00							1		14.0'	X											6		
NB	5.347	D	R1-1	30	30																										
		D	R1-1	30	30			6.25		I	I	I			1		13.0'	X										X			
NB	5.348	A	D3-1	66	12																										
								5.50							2		13.0'/14.0'	X											13		
NB	5.370	A	VW-054R	30	30																										
NB	5.378	A	OM3-R	12	36																										
		A	OM3-R	12	36			3.00		I	I	I			1		11.0'	X										X			
NB	5.445	B	OM3-L	12	36																										
		B	OM3-L	12	36			3.00							1		11.0'	X									X				
NB	5.453	A	VW-054R	30	30																										
								6.25							1		15.0'	X											7		
NB	5.563	A	VW-054R	30	30																										
SIGN SUMMARY SHEET							SHEET TOTALS	35.25	0.00	0	2	2	10	0	0	8		105.0		0	0.0	0.0	0.0	0.0							
VERMONT AGENCY OF TRANSPORTATION							TOWN DIRECTIONAL TOTALS	210.3	0.0	27	1	1	38	0	0	45		675.0		0		0.0									
PROJECT NAME: HARTLAND-BETHEL															PROJECT NUMBER: STPG SIGN (40)			FILE NAME: BETHEL VT ROUTE 12 NB			PLOT DATE: 8/1/2012										
DESIGNED BY: M. MILLER															CHECKED: AMY GAMBLE			DRAWN BY: M. MILLER			SHEET 74 OF 85										





DIRECTION	MILEPOINT	LOCATION CODE (SHEET 2)	SIGN CODE	WIDTH (IN)	HEIGHT (IN)	SHEETING REMARKS	SIGN LEGEND	NEW SIGNS		EXISTING SIGNS				EXIST POST		NUMBER OF NEW POSTS	SQUARE STEEL (IN)			TUBULAR STEEL Ø (IN)				SIGN FRAME REQUIRED	REMARKS	SIGN DETAIL LOCATION								
								"A"	"B"	RETAIN	SALVAGE FROM	SALVAGE TO	REMOVE	RETAIN	REMOVE		1.75	2.00	2.50	FOUNDATION	3.00	3.50	4.00			5.00	SHSM	PROJECT SHEET #	STANDARD SHEET #					
																														(LB / FT)			(LB / FT)	
NB BETHEL VT 12							FY-FLUORESCENT YELLOW FYG-FLUORESCENT YELLOW GREEN															"SHSM"-STANDARD HIGHWAY SIGNS AND MARKINGS												
NB	5.563	A	W16-2	24	18		 500 FEET (PLAQUE) (CONT.)								1																			
		A	W1-4R	30	30		 6.25								1	15.0'									X									
		A	W13-1P	24	24		 4.00																		X									
NB	5.597	A	W1-4R	30	30		RIGHT REVERSE CURVE																											
		A	W13-1P	18	18		 35-MPH (PLAQUE)																											
		A	VW-054R	30	30		 6.25								1	15.0'											7							
NB	5.726	A	W1-6L	48	24																													
		A	W1-6L	48	24		 8.00								2	15.0'/15.0'									X									
NB	6.175	A	W1-5R	30	30		RIGHT WINDING ROAD SYMBOL																											
		A	W13-1P	18	18		 35-MPH (PLAQUE)																											
NB	6.232	A	W1-4R	30	30		 6.25																											
		A	W13-1P	24	24		 4.00																			X								
NB	6.439	A	W1-6L	48	24																													
		A	W1-6L	48	24		 8.00								2	16.0'/17.0'									X									
NB	6.441	B	W1-6R	48	24		LARGE ARROW RIGHT (CONT. ON NEXT PAGE)																											
SIGN SUMMARY SHEET							SHEET TOTALS										42.75	0.00	0	1	1	9	0	0	7	108.0	0	0.0	0.0	0.0	0.0	PROJECT NAME: HARTLAND-BETHEL PROJECT NUMBER: STPG SIGN (40)	FILE NAME: BETHEL VT ROUTE 12 NB PROJECT MANAGER: AMY GAMBLE DESIGNED BY: M. MILLER BETHEL VT-12 NORTHBOUND 7	PLOT DATE: 8/1/2012 DRAWN BY: M. MILLER CHECKED: AMY GAMBLE SHEET 76 OF 85
VERMONT AGENCY OF TRANSPORTATION							TOWN DIRECTIONAL TOTALS										210.3	0.0	27	1	1	38	0	0	45	675.0	0		0.0					

DIRECTION	MILEPOINT	LOCATION CODE (SHEET 2)	SIGN CODE	WIDTH (IN)	HEIGHT (IN)	SHEETING REMARKS	SIGN LEGEND	NEW SIGNS		EXISTING SIGNS			EXIST POST		NUMBER OF NEW POSTS	SQUARE STEEL (IN)			TUBULAR STEEL Ø (IN)				SIGN FRAME REQUIRED	REMARKS	SIGN DETAIL LOCATION			
								"A"	"B"	RETAIN	SALVAGE FROM	SALVAGE TO	REMOVE	RETAIN		REMOVE	1.75	2.00	2.50	3.00	3.50	4.00			5.00	SHSM	PROJECT SHEET #	STANDARD SHEET #
																	(LB / FT)			(LB / FT)								
NB BETHEL VT 12							FY-FLUORESCENT YELLOW FYG-FLUORESCENT YELLOW GREEN															"SHSM"-STANDARD HIGHWAY SIGNS AND MARKINGS						
NB	6.441	B	W1-6R	48	24		 (CONT.)	8.00						2	15.0' / 16.0' X									X				
SIGN SUMMARY SHEET							SHEET TOTALS	8.00	0.00	0	0	0	0	0	0	2	31.0 30.0	0	0.0	0.0	0.0	0.0						
VERMONT AGENCY OF TRANSPORTATION							TOWN DIRECTIONAL TOTALS	210.3	0.0	27	1	1	38	0	0	45	675.0	0		0.0								
															PROJECT NAME: HARTLAND-BETHEL													
															PROJECT NUMBER: STPG SIGN (40)													
															FILE NAME: BETHEL VT ROUTE 12 NB						PLOT DATE: 8/1/2012							
															PROJECT MANAGER: AMY GAMBLE						DRAWN BY: M. MILLER							
															DESIGNED BY: M. MILLER						CHECKED: AMY GAMBLE							
															BETHEL VT-12 NORTHBOUND 8						SHEET 76	OF 88						



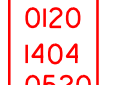

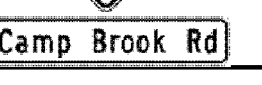DIRECTION	MILEPOINT	LOCATION CODE (SHEET 2)	SIGN CODE	WIDTH (IN)	HEIGHT (IN)	SHEETING REMARKS	SIGN LEGEND	NEW SIGNS		EXISTING SIGNS				EXIST POST		NUMBER OF NEW POSTS	SQUARE STEEL (IN)			TUBULAR STEEL Ø (IN)				SIGN FRAME REQUIRED	REMARKS	SIGN DETAIL LOCATION								
								"A"	"B"	RETAIN	SALVAGE FROM	SALVAGE TO	REMOVE	RETAIN	REMOVE		1.75	2.00	2.50	3.00	3.50	4.00	5.00			SHSM	PROJECT SHEET #	STANDARD SHEET #						
																	(LB / FT)			(LB / FT)														
SB BETHEL VT 12							FY-FLUORESCENT YELLOW FYG-FLUORESCENT YELLOW GREEN																"SHSM"-STANDARD HIGHWAY SIGNS AND MARKINGS											
SB	6.544	F	VW-054R	30	30		HIDDEN DRIVE RIGHT																											
		F	W1-5R	30	30		RIGHT WINDING CURVES SYMBOL																											
		F	W13-1P	18	18		35-MPH (PLAQUE)																											
		F	W1-5R	30	30			6.25																	X									
		F	W13-1P	24	24			4.00																X										
SB	6.500	F	VW-054R	30	30			6.25																			INSTALL 230 FT± SOUTH OF THE SIGNS AT MP 6.544		7					
SB	5.930	F	VW-054R	30	30		HIDDEN DRIVE RIGHT			1																								
SB	5.863	F	W1-4L	30	30		LEFT REVERSE CURVE				1																	TO BE SALVAGED 135 FT± SOUTH						
		F	W13-1P	18	18		40-MPH (PLAQUE)					1																						
SB	5.837	F	W1-4L	30	30		LEFT REVERSE CURVE																					SALVAGE TO BEHIND RAIL 135 FT± SOUTH OF THE PREVIOUS POSITION AT MP 5.863						
		F	W13-1P	18	18		40-MPH (PLAQUE)																											
SB	5.790	F	VW-060	30	30		HIDDEN DRIVES				1																	SALVAGE THIS SIGN ON TO A NEW POST						
		F	VW-060	30	30		HIDDEN DRIVES																											
SB	5.655	F	W2-2R	30	30		RIGHT SIDE ROAD																					TO BE SALVAGED 150 FT± SOUTH						
		F	W16-8A	24	18		GILEAD BROOK RD (PLAQUE)																											
SIGN SUMMARY SHEET							SHEET TOTALS										16.50	0.00	1	5	3	8	0	0	4	57.0	0	0.0	0.0	0.0	0.0	PROJECT NAME: HARTLAND-BETHEL PROJECT NUMBER: STPG SIGN (40)	FILE NAME: BETHEL VT ROUTE 12 SB PROJECT MANAGER: AMY GAMBLE DESIGNED BY: M. MILLER BETHEL VT-12 SOUTHBOUND 1	PLOT DATE: 8/1/2012 DRAWN BY: M. MILLER CHECKED: AMY GAMBLE SHEET 77 OF 86
VERMONT AGENCY OF TRANSPORTATION							TOWN DIRECTIONAL TOTALS										237.8	0.0	8	9	9	52	0	0	53	795.0	0	0.0	0.0	0.0	0.0			

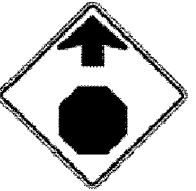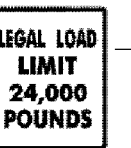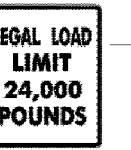




DIRECTION	MILEPOINT	LOCATION CODE (SHEET 2)	SIGN CODE	WIDTH (IN)	HEIGHT (IN)	SHEETING REMARKS	SIGN LEGEND	NEW SIGNS		EXISTING SIGNS				EXIST POST		NUMBER OF NEW POSTS	SQUARE STEEL (IN)			TUBULAR STEEL Ø (IN)				SIGN FRAME REQUIRED	REMARKS	SIGN DETAIL LOCATION			
								"A"	"B"	RETAIN	SALVAGE FROM	SALVAGE TO	REMOVE	RETAIN	REMOVE		1.75 (LB / FT)	2.00	2.50	FOUNDATION	3.00	3.50	4.00			5.00	SHSM	PROJECT SHEET #	STANDARD SHEET #
SB BETHEL VT 12							FY-FLUORESCENT YELLOW FYG-FLUORESCENT YELLOW GREEN															"SHSM"-STANDARD HIGHWAY SIGNS AND MARKINGS							
SB	5.627	F	W2-2R	30	30		RIGHT SIDE ROAD				1							14.0'								SALVAGE TO 150 FT- SOUTH OF THE PREVIOUS POSITION AT MP 5.655			
		F	W16-8A	24	18		GILEAD BROOK RD (PLAQUE)				1																		
SB	5.530	F	D3-1	30	5		GILEAD BROOK RD					1														GILEAD BROOK RD (TH-7)			
		F	D3-1	60	12			5.00										11.0'/11.0'								DUE TO SIGN WIDTH, INSTALL INDEPENDENTLY ON THE LEGAL LOAD LIMIT SIGN SIDE OF TH-7		13	
SB	5.529	G	VR-017	24	30						1															GILEAD BROOK RD (TH-7)			
		G	VR-017	24	30			0.00 5.00										14.0'										6	
SB	5.522	H	R1-1	30	30							1						14.0'								GILEAD BROOK RD (TH-7)			
		H	R1-1	30	30			6.25			1							14.0'									X		
SB	5.515	F	W8-13	30	30			6.25										15.0'								INSTALL BEHIND RAIL ^{100'} 35 FT± SOUTH OF THE STOP SIGN AT MP 5.522		X	
SB	5.445	F	OM3-R	12	36							1																	
		F	OM3-R	12	36			3.00			1							11.0'								INSTALL AT 4 FT VERTICAL CLEARANCE		X	
SB	5.381	E	OM3-L	12	36							1														THIS SIGN FACES NB TRAFFIC			
		E	OM3-L	12	36			3.00										11.0'								INSTALL AT 4 FT VERTICAL CLEARANCE		X	
SB	5.329	F	VW-529	30	30							1														EMERGENCY VEHICLES ENTERING LEFT			
		F	VW-205	36	36			9.00										14.0'/14.0'										6	
SIGN SUMMARY SHEET							SHEET TOTALS	32.50 37.50	0.00	0	3	5	8	0	0	10	129.0 150.0	0	0.0	0.0	0.0	0.0	0.0	PROJECT NAME: HARTLAND-BETHEL PROJECT NUMBER: STPG SIGN (40)					
VERMONT AGENCY OF TRANSPORTATION							TOWN DIRECTIONAL TOTALS	237.8	0.0	8	9	9	52	0	0	53	795.0	0	0.0	0.0	0.0	0.0	0.0	FILE NAME: BETHEL VT ROUTE 12 SB PROJECT MANAGER: AMY GAMBLE DESIGNED BY: M. MILLER BETHEL VT-12 SOUTHBOUND 2	PLOT DATE: 8/1/2012 DRAWN BY: M. MILLER CHECKED BY: AMY GAMBLE SHEET 78 OF 86				

DIRECTION	MILEPOINT	LOCATION CODE (SHEET 2)	SIGN CODE	WIDTH (IN)	HEIGHT (IN)	SHEETING REMARKS	SIGN LEGEND	NEW SIGNS		EXISTING SIGNS			EXIST POST		NUMBER OF NEW POSTS	SQUARE STEEL (IN)			TUBULAR STEEL Ø (IN)					SIGN FRAME REQUIRED	REMARKS	SIGN DETAIL LOCATION				
								"A"	"B"	RETAIN	SALVAGE FROM	SALVAGE TO	REMOVE	RETAIN		REMOVE	1.75	2.00	2.50	3.00	3.50	4.00	5.00			SHSM	PROJECT SHEET #	STANDARD SHEET #		
																	(LB / FT)			(LB / FT)										
SB BETHEL VT 12							FY-FLUORESCENT YELLOW FYG-FLUORESCENT YELLOW GREEN																"SHSM"-STANDARD HIGHWAY SIGNS AND MARKINGS							
SB	5.199	F	W1-2R	30	30		CURVE RIGHT																				NOTE LOCATION AS REFERENCE FOR THE NEXT SIGN			
		F	W13-1P	18	18		 35-MPH (PLAQUE)																				DISCARD THE MILE MARKER			
SB	5.111	F	W1-2R	30	30			6.25																			INSTALL BEHIND RAIL 485 FT ± SOUTH OF THE SIGNS REMOVED AT MP 5.199	X		
		F	W13-1P	24	24			4.00																				X		
SB	4.656	F	W1-2L	30	30		CURVE LEFT																							
SB	4.602	F	VD-700	6	8		MILE MARKER 0120 / 1404 / 0460																				SALVAGE THIS MILE MARKER, REMOVE THIS POST			
		F	W1-4L	30	30			6.25																			INSTALL UNDER THE CURVE WARNING SIGN AT 4 FT VERTICAL CLEARANCE	X		
		F	VD-700	6	8		MILE MARKER 0120 / 1404 / 0460																							
SB	4.305	F	W1-4L	30	30		LEFT REVERSE CURVE																				NOTE LOCATION AS REFERENCE FOR THE NEXT SIGN			
		F	W13-1P	18	18		35-MPH (PLAQUE)																							
		F	VD-701	6	8		BRIDGE PLAQUE																				BRIDGE PLAQUE BR#12			
		F	VD-701	6	8		BRIDGE PLAQUE																				SALVAGE THE BRIDGE PLAQUE ONTO A NEW POST, INSTALL AT 4 FT VERTICAL CLEARANCE			
SB	4.220	F	W1-10L	36	36			9.00																			INSTALL 450 FT ± SOUTH OF THE SIGNS AT MP 4.305	X		
		F	W16-8P	42	8			2.33																			SPAN THE PLAQUE ACROSS BOTH POSTS		8	
SB	4.122	F	VD1-1A	72	12			6.00																			INSTALL 515 FT ± SOUTH OF THE SIGNS INSTALLED AT MP 4.220		9	
SIGN SUMMARY SHEET							SHEET TOTALS	33.83	0.00	0	3	3	8	0	0	7	91.0	0	0.0	0.0	0.0	0.0	0.0	0.0	PROJECT NAME: HARTLAND-BETHEL					
								SF	SF	EA	EA	EA	EA	EA	EA	EA	FT	EA	LB	LB	LB	LB	LB		PROJECT NUMBER: STPG SIGN (40)					
VERMONT AGENCY OF TRANSPORTATION							TOWN DIRECTIONAL TOTALS	237.8	0.0	8	9	9	52	0	0	53	795.0	0		0.0					FILE NAME: BETHEL VT ROUTE 12 SB					
																								PROJECT MANAGER: AMY GAMBLE						
																								DESIGNED BY: M. MILLER						
																								BETHEL VT-12 SOUTHBOUND 3						
																								PLOT DATE: 8/11/2012						
																								DRAWN BY: M. MILLER						
																								CHECKED: AMY GAMBLE						
																								SHEET 79 OF 86						

DIRECTION	MILEPOINT	LOCATION CODE (SHEET 2)	SIGN CODE	WIDTH (IN)	HEIGHT (IN)	SHEETING REMARKS	SIGN LEGEND	NEW SIGNS		EXISTING SIGNS			EXIST POST		NUMBER OF NEW POSTS	SQUARE STEEL (IN)			TUBULAR STEEL Ø (IN)				SIGN FRAME REQUIRED	REMARKS	SIGN DETAIL LOCATION			
								"A"	"B"	RETAIN	SALVAGE FROM	SALVAGE TO	REMOVE	RETAIN		REMOVE	1.75	2.00	2.50	FOUNDATION	3.00	3.50			4.00	5.00	SHSM	PROJECT SHEET #
SB BETHEL VT 12							FY-FLUORESCENT YELLOW FYG-FLUORESCENT YELLOW GREEN															"SHSM"-STANDARD HIGHWAY SIGNS AND MARKINGS						
SB	4.060	G	W3-1	36	36		STOP AHEAD SYMBOL																					
		F	D3-1	24	10		CAMP BROOK RD ROCHESTER 10														THIS SIGN WAS FOUND ON THE GROUND AND GIVEN TO THE TOWN ROAD CREW.							
		G	W3-1	36	36			9.00																X				
SB	4.060	H	R1-1	30	30		STOP																					
		F	D3-1	60	12		Camp Brook Rd 0120 1404 0406	5.00																				
		H	R1-1	30	30		STOP	6.25																				
SB	4.049	G	VR-017	24	30																							
		G	VR-017	24	30			5.00																				
SB	4.025	F	D3-1	24	10		CAMP BROOK RD ROCHESTER 10																					
		F	D3-1	60	12		Camp Brook Rd	5.00																				
SB	4.024	G	VR-017	24	30																							
		G	VR-017	24	30			5.00																				
SB	4.013	H	R1-1	30	30																							
		H	R1-1	30	30		STOP 0120 1404 0401	6.25																				
SB	3.998	F	W1-2R	30	30		RIGHT CURVE (CONT. ON NEXT PAGE)																					
SIGN SUMMARY SHEET								SHEET TOTALS		41.50	0.00	0	2	2	9	0	0	9	136.0	0	0.0	0.0	0.0	0.0	PROJECT NAME: HARTLAND-BETHEL PROJECT NUMBER: STPG SIGN (40)			
VERMONT AGENCY OF TRANSPORTATION								SF	SF	EA	EA	EA	EA	EA	EA	EA	EA	EA	EA	EA	EA	EA	EA	EA	EA	EA	EA	EA
TOWN DIRECTIONAL TOTALS								237.8	0.0	8	9	9	52	0	0	53	795.0	0	0.0	0.0	0.0	0.0	FILE NAME: BETHEL VT ROUTE 12 SB PROJECT MANAGER: AMY GAMBLE DESIGNED BY: M. MILLER BETHEL VT-12 SOUTHBOUND 4			PLOT DATE: 8/1/2012 DRAWN BY: M. MILLER CHECKED BY: AMY GAMBLE SHEET 80 OF 86		

DIRECTION	MILEPOINT	LOCATION CODE (SHEET 2)	SIGN CODE	WIDTH (IN)	HEIGHT (IN)	SHEETING REMARKS	SIGN LEGEND	NEW SIGNS		EXISTING SIGNS				EXIST POST		NUMBER OF NEW POSTS	SQUARE STEEL (IN)			TUBULAR STEEL Ø (IN)				SIGN FRAME REQUIRED	REMARKS	SIGN DETAIL LOCATION			
								"A"	"B"	RETAIN	SALVAGE FROM	SALVAGE TO	REMOVE	RETAIN	REMOVE		1.75	2.00	2.50	FOUNDATION	3.00	3.50	4.00			5.00	SHSM	PROJECT SHEET #	STANDARD SHEET #
SB BETHEL VT 12							FY-FLUORESCENT YELLOW FYG-FLUORESCENT YELLOW GREEN																"SHSM"-STANDARD HIGHWAY SIGNS AND MARKINGS						
SB	3.998	F	W13-1P	18	18																								
		F	W1-2R	30	30			6.25						1		15.0'	X									X			
		F	W13-1P	24	24			4.00																		X			
SB	3.960	F	W5-2	30	30		NARROW BRIDGE																						
		F	M3-3	24	12			2.00							1	14.5'	X									X			
		F	M1-5	24	24			4.00																		E-136B			
SB	3.932	F	M3-3	24	12		SOUTH																						
		F	M1-5	24	24		VT ROUTE 12																						
		F	W5-2	36	36			9.00							2	14.0'/14.0'	X									X			
SB	3.896	F	OM3-R	12	36																								
		F	OM3-R	12	36			3.00			I	I	I																
		F					BRIDGE 34 VT 12																						
SB	3.886	E	OM3-L	12	36																								
		E	OM3-L	12	36			3.00							1	11.0'	X									X			
		F	W1-5MR	30	30		MODIFIED RIGHT WINDING CURVES																						
		F	W13-1P	18	18		35-MPH (PLAQUE)																						
SIGN SUMMARY SHEET								SHEET TOTALS		31.25	0.00	0	1	1	8	0	0	6	73.5	0	0.0	0.0	0.0	PROJECT NAME: HARTLAND-BETHEL PROJECT NUMBER: STPG SIGN (40)					
VERMONT AGENCY OF TRANSPORTATION								SF	SF	EA	EA	EA	EA	EA	EA	EA	EA	EA	FT	EA	LB	LB	LB	LB	FILE NAME: BETHEL VT ROUTE 12 SB PROJECT MANAGER: AMY GAMBLE DESIGNED BY: M. MILLER BETHEL VT-12 SOUTHBOUND 5				
TOWN DIRECTIONAL TOTALS								237.8	0.0	8	9	9	52	0	0	53	795.0	0	0.0	0.0	PLOT DATE: 8/1/2012 DRAWN BY: M. MILLER CHECKED: AMY GAMBLE SHEET 81 OF 85								

DIRECTION	MILEPOINT	LOCATION CODE (SHEET 2)	SIGN CODE	WIDTH (IN)	HEIGHT (IN)	SHEETING REMARKS	SIGN LEGEND	NEW SIGNS		EXISTING SIGNS			EXIST POST		NUMBER OF NEW POSTS	SQUARE STEEL (IN)			TUBULAR STEEL Ø (IN)				SIGN FRAME REQUIRED	REMARKS	SIGN DETAIL LOCATION				
								"A"	"B"	RETAIN	SALVAGE FROM	SALVAGE TO	REMOVE	RETAIN		REMOVE	1.75	2.00	2.50	FOUNDATION	3.00	3.50			4.00	5.00	SHSM	PROJECT SHEET #	STANDARD SHEET #
																	(LB / FT)				(LB / FT)								
SB BETHEL VT 12							FY-FLUORESCENT YELLOW FYG-FLUORESCENT YELLOW GREEN															"SHSM"-STANDARD HIGHWAY SIGNS AND MARKINGS							
SB	2.700	F	W3-5	36	36		SPEED REDUCTION 35-MPH		1																				
SB	2.651	F	VD-018	30	18		Bethel Barnard 9																						
		F	VD-018	30	18		3.75						1	13.5'											14				
SB	2.602	F	R2-1	30	36		SPEED LIMIT 35		1																				
SB	2.600	F	S1-1	36	36		SCHOOL (SYMBOL)		1																				
		F	S4-3	24	8		SCHOOL (PLAQUE)		1																				
SB	2.430	F	W3-5	36	36		SPEED REDUCTION 25-MPH		1																				
SB	2.345	F	VR-038	24	18		STATE HIGHWAY ENDS			+	I	I	I	✗	X														
		F	R2-1	24	30		SPEED LIMIT 25						1	15.0'															
		F	R2-1	30	36																				X				
SB	1.324	F	M3-3	24	12		SOUTH					1																	
		F	M1-5	24	24		VT ROUTE 12					1																	
		F	VD2-1	72	12		6.00						2	15.0' / 15.0'											10				
		F	M3-3	24	12		2.00																	X					
		F	M1-5	24	24		4.00																				E-136B		
SIGN SUMMARY SHEET							SHEET TOTALS	23.25	0.00	6	0	1	0	4	3	0	0	3	58.5	46.0	0	0.0	0.0	0.0	0.0	PROJECT NAME: HARTLAND-BETHEL PROJECT NUMBER: STPG SIGN (40)			
VERMONT AGENCY OF TRANSPORTATION							TOWN DIRECTIONAL TOTALS	237.8	0.0	8	9	9	52	0	0	53	795.0	0	0.0	0	0.0	0.0	0.0	0.0	FILE NAME: BETHEL VT ROUTE 12 SB PROJECT MANAGER: AMY GAMBLE DESIGNED BY: M. MILLER BETHEL VT-12 SOUTHBOUND 7				
																											PLOT DATE: 8/1/2012 DRAWN BY: M. MILLER CHECKED: AMY GAMBLE SHEET 83 OF 86		

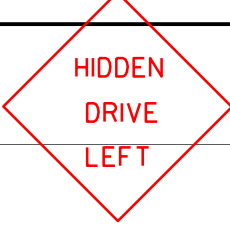DIRECTION	MILEPOINT	LOCATION CODE (SHEET 2)	SIGN CODE	WIDTH (IN)	HEIGHT (IN)	SHEETING REMARKS	SIGN LEGEND	NEW SIGNS		EXISTING SIGNS			EXIST POST		NUMBER OF NEW POSTS	SQUARE STEEL (IN)			TUBULAR STEEL Ø (IN)				SIGN FRAME REQUIRED	REMARKS	SIGN DETAIL LOCATION		
								"A"	"B"	RETAIN	SALVAGE FROM	SALVAGE TO REMOVE	RETAIN	REMOVE		1.75	2.00	2.50	(LB / FT)						SHSM	PROJECT SHEET #	STANDARD SHEET #
																			3.00	3.50	4.00	5.00					
SB BETHEL VT 12							FY-FLUORESCENT YELLOW FYG-FLUORESCENT YELLOW GREEN															"SHSM"-STANDARD HIGHWAY SIGNS AND MARKINGS					
SB	1.263	F	R2-1	24	30																	SIGN AND POST MISSING					
		F	R2-1	24	30			0.00 5.00															X				
SB	1.154	F	W5-2	30	30		NARROW BRIDGE			0 +												SIGN WAS ALREADY REMOVED.	THE ONGOING BRIDGE PROJECT JUST AHEAD WILL REMOVE THIS SIGN AFTER THAT PROJECT IS COMPLETED IN LATE 2012				
SB	0.895	G	VR-017	24	30																	OLD ROUTE 12 (TH-79)					
		G	VR-017	24	30			5.00																6			
SB	0.891	F	D3-1	24	5		OLD ROUTE 12																OLD ROUTE 12 (TH-79)				
		F	D3-1	54	12			4.50														14.0' / 14.0'	DUE TO SIGN WIDTH, INSTALL INDEPENDENTLY ON THE STOP SIGN SIDE OF TH-79		13		
SB	0.891	H	R1-1	30	30																		OLD ROUTE 12 (TH-79)				
		H	R1-1	30	30			6.25																X			
SB	0.000	G	VD-024	60	7.5		BARNARD I BETHEL																REMOVE THIS ASSEMBLY ONLY AFTER THE NEW TOWN LINE SIGN HAS BEEN INSTALLED ADJACENT TO THE NB LANE				
		G	VD-700	6	8		0120 / 1404 / 0000 (BETHEL MM)																				
		G	VD-700	6	8		0120 / 1403 / 0962 (BARNARD MM)																				
SB	1.127	F	VW-054L	30	30																		SIGN WAS RECENTLY INSTALLED.				
SIGN SUMMARY SHEET							SHEET TOTALS	15.75 20.75	0.00	1	0	0	6	0	0	5	42.0 75.0	0	0.0	0.0	0.0	0.0	PROJECT NAME: HARTLAND-BETHEL PROJECT NUMBER: STPG SIGN (40)				
VERMONT AGENCY OF TRANSPORTATION							TOWN DIRECTIONAL TOTALS	237.8	0.0	8	9	9	52	0	0	53	795.0	0	0.0	0.0	0.0	0.0	FILE NAME: BETHEL VT ROUTE 12 SB PROJECT MANAGER: AMY GAMBLE DESIGNED BY: M. MILLER BETHEL VT-12 SOUTHBOUND 8	PLOT DATE: 8/1/2012 DRAWN BY: M. MILLER CHECKED: AMY GAMBLE SHEET 84 OF 86			

TOWN TOTAL SIGN SUMMARY SHEET

Hartland - Bethel STPG SIGN(40)

Town - Route	County	Town Mileage	NEW SIGNS (SF)		EXISTING SIGNS (EA)				EXIST POST (EA)		NUMBER OF NEW POSTS (EA)				SQUARE STEEL (FT)			TUBULAR STEEL Ø (IN)				
			TYPE A	TYPE B	RETAIN	SALVAGE FROM	SALVAGE TO	REMOVE	RETAIN	REMOVE	1.75"	2"	2.5"	TOTAL POSTS	1.75"	2.00"	2.50"	FOUNDATION	3.00	3.50	4.00	5.00
											(LB / FT)				(LB / FT)				(LB / FT)			
											1.88	2.42	3.35		1.88	2.42	3.35		7.60	9.00	10.80	14.60
Hartland VT-12 NB	Windsor	7.705	339.4	0	18	1	1	68	0	0	0	54	4	58	0	810	60					
Hartland VT-12 SB	Windsor	7.705	277.6	0	12	3	3	64	0	0	0	47	2	49	0	705	30					
Woodstock VT-12 NB	Windsor	3.298	126.3	0	12	6	6	32	0	0	0	24	0	24	0	360	0					
Woodstock VT-12 SB	Windsor	3.298	141.5	0	7	1	1	25	0	0	0	26	0	26	0	390	0					
Pomfret VT-12 NB	Windsor	1.383	12.5	0	0	0	0	2	0	0	0	2	0	2	0	30	0					
Pomfret VT-12 SB	Windsor	1.383	32.1	0	1	0	0	8	0	0	0	6	0	6	0	90	0					
Barnard VT-12 NB	Windsor	9.615	322.2	0	6	2	2	59	0	0	0	65	0	65	0	975	0					
Barnard VT-12 SB	Windsor	9.615	441.5	0	2	3	3	78	0	0	0	87	0	87	0	1305	0					
Bethel VT-12 NB	Windsor	6.057	210.3	0	27	1	1	38	0	0	0	45	0	45	0	675	0					
Bethel VT-12 SB	Windsor	6.057	237.8	0	8	9	9	52	0	0	1	52	0	52	15	780	0					
			Sub-Total			26	26	426			Sub-Total				15	6120	90					
Estimated Salvaged Street Name Signs to be erected onto new posts (Sheet 2, General Note 4):								0	0													
Salvaged Mile Marker Signs to be erected onto new posts (Sheet 2, General Notes 2, 3 & 4):								25	32													
TOTAL =			2141.2	0	93	26	51	458	0	0	1	408	6	414	6225			0	0	0	0	0

PROJECT NAME: HARTLAND - BETHEL	
PROJECT NUMBER: STPG SIGN (40)	
FILE NAME: I2CI16.SS	PLOT DATE: 01-AUG-2012
PROJECT LEADER: A. GAMBLE	DRAWN BY: M. MILLER
DESIGNED BY: M. MILLER	CHECKED BY: A. GAMBLE
TOWN TOTAL SIGN SUMMARY SHEET	SHEET 85 OF 85