


STATE OF VERMONT  
AGENCY OF TRANSPORTATION



INDEX OF SHEETS AND STANDARDS  
SEE SHEET 2

PROPOSED IMPROVEMENT  
TOWNS OF READSBORO, SEARSBURG, JAMAICA,  
WELLS, POULTNEY AND POWNAL  
COUNTIES OF BENNINGTON, RUTLAND AND WINDHAM  
VERMONT ROUTES 8, 30, 31 AND 346  
(MAJOR COLLECTORS)

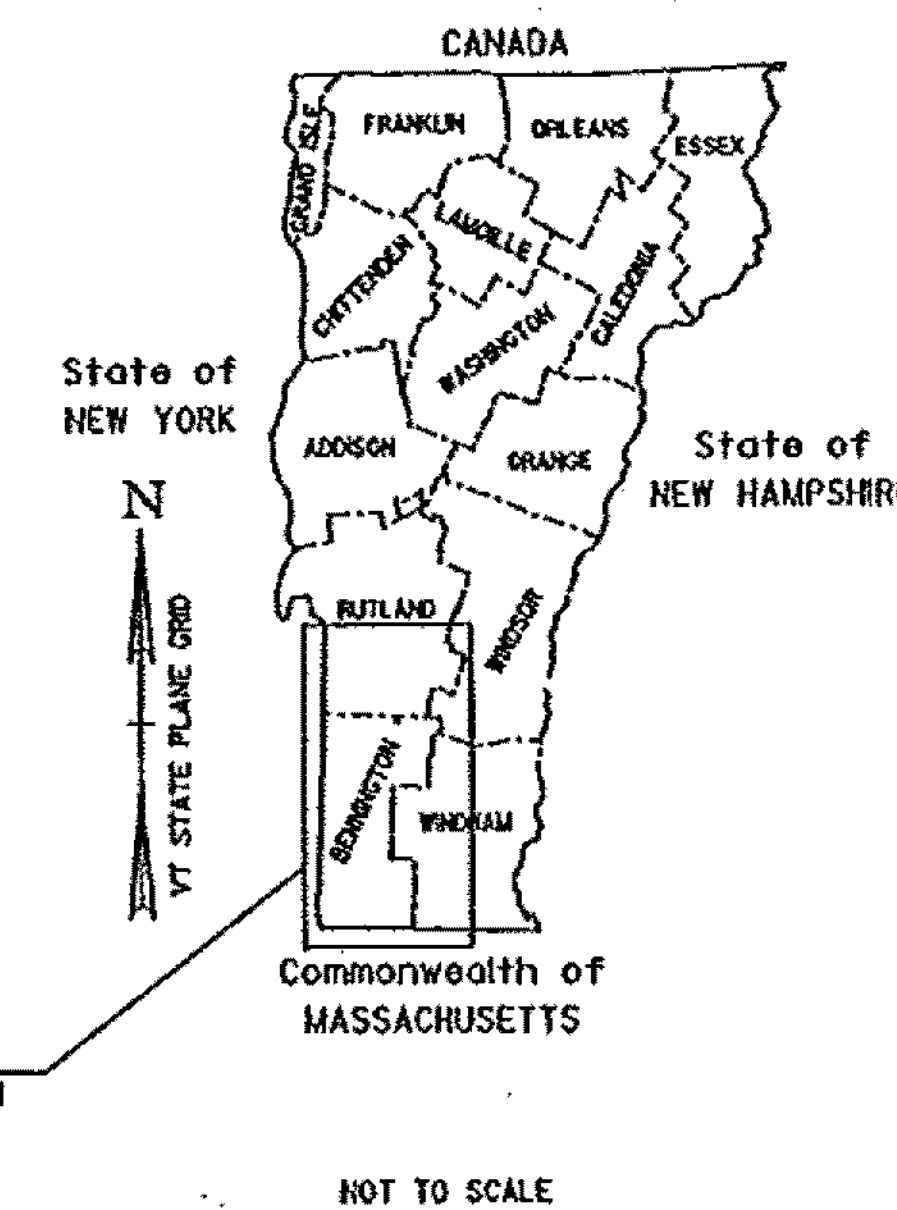

SOUTHWESTERN REGION SIGN REPLACEMENT - 25.492 MILES:  
READSBORO (VT-8) MP 0.000-2.507, SEARSBURG (VT-8) MP 0.000-2.703,  
JAMAICA (VT-30) MP 0.000-10.89, WELLS (VT-30) MP 0.000-1.756,  
POULTNEY (VT-30) MP 0.000-3.779, POWNAL (VT-346) MP 0.000-4.628

LENGTH OF ROADWAY = 25.492  
LENGTH OF PROJECT = 25.492

WORK TO BE PERFORMED INCLUDES THE REMOVAL OF EXISTING SIGNS AND POSTS  
AND THE INSTALLATION OF NEW SIGNS AND POSTS AND OTHER RELATED HIGHWAY ITEMS

RECORD PLANS

CONTRACTOR: AMERICAN FLAGGING & TRAFFIC CONTROL - SALEM, NH

RESIDENT ENGINEER: SARA LUICHINGER

CONSTRUCTION BEGAN: AUGUST 20, 2013

CONSTRUCTION COMPLETE: OCTOBER 3, 2013


RECORD PLANS BY: SARAH LUICHINGER & STEVE KENT

HEREBY CERTIFY THAT ALL THE CONSTRUCTION REQUIRED BY THIS SET  
OF DRAWINGS HAS BEEN ACCOMPLISHED AS INDICATED HEREIN.

BY Sara Luichinger RESIDENT ENGINEER

DATE 8/11/14

NOTE: Any further information concerning final quantities, amounts or other details  
relative to this project may be found at Central Files in the electronic archives.

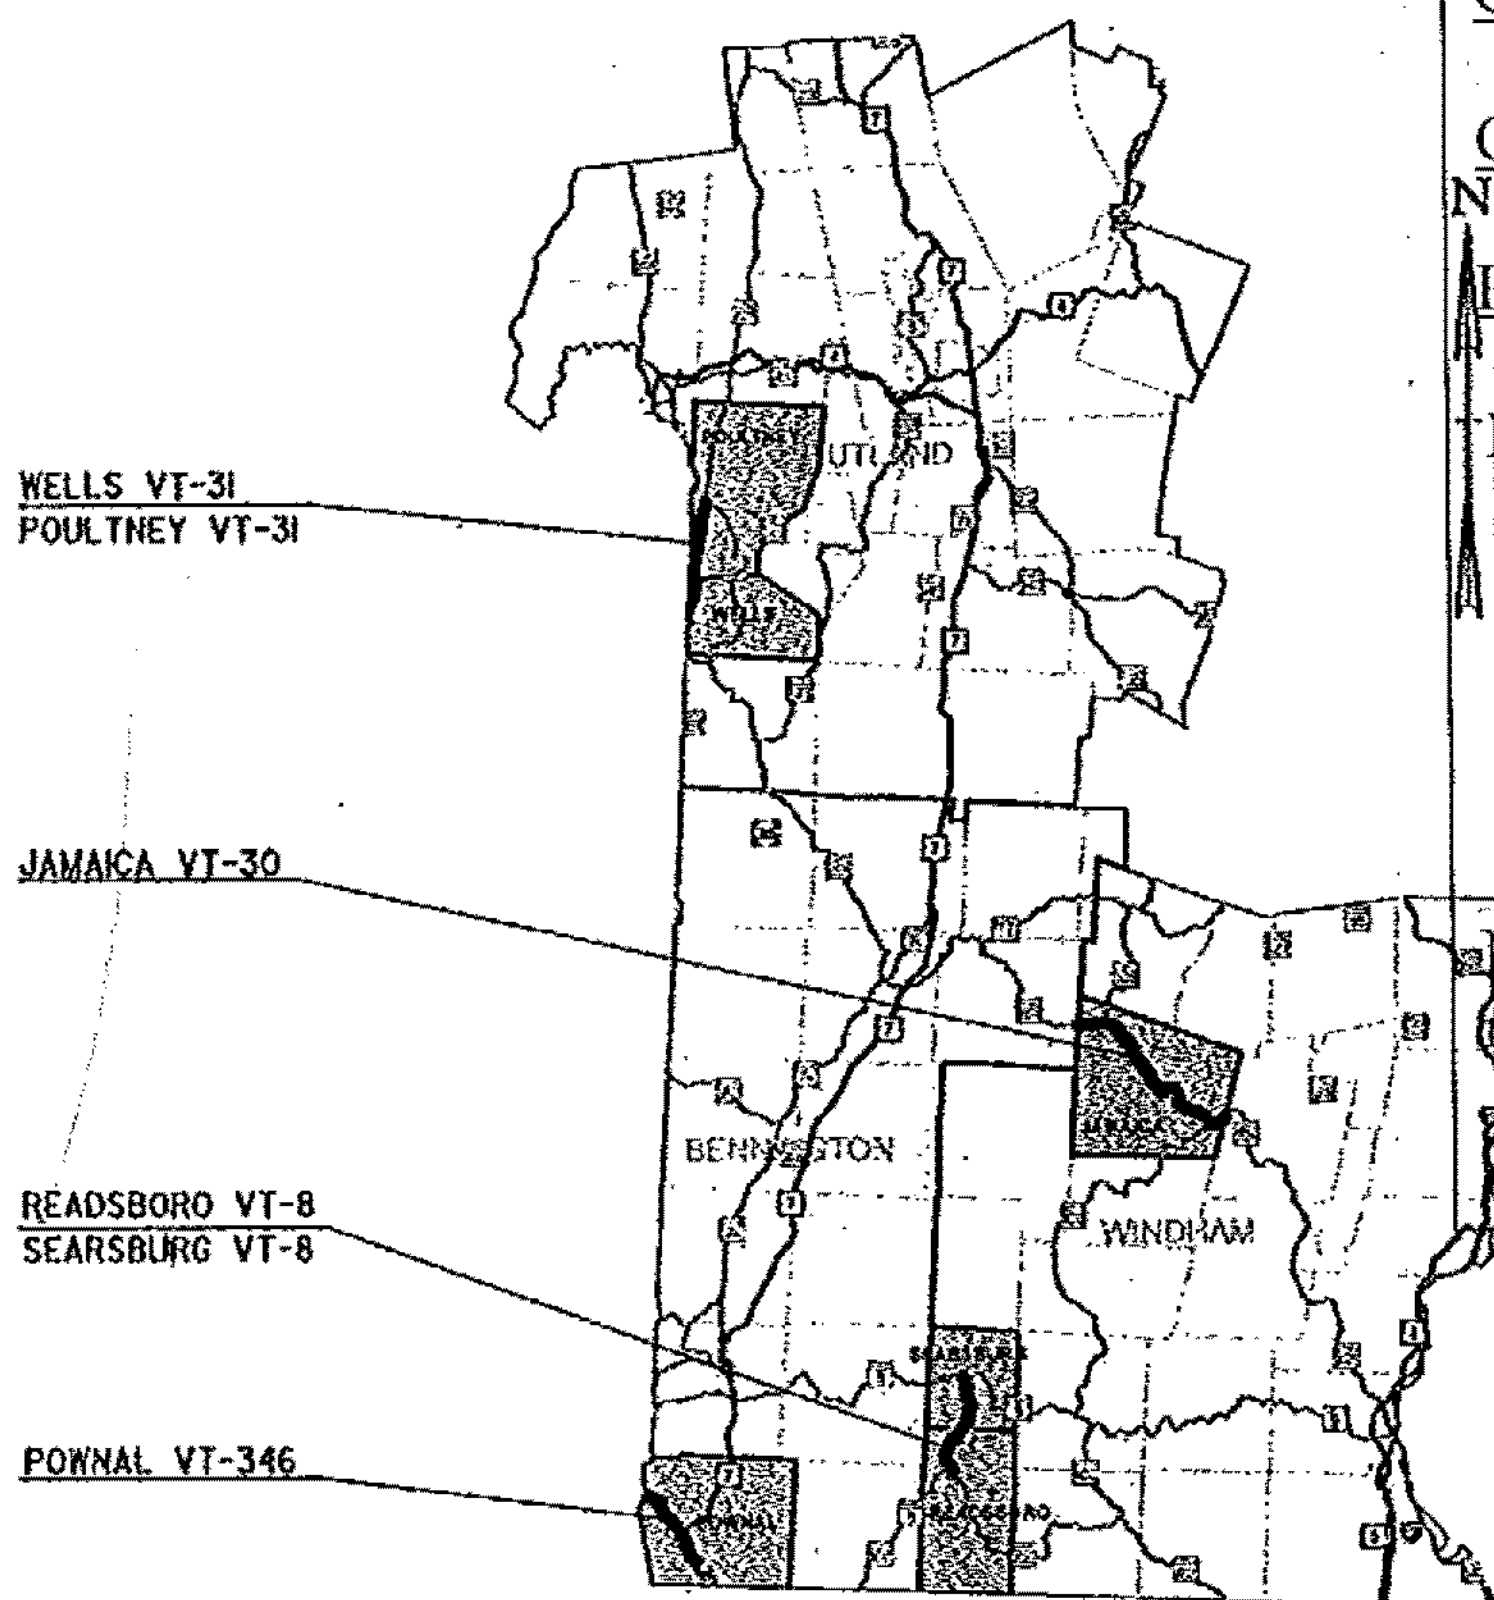

QUALITY ASSURANCE PROGRAM: LEVEL 3

CONVENTIONAL SYMBOLS

COUNTY LINE	
TOWN LINE	
LIMITS OF ACCESS	
POINT OF ACCESS	
FENCE LINE	
STONE WALL	
TRAVELED WAY	
GUARD RAIL	
RAILROAD	
SURVEY LINE	
CULVERT	
POWER POLE	
TELEPHONE POLE	
TREES	
CONTROL OF ACCESS	
PROPERTY LINE	
R.O.W. TAKING LINE	
SLOPE RIGHTS	
TOP OF CUT	
TOE OF SLOPE	

SURVEYED BY : N/A  
SURVEYED DATE : N/A

DATUM  
VERTICAL : N/A  
HORIZONTAL : N/A

THESE PLANS ARE SUBJECT TO SUCH ENGINEERING  
CHANGES AS MAY BE REQUIRED BY THE FEDERAL HIGHWAY  
ADMINISTRATION OR THE DIRECTOR OF PROGRAM  
DEVELOPMENT.

CONSTRUCTION IS TO BE CARRIED ON IN ACCORDANCE  
WITH THESE PLANS AND THE STANDARD SPECIFICATIONS  
FOR CONSTRUCTION DATED 2014, AS APPROVED BY THE  
FEDERAL HIGHWAY ADMINISTRATION ON JULY 20, 2014  
FOR USE ON THIS PROJECT, INCLUDING ALL SUBSEQUENT  
REVISIONS AND SUCH REVISED SPECIFICATIONS AND  
SPECIAL PROVISIONS AS ARE INCORPORATED IN THESE  
PLANS.

DIRECTOR OF PROGRAM DEVELOPMENT

APPROVED [Signature] DATE 2-19-13

PROJECT MANAGER : AMY GAURLE

PROJECT NAME : STATEWIDE SW REGION

PROJECT NUMBER : STPG SIGN (41)

SHEET 1 OF 97 SHEETS