
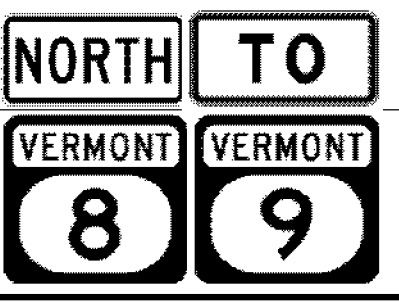





DIRECTION	MILEPOINT	LOCATION CODE (SHEET 2)	SIGN CODE	WIDTH (IN)	HEIGHT (IN)	SHEETING REMARKS	SIGN LEGEND	NEW SIGNS		EXISTING SIGNS				EXIST POST		NUMBER OF NEW POSTS	SQUARE STEEL (IN)			TUBULAR STEEL Ø (IN)				SIGN FRAME REQUIRED	REMARKS	SIGN DETAIL LOCATION			
								"A"	"B"	RETAIN	SALVAGE FROM	SALVAGE TO	REMOVE	RETAIN	REMOVE		1.75	2.00	2.50	FOUNDATION	3.00	3.50	4.00			5.00	SHSM	PROJECT SHEET #	STANDARD SHEET #
																	(LB / FT)				(LB / FT)								
READSBORO VT-8 NB							FY-FLUORESCENT YELLOW FYG-FLUORESCENT YELLOW GREEN															"SHSM"-STANDARD HIGHWAY SIGNS AND MARKINGS							
NB	0.009	A	VD-700	6	10																								
		B	R1-1	30	30																								
		A	VD-700	6	10																								
		B	R1-1	30	30			0.42																					
		B	R1-1	30	30			6.25																					
NB	0.027	A	M3-1	24	12		ROUTE MARKER ASSEMBLY:																						
		A	M1-5	24	24																								
		A	M4-5	24	12																								
		A	M1-5	24	24																								
		A	M1-5	24	24																								
		A	M3-1	24	12			2.00																					
		A	M1-5	24	24			4.00																					
		A	M4-5	24	12																								
		A	M1-5	24	24			4.00																					
NB	0.050	A	W1-1L	30	30		LEFT TURN																						
		A	W13-1	18	18		30 MPH ADVISORY																						
		A	VD2-1	72	12			6.00																					
		A	VD2-1	72	12			6.00																					
		A	VD2-1	72	12			6.00																					
SIGN SUMMARY SHEET							SHEET TOTALS	36.67 36.25	0.00	0	0	0	7	0	0	4	60.0	0	0.0	0.0	0.0	0.0	PROJECT NAME: STATEWIDE SOUTHWEST REGION						
								SF	SF	EA	EA	EA	EA	EA	EA	EA	FT	EA	LB	LB	LB	LB	PROJECT NUMBER: STPG SIGN(41)						
VERMONT AGENCY OF TRANSPORTATION							TOWN DIRECTIONAL TOTALS	90.59 -89.8	0.0	1	0	0	18	0	0	13	195.0	0		0.0			FILE NAME: 12C118	PLOT DATE: 2/21/2013					
																						PROJECT MANAGER: A. GAMBLE	DRAWN BY: J. KELLY						
																						DESIGNED BY: J. KELLY	CHECKED: A. GAMBLE						
																						READSBORO NB SHEET 1	SHEET 13	OF 97					