


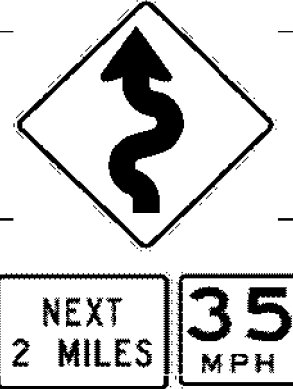


DIRECTION	MILEPOINT	LOCATION CODE (SHEET 2)	SIGN CODE	WIDTH (IN)	HEIGHT (IN)	SHEETING REMARKS	SIGN LEGEND	NEW SIGNS		EXISTING SIGNS				EXIST POST		NUMBER OF NEW POSTS	SQUARE STEEL (IN)			TUBULAR STEEL Ø (IN)				SIGN FRAME REQUIRED	REMARKS	SIGN DETAIL LOCATION			
								"A"	"B"	RETAIN	SALVAGE FROM	SALVAGE TO	REMOVE	RETAIN	REMOVE		1.75	2.00	2.50	FOUNDATION	3.00	3.50	4.00			5.00	SHSM	PROJECT SHEET #	STANDARD SHEET #
																	(LB / FT)				(LB / FT)								
READSBORO VT-8 NB							FY-FLUORESCENT YELLOW FYG-FLUORESCENT YELLOW GREEN															"SHSM"-STANDARD HIGHWAY SIGNS AND MARKINGS							
NB	0.057	A	D3-1	UNK	UNK																		OLD COUNTY LN (TH-31)						
		A	D3-1	54	12			4.50																FIELD LOCATE AS TO NOT BLOCK ANY OTHER SIGNAGE.		11			
NB	0.065	C	VR-017	24	30																			OLD COUNTY LN (TH-31)					
		C	VR-017	24	30			5.00																		6			
NB	0.071	C	VD-700	6	10																			OLD COUNTY LN (TH-31)					
		D	R1-1	30	30			0.42																					
		D	R1-1	30	30			6.25																	X				
NB	0.105	A	D2-1	72	10		DESTINATION SIGN ASSEMBLY																						
		A	D2-1	72	10																								
		A	D2-1	72	10																								
NB	0.268	A	W1-5L	48	48		LEFT WINDING CURVES																	SIGN ASSEMBLY NOT FOUND					
		A	W7-3A	24	18		NEXT 2 MILES																						
		A	W13-1	18	18		35 MPH ADVISORY																						
NB	0.279	A	W1-5L	30	30																			INSTALL 60 FEET NORTH OF EXISTING WINDING ROAD SIGN ASSEMBLY.	X				
		A	W7-3A	24	18			3.00																	X				
		A	W13-1P	18	18			2.25																	X				
SIGN SUMMARY SHEET							SHEET TOTALS	27.67 27.25	0.00	0	0	0	7 9	0	0	6	90.0	0	0.0	0.0	0.0	0.0	PROJECT NAME: STATEWIDE SOUTHWEST REGION						
								SF	SF	EA	EA	EA	EA	EA	EA	EA	FT	EA	LB	LB	LB	LB	PROJECT NUMBER: STPG SIGN(41)						
VERMONT AGENCY OF TRANSPORTATION							TOWN DIRECTIONAL TOTALS	90.59 89.8	0.0	1	0	0	18	0	0	13	195.0	0		0.0			FILE NAME: 12C118	PLOT DATE: 2/21/2013					
																						PROJECT MANAGER: A. GAMBLE	DRAWN BY: J. KELLY						
																						DESIGNED BY: J. KELLY	CHECKED: A. GAMBLE						
																						READSBORO NB SHEET 2	SHEET 14	OF 97					