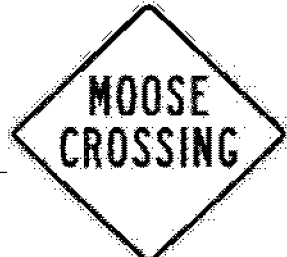

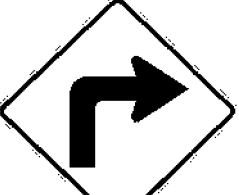

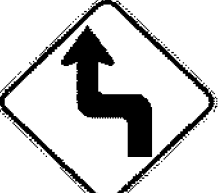



DIRECTION	MILEPOINT	LOCATION CODE (SHEET 2)	SIGN CODE	WIDTH (IN)	HEIGHT (IN)	SHEETING REMARKS	SIGN LEGEND	NEW SIGNS		EXISTING SIGNS				EXIST POST		NUMBER OF NEW POSTS	SQUARE STEEL (IN)			TUBULAR STEEL Ø (IN)				SIGN FRAME REQUIRED	REMARKS	SIGN DETAIL LOCATION			
								"A"	"B"	RETAIN	SALVAGE FROM	SALVAGE TO	REMOVE	RETAIN	REMOVE		1.75	2.00	2.50	FOUNDATION	3.00	3.50	4.00			5.00	SHSM	PROJECT SHEET #	STANDARD SHEET #
																	(LB / FT)				(LB / FT)								
READSBORO VT-8 NB							FY-FLUORESCENT YELLOW FYG-FLUORESCENT YELLOW GREEN															"SHSM"-STANDARD HIGHWAY SIGNS AND MARKINGS							
NB	0.380	A	VW-000	30	30		 	6.25										14'-6" X							INSTALL 525 FEET NORTH OF NEW WINDING ROAD SIGN ASSEMBLY (& SOUTH OF BRIDGE).		7		
		A	W7-3A	24	18			3.00																	X				
NB	0.860	A	W1-1R	30	30		 	6.25										16'-4" X							INSTALL 325 FEET SOUTH OF EXISTING LEFT REVERSE TURN SIGN ASSEMBLY.	X			
		A	W13-1P	18	18			2.25																	X				
NB	0.920	A	W1-3L	30	30		LEFT REVERSE TURN						1																
		A	W13-1	18	18		30 MPH ADVISORY						1																
NB	0.960	A	W1-3L	30	30		 	6.25										15'-0" X							INSTALL 200 FEET NORTH OF EXISTING LEFT REVERSE TURN SIGN ASSEMBLY.	X			
		A	W13-1P	18	18			2.25																	X				
NB	1.275	A	VD11-6H	30	30		FOLDING SNOWMOBILE			1																			
NB	0.800	A	W1-1R	30	30		RIGHT TURN																						
		A	W13-1	18	18		30 MPH ADVISORY																						
SIGN SUMMARY SHEET							SHEET TOTALS	26.25	0.00	1	0	0	4 2-	0	0	3	45.0	0	0.0	0.0	0.0	0.0	PROJECT NAME: STATEWIDE SOUTHWEST REGION						
VERMONT AGENCY OF TRANSPORTATION							TOWN DIRECTIONAL TOTALS	90.59 -89.8	0.0	1	0	0	18	0	0	13	195.0	0		0.0		PROJECT NUMBER: STPG SIGN(41)							
																					FILE NAME: 12C118	PROJECT MANAGER: A. GAMBLE	DESIGNED BY: J. KELLY	PLOT DATE: 2/21/2013	DRAWN BY: J. KELLY	CHECKED: A. GAMBLE	SHEET 15 OF 97		