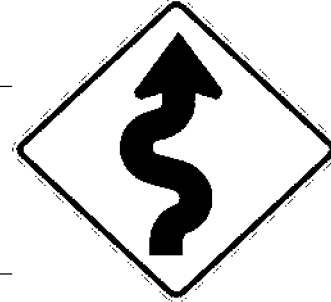

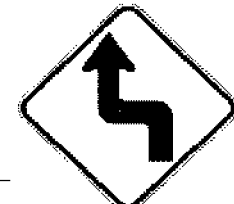

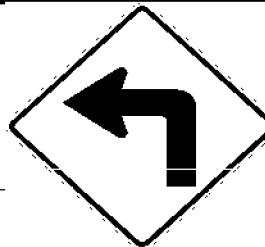



DIRECTION	MILEPOINT	LOCATION CODE (SHEET 2)	SIGN CODE	WIDTH (IN)	HEIGHT (IN)	SHEETING REMARKS	SIGN LEGEND	NEW SIGNS		EXISTING SIGNS				EXIST POST		NUMBER OF NEW POSTS	SQUARE STEEL (IN)			TUBULAR STEEL Ø (IN)				SIGN FRAME REQUIRED	REMARKS	SIGN DETAIL LOCATION										
								"A"	"B"	RETAIN	SALVAGE FROM	SALVAGE TO	REMOVE	RETAIN	REMOVE		1.75	2.00	2.50	FOUNDATION	3.00	3.50	4.00			5.00	SHSM	PROJECT SHEET #	STANDARD SHEET #							
																	(LB / FT)				(LB / FT)															
<b>READSBORO VT-8 SB</b>							FY-FLUORESCENT YELLOW FYG-FLUORESCENT YELLOW GREEN																"SHSM"-STANDARD HIGHWAY SIGNS AND MARKINGS													
SB	2.060	F	W1-5R	30	30			6.25															2	14'-3" 14'-2" X								INSTALL 425 FEET SOUTH OF SMALL GRAVEL PULL-OFF (AT MP 2.14).	X			
		F	W7-3A	24	18				3.00																									X		
		F	W13-1P	18	18				2.25																										X	
SB	1.435	F	VW11-6H	30	30		FOLDING SNOWMOBILE			1																										
SB	1.163	F	W1-3L	30	30			6.25															1	13'-9" X									INSTALL 150 FEET NORTH OF EXISTING LEFT REVERSE TURN SIGN ASSEMBLY.	X		
		F	W13-1P	18	18				2.25																										X	
SB	1.135	F	W1-3L	30	30		LEFT REVERSE TURN																													
		F	W13-1P	18	18		30 MPH ADVISORY																													
SB	0.948	F	W1-1L	30	30		LEFT TURN																													
		F	W13-1P	18	18		30 MPH ADVISORY																													
SB	0.908	F	W1-1L	30	30			6.25															1	15'-0" X									INSTALL 200 FEET SOUTH OF EXISTING LEFT CURVE SIGN ASSEMBLY.	X		
		F	W13-1	18	18				2.25																										X	
SB	0.200	F	W1-1MR	30	30		MODIFIED RIGHT TURN WITH SIDE ROADS																													
		F	W13-1	18	18																															
		F	VD-700	6	10																															
<b>SIGN SUMMARY SHEET</b>							SHEET TOTALS	28.50	0.00	1	0	0	7	0	0	4	60.0	0	0.0	0.0	0.0	0.0		PROJECT NAME: STATEWIDE SOUTHWEST REGION												
								SF	SF	EA	EA	EA	EA	EA	EA	EA	FT	EA	LB	LB	LB	LB		PROJECT NUMBER: STPG SIGN(41)												
							TOWN DIRECTIONAL TOTALS	124.27 123.4	0.0	1	0	0	27	0	0	12	180.0	0		0.0				FILE NAME: 12C118	PROJECT MANAGER: A. GAMBLE	PLOT DATE: 2/13/2013										
																							DESIGNED BY: J. KELLY	CHECKED: A. GAMBLE	DRAWN BY: J. KELLY											
																							VERMONT AGENCY OF TRANSPORTATION	READSBORO SB SHEET 1	SHEET 16	OF 97										