




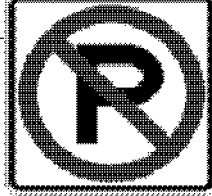




| DIRECTION | MILEPOINT | LOCATION CODE (SHEET 2) | SIGN CODE | WIDTH (IN) | HEIGHT (IN) | SHEETING REMARKS | SIGN LEGEND | NEW SIGNS | | EXISTING SIGNS | | | | EXIST POST | | NUMBER OF NEW POSTS | SQUARE STEEL (IN) | | | TUBULAR STEEL Ø (IN) | | | | SIGN FRAME REQUIRED | REMARKS | SIGN DETAIL LOCATION | | | |
|----------------------------------|-----------|-------------------------|-----------|------------|-------------|------------------|--|-----------------|------|----------------|--------------|------------|----------|------------|--------|---------------------|-------------------|------|------|----------------------|-----------|--|--|--|---------|----------------------|------|-----------------|------------------|
| | | | | | | | | "A" | "B" | RETAIN | SALVAGE FROM | SALVAGE TO | REMOVE | RETAIN | REMOVE | | 1.75 | 2.00 | 2.50 | FOUNDATION | 3.00 | 3.50 | 4.00 | | | 5.00 | SHSM | PROJECT SHEET # | STANDARD SHEET # |
| | | | | | | | | | | | | | | | | | (LB / FT) | | | | (LB / FT) | | | | | | | | |
| SEARSBURG VT-8 NB | | | | | | | FY-FLUORESCENT YELLOW FYG-FLUORESCENT YELLOW GREEN | | | | | | | | | | | | | | | "SHSM"-STANDARD HIGHWAY SIGNS AND MARKINGS | | | | | | | |
| NB | 1.675 | A | D3-1 | UNK | UNK | |  | | | | | | | | | | | | | | | | HAGER LN (TH-5) | | | | | | |
| | | A | D3-1 | 34 | 12 | | | 2.83 | | | | | | | | | | | | | | | INSTALL ABOVE STOP SIGN WITH BRACKET. | | 11 | | | | |
| | | C | VD-700 | 6 | 10 | | | | | | | | | | | | | | | | | | | | | | | | |
| | | D | R1-1 | 30 | 30 | | | | | | | | | | | | | | | | | | HAGER LN (TH-5) | | | | | | |
| | | C | VD-700 | 6 | 10 | |  | 0.42 | | | | | | | | | | | | | | | | | | | | | |
| | | D | R1-1 | 30 | 30 | |  | 6.25 | | | | | | | | | | | | | | | | X | | | | | |
| NB | 1.692 | A | VW-054L | 30 | 30 | |  | 6.25 | | | | | | | | | | | | | | | INSTALL 90 FEET NORTH OF STOP SIGN FOR HAGER LANE AND SOUTH OF UTILITY POLE. | | 7 | | | | |
| NB | 2.000 | A | R8-3A | 24 | 24 | | | | | | | | | | | | | | | | | | | | | | | | |
| | | A | R7-201a | 12 | 6 | | | | | | | | | | | | | | | | | | | | | | | | |
| | | A | VR-644P | 24 | 12 | | | | | | | | | | | | | | | | | | | | | | | | |
| | | A | R3-9cP | 30 | 12 | |  | 2.50 | | | | | | | | | | | | | | | | X | | | | | |
| | | A | R8-3 | 24 | 24 | |  | 4.00 | | | | | | | | | | | | | | | | X | | | | | |
| NB | 2.038 | A | W1-5L | 30 | 30 | | LEFT WINDING ROAD | | | | | | | | | | | | | | | | | | | | | | |
| | | A | W13-1 | 18 | 18 | | 35 MPH ADVISORY | | | | | | | | | | | | | | | | | | | | | | |
| NB | 2.080 | A | R7-201a | 12 | 6 | | | | | | | | | | | | | | | | | | | | | | | | |
| | | A | R8-3A | 24 | 30 | | | | | | | | | | | | | | | | | | | | | | | | |
| | | A | R8-3 | 24 | 30 | |  | 4.00 | | | | | | | | | | | | | | | | X | | | | | |
| NB | 2.120 | A | W1-2L | 30 | 30 | |  | 6.25 | | | | | | | | | | | | | | | INSTALL AT NORTHERLY END OF GRAVEL PULL OFF AND 10 FEET SOUTH OF UTILITY POLE WITH GUY WIRES. | X | | | | | |
| NB | 2.156 | A | R7-201a | 12 | 6 | | | | | | | | | | | | | | | | | | | | | | | | |
| | | A | R8-3A | 24 | 24 | | | | | | | | | | | | | | | | | | | | | | | | |
| SIGN SUMMARY SHEET | | | | | | | SHEET TOTALS | 32.50 32.08 | 0.00 | 0 | 0 | 0 | 12 8 | 0 | 0 | 5 | 75.0 | 0 | 0.0 | 0.0 | 0.0 | 0.0 | PROJECT NAME: STATEWIDE SOUTHWEST REGION PROJECT NUMBER: STPG SIGN(41) | | | | | | |
| VERMONT AGENCY OF TRANSPORTATION | | | | | | | TOWN DIRECTIONAL TOTALS | 158.57 151.9 | 0.0 | 3 1 | 0 | 0 | 37 32 | 0 | 0 | 23 22 | 345.0 330.0 | 0 | | 0.0 | | | FILE NAME: 12C118 PROJECT MANAGER: A. GAMBLE DESIGNED BY: J. KELLY SEARSBURG NB SHEET 2 | PLOT DATE: 2/13/2013 DRAWN BY: J. KELLY CHECKED: A. GAMBLE SHEET 21 OF 97 | | | | | |