


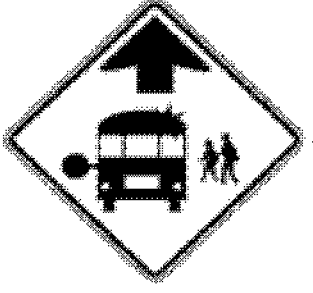
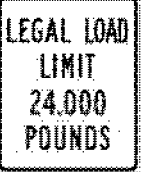




DIRECTION	MILEPOINT	LOCATION CODE (SHEET 2)	SIGN CODE	WIDTH (IN)	HEIGHT (IN)	SHEETING REMARKS	SIGN LEGEND	NEW SIGNS		EXISTING SIGNS				EXIST POST		NUMBER OF NEW POSTS	SQUARE STEEL (IN)			TUBULAR STEEL Ø (IN)				SIGN FRAME REQUIRED	REMARKS	SIGN DETAIL LOCATION			
								"A"	"B"	RETAIN	SALVAGE FROM	SALVAGE TO	REMOVE	RETAIN	REMOVE		1.75	2.00	2.50	FOUNDATION	3.00	3.50	4.00			5.00	SHSM	PROJECT SHEET #	STANDARD SHEET #
																	(LB / FT)				(LB / FT)								
JAMAICA VT-30 NB							FY-FLUORESCENT YELLOW FYG-FLUORESCENT YELLOW GREEN															"SHSM"-STANDARD HIGHWAY SIGNS AND MARKINGS							
NB	0.982	A	D3-1	68	12		Turkey Mtn Rd J20	5.67							2	12'-1" 11'-8" X								INSTALL BEHIND GUARDRAIL AT SOUTH SIDE OF INTERSECTION.		11			
NB	0.984	C	VR-017	24	30							1	X	X										TURKEY MTN RD (TH-20)					
		C	VR-017	24	30			5.00							1	13'-4" X								INSTALL ON EXISTING FLANGED CHANNEL SIGN POST.		6			
NB	0.990	A	D3-1	UNK	UNK		TURKEY MTN RD STREET SIGN					1												TURKEY MTN RD (TH-20)					
		C	VD-700	6	10		MILEMARKER SALVAGED FROM			1																			
		D	R1-1	30	30							1	X	X															
		C	VD-700	6	10			6.25			1					13'-6" X								INSTALL ON EXISTING FLANGED CHANNEL SIGN POST.	X				
		D	R1-1	30	30																								
NB	1.380	A	S3-1T	30	30		SCHOOL BUS STOP AHEAD					1																	
		A	S3-1	36	36	FYG		9.00							2	13'-4" 13'-5" X										X			
NB	1.562	C	VR-017	24	30							1	X												HOWE FARM RD (TH-22)				
		C	VR-017	24	30			5.00																	INSTALL ON EXISTING FLANGED CHANNEL SIGN POST.		6		
NB	1.568	C	VD-700	6	10					1															HOWE FARM RD (TH-22)				
		D	R1-1	30	30			6.25				1	X												INSTALL ON EXISTING FLANGED CHANNEL SIGN POST.	X			
NB	1.571	A	D3-1	UNK	UNK							1													HOWE FARM RD (TH-22)				
		A	D3-1	64	12		Howe Farm Rd J22	5.33							2	13'-9" 13'-0" X									INSTALL ON TWO POSTS AT EXISTING LOCATION.		11		
NB	1.894	C	VR-017	24	30							1	X												GILFEATHER LA (TH-21)				
SIGN SUMMARY SHEET							SHEET TOTALS	42.50	0.00	10	10	10	8	0	0	8	120.0 -90.0								PROJECT NAME: STATEWIDE SOUTHWEST REGION				
								SF	SF	EA	EA	EA	EA	EA	EA	EA	FT	EA	LB	LB	LB	LB	LB	PROJECT NUMBER: STPG SIGN(41)					
VERMONT AGENCY OF TRANSPORTATION							TOWN DIRECTIONAL TOTALS	438.5 -443.5	0.0	32 -29	2 -1	2 -1	88 -78	0	0	63 -62	945.0 -930.0				0.0				FILE NAME: 12C118	PROJECT MANAGER: A. GAMBLE	PLOT DATE: 2/13/2013		
																							DESIGNED BY: J. KELLY	CHECKED: A. GAMBLE	DRAWN BY: J. KELLY	SHEET 31 OF 97			