

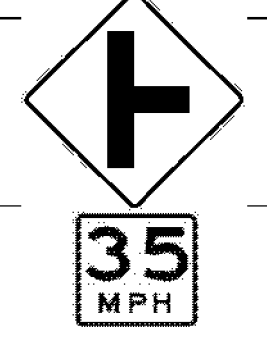
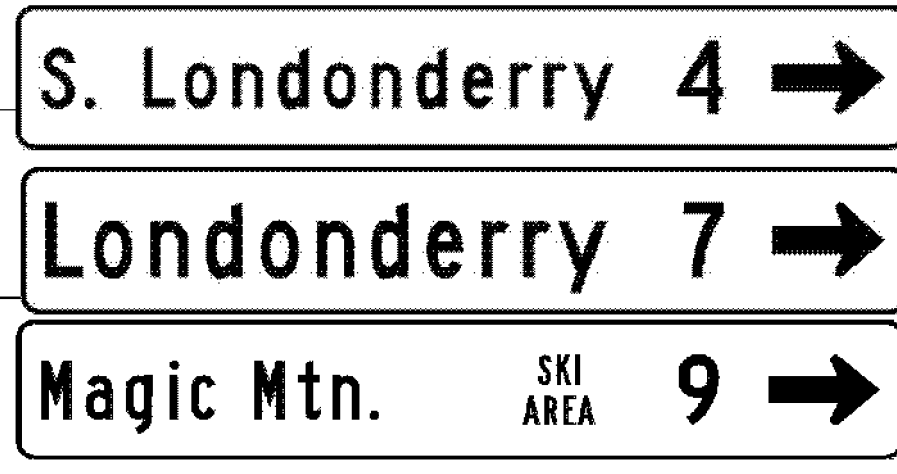


DIRECTION	MILEPOINT	LOCATION CODE (SHEET 2)	SIGN CODE	WIDTH (IN)	HEIGHT (IN)	SHEETING REMARKS	SIGN LEGEND	NEW SIGNS		EXISTING SIGNS				EXIST POST		NUMBER OF NEW POSTS	SQUARE STEEL (IN)			TUBULAR STEEL Ø (IN)				SIGN FRAME REQUIRED	REMARKS	SIGN DETAIL LOCATION			
								"A"	"B"	RETAIN	SALVAGE FROM	SALVAGE TO	REMOVE	RETAIN	REMOVE		1.75	2.00	2.50	FOUNDATION	3.00	3.50	4.00			5.00	SHSM	PROJECT SHEET #	STANDARD SHEET #
																	(LB / FT)				(LB / FT)								
JAMAICA VT-30 NB							FY-FLUORESCENT YELLOW FYG-FLUORESCENT YELLOW GREEN																"SHSM"-STANDARD HIGHWAY SIGNS AND MARKINGS						
NB	8.666	C D	VD-700 R1-1	6 30	10 30																								
		C D	VD-700 R1-1	6 30	10 30			0.42 6.25																		X			
NB	8.666	A	D3-1	UNK	UNK																								
NB	8.660	A	D3-1	68	12			5.67																				11	
NB	8.675	A	W2-2R	36	36																								
		A	W13-1	18	18																								
		A	W2-2R	30	30			6.25																		X			
		A	W13-1P	18	18			2.25																		X			
NB	8.710	A	VD1-1A	72	12			6.00																				9	
		A	VD1-1A	72	12			6.00																				9	
		A	VD1-1A	72	12			6.00																				9	
NB	8.723	A	D1-1A	72	12		DESTINATION SIGN ASSEMBLY.																						
		A	D1-1A	72	12																								
		A	D1-1S	72	12																								
NB	8.740	A	D1-1A	72	12		DESTINATION SIGN ASSEMBLY.																						
SIGN SUMMARY SHEET							SHEET TOTALS	38.84 38.42	0.00	0	0	0	0	9	0	0	5	75.0	0	0.0	0.0	0.0	0.0	PROJECT NAME: STATEWIDE SOUTHWEST REGION					
								SF	SF	EA	EA	EA	EA	EA	EA	EA	EA	FT	EA	LB	LB	LB	LB	PROJECT NUMBER: STPG SIGN(41)					
VERMONT AGENCY OF TRANSPORTATION							TOWN DIRECTIONAL TOTALS	438.5 443.5	0.0	32	2	2	88	78	0	0	63	945.0	0		0.0			FILE NAME: 12C118	PLOT DATE: 2/13/2013				
										29	1	1	78	0	0	62	930.0						PROJECT MANAGER: A. GAMBLE	DRAWN BY: J. KELLY					
																							DESIGNED BY: J. KELLY	CHECKED: A. GAMBLE					
																							JAMAICA NB SHEET 11	SHEET 39	OF 97				