




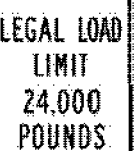


DIRECTION	MILEPOINT	LOCATION CODE (SHEET 2)	SIGN CODE	WIDTH (IN)	HEIGHT (IN)	SHEETING REMARKS	SIGN LEGEND	NEW SIGNS		EXISTING SIGNS				EXIST POST		NUMBER OF NEW POSTS	SQUARE STEEL (IN)			TUBULAR STEEL Ø (IN)				SIGN FRAME REQUIRED	REMARKS	SIGN DETAIL LOCATION			
								"A"	"B"	RETAIN	SALVAGE FROM	SALVAGE TO	REMOVE	RETAIN	REMOVE		1.75	2.00	2.50	FOUNDATION	3.00	3.50	4.00			5.00	SHSM	PROJECT SHEET #	STANDARD SHEET #
																	(LB / FT)				(LB / FT)								
JAMAICA VT-30 SB							FY-FLUORESCENT YELLOW FYG-FLUORESCENT YELLOW GREEN																"SHSM"-STANDARD HIGHWAY SIGNS AND MARKINGS						
SB	10.015	F	R2-1	24	30																								
		F	R2-1	24	30			5.00																	X		INSTALL DIRECTLY ACROSS FROM NB SPEED LIMIT 40 SIGN ASSEMBLY.		
SB	9.302	F	W3-5	36	36		SPEED REDUCTION ADVANCE WARNING SIGN (40 MPH)			1																			
SB	9.245	F	VD-018	30	18																								
		F	VD-018	30	18			3.75																		5			
SB	9.150	F	R2-1	24	30																								
		F	R2-1	30	36			7.50																	X				
SB	9.110	F	VW-054R	30	30		HIDDEN DRIVE RIGHT																						
		F	VW-054R	30	30			6.25																		7			
		F	W11-5M	30	30		FARM MACHINERY																						
SB	8.983	A	D3-1	UNK	UNK																								
		A	D3-1	40	12			3.33																					
SB	8.983	G	VR-017	24	30																								
		G	VR-017	24	30			5.00																		6			
SB	8.977	H	R1-1	30	30																								
SIGN SUMMARY SHEET							SHEET TOTALS	30.83	0.00	1	0	0	9 8	0	0	7 5	105.0 75.0	0	0.0	0.0	0.0	0.0	PROJECT NAME: STATEWIDE SOUTHWEST REGION PROJECT NUMBER: STPG SIGN(41)						
VERMONT AGENCY OF TRANSPORTATION							TOWN DIRECTIONAL TOTALS	431.84 430.2	0.0	31 29	2 0	2 0	85 82	0	0	66 63	990.0 945.0	0		0.0			FILE NAME: 12C118 PROJECT MANAGER: A. GAMBLE DESIGNED BY: J. KELLY JAMAICA SB SHEET 1 PLOT DATE: 2/13/2013 DRAWN BY: J. KELLY CHECKED: A. GAMBLE SHEET 43 OF 97						