
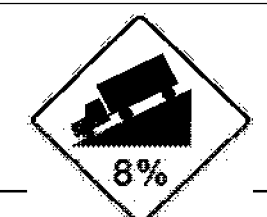


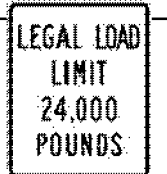
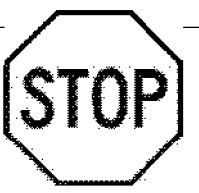




DIRECTION	MILEPOINT	LOCATION CODE (SHEET 2)	SIGN CODE	WIDTH (IN)	HEIGHT (IN)	SHEETING REMARKS	SIGN LEGEND	NEW SIGNS		EXISTING SIGNS				EXIST POST		NUMBER OF NEW POSTS	SQUARE STEEL (IN)			TUBULAR STEEL Ø (IN)				SIGN FRAME REQUIRED	REMARKS	SIGN DETAIL LOCATION			
								"A"	"B"	RETAIN	SALVAGE FROM	SALVAGE TO	REMOVE	RETAIN	REMOVE		1.75	2.00	2.50	FOUNDATION	3.00	3.50	4.00			5.00	SHSM	PROJECT SHEET #	STANDARD SHEET #
																	(LB / FT)				(LB / FT)								
<b>JAMAICA VT-30 SB</b>							FY-FLUORESCENT YELLOW FYG-FLUORESCENT YELLOW GREEN																"SHSM"-STANDARD HIGHWAY SIGNS AND MARKINGS						
SB	5.450	F	VW-054R	30	30																								
		F	VW-054R	30	30				6.25																		7		
SB	5.410	F	W7-1B	36	36		HILL SYMBOL																						
SB	4.960	F	W7-1B	36	36																								
		F	W7-3A	24	18																								
		F	W7-1A	36	36		 																						
		F	W7-3A	24	18				9.00																		X		
		F	W7-3A	24	18																					X			
SB	4.705	G	D3-1	UNK	UNK																								
		G	D3-1	56	12				4.67																			11	
SB	4.705	G	VR-017	24	30																								
		G	VR-017	24	30				5.00																			6	
SB	4.697	G	VD-700	6	10		 																						
		H	R1-1	30	30				6.25																				
		G	VD-700	6	10																								
		H	R1-1	30	30																					X			
SB	4.605	F	W3-5	36	36																								
		F	W3-5	36	36				9.00																		X		
<b>SIGN SUMMARY SHEET</b>							SHEET TOTALS	43.17	0.00	0	<del>1</del> 0	<del>1</del> 0	8	0	0	9	135.0	0	0.0	0.0	0.0	0.0		PROJECT NAME: STATEWIDE SOUTHWEST REGION PROJECT NUMBER: STPG SIGN(41)					
								SF	SF	EA	EA	EA	EA	EA	EA	EA	FT	EA	LB	LB	LB	LB		FILE NAME: 12C118 PROJECT MANAGER: A. GAMBLE DESIGNED BY: J. KELLY JAMAICA SB SHEET 8					
VERMONT AGENCY OF TRANSPORTATION							TOWN DIRECTIONAL TOTALS	431.84 <del>430.2</del>	0.0	31 <del>29</del>	2 <del>0</del>	2 <del>0</del>	85 <del>82</del>	0	0	66 <del>63</del>	990.0 <del>945.0</del>	0		0.0				PLOT DATE: 2/13/2013 DRAWN BY: J. KELLY CHECKED: A. GAMBLE SHEET 50 OF 97					