
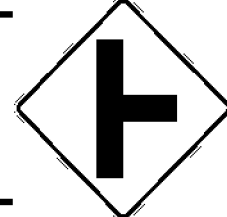









DIRECTION	MILEPOINT	LOCATION CODE (SHEET 2)	SIGN CODE	WIDTH (IN)	HEIGHT (IN)	SHEETING REMARKS	SIGN LEGEND	NEW SIGNS		EXISTING SIGNS				EXIST POST		NUMBER OF NEW POSTS	SQUARE STEEL (IN)			TUBULAR STEEL Ø (IN)				SIGN FRAME REQUIRED	REMARKS	SIGN DETAIL LOCATION			
								"A"	"B"	RETAIN	SALVAGE FROM	SALVAGE TO	REMOVE	RETAIN	REMOVE		1.75	2.00	2.50	FOUNDATION	3.00	3.50	4.00			5.00	SHSM	PROJECT SHEET #	STANDARD SHEET #
																	(LB / FT)				(LB / FT)								
POULTNEY VT-31 NB							FY-FLUORESCENT YELLOW FYG-FLUORESCENT YELLOW GREEN															"SHSM"-STANDARD HIGHWAY SIGNS AND MARKINGS							
NB	2.003	A	VD-700 W2-2R	6 30	10 30		RIGHT SIDE ROAD 					1																	
NB	2.050	A	W2-2R	30	30			6.25										13'-5" X							INSTALL 250 NORTH OF EXISTING RIGHT SIDE ROAD SIGN ASSEMBLY.	X			
NB	2.128	C	VR-079	24	30							1													UPPER RD (TH-11)				
		C	VR-079	24	30			5.00											12'-9" X										6
NB	2.132	C	VD-700	6	10					1															UPPER RD (TH-11)				
		D	R1-1	30	30			6.25																	INSTALL ON EXISTING FLANGED CHANNEL SIGN POST.	X			
NB	2.133	A	D3-1	UNK	UNK		UPPER RD STREET SIGN					1													UPPER RD (TH-11)				
		A	D3-1	34	12			2.83											11'-9" X										12
NB	2.390	A	R2-5A	24	30		REDUCED SPEED AHEAD 					1																	
		A	W3-5	36	36			9.00											14'-2" 14'-4" X							X			
NB	2.429	A	VD-018	30	18							1													INSTALL SIGN ON EXISTING FLANGED CHANNEL SIGN POST.			5	
		A	VD-018	30	18			3.75																					
NB	2.470	A	R2-1	24	30		SPEED LIMIT 40					1																	
		A	R2-1	30	36			7.50												13'-7" X						INSTALL NEW 10+/- FEET NORTH OF AND ACROSS FROM UTILITY POLE.	X		
NB	2.506	C	R2-1 VR-017	18 24	24 30							1													JONES RD (TH-35)				
SIGN SUMMARY SHEET							SHEET TOTALS	40.58	0.00	1 0	0	0	10 8	0	0	6	90.0	0	0.0	0.0	0.0	0.0	PROJECT NAME: STATEWIDE SOUTHWEST REGION						
								SF	SF	EA	EA	EA	EA	EA	EA	EA	FT	EA	LB	LB	LB	LB	PROJECT NUMBER: STPG SIGN(41)						
VERMONT AGENCY OF TRANSPORTATION							TOWN DIRECTIONAL TOTALS	248.2 243.2	0.0	2	0	0	60 57	0	0	27 25	405.0 375.0	0		0.0			FILE NAME: 12C118	PROJECT MANAGER: A. GAMBLE	PLOT DATE: 2/13/2013				
																						DESIGNED BY: J. KELLY	CHECKED: A. GAMBLE	DRAWN BY: J. KELLY					
																						POULTNEY NB SHEET 4	SHEET 67	OF 97					