

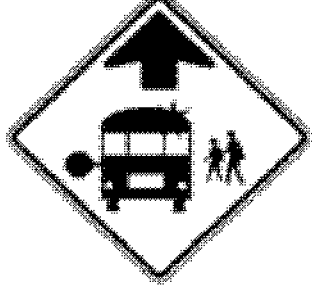



DIRECTION	MILEPOINT	LOCATION CODE (SHEET 2)	SIGN CODE	WIDTH (IN)	HEIGHT (IN)	SHEETING REMARKS	SIGN LEGEND	NEW SIGNS		EXISTING SIGNS				EXIST POST		NUMBER OF NEW POSTS	SQUARE STEEL (IN)			TUBULAR STEEL Ø (IN)				SIGN FRAME REQUIRED	REMARKS	SIGN DETAIL LOCATION			
								"A"	"B"	RETAIN	SALVAGE FROM	SALVAGE TO	REMOVE	RETAIN	REMOVE		1.75	2.00	2.50	FOUNDATION	3.00	3.50	4.00			5.00	SHSM	PROJECT SHEET #	STANDARD SHEET #
																	(LB / FT)				(LB / FT)								
POULTNEY VT-31 SB							FY-FLUORESCENT YELLOW FYG-FLUORESCENT YELLOW GREEN																"SHSM"-STANDARD HIGHWAY SIGNS AND MARKINGS						
SB	1.167	F	W1-2L	30	30			6.25							1	15'-0" X								INSTALL 200 FEET SOUTH OF EXISTING LEFT CURVE SIGN ASSEMBLY.	X				
SB	1.150	F	W1-8L	18	24		CHEVRON																						
SB	1.14-1.07	E/F	N/A	6	8		INSTALL ⁷ (8) NEW DELINEATOR POSTS																			4			
SB	1.145	E	W1-8R	18	24		CHEVRON																						
SB	1.120	F	W1-8L	18	24		CHEVRON																						
SB	1.120	E	W1-8R	18	24		CHEVRON																						
SB	1.090	F	W1-8R	18	24		CHEVRON																						
SB	1.090	E	W1-8L	18	24		CHEVRON																						
SB	1.000	F	VW-054R	30	30		HIDDEN DRIVE RIGHT																						
		F	S3-1T	30	30		SCHOOL BUS STOP AHEAD																						
		F	W1-10R	36	36	FY		9.00																INSTALL NEW SIGNS ON EXISTING FLANGED CHANNEL SIGN POSTS.	X				
		F	S3-1	36	36	FYG		9.00																		X			
SB	0.955	F	W1-2MR	30	30		MODIFIED RIGHT CURVE																						
		F	W13-1	18	18		35 MPH ADVISORY																						
SB	0.940	F	VW-133R	30	30			6.25							1	12'-8" X									INSTALL 80 FEET SOUTH OF EXISTING RIGHT CURVE SIGN ASSEMBLY.		7		
SIGN SUMMARY SHEET							SHEET TOTALS	30.50	0.00	0	0	0	10	0	0	2	30.0	0	0.0	0.0	0.0	0.0		PROJECT NAME: STATEWIDE SOUTHWEST REGION					
								SF	SF	EA	EA	EA	EA	EA	EA	EA	FT	EA	LB	LB	LB	LB	PROJECT NUMBER: STPG SIGN(41)						
VERMONT AGENCY OF TRANSPORTATION							TOWN DIRECTIONAL TOTALS	207.2	0.0	2	0	0	43 41	0	0	31 29	465.0 435.0	0		0.0				FILE NAME: 12C118	PLOT DATE: 2/13/2013				
																							PROJECT MANAGER: A. GAMBLE	DRAWN BY: J. KELLY					
																							DESIGNED BY: J. KELLY	CHECKED: A. GAMBLE					
																							POULTNEY SB SHEET 4	SHEET 75 OF 97					