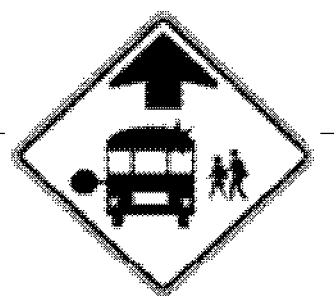
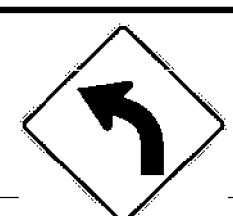
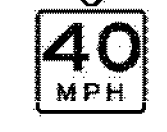
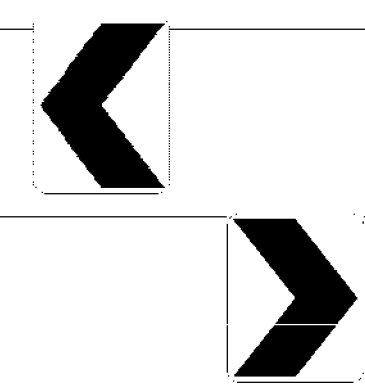


DIRECTION	MILEPOINT	LOCATION CODE (SHEET 2)	SIGN CODE	WIDTH (IN)	HEIGHT (IN)	SHEETING REMARKS	SIGN LEGEND	NEW SIGNS		EXISTING SIGNS				EXIST POST		NUMBER OF NEW POSTS	SQUARE STEEL (IN)			TUBULAR STEEL Ø (IN)				SIGN FRAME REQUIRED	REMARKS	SIGN DETAIL LOCATION			
								"A"	"B"	RETAIN	SALVAGE FROM	SALVAGE TO	REMOVE	RETAIN	REMOVE		1.75	2.00	2.50	FOUNDATION	3.00	3.50	4.00			5.00	SHSM	PROJECT SHEET #	STANDARD SHEET #
																	(LB / FT)				(LB / FT)								
POULTNEY VT-31 SB							FY-FLUORESCENT YELLOW FYG-FLUORESCENT YELLOW GREEN																"SHSM"-STANDARD HIGHWAY SIGNS AND MARKINGS						
SB	0.200	F	S3-1T	30	30		SCHOOL BUS STOP AHEAD 																						
		F	S3-1	36	36	FYG		9.00																		X			
SB	0.074	F	W1-2L	30	30		LEFT CURVE																						
		F	W13-1	18	18		35 MPH ADVISORY																						
SB	0.040	F	W1-2L	30	30	FY		6.25																		X		INSTALL 180 FEET SOUTH OF EXISTING LEFT CURVE SIGN ASSEMBLY.	
		F	W13-1P	18	18	FY		2.25																		X			
SB	0.000	F	W1-8L	18	24																								
		E	W1-8R	18	24																								
		F	W1-8L	18	24	FY		3.00																		X		INSTALL SIGNS BACK TO BACK ON SAME SIGN POST.	
		E	W1-8R	18	24	FY		3.00																	X				
SIGN SUMMARY SHEET							SHEET TOTALS	23.50	0.00	0	0	0	5	0	0	4	60.0	0	0.0	0.0	0.0	0.0	0.0	0.0	0.0	0.0	PROJECT NAME: STATEWIDE SOUTHWEST REGION PROJECT NUMBER: STPG SIGN(41)		
VERMONT AGENCY OF TRANSPORTATION							TOWN DIRECTIONAL TOTALS	207.2	0.0	2	0	0	43 41	0	0	31 29	465.0 435.0	0		0.0						FILE NAME: 12C118 PROJECT MANAGER: A. GAMBLE DESIGNED BY: J. KELLY POULTNEY SB SHEET 6			
																										PLOT DATE: 2/13/2013 DRAWN BY: J. KELLY CHECKED: A. GAMBLE SHEET 77 OF 97			