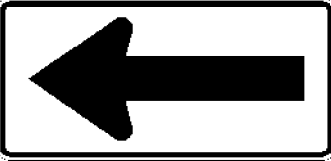
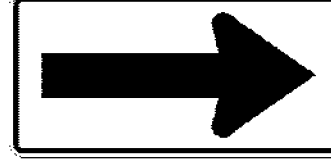


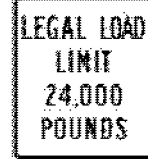



DIRECTION	MILEPOINT	LOCATION CODE (SHEET 2)	SIGN CODE	WIDTH (IN)	HEIGHT (IN)	SHEETING REMARKS	SIGN LEGEND	NEW SIGNS		EXISTING SIGNS				EXIST POST		NUMBER OF NEW POSTS	SQUARE STEEL (IN)			TUBULAR STEEL Ø (IN)				SIGN FRAME REQUIRED	REMARKS	SIGN DETAIL LOCATION				
								"A"	"B"	RETAIN	SALVAGE FROM	SALVAGE TO	REMOVE	RETAIN	REMOVE		1.75	2.00	2.50	FOUNDATION	3.00	3.50	4.00			5.00	SHSM	PROJECT SHEET #	STANDARD SHEET #	
																	(LB / FT)				(LB / FT)									
<b>POWNAI VT-346 NB</b>							FY-FLUORESCENT YELLOW FYG-FLUORESCENT YELLOW GREEN																"SHSM"-STANDARD HIGHWAY SIGNS AND MARKINGS							
NB	3.558	A	W1-6	48	24																									
		A	W1-6L	48	24			8.00																	X					
NB	3.559	B	W1-6	48	24																									
		B	W1-6R	48	24			8.00																	X					
NB	3.559	D	R1-1	30	30		STOP			1																				
NB	3.565	D	R1-1	30	30		STOP			1																				
NB	3.565	A	D3-1	UNK	UNK		NORTH POWNAI STREET SIGN			1																				
NB	3.578	A	OM-3R	12	36																									
		A	OM3-R	12	36			3.00																	X					
NB	3.587	B	OM-3L	12	36																									
		B	OM3-L	12	36			3.00																	X					
NB	3.589	C	VR-017	24	30																									
		C	VR-017	24	30			5.00																		6				
NB	3.596	A	D3-1	UNK	UNK																									
		C	VD-700	6	10		MILE MARKER																							
		D	R1-1	30	30																									
<b>SIGN SUMMARY SHEET</b>							<b>SHEET TOTALS</b>	27.00	0.00	3	0	0	<del>8</del>	0	0	5	75.0	0	0.0	0.0	0.0	0.0	0.0	PROJECT NAME: STATEWIDE SOUTHWEST REGION PROJECT NUMBER: STPG SIGN(41)						
VERMONT AGENCY OF TRANSPORTATION							<b>TOWN DIRECTIONAL TOTALS</b>	224.3	0.0	31	3	3	47	0	0	32	480.0	0		0.0					FILE NAME: 12C118 PROJECT MANAGER: A. GAMBLE DESIGNED BY: J. KELLY POWNAI NB SHEET 6 PLOT DATE: 2/15/2013 DRAWN BY: J. KELLY CHECKED: A. GAMBLE SHEET 83 OF 97					