


STATE OF VERMONT AGENCY OF TRANSPORTATION



PROPOSED IMPROVEMENT TOWNS OF READSBORO, SEARSBURG, JAMAICA, WELLS, POULTNEY AND POWNAL COUNTIES OF BENNINGTON, RUTLAND AND WINDHAM VERMONT ROUTES 8, 30, 31 AND 346 (MAJOR COLLECTORS)

INDEX OF SHEETS AND STANDARDS
SEE SHEET 2

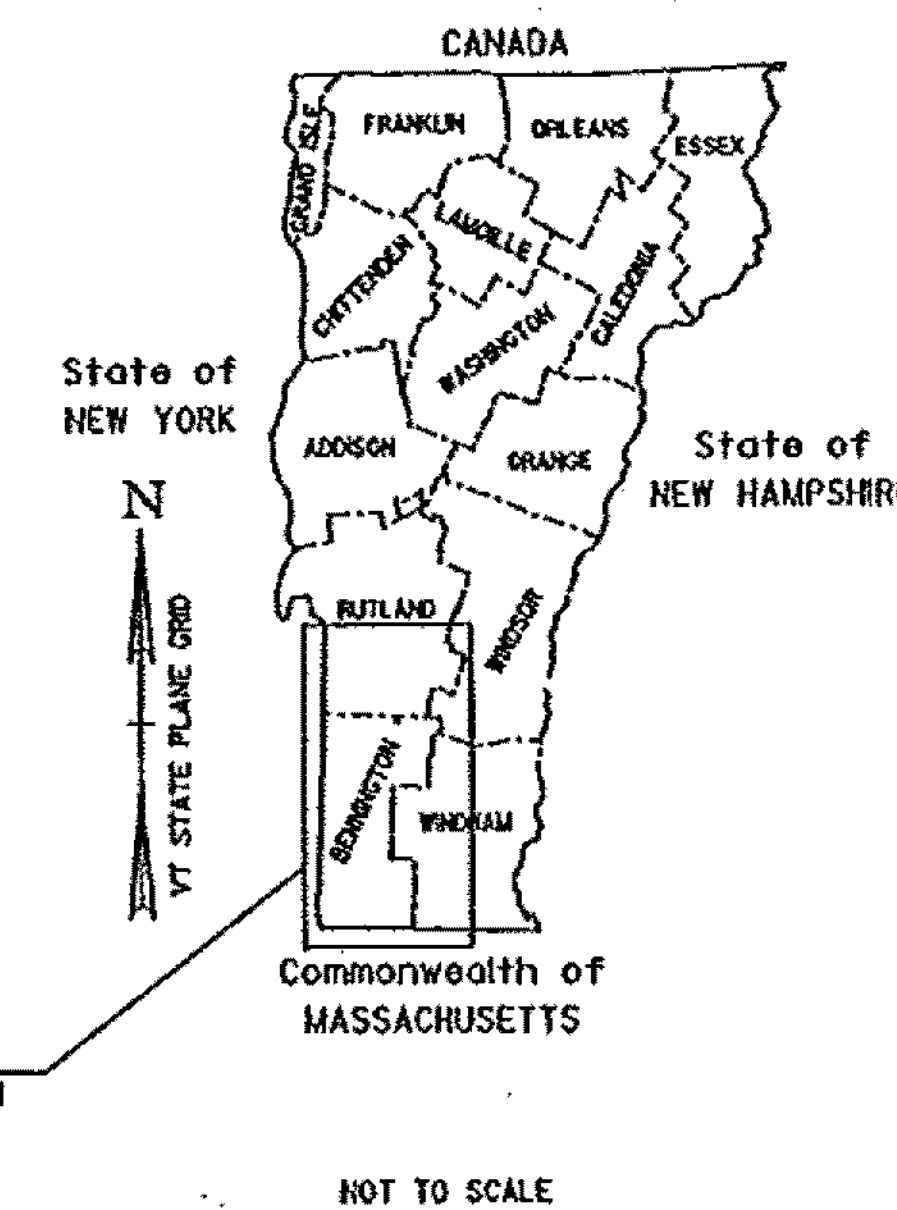

SOUTHWESTERN REGION SIGN REPLACEMENT - 25.492 MILES:
READSBORO (VT-8) MP 0.000-2.507, SEARSBURG (VT-8) MP 0.000-2.703,
JAMAICA (VT-30) MP 0.000-10.89, WELLS (VT-30) MP 0.000-1.756,
POULTNEY (VT-30) MP 0.000-3.779, POWNAL (VT-346) MP 0.000-4.628

LENGTH OF ROADWAY = 25.492
LENGTH OF PROJECT = 25.492

WORK TO BE PERFORMED INCLUDES THE REMOVAL OF EXISTING SIGNS AND POSTS
AND THE INSTALLATION OF NEW SIGNS AND POSTS AND OTHER RELATED HIGHWAY ITEMS

RECORD PLANS

CONTRACTOR: AMERICAN FLAGGING & TRAFFIC CONTROL - SALEM, NH

RESIDENT ENGINEER: SARA LUICHINGER

CONSTRUCTION BEGAN: AUGUST 20, 2013

CONSTRUCTION COMPLETE: OCTOBER 3, 2013


RECORD PLANS BY: SARAH LUICHINGER & STEVE KENT

HEREBY CERTIFY THAT ALL THE CONSTRUCTION REQUIRED BY THIS SET
OF DRAWINGS HAS BEEN ACCOMPLISHED AS INDICATED HEREIN.

BY Sara Luichinger RESIDENT ENGINEER

DATE 8/11/14

NOTE: Any further information concerning final quantities, amounts or other details
relative to this project may be found at Central Files in the electronic archives.

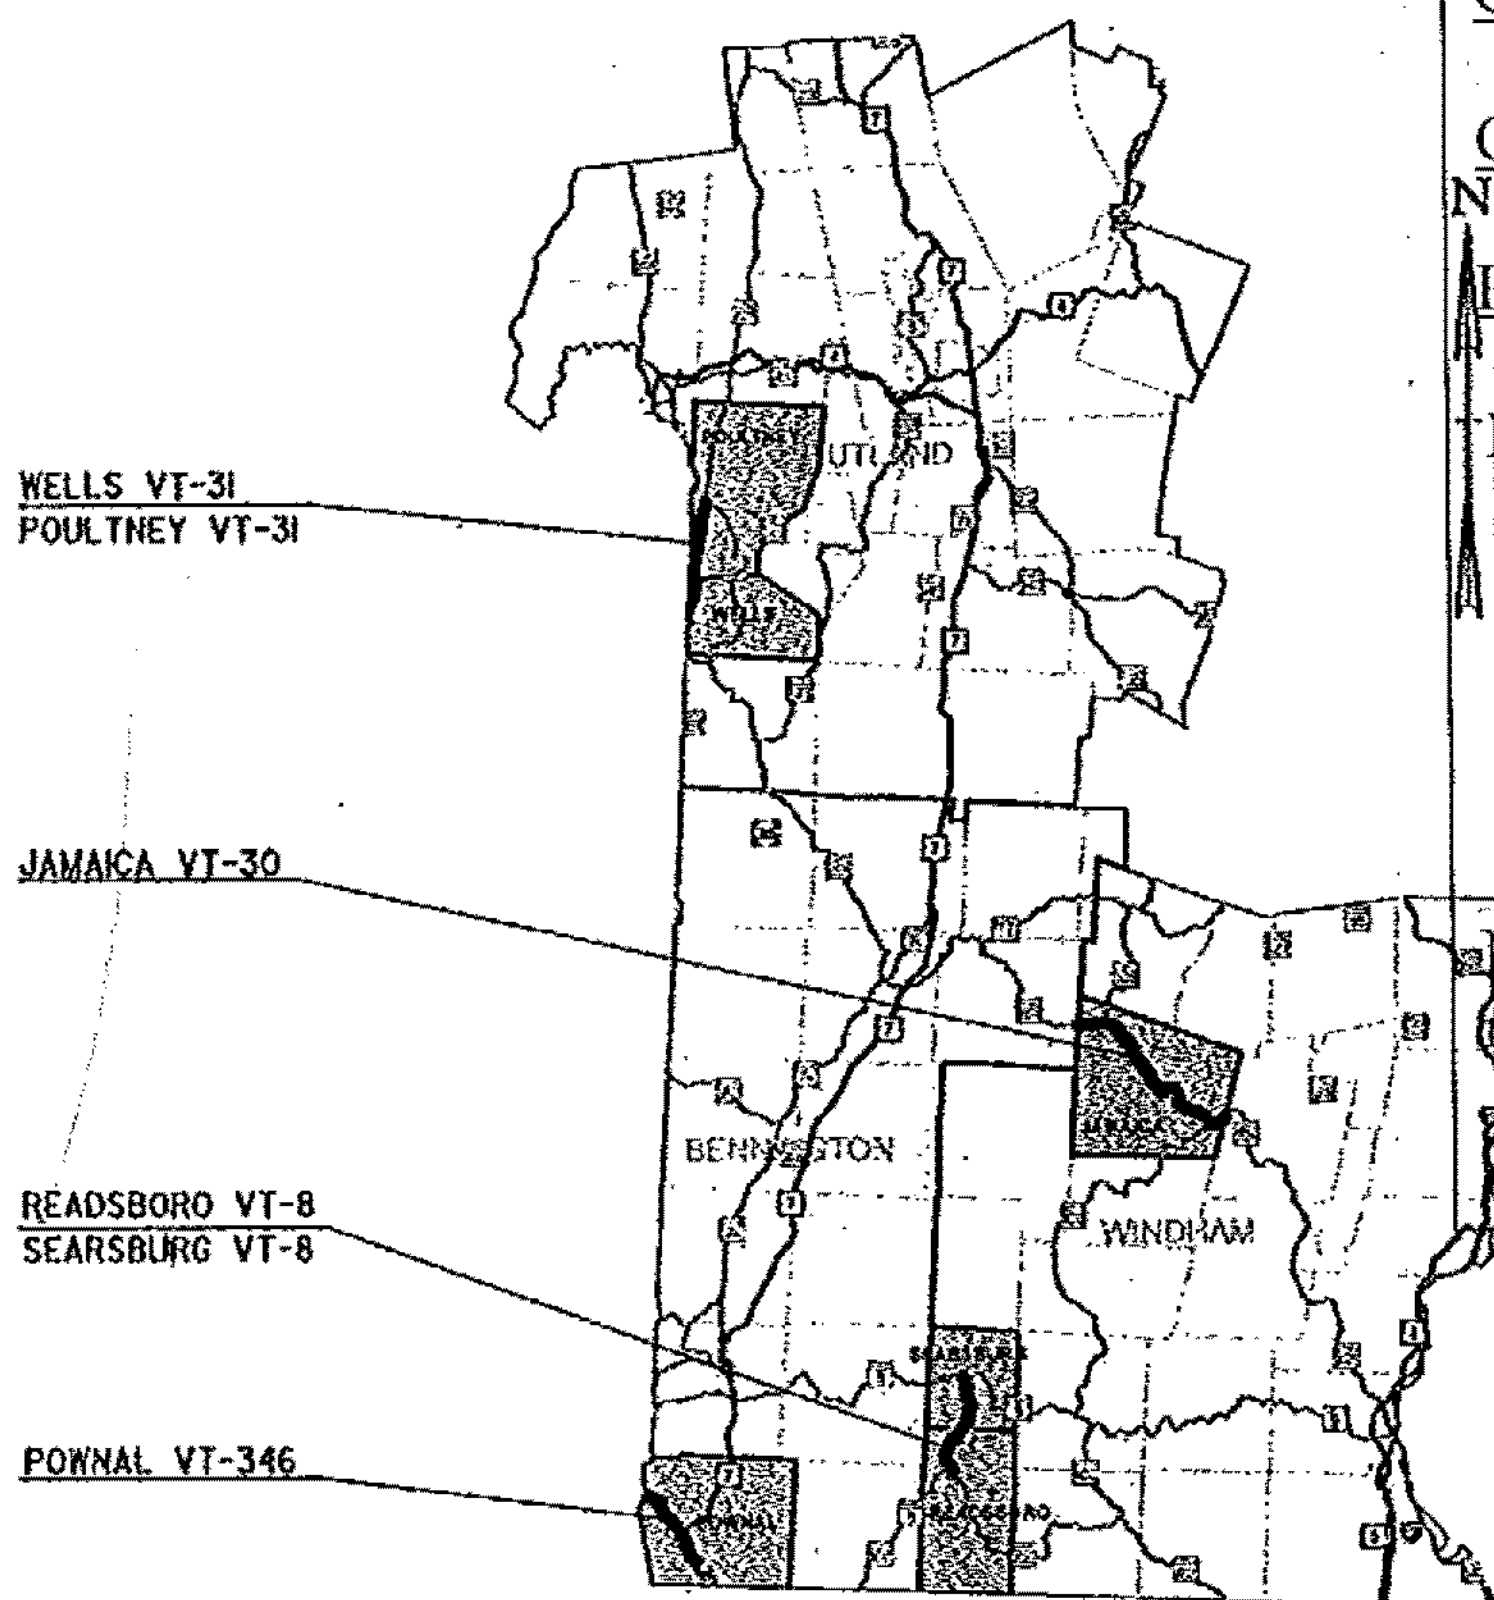

QUALITY ASSURANCE PROGRAM: LEVEL 3

CONVENTIONAL SYMBOLS

COUNTY LINE	
TOWN LINE	
LIMITS OF ACCESS	
POINT OF ACCESS	
FENCE LINE	
STONE WALL	
TRAVELED WAY	
GUARD RAIL	
RAILROAD	
SURVEY LINE	
CULVERT	
POWER POLE	
TELEPHONE POLE	
TREES	
CONTROL OF ACCESS	
PROPERTY LINE	
R.O.W. TAKING LINE	
SLOPE RIGHTS	
TOP OF CUT	
TOE OF SLOPE	

SURVEYED BY : N/A
SURVEYED DATE : N/A

DATUM
VERTICAL : N/A
HORIZONTAL : N/A

THESE PLANS ARE SUBJECT TO SUCH ENGINEERING
CHANGES AS MAY BE REQUIRED BY THE FEDERAL HIGHWAY
ADMINISTRATION OR THE DIRECTOR OF PROGRAM
DEVELOPMENT.

CONSTRUCTION IS TO BE CARRIED ON IN ACCORDANCE
WITH THESE PLANS AND THE STANDARD SPECIFICATIONS
FOR CONSTRUCTION DATED 2014, AS APPROVED BY THE
FEDERAL HIGHWAY ADMINISTRATION ON JULY 20, 2014
FOR USE ON THIS PROJECT, INCLUDING ALL SUBSEQUENT
REVISIONS AND SUCH REVISED SPECIFICATIONS AND
SPECIAL PROVISIONS AS ARE INCORPORATED IN THESE
PLANS.

DIRECTOR OF PROGRAM DEVELOPMENT

APPROVED [Signature] DATE 2-19-13

PROJECT MANAGER : AMY GAURLE

PROJECT NAME : STATEWIDE SW REGION

PROJECT NUMBER : STPG SIGN (41)

SHEET 1 OF 97 SHEETS

INDEX OF SHEETS:

1	TITLE SHEET
2	PROJECT NOTES
3	QUANTITY SHEET I
4-12	SIGN DETAILS
13-15	READSBORO VT-8 NORTHBOUND TRAFFIC SIGN SUMMARY SHEETS
16-19	READSBORO VT-8 SOUTHBOUND TRAFFIC SIGN SUMMARY SHEETS
20-24	SEARSBURG VT-8 NORTHBOUND TRAFFIC SIGN SUMMARY SHEETS
25-28	SEARSBURG VT-8 SOUTHBOUND TRAFFIC SIGN SUMMARY SHEETS
29-42	JAMAICA VT-30 NORTHBOUND TRAFFIC SIGN SUMMARY SHEETS
43-56	JAMAICA VT-30 SOUTHBOUND TRAFFIC SIGN SUMMARY SHEETS
57-60	WELLS VT-31 NORTHBOUND TRAFFIC SIGN SUMMARY SHEETS
61-63	WELLS VT-31 SOUTHBOUND TRAFFIC SIGN SUMMARY SHEETS
64-71	POULTNEY VT-31 NORTHBOUND TRAFFIC SIGN SUMMARY SHEETS
72-77	POULTNEY VT-31 SOUTHBOUND TRAFFIC SIGN SUMMARY SHEETS
78-85	POWNAI VT-346 NORTHBOUND TRAFFIC SIGN SUMMARY SHEETS
86-96	POWNAI VT-346 SOUTHBOUND TRAFFIC SIGN SUMMARY SHEETS
97	TOWN TOTAL SIGN SUMMARY SHEET

STANDARDS:

E-121	STANDARD SIGN PLACEMENT CONVENTIONAL ROAD	08/08/1995
E-136B	STATE ROUTE MARKER SIGN DETAILS	08/08/1995
E-138	MILE MARKER DETAILS STATE AND TOWN HIGHWAYS	05/30/2003
E-164	SQUARE STEEL SIGN POST	06/08/2009

**2-1/2" SOIL BEARING SLIP BASE LOCATIONS
(ITEM 900.620 SPECIAL PROVISION):**

TOWN:	DIRECTION:	MILE POINT:	NO. REQ:	SHEET:
READSBORO	SB	0.086	2	17
SEARSBURG	NB	2.630	2	23
JAMAICA	SB	8.866	2	45
WELLS	NB	0.025	2	57
POWNAI	SB	4.595	2	86

- THE LOCATIONS SHOWN IN THE TABLE ABOVE WILL REQUIRE THAT EACH 2-1/2" SQUARE STEEL SIGN POST, AS SPECIFIED ON THE APPLICABLE SIGN SUMMARY SHEET, BE INSTALLED USING A SOIL BEARING SLIP BASE WITH ANCHOR SLEEVE. AT THESE SPECIFIED LOCATIONS THE 2-1/2" POSTS ARE NOT PROTECTED BY GUARD RAIL OR CURBING, THUS REQUIRING THE USE OF SOIL BEARING SLIP BASES FOR THIS SIZE POST.
- PAYMENT FOR SOIL BEARING SLIP BASE (EACH) WILL BE MADE UNDER CONTRACT ITEM 900.620 SPECIAL PROVISION (SOIL BEARING SLIP BASE) (2-1/2").

TEMPORARY TRAFFIC CONTROL NOTES:

- THE CONTRACTOR SHALL SUBMIT A SITE-SPECIFIC TRAFFIC CONTROL PLAN CONFORMING TO THE MANUAL ON UNIFORM TRAFFIC CONTROL DEVICES (MUTCD), DATED 2009, AND ITS LATEST REVISIONS, TO THE ENGINEER AT THE PRE-CONSTRUCTION MEETING, FOR REVIEW AND APPROVAL BY THE ENGINEER.
- WHEN WORKING IN THE VICINITY OF EXISTING PEDESTRIAN FACILITIES, AMERICAN WITH DISABILITIES ACT (A.D.A.) ACCESSIBLE PEDESTRIAN ACCOMMODATIONS SHALL BE MAINTAINED AT ALL TIMES. PAYMENT SHALL BE INCLUDED IN THE UNIT BID PRICE FOR CONTRACT ITEM 641.0 TRAFFIC CONTROL.
- THE CONTRACTOR SHALL PROVIDE ACCESS THROUGH THE WORK ZONE FOR EMERGENCY VEHICLES AT ALL TIMES.
- THE CONTRACTOR SHALL CONDUCT THE WORK AT ALL TIMES IN SUCH A MANNER AND IN SUCH SEQUENCE SO AS TO ENSURE THE LEAST INTERFERENCE WITH TRAFFIC OCCURS.
- TEMPORARY TRAFFIC CONTROL SIGNS SHALL ONLY BE VISIBLE TO MOTORISTS AT THE TIMES WHEN THE MESSAGE IS PERTINENT, I.E. A "FLAGGER AHEAD" SIGN SHALL ONLY BE VISIBLE TO MOTORISTS WHEN THE FLAGGER IS ACTUALLY PRESENT PERFORMING THEIR DUTIES.
- PAYMENT FOR CONSTRUCTION SIGNING WILL BE MADE UNDER CONTRACT ITEM 641.0 TRAFFIC CONTROL.
- TEMPORARY TRAFFIC CONTROL SIGNS SHALL BE MOVED AS WORK AREA MOVES. AT NO TIME SHALL THE FLAGGER SIGN BE GREATER THAN 1000 FEET IN ADVANCE OF THE FLAGGER STATION.

SIGN DESIGN AND FABRICATION:

- THE MANUAL ON UNIFORM TRAFFIC CONTROL DEVICES (MUTCD) SIGN CODES PROVIDED IN THESE PLANS REFER TO THE 2009 MUTCD. DESIGN DETAILS FOR SIGNS INDICATED ON THE PLANS, AS FOUND IN THE STANDARD HIGHWAY SIGNS AND MARKINGS BOOK (SHSM), SHALL BE PER THE 2004 SHSM AND THE 2012 SUPPLEMENT TO THE 2004 EDITION.
- SIGN SHEETING FOR FLUORESCENT YELLOW (FY) AND FLUORESCENT YELLOW-GREEN (FYG) SHALL BE ASTM D4956 TYPE VII, VIII OR IX. ALL OTHER SIGN SHEETING SHALL BE TYPE III OR IV.
- SHEETING TYPES AND SHEETING FABRICATED BY DIFFERENT MANUFACTURERS SHALL NOT BE MIXED ON A SINGLE SIGN ASSEMBLY. SHEETING COLOR/TYPE SHOULD BE BY THE SAME MANUFACTURER AND SHOULD BE CONSISTENT THROUGHOUT THE PROJECT.
- SIGN BASE MATERIAL FOR ALL STREET NAME SIGNS SHALL BE EITHER 0.125 INCH THICK FLAT SHEET ALUMINUM OR EXTRUDED ALUMINUM WITH A 0.250 INCH THICK FLANGE AND 0.090 INCH MINIMUM WEB THICKNESS.
- UNLESS OTHERWISE NOTED ON THE PLANS, ALL SIGNS SHALL BE FLAT SHEET ALUMINUM WITH THE FOLLOWING MINIMUM THICKNESSES:

SIGN SIZE	12" X 12"		
	18" X 18"		
21" X 15"			
24" X 8"			
24" X 10"			48" X 18"
24" X 12"	36" X 12"	48" X 24"	
24" X 18"	36" X 15"	48" X 30"	
24" X 24"	36" X 18"	48" X 42"	
24" X 30"	36" X 24"	48" X 48"	
30" X 15"	36" X 36"	48" X 60"	
30" X 18"	36" X 42"	72" X 10"	
30" X 30"	36" X 48"	72" X 12"	
30" X 42"	36" X 54"	72" X 20"	
THICKNESS	0.080"	0.100"	0.125"

SIGN POSTS:


- ALL SQUARE STEEL SIGN POSTS SHALL BE INSTALLED IN A NEW ANCHOR. ALL SIGNS INSTALLED IN PAVED OR CONCRETE ISLANDS OR SIDEWALKS SHALL ALSO BE INSTALLED WITH AN 18" SLEEVE. PAYMENT FOR SLEEVE SHALL BE INCIDENTAL TO CONTRACT ITEM 675.341 SQUARE TUBE SIGN POST AND ANCHOR.
- THE 1.75" SQUARE STEEL POSTS SHALL BE 14 GAGE STEEL. THE 2.0" AND 2.5" SQUARE STEEL POSTS SHALL BE 12 GAGE STEEL.
- DIAMOND-SHAPED ADVANCE WARNING SIGNS 36" AND LARGER WILL REQUIRE TWO POSTS. ASSEMBLIES WITH TWO 30" DIAMOND-SHAPED SIGNS WILL REQUIRE TWO POSTS. POST SPACING SHALL BE AS FOLLOWS:
30" SIGN 15'-20"
36" SIGN 18'-24"
48" SIGN 24'-32"

SIGN INSTALLATION:

- THE CONTRACTOR SHALL BE RESPONSIBLE FOR REPAIRING ANY DAMAGE TO PRIVATE OR PUBLIC PROPERTY CAUSED BY THE CONTRACTOR, AT THE CONTRACTOR'S EXPENSE AND AT NO EXPENSE TO THE STATE.
- ALL SIGNS WITHIN THE PROJECT LIMITS ARE TO BE REPLACED, UNLESS OTHERWISE NOTED ON THE PLANS OR AS DIRECTED BY THE ENGINEER. SIGN LOCATIONS AS SHOWN ON THE PLANS ARE APPROXIMATE; EXACT LOCATIONS TO BE DETERMINED IN THE FIELD.
- ALL SIGN PLACEMENT SHALL BE IN CONFORMANCE WITH VAOT STANDARD E-121 STANDARD SIGN PLACEMENT CONVENTIONAL ROADS, UNLESS OTHERWISE NOTED.
- ALL SIGNS, FRAMES, MOUNTING HARDWARE, POSTS, AND ANCHORS FOR ANY SIGN ASSEMBLY SHALL BE REPLACED AT THE SAME TIME. MIXING OF OLD AND NEW SIGNS ON THE SAME ASSEMBLY WILL NOT BE ALLOWED.
- NEW SIGNS, WITH THEIR GREATER NIGHTTIME RETROREFLECTIVITY, CAN OBSCURE OLDER SIGNS MOUNTED IN CLOSE PROXIMITY TO THEM. TO AVOID CONFUSION OF ROAD USERS, WORK SHALL BE COORDINATED SUCH THAT ALL SIGNS ASSOCIATED WITH A CURVE, INTERSECTION OR SPEED LIMIT CHANGE SHALL BE REPLACED ON THE SAME DAY AND NOT LEFT INCOMPLETE OR WITH A MIXTURE OF OLD AND NEW SIGNS WITHIN A GROUP OF ASSOCIATED SIGNS.
- ALL NEW SIGN INSTALLATIONS, IF NEAR A UTILITY POLE, SHALL BE NO CLOSER THAN 10 FEET FROM THE UTILITY POLE.

STREET NAME SIGN INSTALLATION:

- SIDE ROAD STREET NAME SIGNS, COMMONLY INSTALLED PERPENDICULAR TO APPROACHING MAINLINE TRAFFIC, SHALL BE POSITIONED IN SUCH A WAY AS TO ENSURE THE BEST POSSIBLE VISIBILITY TO APPROACHING MAINLINE TRAFFIC FROM EACH DIRECTION. IN MOST CASES, STREET NAME SIGNS MAY BE INSTALLED ABOVE THE SIDE ROAD STOP SIGN. IN CASES WHERE THE SIDE ROAD STOP SIGN POSITION WOULD NOT BE SUITABLE FOR A TOP-MOUNTED STREET NAME SIGN, OR DUE TO OTHER SITE-SPECIFIC CONSTRAINTS, THE STREET NAME SIGN MAY BE INSTALLED INDEPENDENTLY ON EITHER CORNER OF THE INTERSECTION. THE STREET NAME SIGNS SHALL BE INSTALLED A MINIMUM OF SIX FEET FROM THE EDGE OF PAVEMENT ON THE MAINLINE ROUTE TO THE NEAREST EDGE OF THE SIGN.
- STREET NAME SIGNS WITH A LENGTH EXCEEDING 42-INCHES SHALL BE INSTALLED ON TWO POSTS. UNLESS PROTECTED BY BARRIER, THIS TWO POST ASSEMBLY SHALL BE LATERALLY OFFSET A MINIMUM OF TWO FEET (IN THE DIRECTION OF MAINLINE TRAFFIC) FROM ANY OTHER SIGN POST. NO MORE THAN TWO POSTS SHALL OCCUPY AN EIGHT FOOT TRAVEL PATH, UNLESS PROTECTED BY BARRIER.
- TOP-MOUNTED STREET NAME SIGNS SHALL REQUIRE 12-INCH MOUNTING BRACKETS. MOUNTING BRACKET AND ALL MOUNTING HARDWARE IS INCIDENTAL TO PAY ITEM 675.20 (TRAFFIC SIGN, TYPE A).
- IF EXISTING STREET SIGNS ARE SALVAGED THEY SHALL BE RE-INSTALLED PER THE ABOVE NOTES OR AS DIRECTED BY THE ENGINEER.
- STREET NAME SIGNS FOR PRIVATE ROADS SHALL BE RETAINED, UNLESS OTHERWISE NOTED OR AS DIRECTED BY THE ENGINEER.

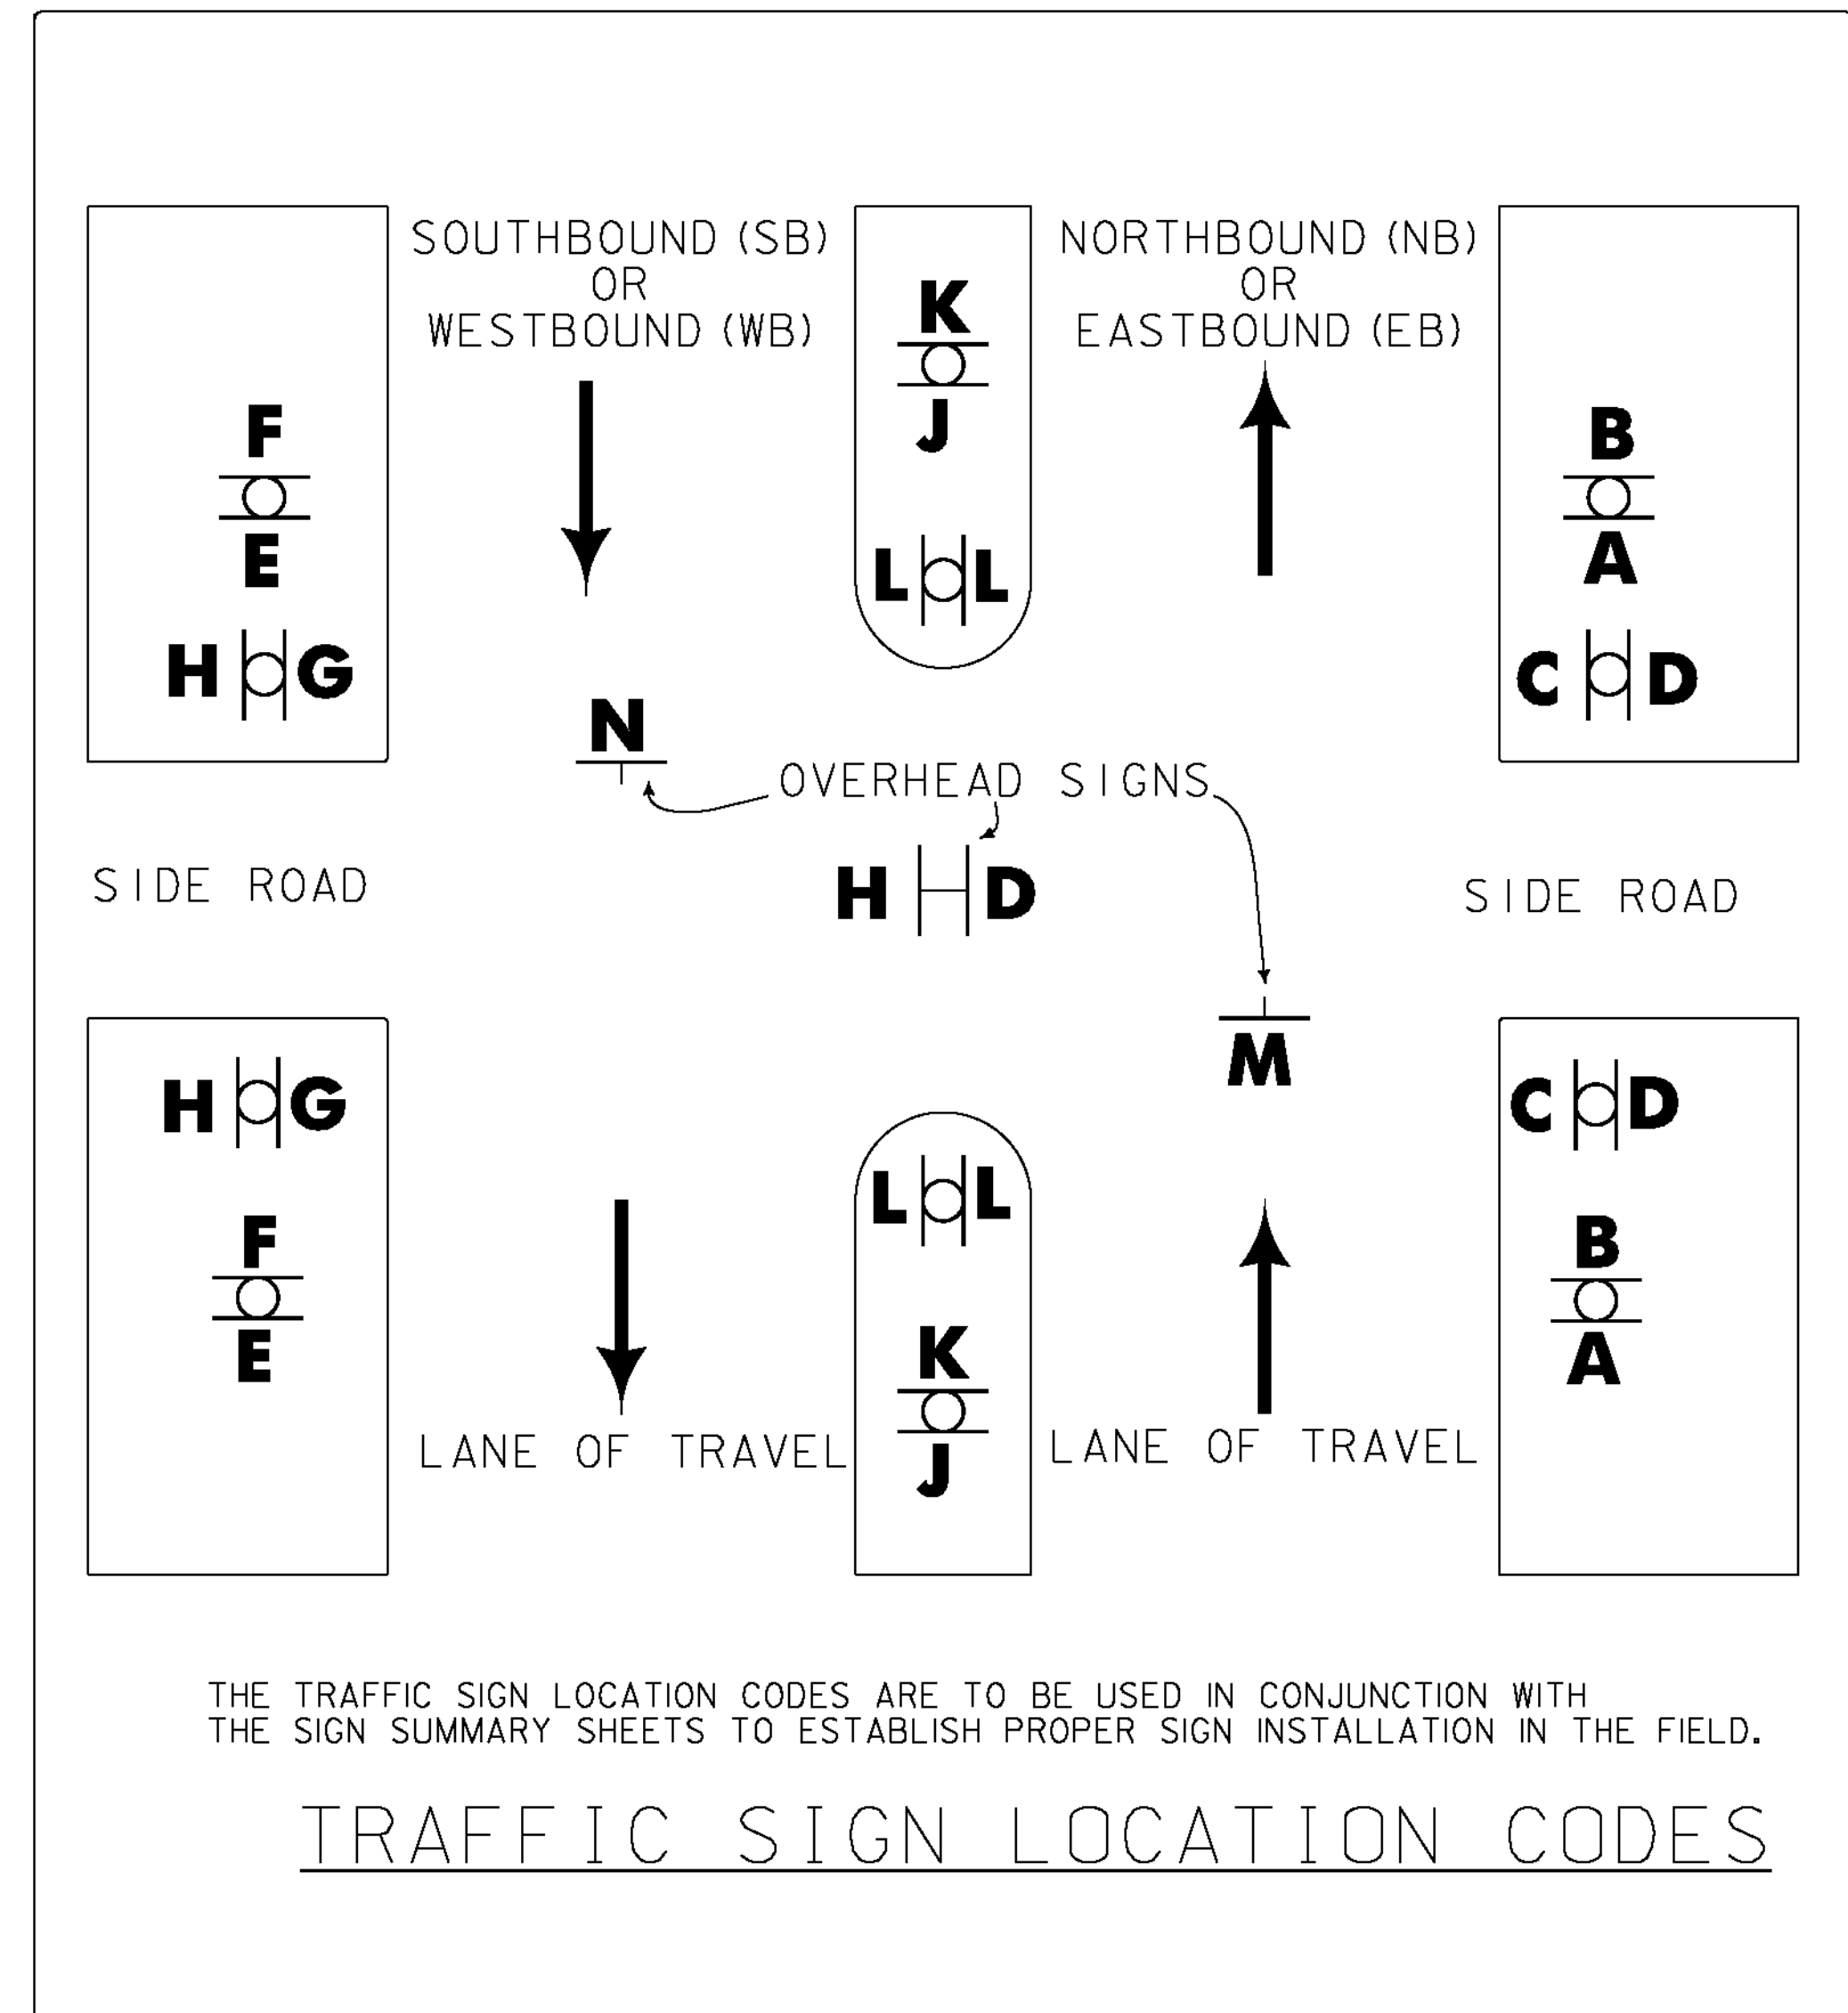

GENERAL NOTES:


- EXISTING STAND-ALONE MILE MARKER SIGNS, OR MILE MARKER SIGNS ATTACHED TO A RETAINED SIGN POST ASSEMBLY, SHALL BE RETAINED.
- EXISTING MILE MARKER SIGNS ON SIGN POSTS BEING REPLACED SHALL BE REMOVED AND SALVAGED ONTO THE NEW SIGN POST, UNLESS OTHERWISE NOTED ON THE APPLICABLE SIGN SUMMARY SHEET OR AS DIRECTED BY THE ENGINEER.
- EXISTING MILE MARKER SIGNS ATTACHED TO A SIGN ASSEMBLY THAT IS TO BE REMOVED OR RELOCATED SHALL BE REMOVED AND DISPOSED OF, UNLESS OTHERWISE NOTED ON THE APPLICABLE SIGN SUMMARY SHEET OR AS DIRECTED BY THE ENGINEER.
- ESTIMATED QUANTITIES OF CONTRACT ITEMS 675.50 REMOVING SIGNS AND 675.60 ERECTING SALVAGED SIGNS HAVE BEEN INCLUDED FOR MILE MARKER AND STREET NAME SIGNS.
- SELECTIVE CUTTING OF BRUSH OR TREE BRANCHES IN THE IMMEDIATE VICINITY OF A SIGN MAY BE NECESSARY TO PROVIDE FULL VISIBILITY FOR ANY EXISTING (RETAINED) OR NEW SIGN LOCATION. THIS WORK WILL BE PERFORMED AT THE DIRECTION OF THE ENGINEER AND PAID FOR UNDER CONTRACT ITEM 201.31 THINNING AND TRIMMING FOR SIGNS. THIS WORK SHALL BE DONE AT THE SAME TIME THE SIGN IS INSTALLED, OR AS DIRECTED BY THE ENGINEER. ALL SIGNS SHALL BE FULLY VISIBLE FROM THE APPROACHING TRAVEL LANE FOR A MINIMUM DISTANCE OF 250 FEET.

PROJECT NAME:	STATEWIDE SW REGION		
PROJECT NUMBER:	STPG SIGN (41)		
FILE NAME:	I2C18_TS.DGN	PLOT DATE:	13-FEB-2013
PROJECT LEADER:	A. GAMBLE	DRAWN BY:	J. KELLY
DESIGNED BY:	J. KELLY	CHECKED BY:	A. GAMBLE
PROJECT NOTES		SHEET	2 OF 97


QUANTITY SHEET 1

SUMMARY OF ESTIMATED QUANTITIES													TOTALS		DESCRIPTIONS				DETAILED SUMMARY OF QUANTITIES		
												ROADWAY	GRAND TOTAL	FINAL	UNIT	ITEMS	ITEM NUMBER	ROUND	QUANTITIES	UNIT	ITEMS
													35	35	EACH	THINNING AND TRIMMING FOR SIGNS	201.31	EST			
													1	1	CY	TRENCH EXCAVATION OF EARTH, EXPLORATORY (N.A.B.I.)	204.22	EST			
													50	50	HR	UNIFORMED TRAFFIC OFFICERS	630.10	EST			
													150	150	HR	FLAGGERS	630.15	EST			
													1	1	LS	MOBILIZATION/DEMobilIZATION	635.11				
													1	1	LS	TRAFFIC CONTROL	641.10				
													2587.3	2587.3	SF	TRAFFIC SIGNS, TYPE A	675.20				
													5010	5010	LF	SQUARE TUBE SIGN POST AND ANCHOR	675.341	EST			
													524	524	EACH	REMOVING SIGNS	675.50	EST			
													6	6	EACH	ERECTING SALVAGED SIGNS	675.60	EST			
													8	8	EACH	DELINEATOR WITH STEEL POST	676.10				
													10	10	EACH	SPECIAL PROVISION (SOIL BEARING SLIP BASE) (2 1/2")	900.620				

PROJECT NAME: STATEWIDE SW REGION
 PROJECT NUMBER: STPG SIGN (4I)
 FILE NAME: I2C118_TS.DGN
 PROJECT LEADER: A. GAMBLE
 DESIGNED BY: J. KELLY
 QUANTITY SHEET 1
 PLOT DATE: 13-FEB-2013
 DRAWN BY: J. KELLY
 CHECKED BY: A. GAMBLE
 SHEET 3 OF 97

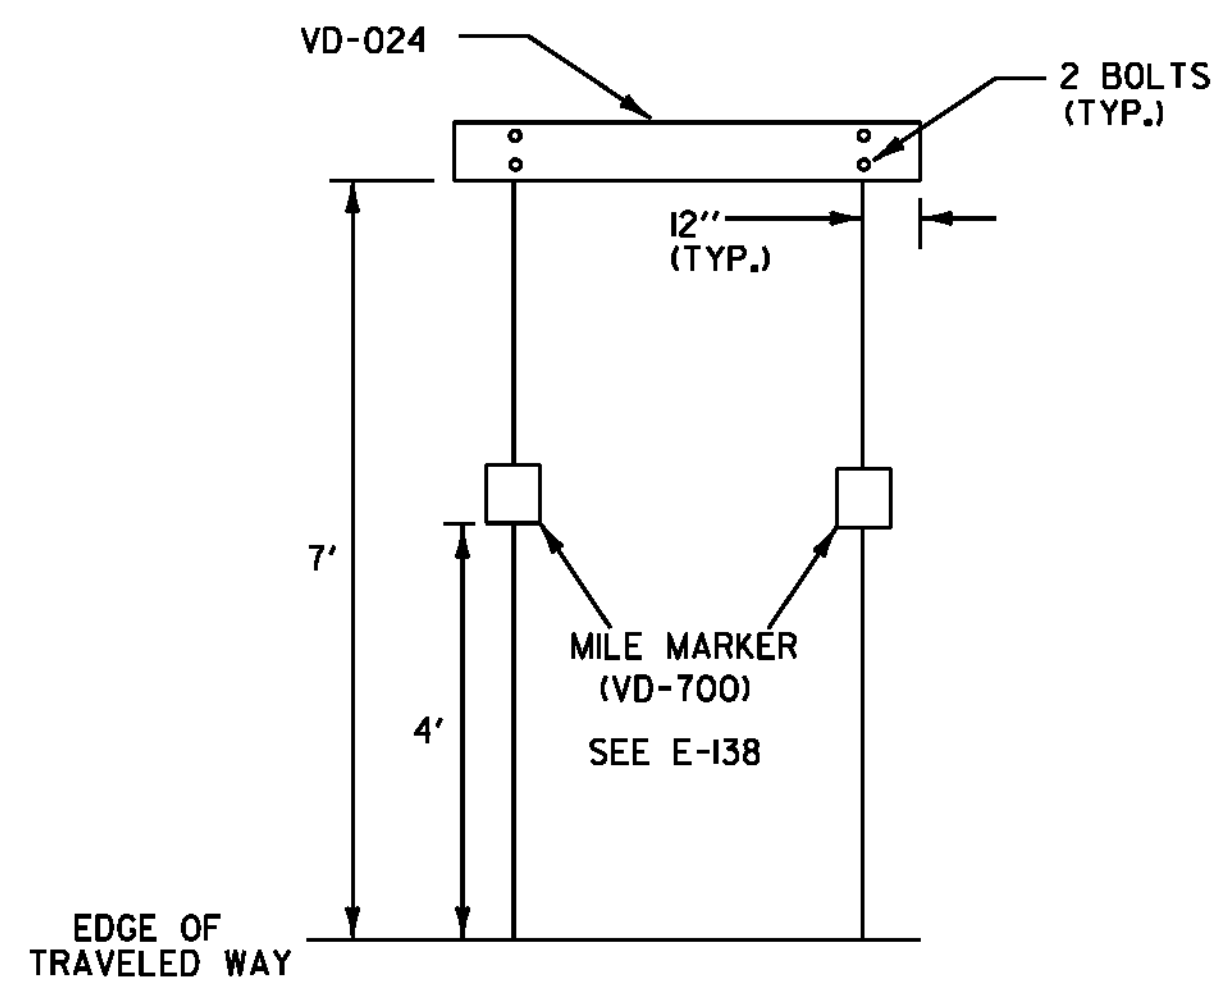


WHEN CROSSING COUNTY BOUNDARIES, AN ADDITIONAL COUNTY LINE SIGN (VD-025) SHALL BE MOUNTED BELOW THE TOWN LINE SIGN (VD-024), MAINTAINING A SEVEN FOOT CLEARANCE.

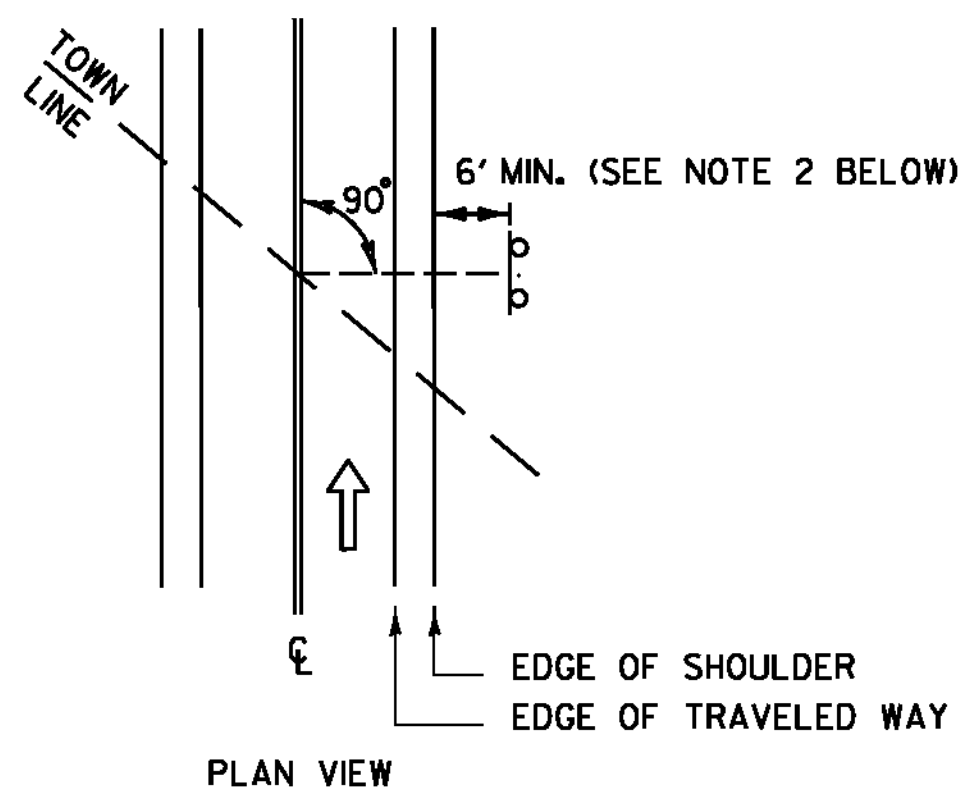


TOWN /COUNTY LINE (VD-024 /VD-025) INSTALLATION:

1. THE SIGN SHALL BE MOUNTED PARALLEL WITH THE ROADWAY, NORMALLY ON THE RIGHT SIDE TRAVELING WEST TO EAST OR SOUTH TO NORTH.
2. FOR POST-MOUNTED SIGNS, THE MINIMUM LATERAL OFFSET SHOULD BE TWELVE FEET FROM THE EDGE OF THE TRAVELED WAY. IF A SHOULDER WIDER THAN SIX FEET EXISTS, THE MINIMUM LATERAL OFFSET FOR POST-MOUNTED SIGNS SHOULD BE SIX FEET FROM THE EDGE OF SHOULDER.

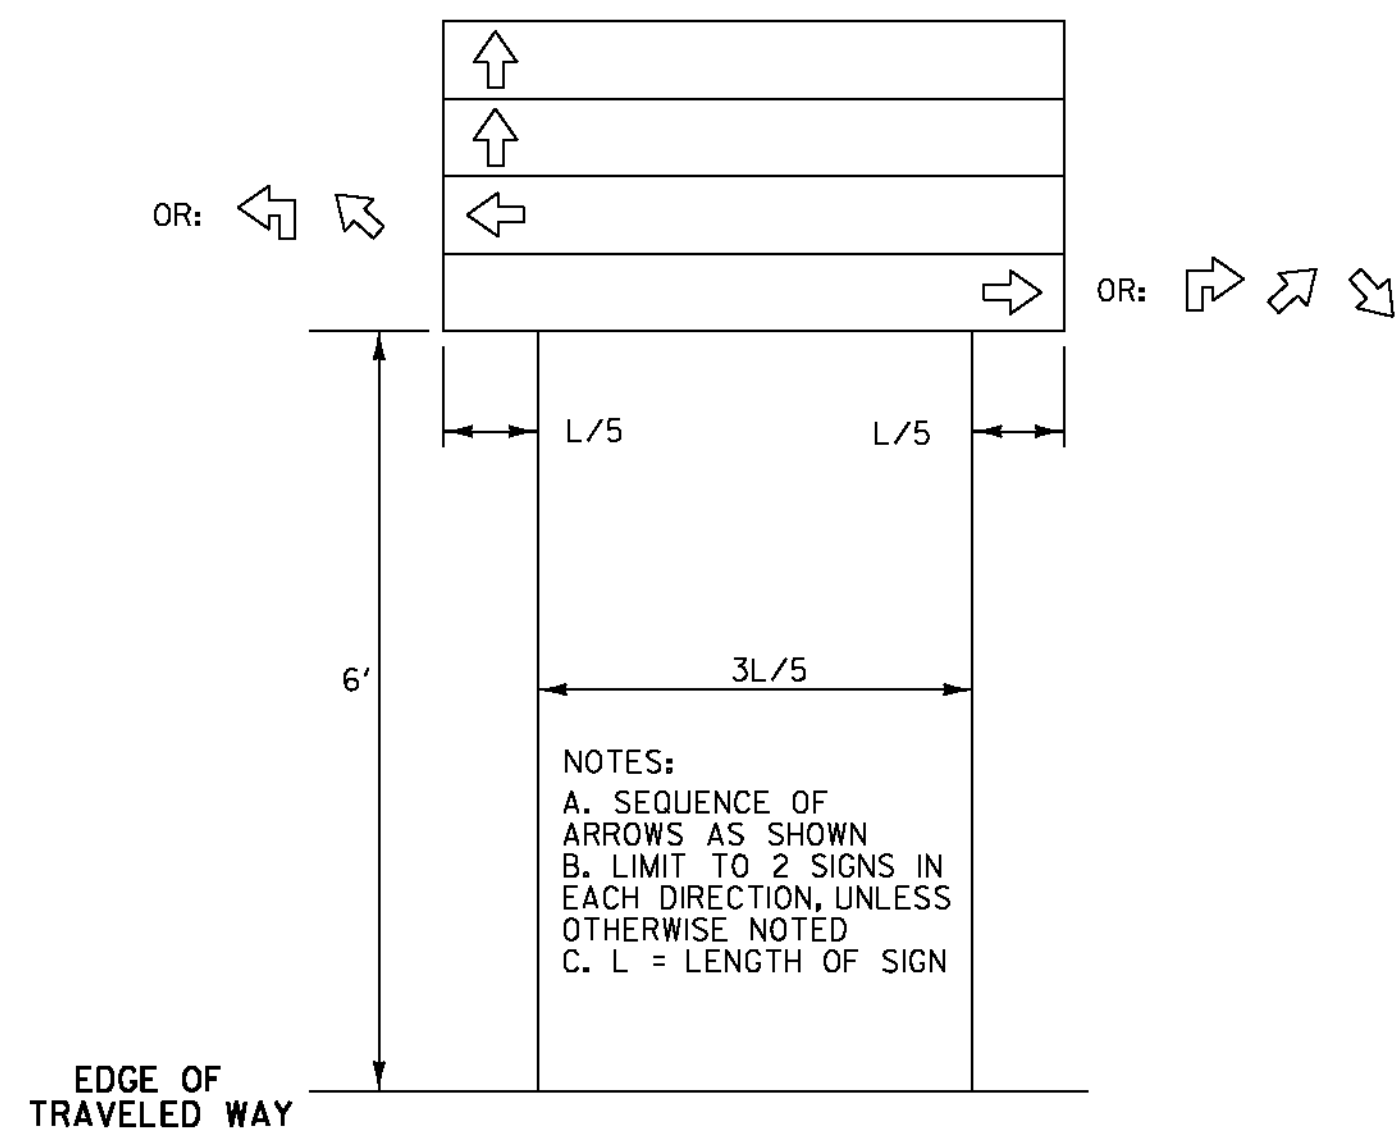


DESTINATION SIGNS (VD1-1, VD1-1A, VD1-2, VD2-1) ASSEMBLY:


1. THE DESTINATION SIGN DETAILS SHOWN ON SHEETS 9 AND 10 SHALL HAVE WHITE RETROREFLECTIVE ASTM D 4956 TYPE III OR IV TEXT, ARROWS AND BORDERS ON A GREEN RETROREFLECTIVE ASTM D 4956 TYPE III OR IV BACKGROUND.
2. FONT SPACING SHOWN ON AN INDIVIDUAL SIGN DETAIL MAY BE ADJUSTED SLIGHTLY TO MEET DIMENSION REQUIREMENT(S).
3. DIMENSIONS SHOWN ON THE INDIVIDUAL SIGN DETAILS MAY BE ADJUSTED SLIGHTLY TO ACCOMMODATE VARIOUS MANUFACTURER'S LETTER WIDTHS.

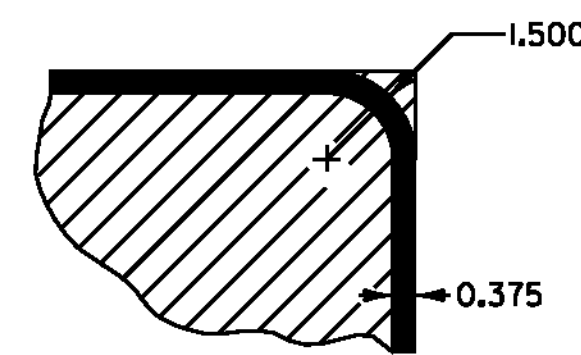


BORDER DETAIL
NOTE: TRIM CORNERS FOR ALUMINUM SIGNS

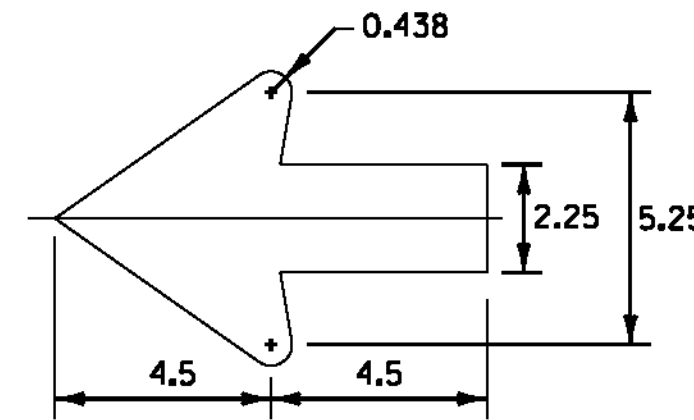

STANDARD SHSM 2.25" ARROW

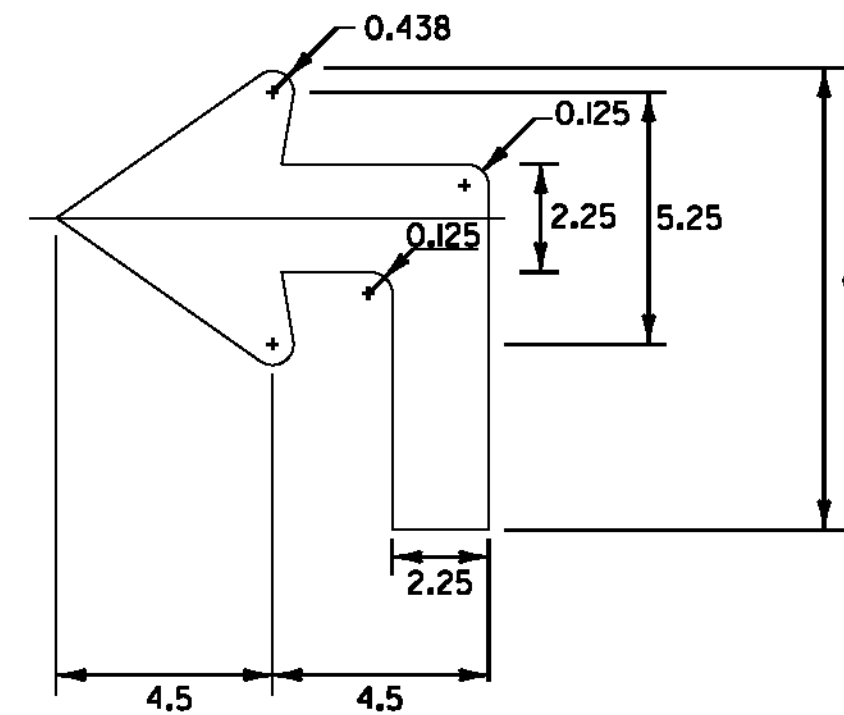


ADVANCE 2.25" ARROW

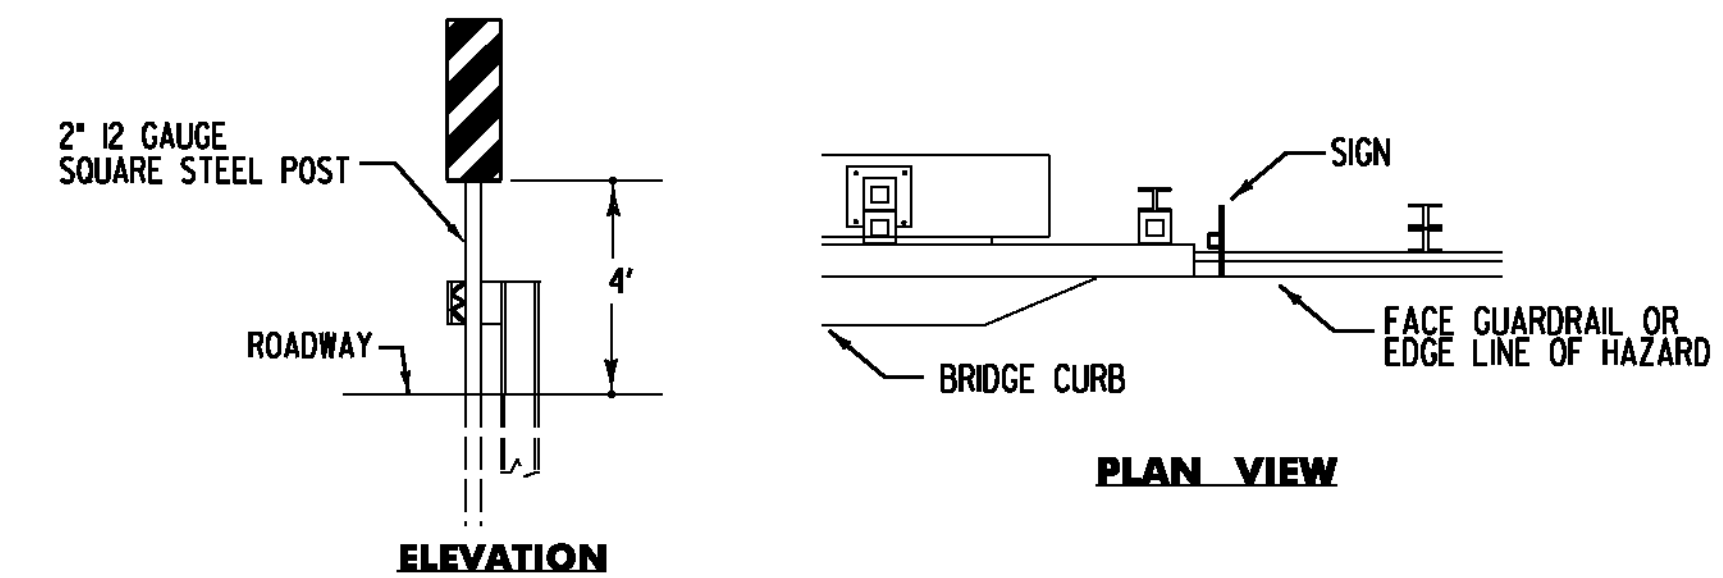


OBJECT MARKER (OM3-L or OM3-R) INSTALLATION:

1. OBJECT MARKER SHOULD BE INSTALLED SO THAT THE INSIDE EDGE OF THE SIGN IS AS CLOSE AS POSSIBLE TO THE FACE OF GUARDRAIL OR INSIDE EDGE OF THE HAZARD.
2. THE SIGN SHALL BE MOUNTED SO THE DIAGONAL STRIPES SLOPE DOWNWARDS TOWARD THE ROAD CENTERLINE.
3. ASSEMBLY HARDWARE SHALL CONFORM TO SUBSECTION 750.12 (a). RIVETS SHALL NOT BE USED.
4. SIGN BASE MATERIAL SHALL BE 0.100" FLAT SHEET ALUMINUM.
5. MOUNTING HARDWARE FOR SIGNS ATTACHED TO ABUTMENTS OR HAZARDS SHALL BE APPROVED BY THE ENGINEER.
6. PAYMENT FOR ALL MATERIALS AND LABOR NECESSARY TO ATTACH AN OBJECT MARKER SIGN TO ANYTHING OTHER THAN A SIGN POST WILL BE PAID FOR AS ONE 15 FT LONG 2.0" SQUARE STEEL SIGN POST.

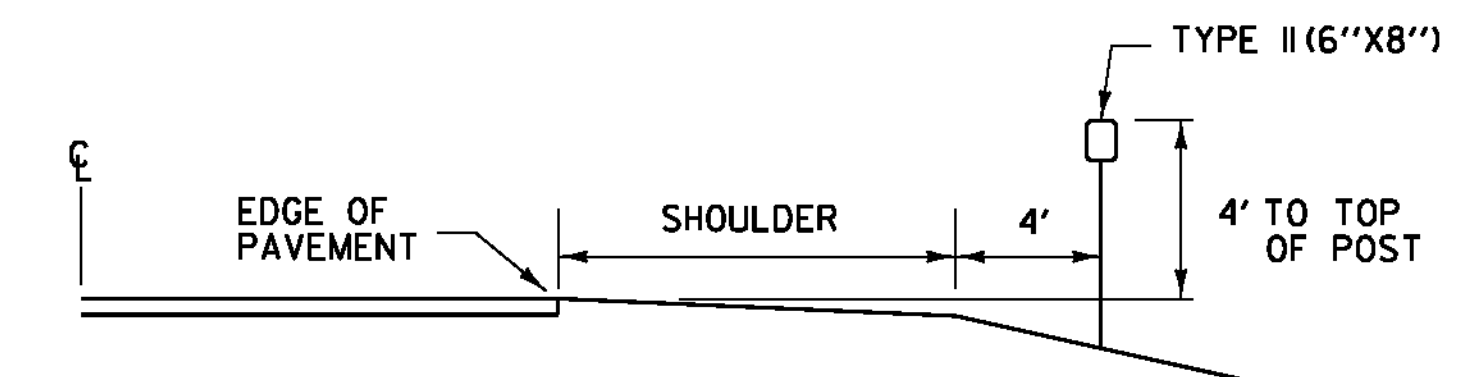

DELINEATOR PLACEMENT

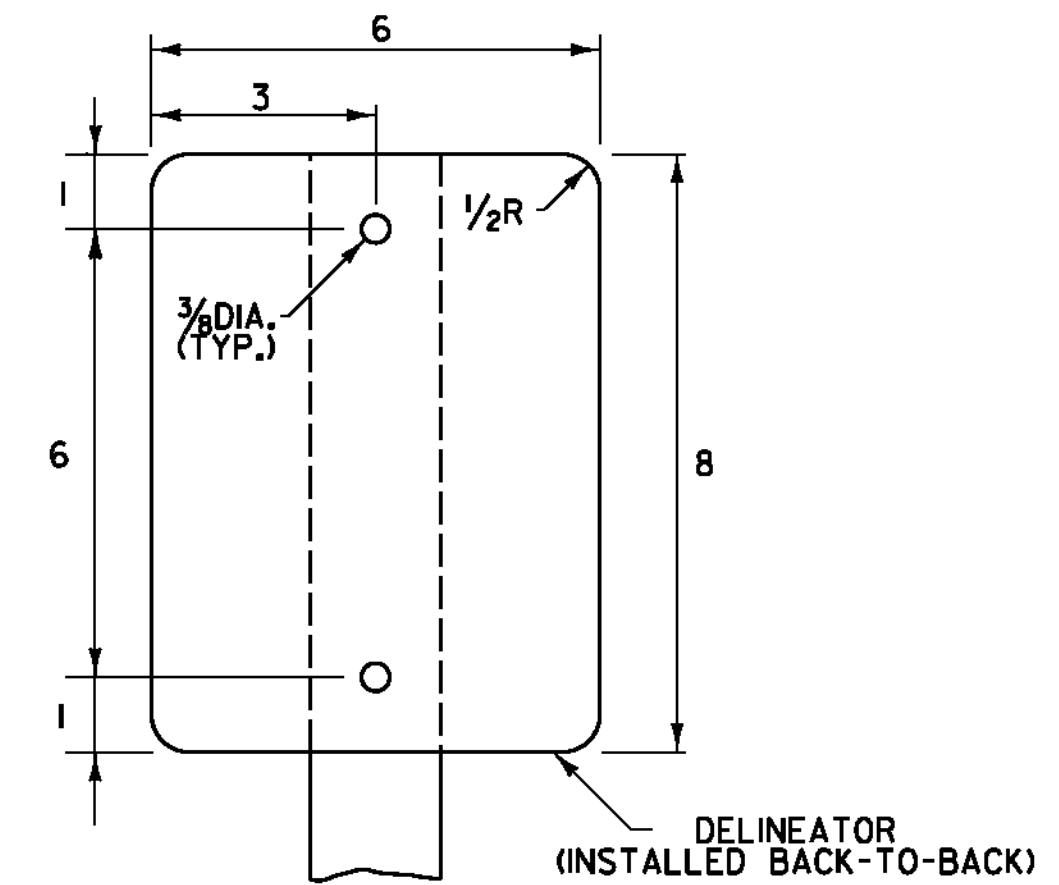

TYPE II (6"x8") DELINEATOR

ALL DIMENSIONS SHOWN IN INCHES, EXCEPT WHERE NOTED.

DELINEATOR LOCATIONS:

TOWN:	DIRECTION:	MILE POINT:	NO. OF NEW TYPE II DELINEATORS (POSTS):	NO. OF REMOVALS:	POST SPACING:	SHEET:
POULTNEY	SB	1.14 - 1.07	16 (8)	(NONE)	50 FT	75


DELINEATORS WITH RETROREFLECTIVE SHEETING:

1. MATERIAL FOR A TYPE II (6"x8") DELINEATOR PANELS SHALL BE A 0.063" ALUMINUM BACKING WITH WHITE ASTM D 4956 TYPE III OR IV RETROREFLECTIVE SHEETING APPLIED TO ONE SIDE.
2. ALL TYPE II (6"x8") DELINEATOR POSTS SHALL BE 1.75" SQUARE STEEL, 1.88 LB/FT (14 GAUGE) WITH A 12 GAUGE ANCHOR, ANCHOR REVEAL OF 2" MAXIMUM ABOVE GRADE.
3. DELINEATOR POSTS SHALL HAVE A MINIMUM EMBEDMENT OF 2'-6" IN THE GROUND.
4. A DELINEATOR ASSEMBLY SHALL CONSIST OF A SINGLE POST AND ANCHOR WITH TWO TYPE II RETROREFLECTIVE PANELS AND ASSOCIATED ASSEMBLY HARDWARE.
5. ALL WORK ASSOCIATED WITH INSTALLING NEW TYPE II (6"x8") DELINEATORS SHALL BE PAID FOR UNDER ITEM 676.10 DELINEATOR WITH STEEL POST.

NOT TO SCALE

PROJECT NAME:	STATEWIDE SW REGION
PROJECT NUMBER:	STPG SIGN (4)
FILE NAME:	I2CI18.SD.1
PROJECT LEADER:	A. GAMBLE
DESIGNED BY:	J. KELLY
SIGN DETAILS I	
PLOT DATE:	13-FEB-2013
DRAWN BY:	J. KELLY
CHECKED BY:	A. GAMBLE
SHEET	4 OF 97


ROUTE MARKER ASSEMBLY FRAMES

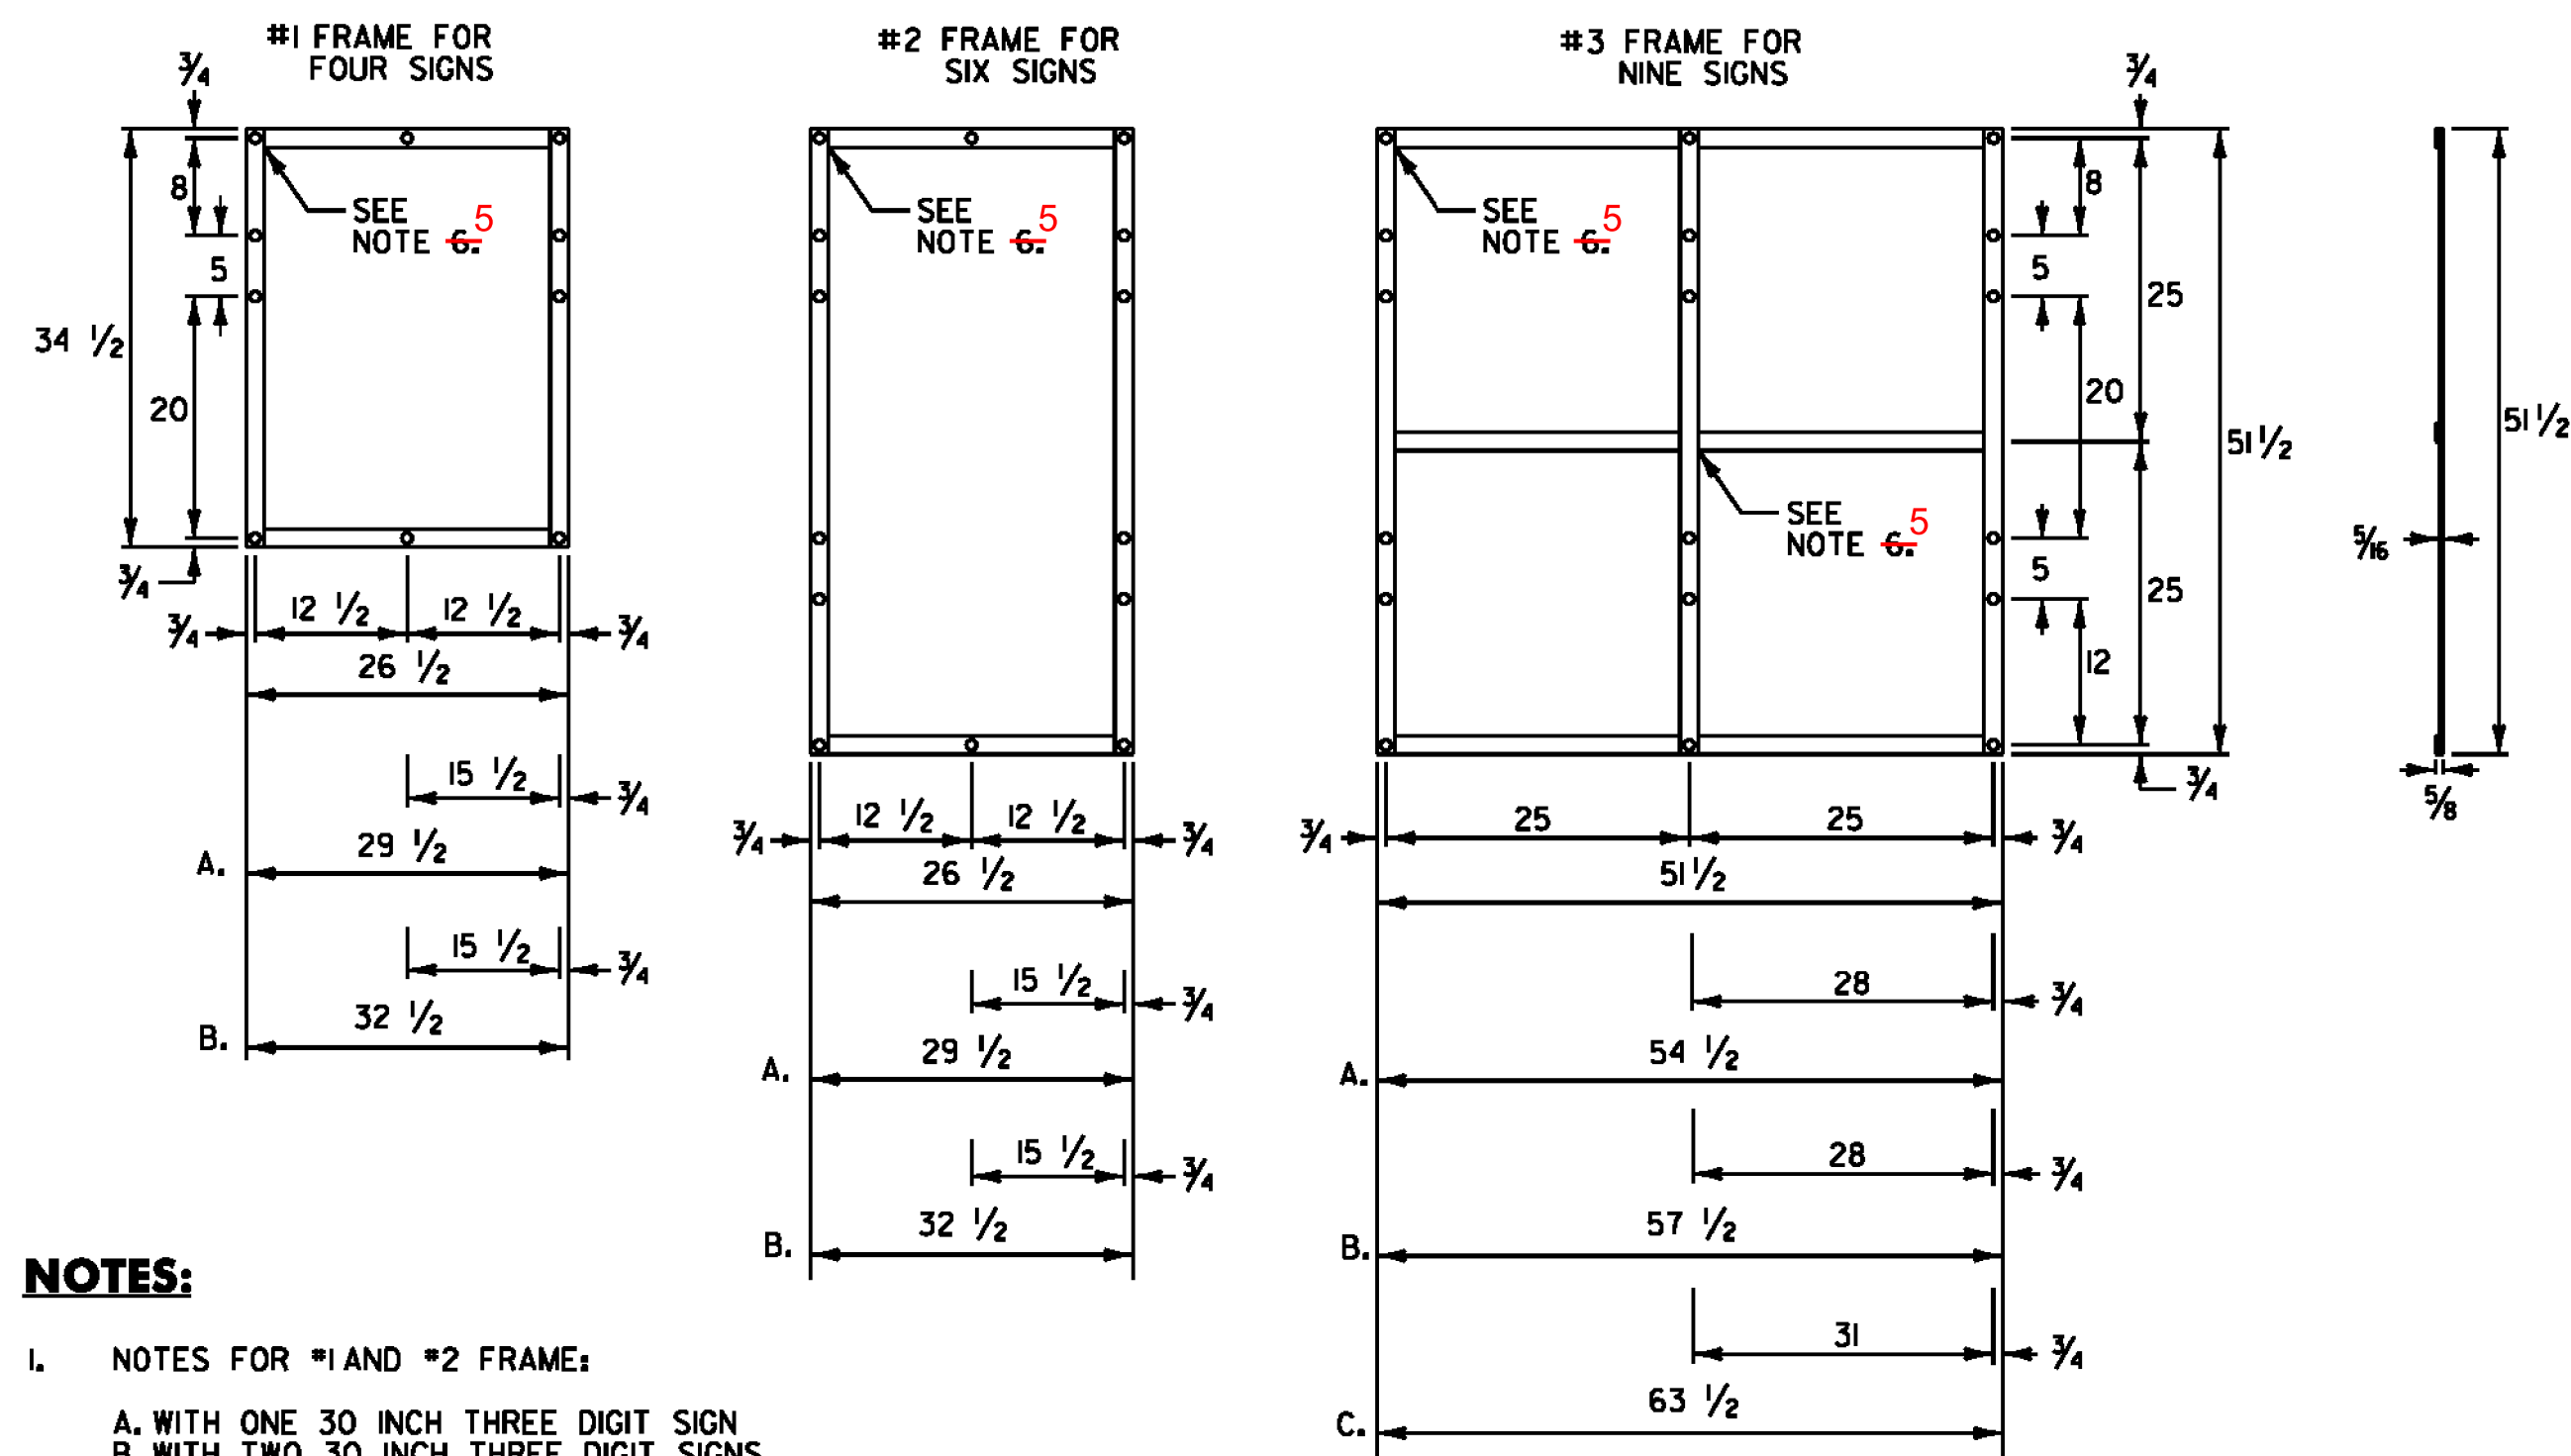

NOTES:

- NOTES FOR #1 AND #2 FRAME:
 - A. WITH ONE 30 INCH THREE DIGIT SIGN
 - B. WITH TWO 30 INCH THREE DIGIT SIGNS
- NOTES FOR #3 FRAME:
 - A. WITH ONE 30 INCH THREE DIGIT SIGN IN AN OUTSIDE POSITION.
 - B. WITH ONE 30 INCH THREE DIGIT SIGN IN THE CENTER POSITION OR TWO SUCH SIGNS IN THE OUTSIDE POSITIONS.
 - C. WITH THREE 30 INCH THREE DIGIT SIGNS.
- ALL HOLES SHALL BE 7/16 INCH DIAMETER. FOR OTHER SIGN COMBINATIONS THAN ABOVE, THE FRAME DIMENSIONS AND HOLE SPACING SHALL BE MODIFIED AS NECESSARY. THE FRAME SHALL BE PAINTED WITH ONE COAT OF PRIMER AND A SECOND COAT OF BLACK PAINT. THE PAINT SHALL BE OF THE TYPE USED ON EXTERIOR METAL SURFACES TO PREVENT METAL CORROSION.
- FRAMES SHALL BE CONSTRUCTED OF 5/16 INCH x 1 1/2 INCH A-36 STEEL.
- ALL OVERLAPPED CONNECTIONS SHALL BE WELDED WITH TWO 1/4 INCH WIDE FILLET WELDS, 1 1/2 INCHES LONG.

STANDARD MOUNTING OF ROUTE MARKER ASSEMBLIES

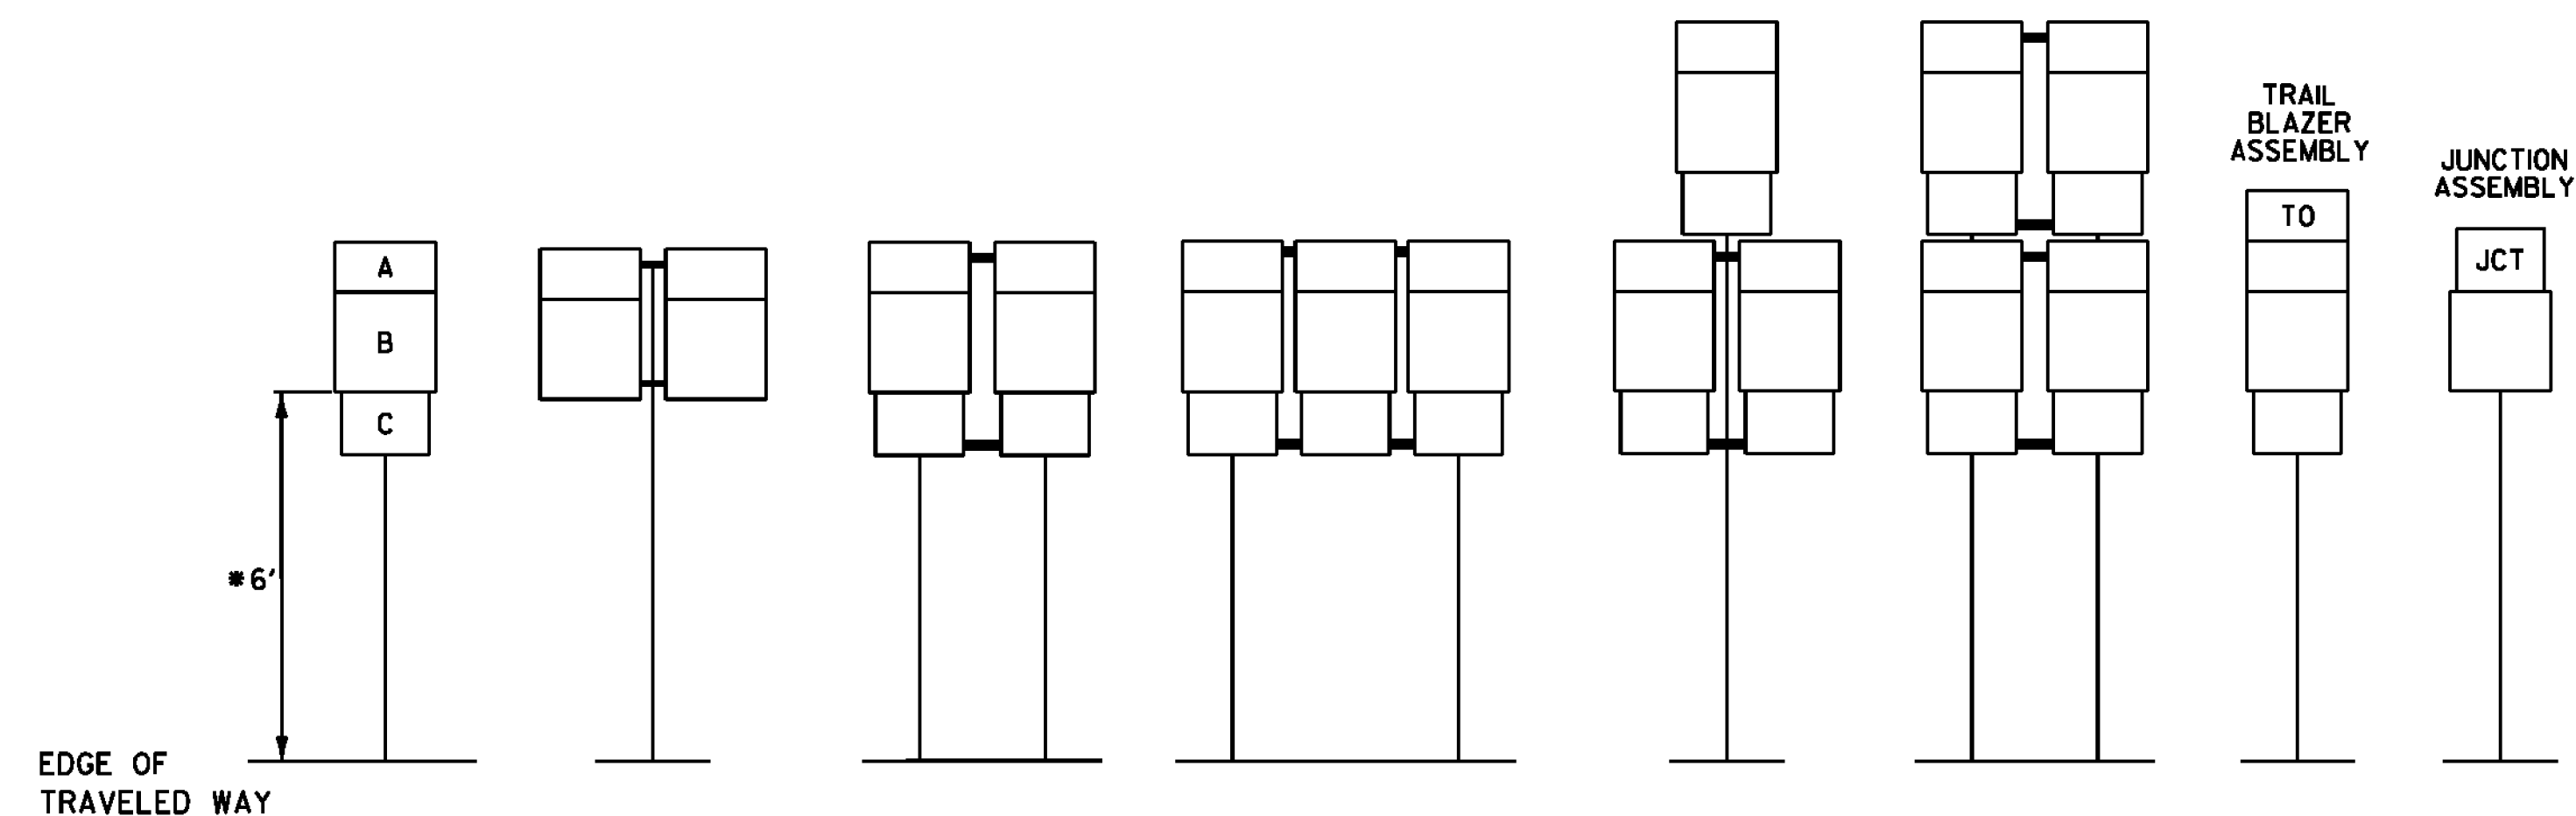









INSTALLATION SEQUENCE:

IN MULTIPLE HORIZONTAL MOUNTINGS, PLACE A ROUTE MARKER ASSEMBLY INDICATING A LEFT TURN ON THE LEFT SIDE OF THE ASSEMBLY; RIGHT TURN ON THE RIGHT SIDE. FOR VERTICALLY STACKED MOUNTINGS, PLACE THE STRAIGHT THROUGH MOVE INDICATION ON TOP, THE LEFT OR RIGHT TURNS AS APPROPRIATE BENEATH.


* WHERE PARKING OR PEDESTRIAN TRAFFIC WILL OCCUR IN THE IMMEDIATE VICINITY OF THESE SIGNS, MINIMUM VERTICAL CLEARANCE SHALL BE INCREASED TO SEVEN FEET.

NOTE:

VERTICAL FRAME MEMBERS SHALL LINE UP WITH SIGN POST ON WHICH THEY ARE MOUNTED.

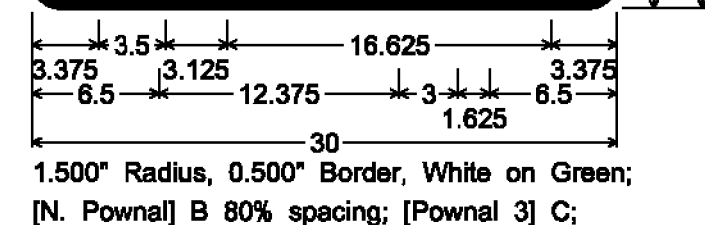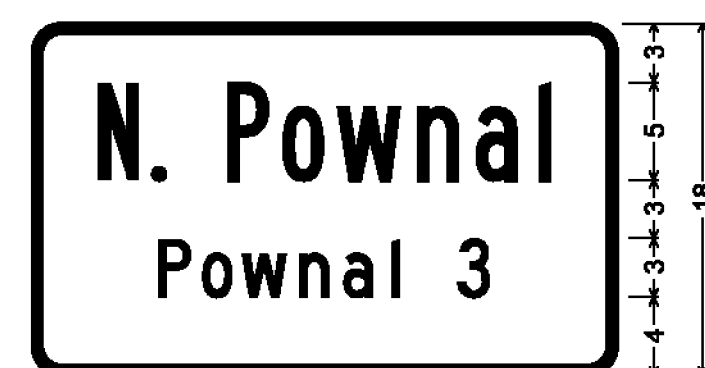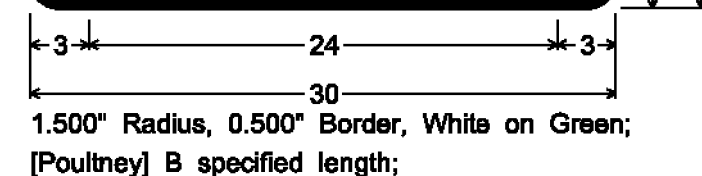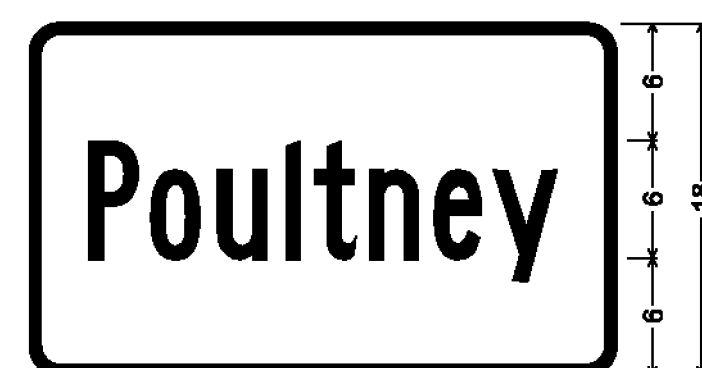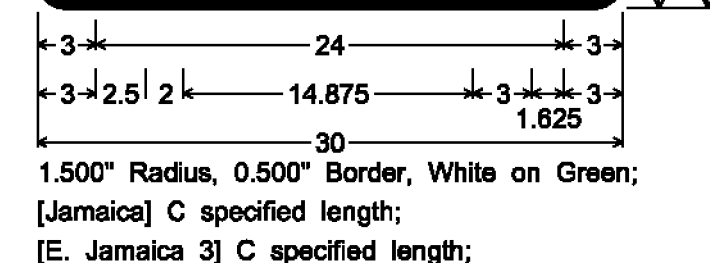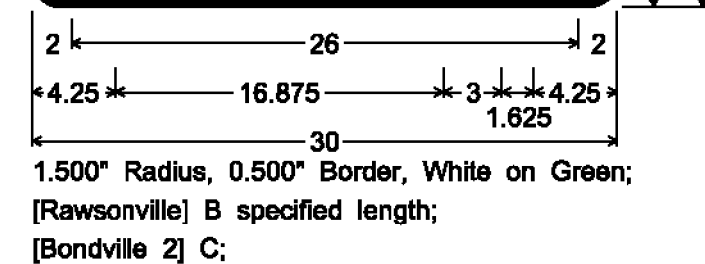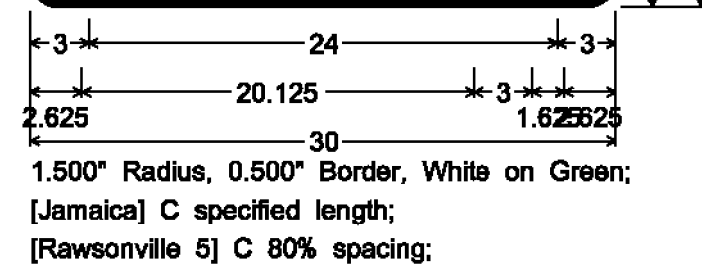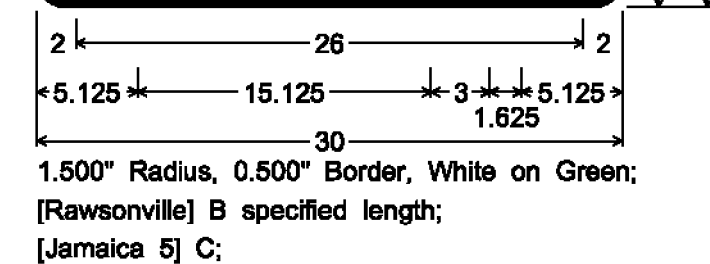

ALL SIGNS IN THIS SECTION ARE SIGN CODE VD-018

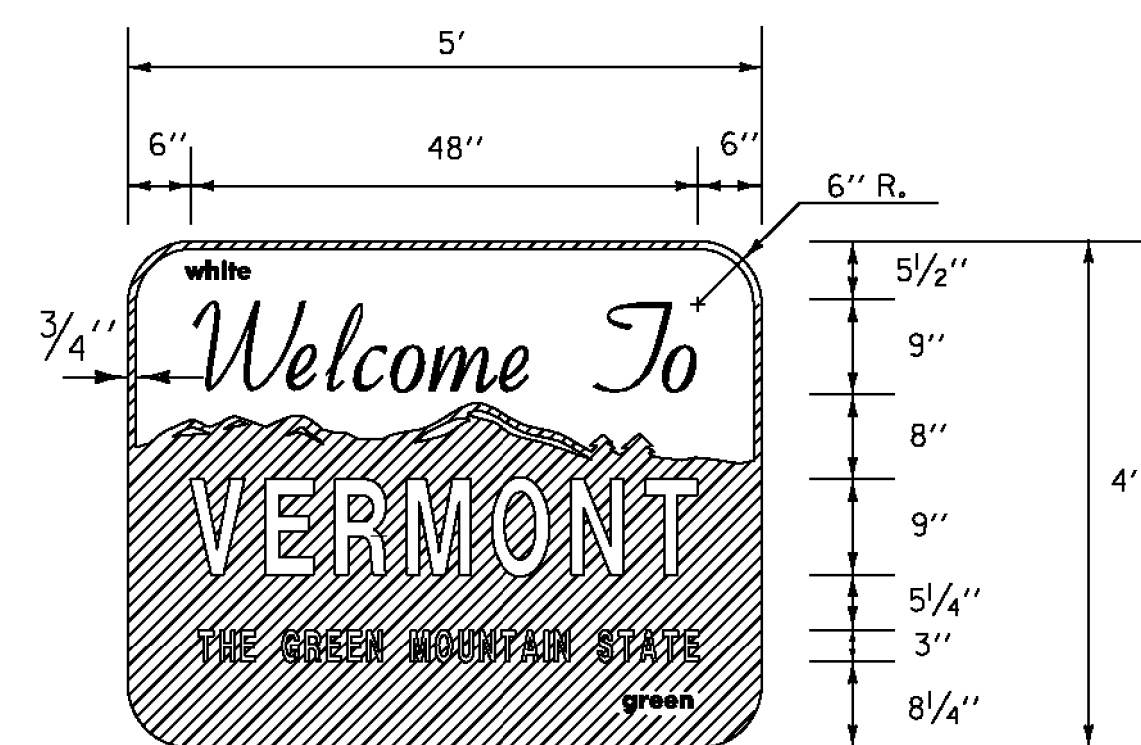

NOTE:

FOR THE WORDS "WELCOME TO" USE GERBER FONT MURRAY HILL BOLD OR EQUIVALENT. TEXT COLOR IS GREEN. ALL OTHER TEXT USE GERBER FONT SOUVENIR DEMIBOLD OR EQUIVALENT. TEXT COLOR IS WHITE. ALL SHEETING SHALL BE MIN. ASTM D 4956 TYPE III RETROREFLECTIVE.

MATERIALS:

THE SIGN BASE MATERIAL USED FOR THIS SIGN SHALL BE FLAT SHEET ALUMINUM 0.125" MIN.



ALL DIMENSIONS SHOWN IN INCHES, UNLESS OTHERWISE NOTED.


PROJECT NAME: STATEWIDE SW REGION

PROJECT NUMBER: STPG SIGN (41)


FILE NAME: I2C118.SD_2
 PROJECT LEADER: A. GAMBLE
 DESIGNED BY: J. KELLY
 SIGN DETAILS 2

PLOT DATE: 13-FEB-2013
 DRAWN BY: J. KELLY
 CHECKED BY: A. GAMBLE
 SHEET 5 OF 97


NOT TO SCALE

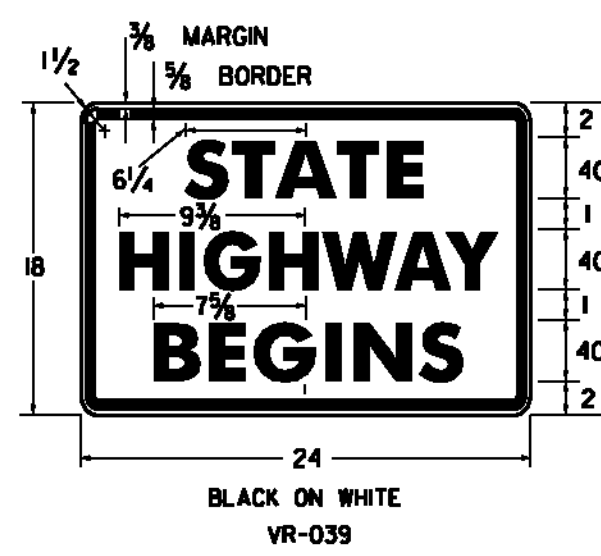


BLACK ON WHITE
VR-039

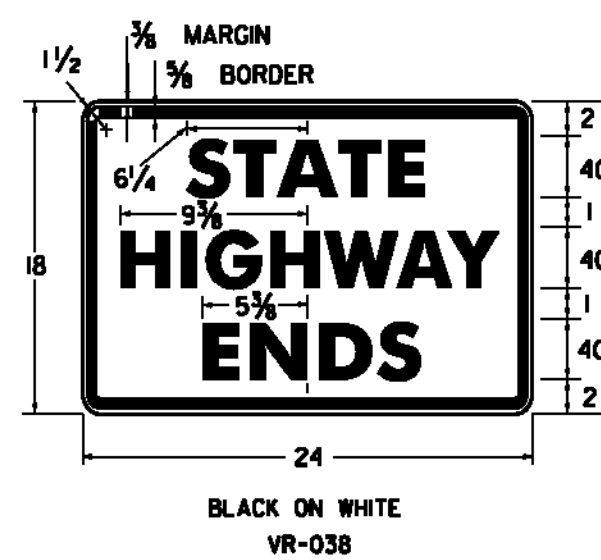


BLACK ON WHITE
VR-038

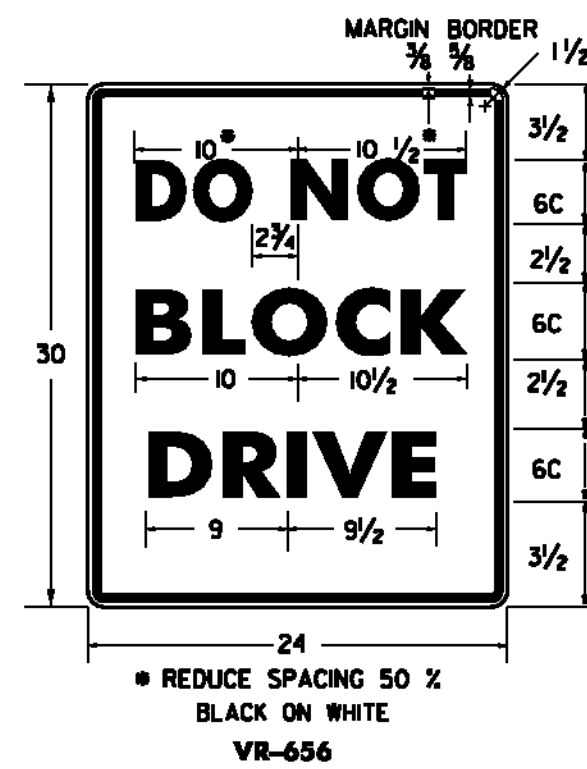


• REDUCE SPACING 50%
BLACK ON WHITE
VR-656

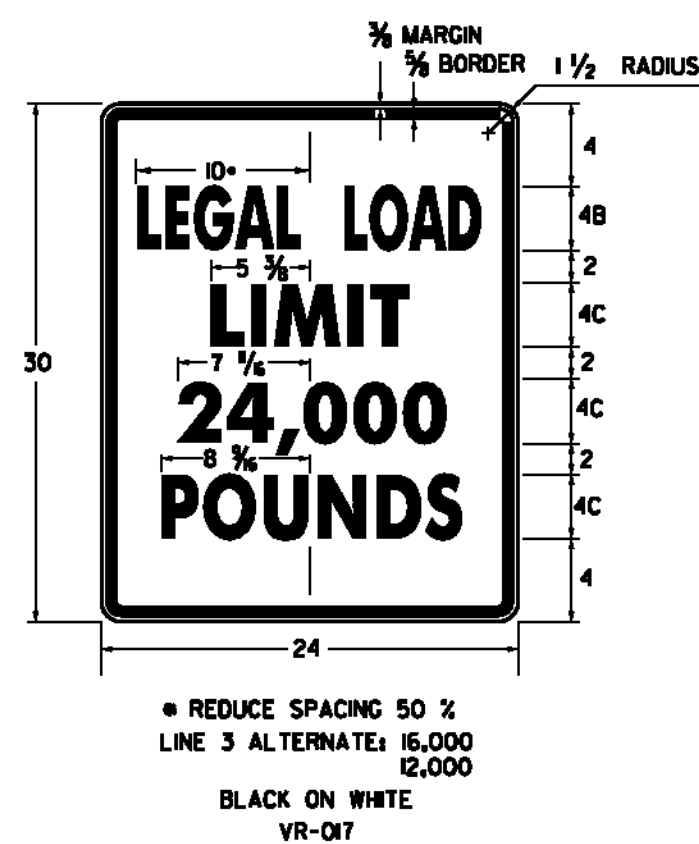


• REDUCE SPACING 50%
LINE 3 ALTERNATE: 16,000
12,000
BLACK ON WHITE
VR-07

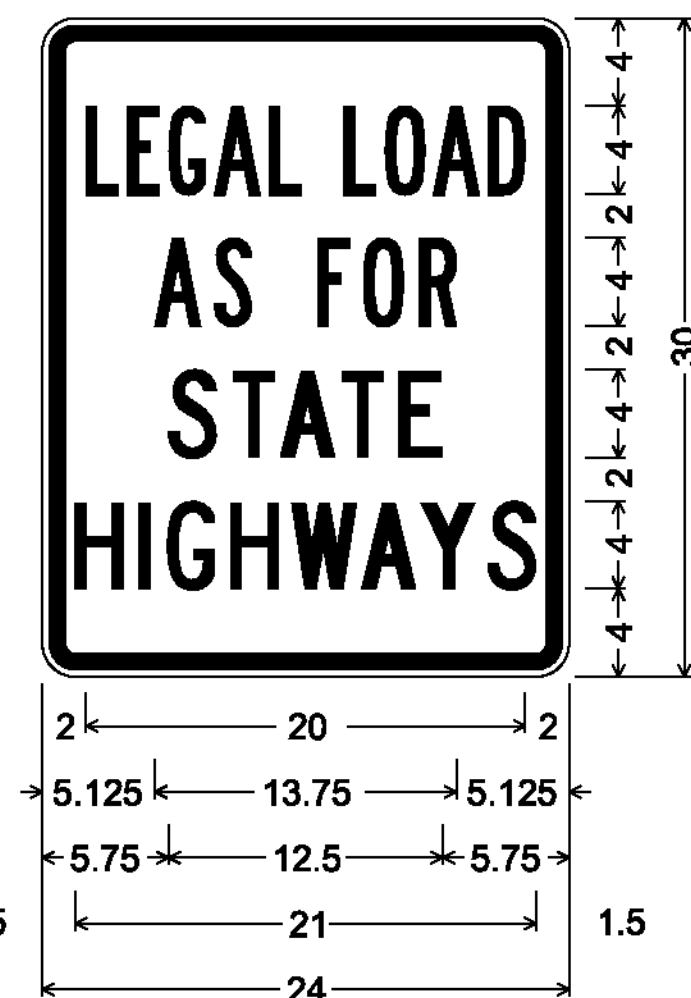


VR-079;
1.500" Radius, 0.625" Border, 0.375" Indent,
Black on White;
[LEGAL LOAD] B specified length;
[AS FOR] B;
[STATE] C specified length;
[HIGHWAYS] C specified length;

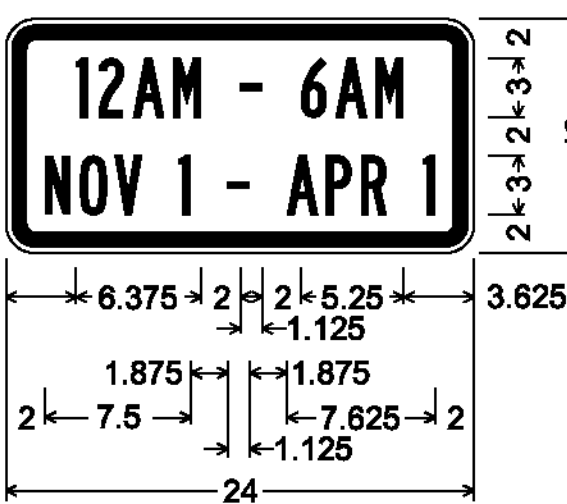

VR-122;
1.500" Radius, 0.625" Border, 0.375" Indent, Black on White;
[12AM - 6AM] B;
[NOV 1 - APR 1] B specified length;

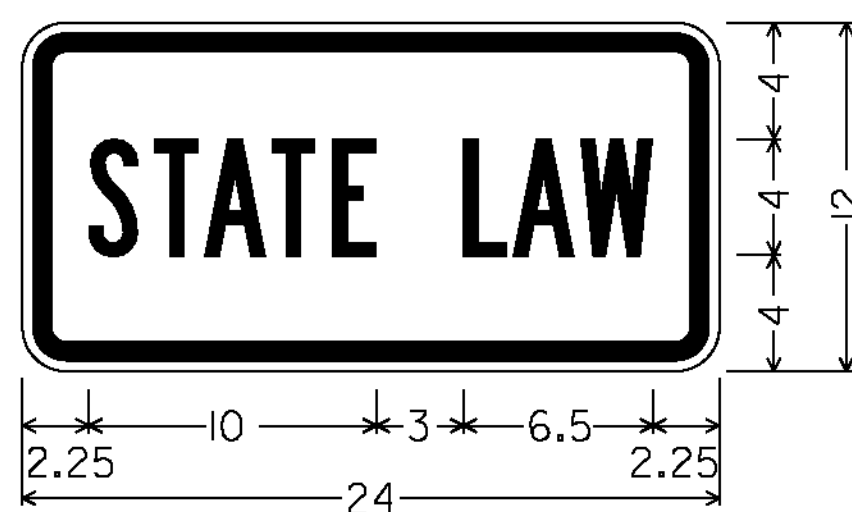


VW16-18P
1.500" RADIUS, 0.625" BORDER, 0.375" INDENT,
BLACK ON FLUORESCENT YELLOW;
[STATE LAW] 4"B

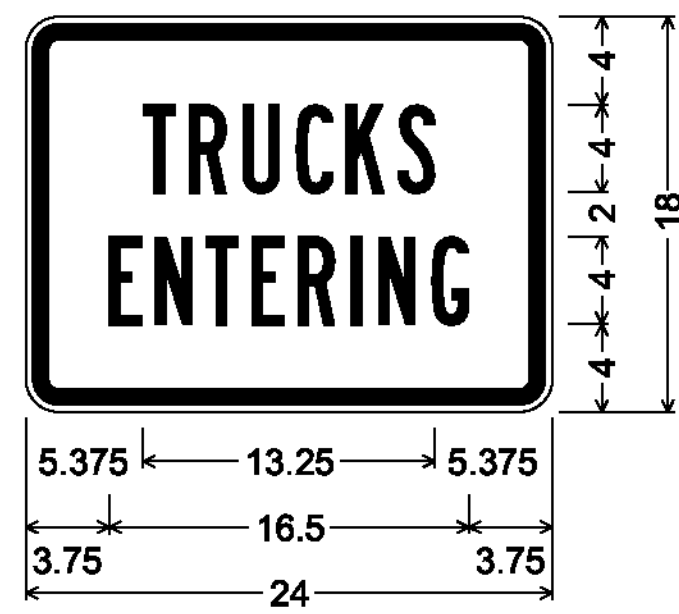



VW-202P TRUCKS ENTERING;
1.500" Radius, 0.625" Border, 0.375" Indent,
Black on Yellow;
[TRUCKS] B;
[ENTERING] B;




R8-1 MOD.
1.500" Radius, 0.625" Border, 0.375" Indent,
Red on White;
[NO] D;
[PARKING] C specified length;
[ON VILLAGE] D 50% spacing;
[STREETS] D 50% spacing;
[NOV. 1 - APR. 1] C specified length;
[11 PM - 6 AM] C 45% spacing;

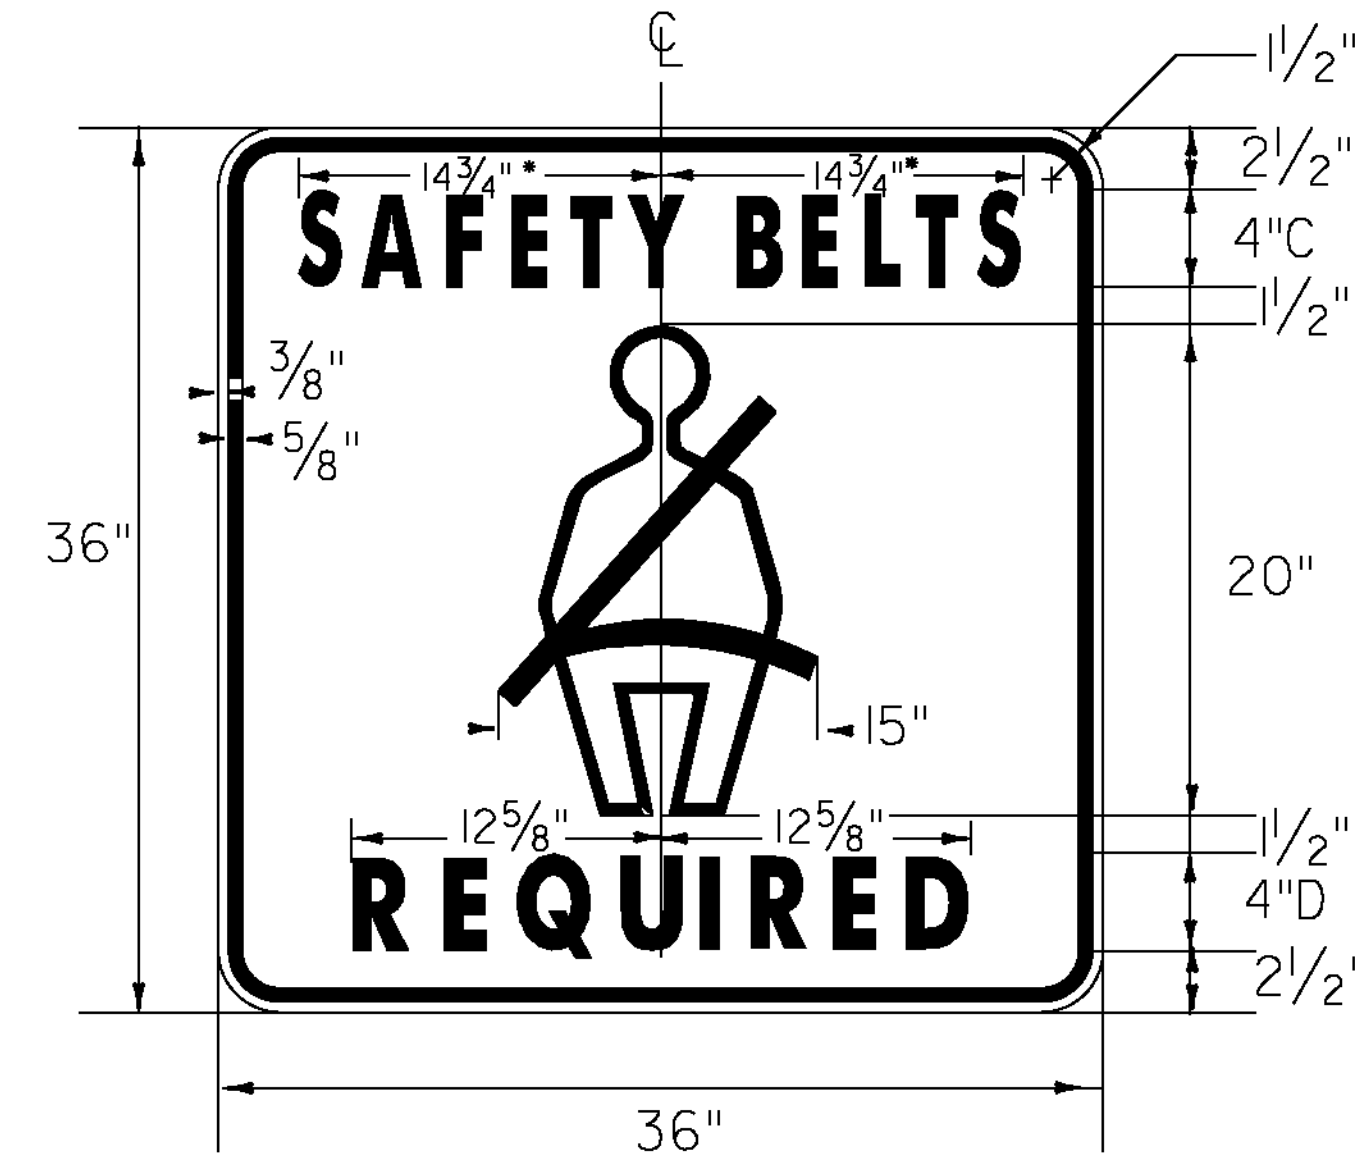

•REDUCE SPACING 50%
BLACK ON WHITE
VR-601

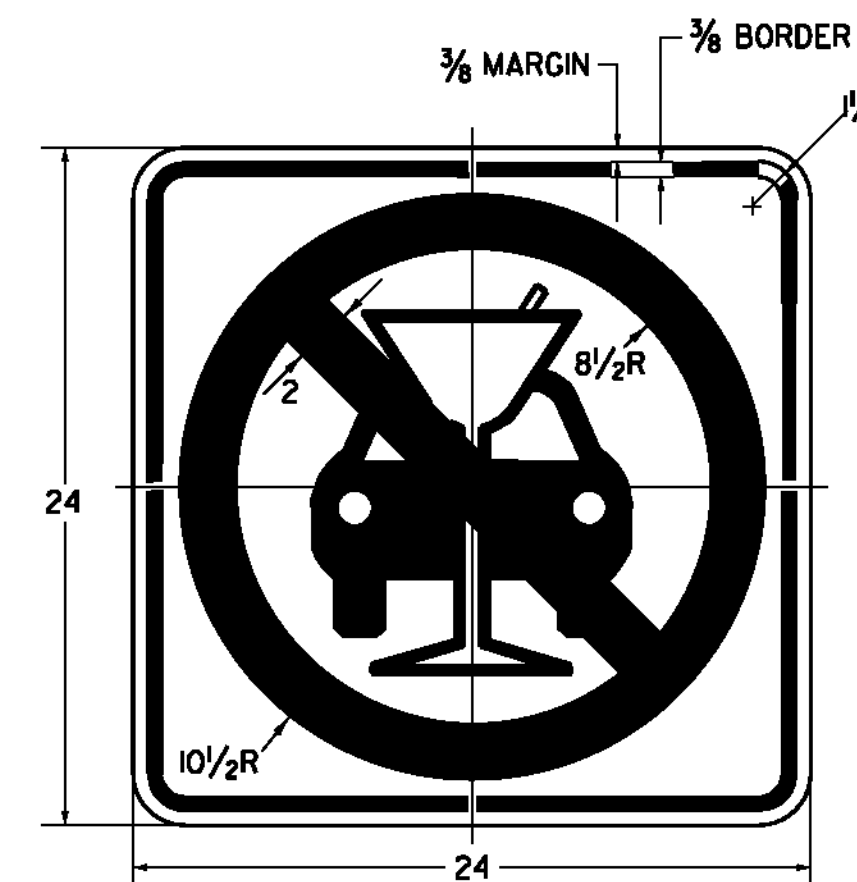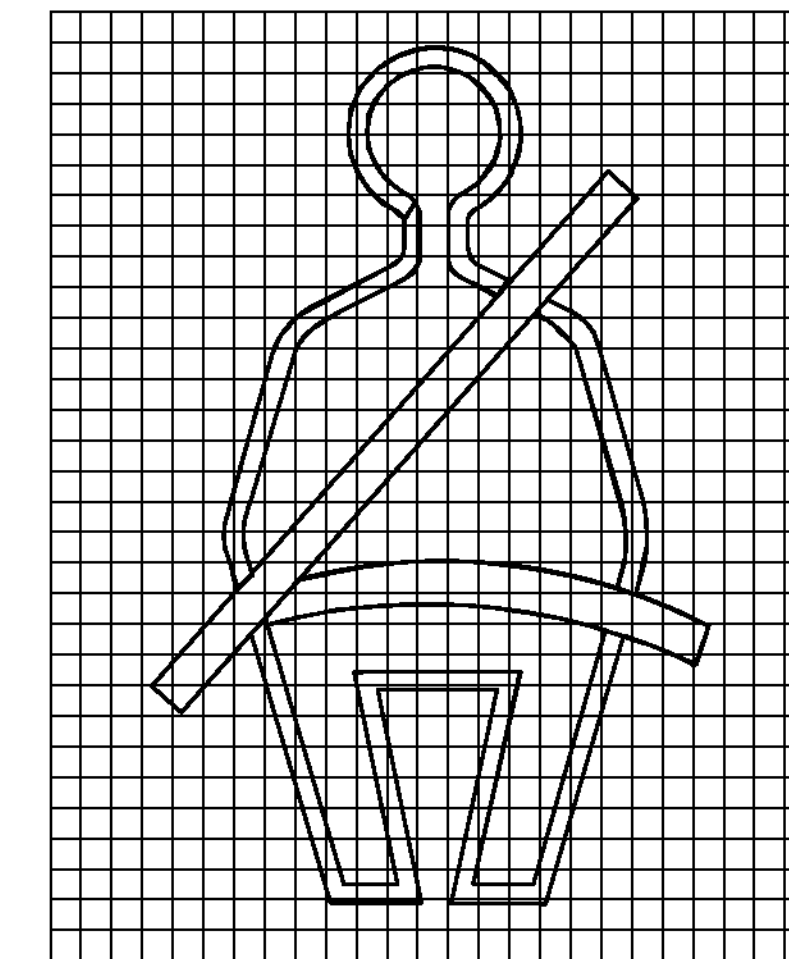


COLORS
CIRCLE AND DIAGONAL - RED (REFL)
SYMBOL AND BORDER - BLACK (NON - REFL)
BACKGROUND - WHITE (REFL)
VR-654

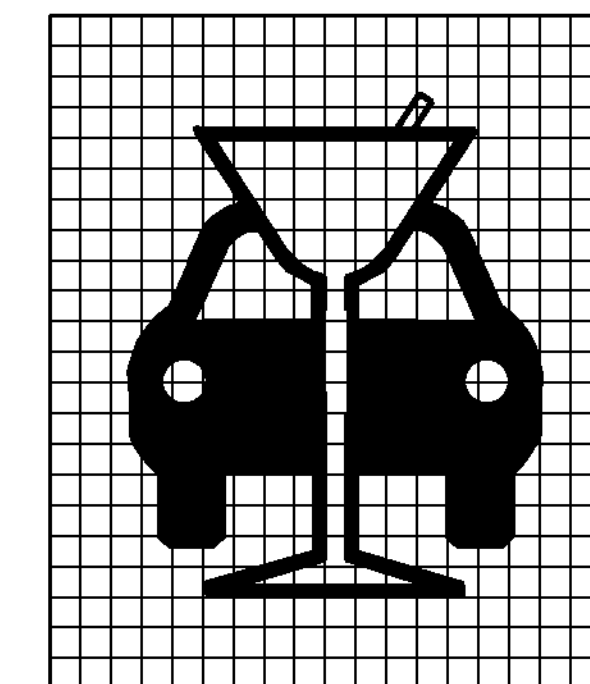


ALL DIMENSIONS SHOWN IN INCHES, EXCEPT WHERE NOTED.

PROJECT NAME:	STATEWIDE SW REGION	PLOT DATE:	13-FEB-2013
PROJECT NUMBER:	STPG SIGN (4I)	DRAWN BY:	J. KELLY
FILE NAME:	I2CI18.SD_3	CHECKED BY:	A. GAMBLE
PROJECT LEADER:	A. GAMBLE	SIGN DETAILS	3
DESIGNED BY:	J. KELLY	SHEET	6
		OF	97


NOT TO SCALE

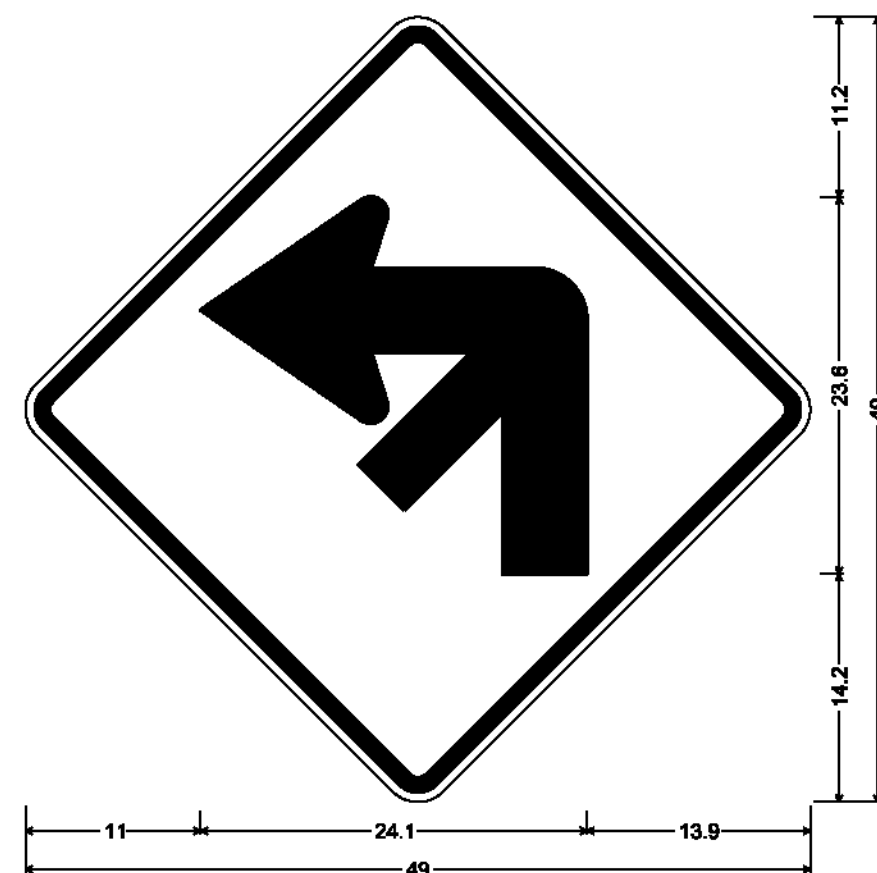

VW-11ML Left Turn, 4" Left Road, 36x36;
36.0" across sides 2.3" Radius, 0.9" Border, 0.6" Indent, Black on Yellow;

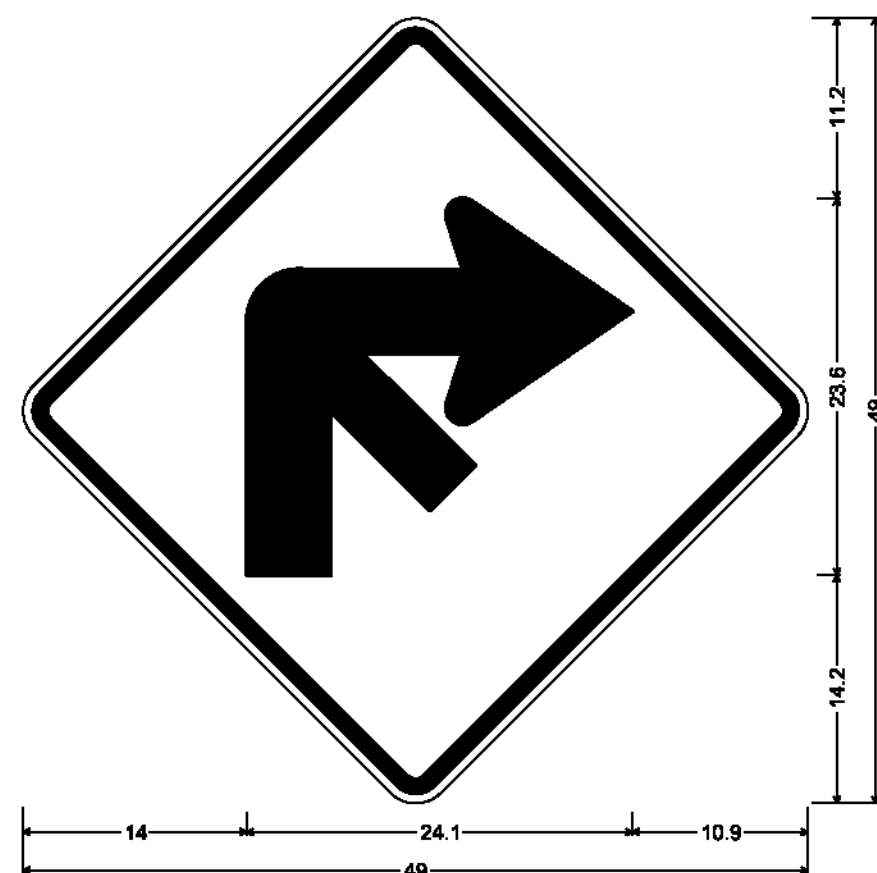


VW-11RM Right Turn, 4" Right Road, 36x36;
36.0" across sides 2.3" Radius, 0.9" Border, 0.6" Indent, Black on Yellow;

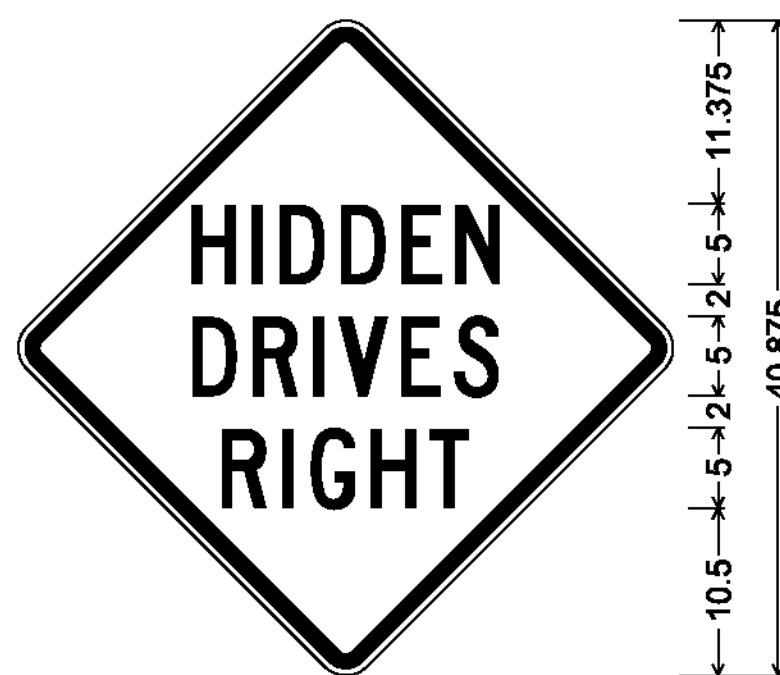

30.000" across sides 1.875" Radius, 0.750" Border, 0.500" Indent, Black on Yellow;
[HIDDEN] C; [DRIVES] C; [RIGHT] C;

VW-133R

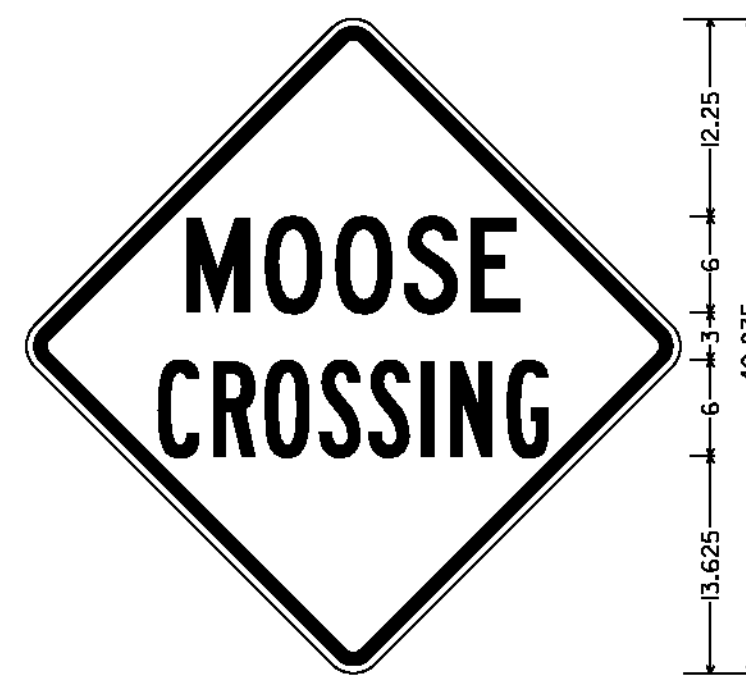

30.00" ACROSS SIDES, 1.875" RADIUS, 0.750" BORDER, 0.500" INDENT, BLACK ON YELLOW; [MOOSE] 6" @ 80% SPACING

VW-000




30.00" ACROSS SIDES, 1.875" RADIUS, 0.750" BORDER, 0.500" INDENT, BLACK ON YELLOW; [HIDDEN] 5", [DRIVE] 5", [RIGHT] 5"

VW-054R




30.00" ACROSS SIDES, 1.875" RADIUS, 0.750" BORDER, 0.500" INDENT, BLACK ON YELLOW; [HIDDEN] 5", [DRIVE] 5", [LEFT] 5"

VW-054L

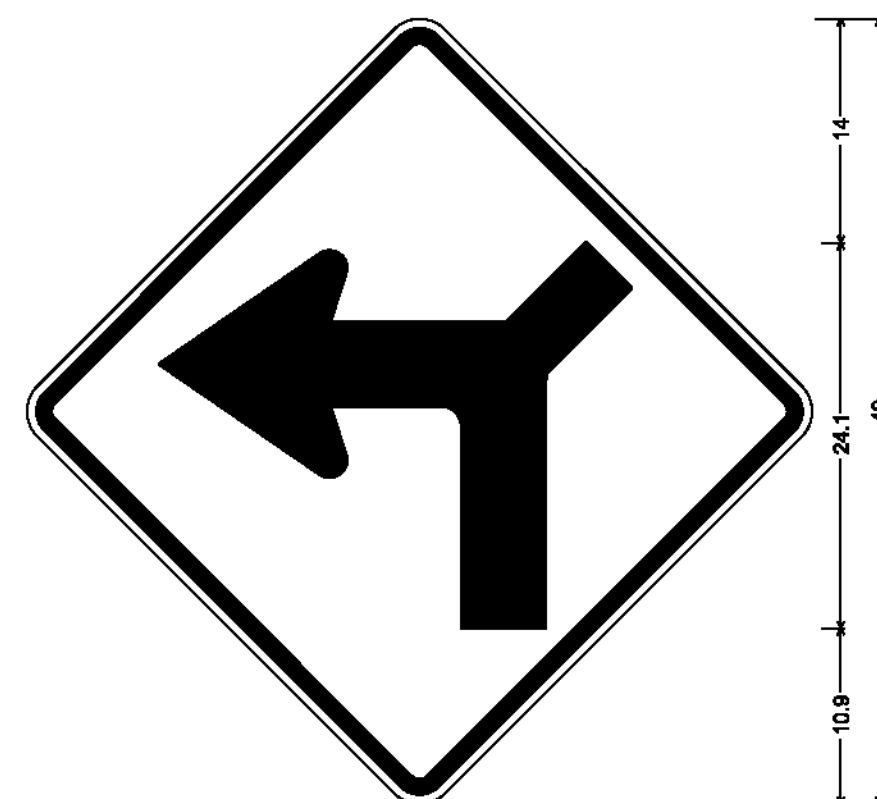

VW-11LR Left Turn, 4" Right Road, 36x36;
36.0" across sides 2.3" Radius, 0.9" Border, 0.6" Indent, Black on Yellow;

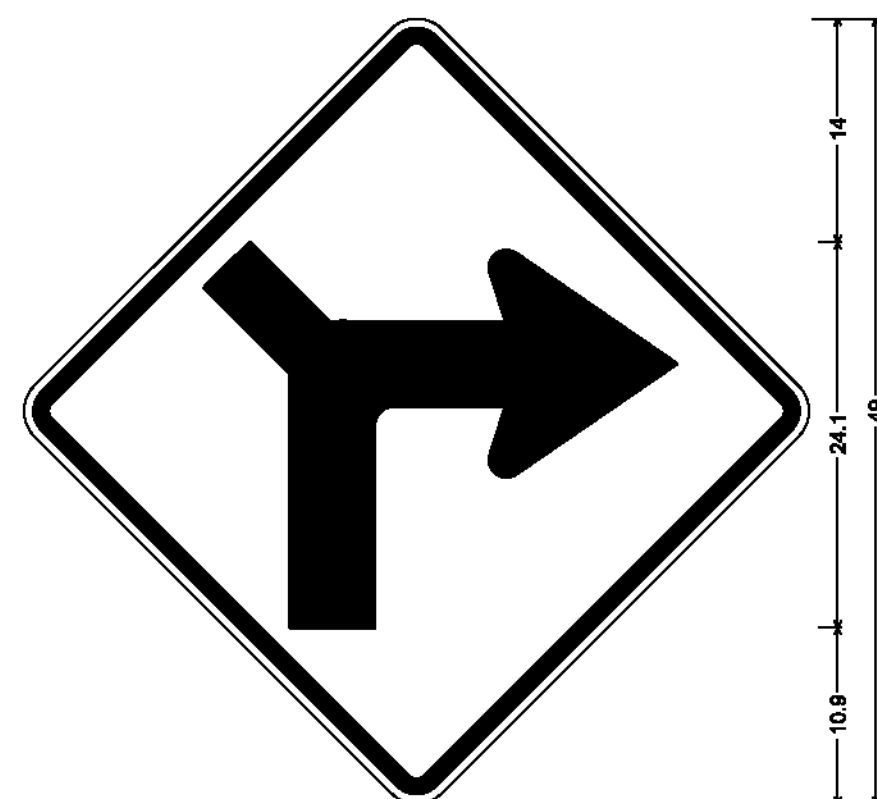

VW-11RL Right Turn, 4" Left Road, 36x36;
36.0" across sides 2.3" Radius, 0.9" Border, 0.6" Indent, Black on Yellow;



30.00" ACROSS SIDES, 1.875" RADIUS, 0.750" BORDER, 0.500" INDENT, BLACK ON YELLOW; [HIDDEN] 5", [DRIVES] 5"

VW-060




30.00" ACROSS SIDES, 1.875" RADIUS, 0.750" BORDER, 0.500" INDENT, BLACK ON YELLOW; [TRUCKS] 5", [ENTERING] 5" @ 80% SPACING

VW-202



30.0" across sides 1.9" Radius, 0.8" Border, 0.5" Indent, Black on Yellow;
[RECREATION] C; [AREA] C;

VW-622

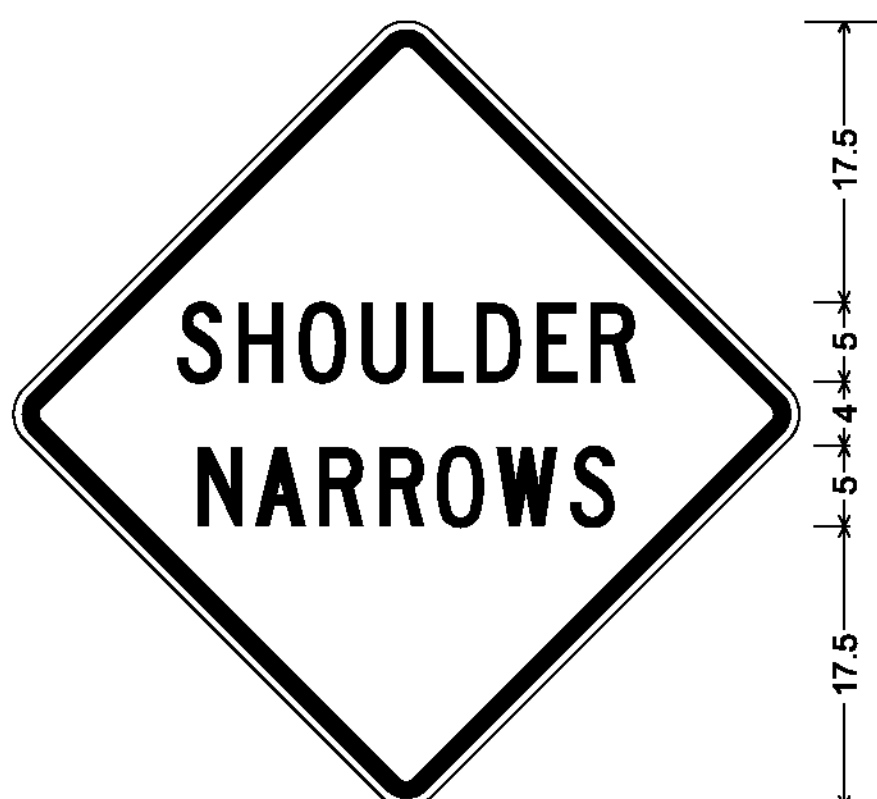

36.000" across sides 2.250" Radius, 0.875" Border, 0.625" Indent, Black on Yellow;

[SHOULDER] C; [NARROWS] C;



VW-619



36.000" across sides 2.250" Radius, 0.875" Border, 0.625" Indent, Black on Yellow;


[UNSAFE] C; [TO PASS] C;

VW-092

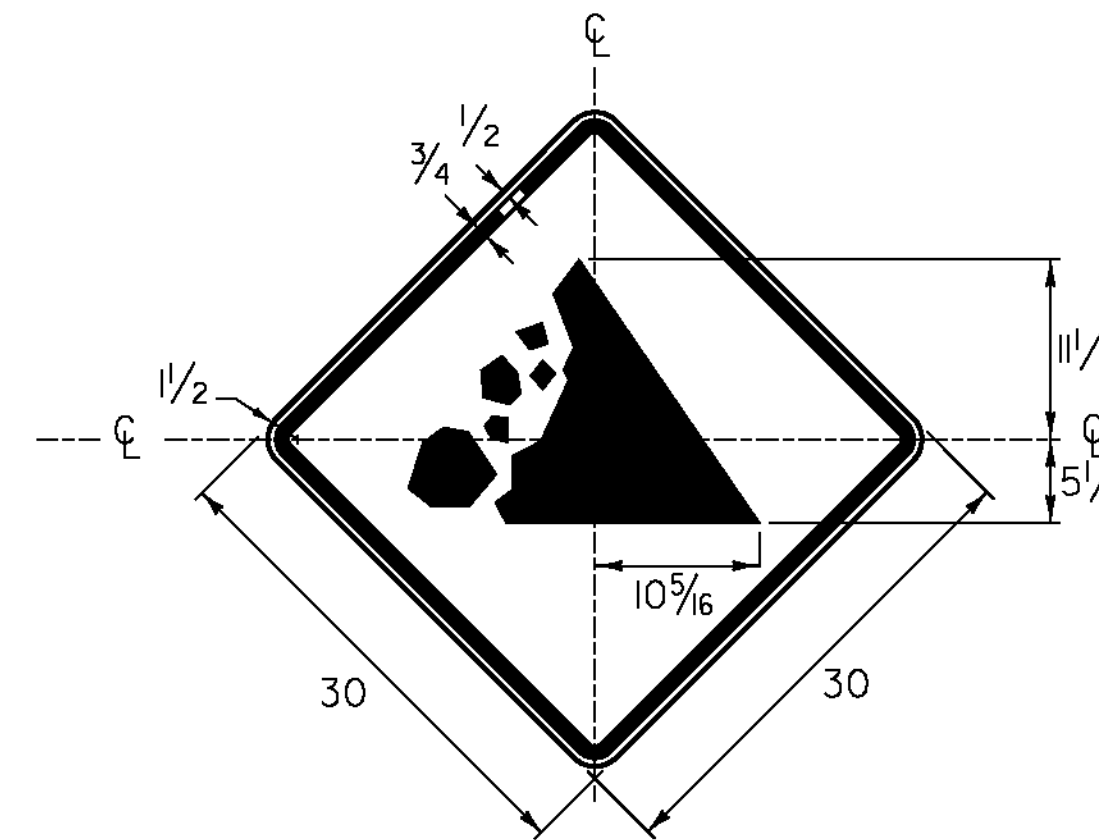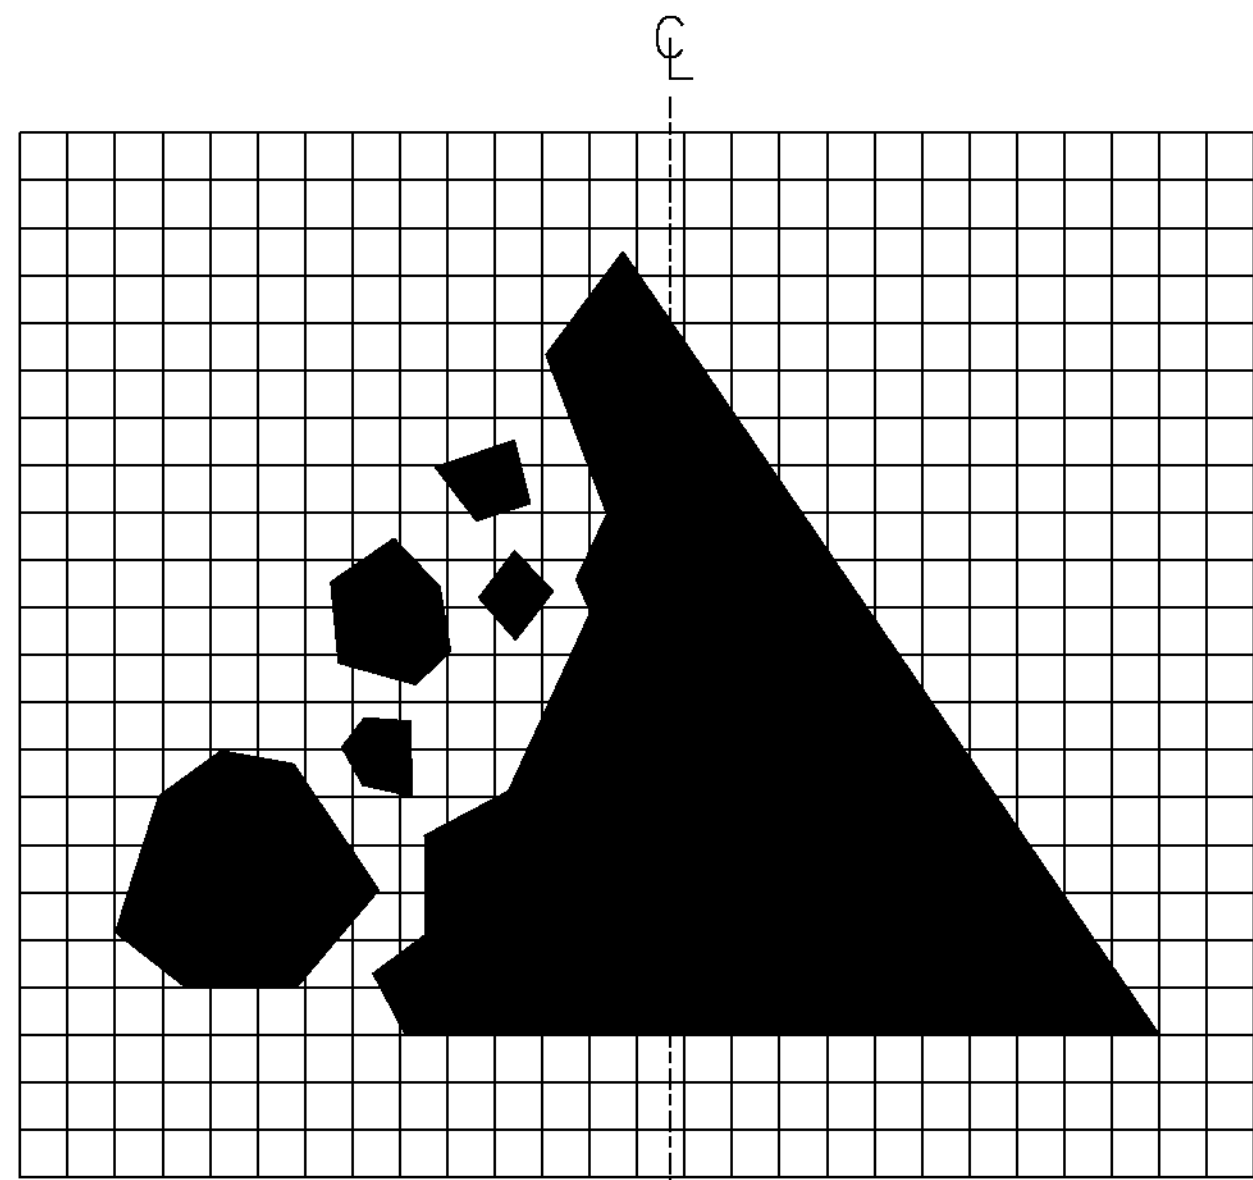

VW-285

SYMBOL AND BORDER - BLACK (NON-REFL.)
BACKGROUND - YELLOW (REFL.)

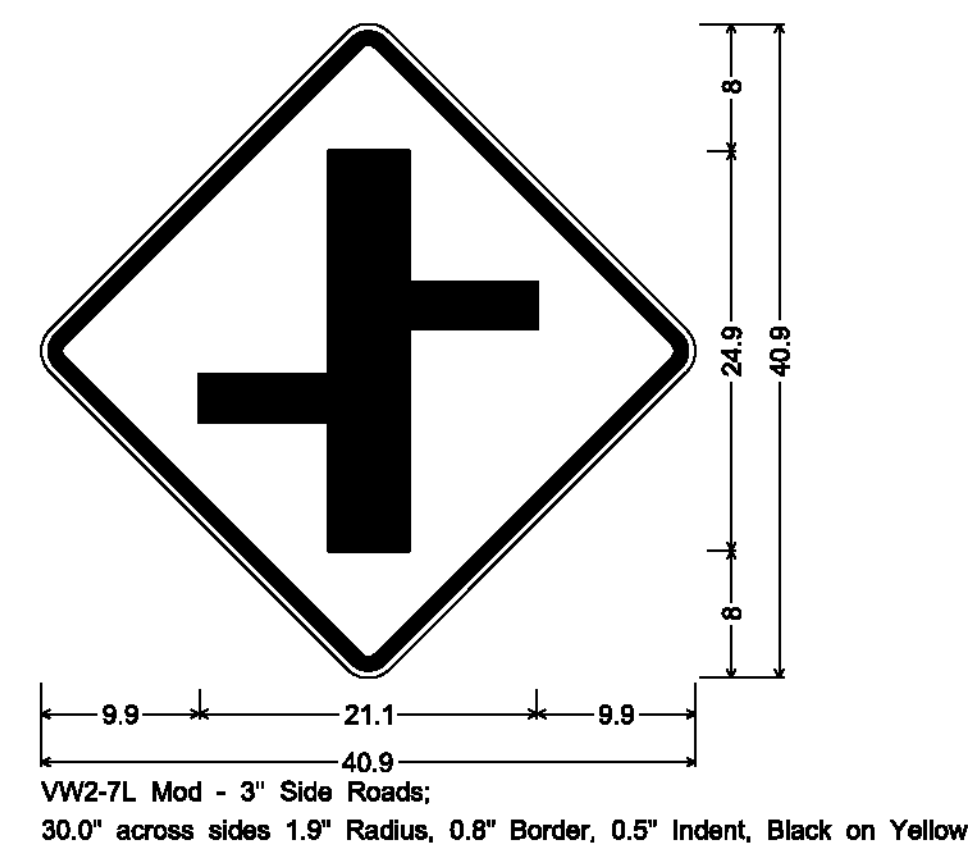


VW-7L Mod - 3" Side Roads;
30.0" across sides 1.9" Radius, 0.8" Border, 0.5" Indent, Black on Yellow;


ALL DIMENSIONS SHOWN IN INCHES, EXCEPT WHERE NOTED.

NOT TO SCALE

PROJECT NAME:	STATEWIDE SW REGION
PROJECT NUMBER:	STPG SIGN (4I)
FILE NAME:	I2CI18.SD_4
PROJECT LEADER:	A. GAMBLE
DESIGNED BY:	J. KELLY
SIGN DETAILS	4
PLOT DATE:	13-FEB-2013
DRAWN BY:	J. KELLY
CHECKED BY:	A. GAMBLE
SHEET	7 OF 97

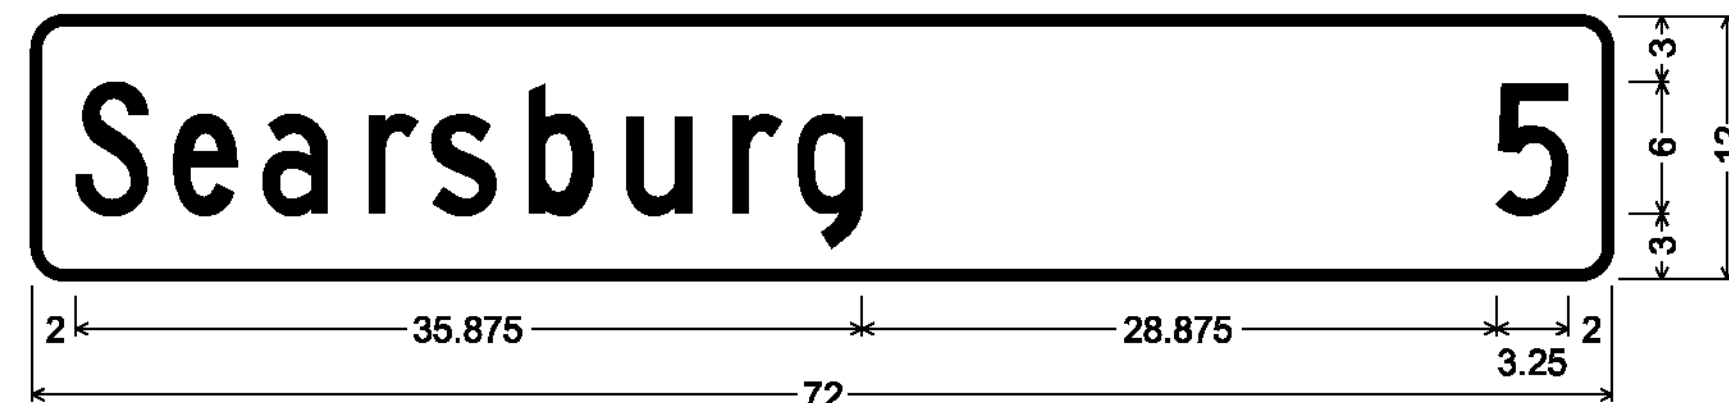


1.500" Radius, 0.375" Border, White on Green;
[Searsburg] C; [5] C;

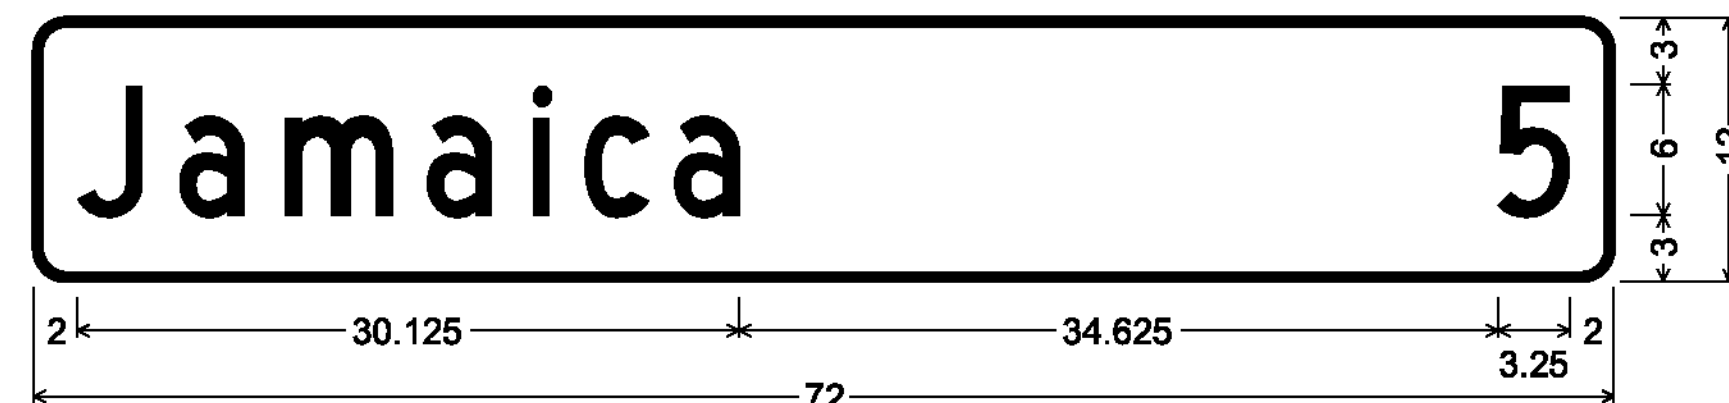

1.500" Radius, 0.375" Border, White on Green;
[Jamaica] C; [5] C;



1.500" Radius, 0.375" Border, White on Green;
[Stamford] C; [12] C;

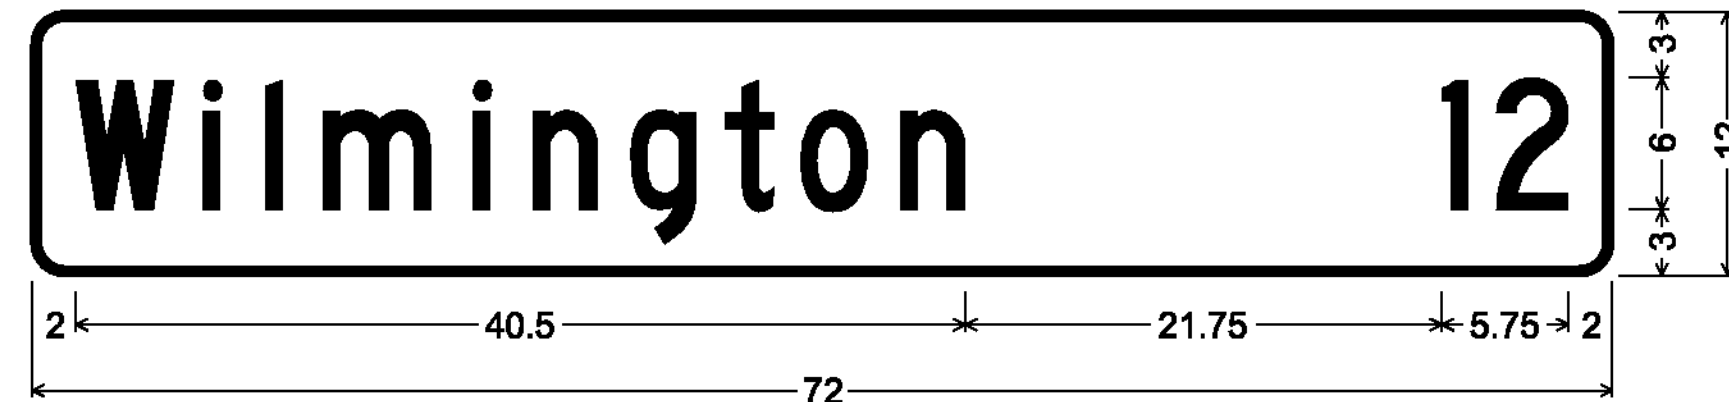

1.500" Radius, 0.375" Border, White on Green;
[Wilmington] C; [12] C;




1.500" Radius, 0.375" Border, White on Green;
[Readsboro] C; [11] C;



1.500" Radius, 0.375" Border, White on Green;
[Brattleboro] C; [31] C;



1.500" Radius, 0.375" Border, White on Green;
[Bennington] C; [19] C;

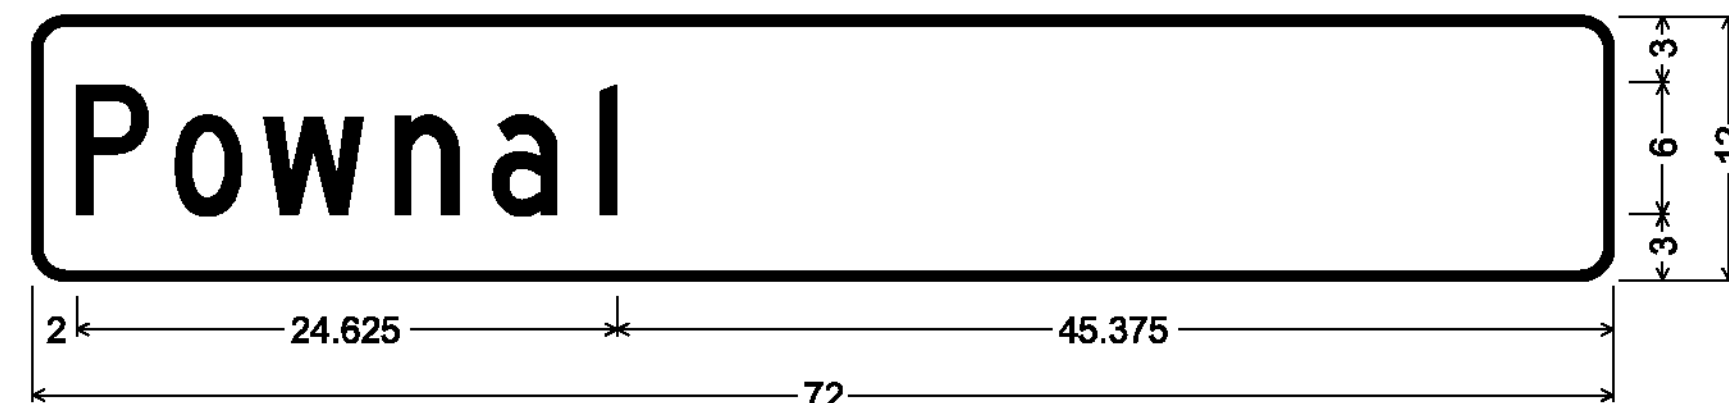


1.500" Radius, 0.375" Border, White on Green;
[Pownal] C;




1.500" Radius, 0.375" Border, White on Green;
[N. Pownal] C; [3] C;

ALL SIGNS IN THIS SECTION ARE SIGN CODE VD2-I

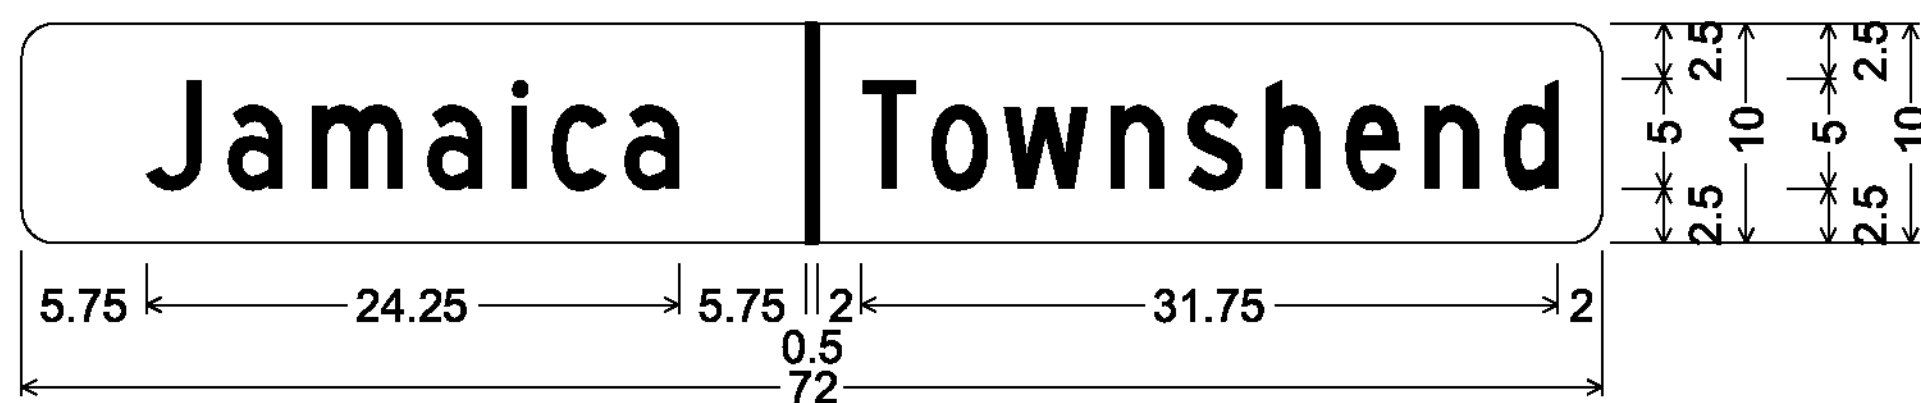


1.500" Radius, No border, White on Green;
[Jamaica] C specified length; [Townshend] C specified length;

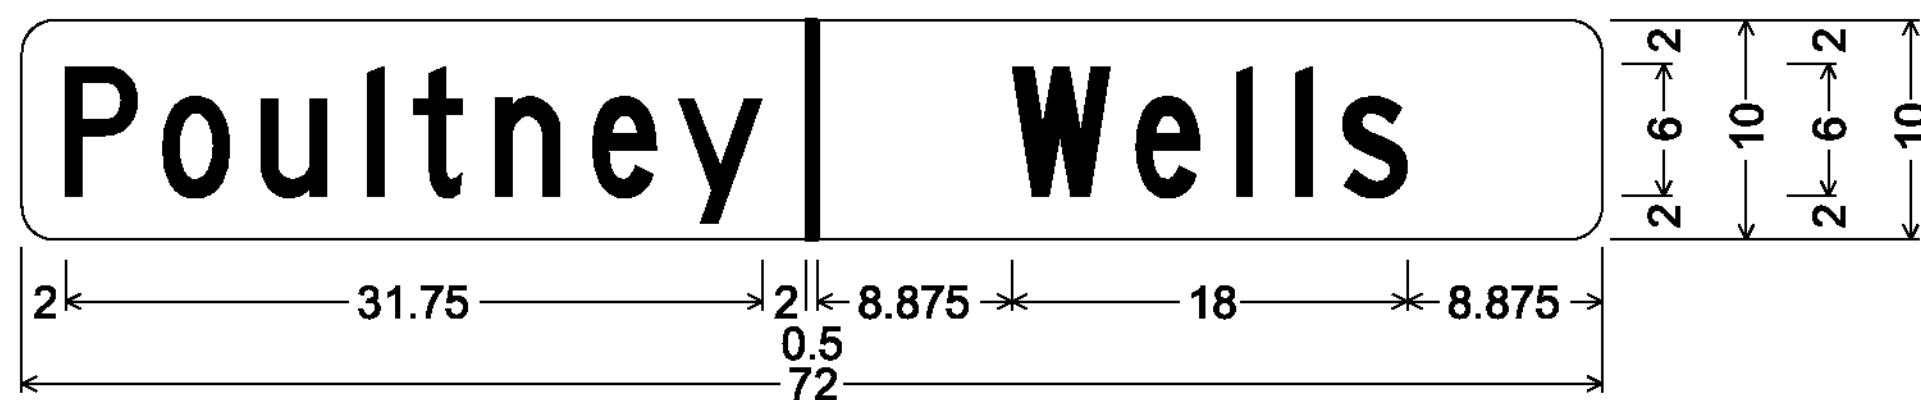


1.500" Radius, No border, White on Green;
[Poultney] C specified length; [Wells] C specified length;

ALL SIGNS IN THIS SECTION ARE SIGN CODE VD-024

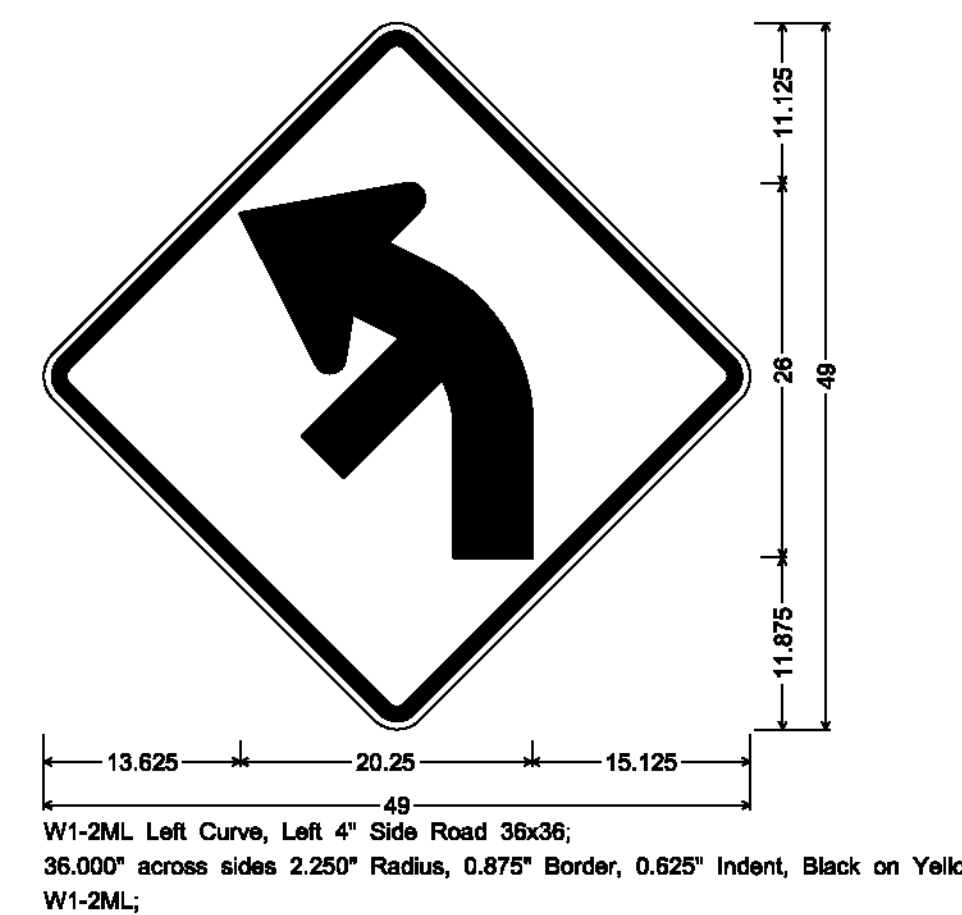

W1-2ML Left Curve, Left 4" Side Road 36x36;
36.000" across sides 2.250" Radius, 0.875" Border, 0.625" Indent, Black on Yellow;
W1-2ML;

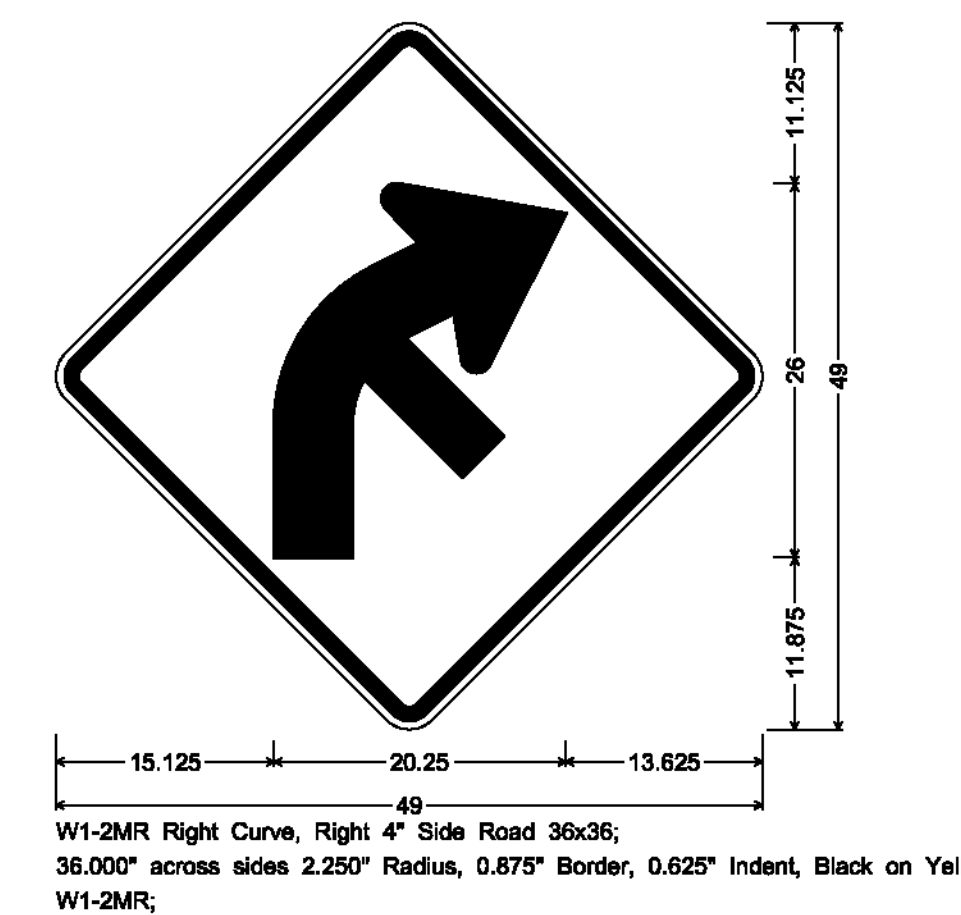


W1-2MR Right Curve, Right 4" Side Road 36x36;
36.000" across sides 2.250" Radius, 0.875" Border, 0.625" Indent, Black on Yellow;
W1-2MR;


ALL DIMENSIONS SHOWN IN INCHES, EXCEPT WHERE NOTED.

NOT TO SCALE


PROJECT NAME:	STATEWIDE SW REGION
PROJECT NUMBER:	STPG SIGN (4I)
FILE NAME:	I2CI18.SD_5
PROJECT LEADER:	A. GAMBLE
DESIGNED BY:	J. KELLY
SIGN DETAILS	5
PLOT DATE:	13-FEB-2013
DRAWN BY:	J. KELLY
CHECKED BY:	A. GAMBLE
SHEET	8 OF 97

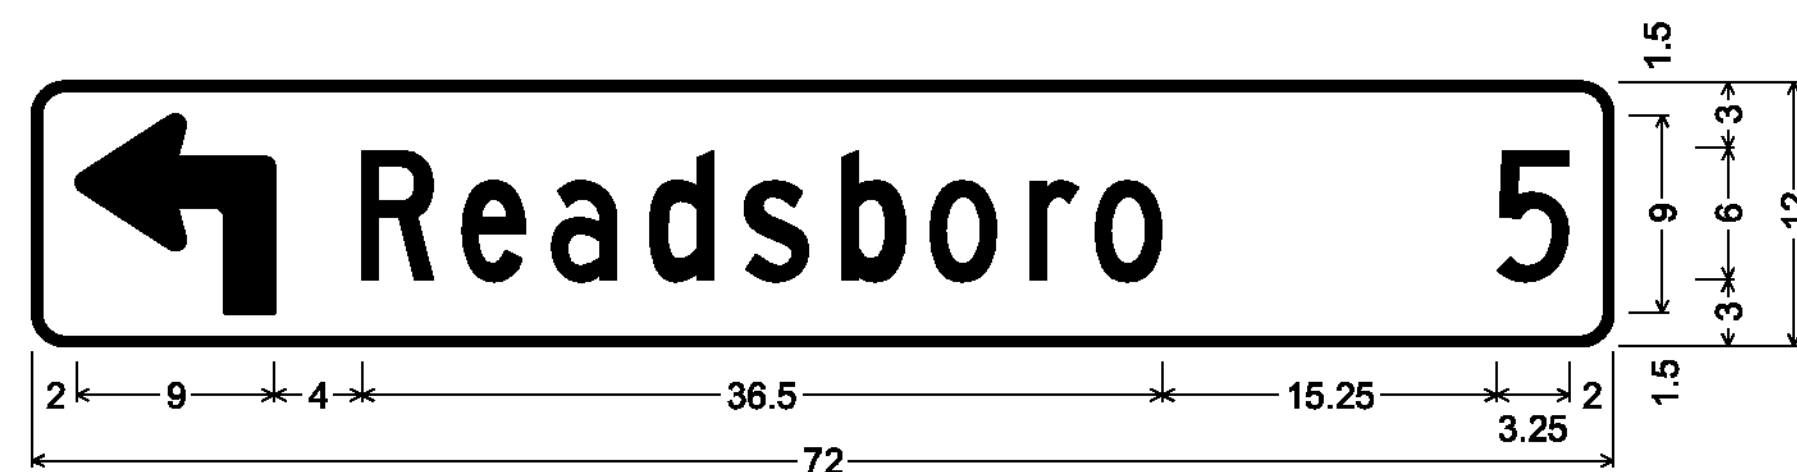


1.500" Radius, 0.375" Border, White on Green;
90 Deg Advanced Turn Arrow Custom 9.000" X 9.000"; [Readsboro] C; [5] C;

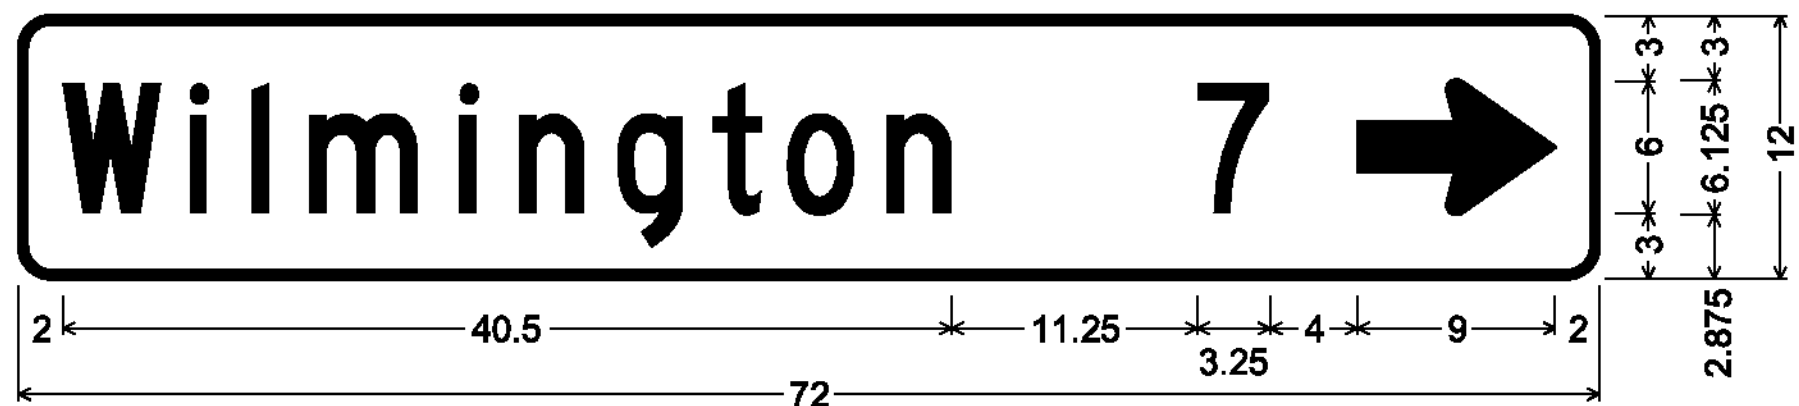

1.500" Radius, 0.375" Border, White on Green;
[Wilmington] C; [7] C; Standard Arrow Custom 9.000" X 6.125" 0°;

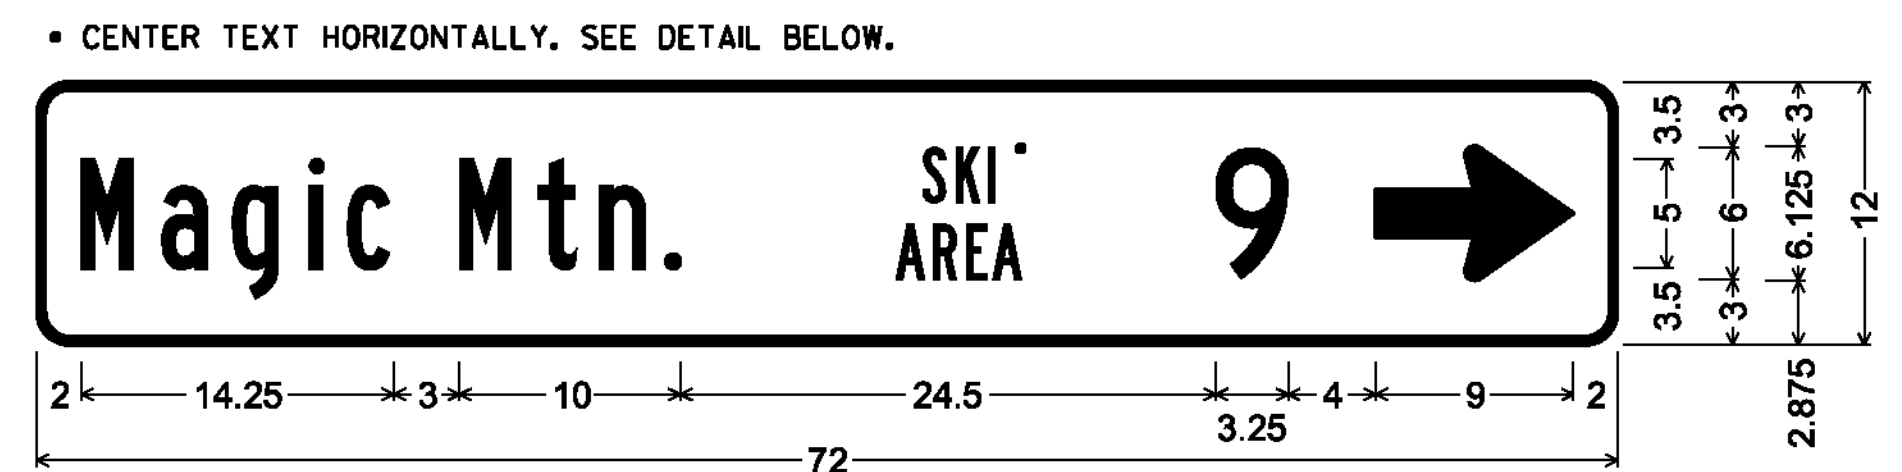


1.500" Radius, 0.375" Border, White on Green;
[Magic Mtn.] B; [9] C; Standard Arrow Custom 9.000" X 6.125" 0°;

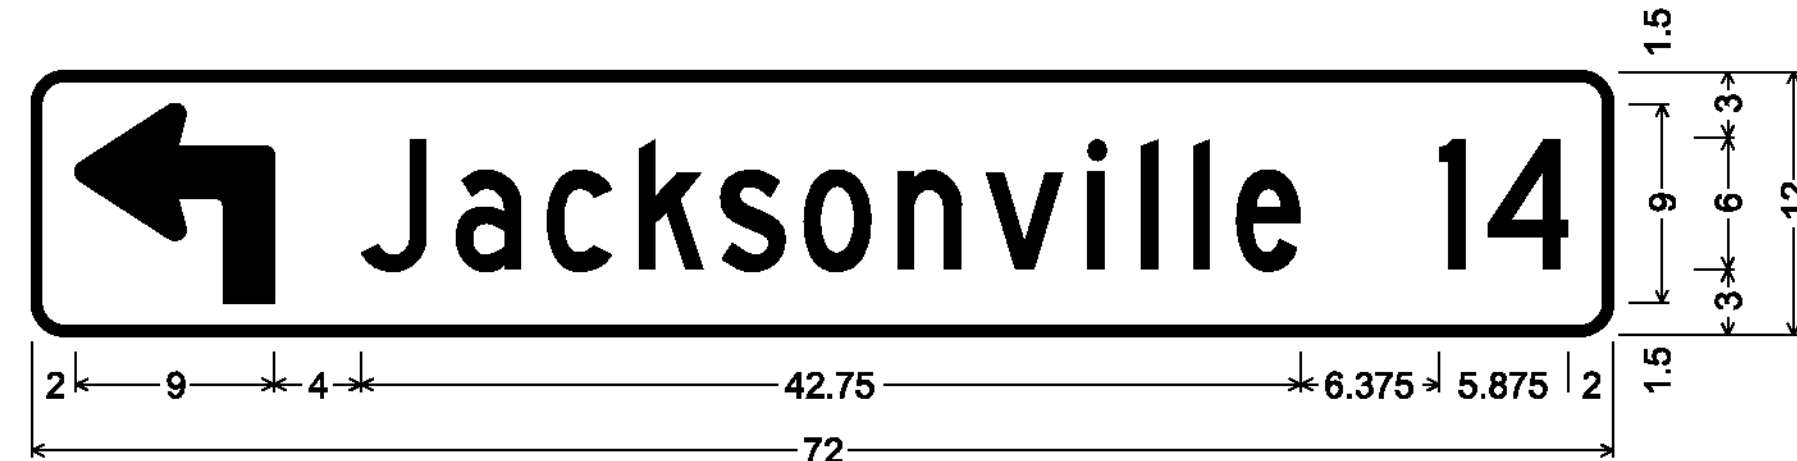


1.500" Radius, 0.375" Border, White on Green;
90 Deg Advanced Turn Arrow Custom 9.000" X 9.000"; [Jacksonville] C 80% spacing;
[14] C;



1.500" Radius, 0.375" Border, White on Green;
[Ski Areas] C; Standard Arrow Custom 9.000" X 6.125" 0°;

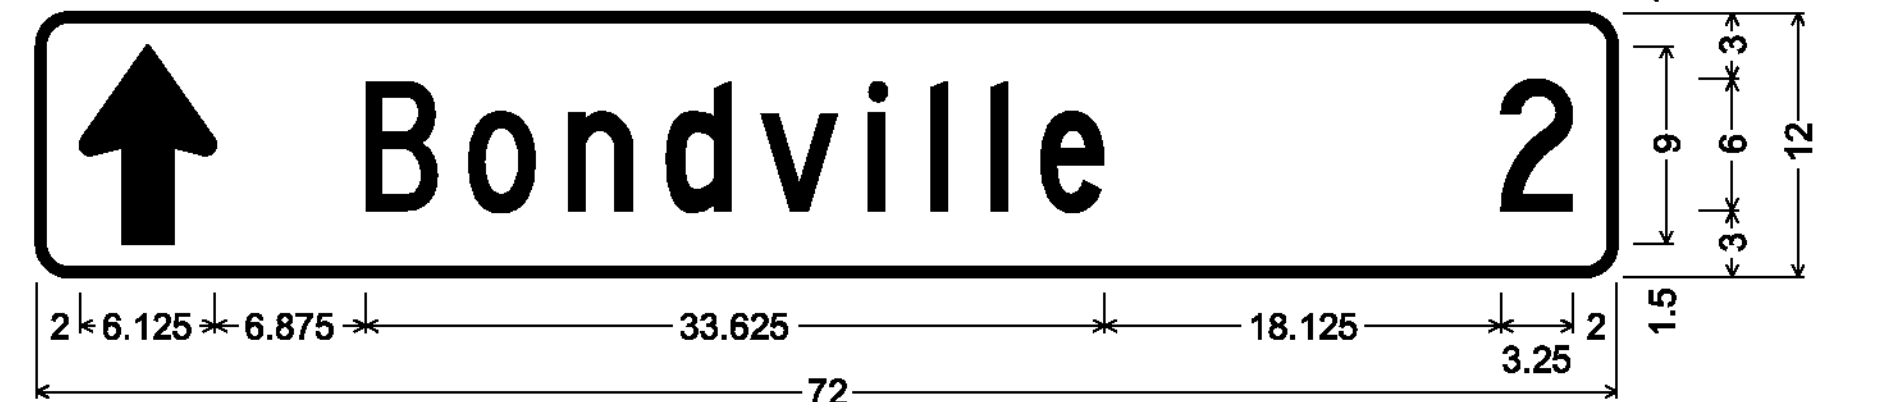

1.500" Radius, 0.375" Border, White on Green;
Standard Arrow Custom 9.000" X 6.125" 90°; [Bondville] C; [2] C;

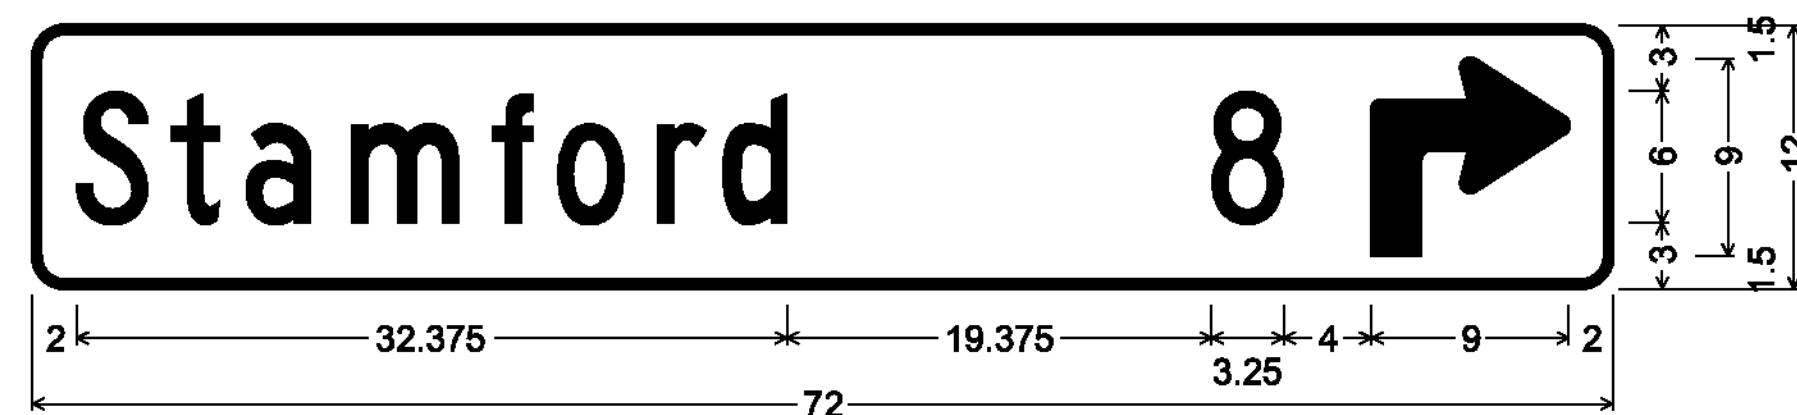


1.500" Radius, 0.375" Border, White on Green;
[Stamford] C; [8] C; 90 Deg Advanced Turn Arrow Custom 9.000" X 9.000";




1.500" Radius, 0.375" Border, White on Green;
[Brattleboro] C; [24] C; Standard Arrow Custom 9.000" X 6.125" 0°;



1.500" Radius, 0.375" Border, White on Green;
Standard Arrow Custom 9.000" X 6.125" 90°; [Manchester] C; [15] C;

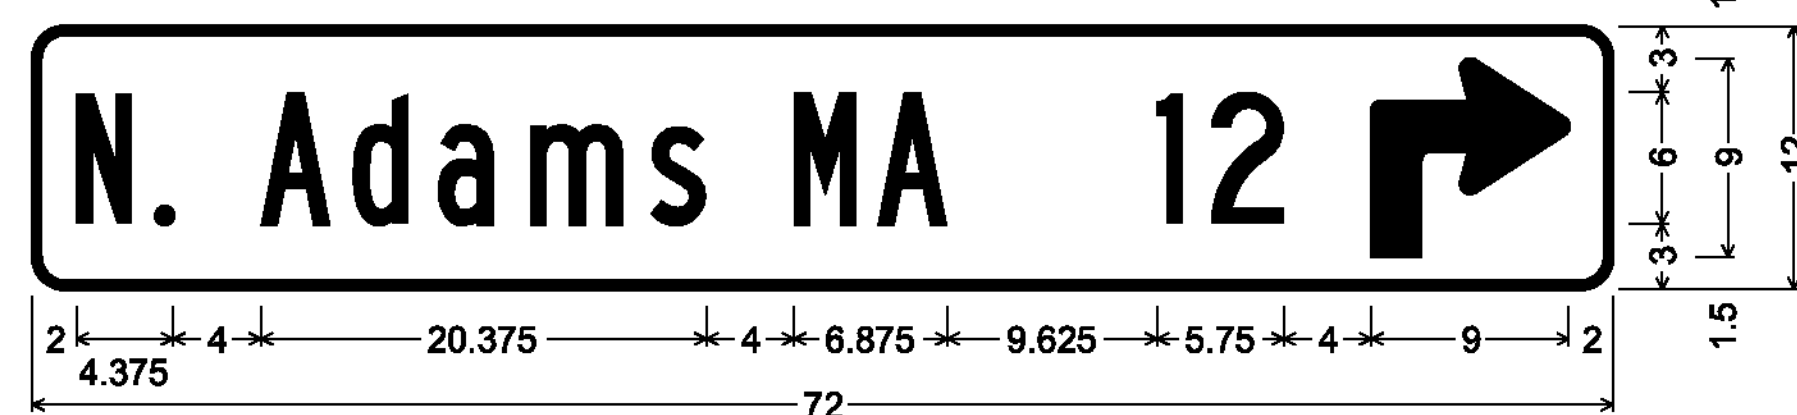

1.500" Radius, 0.375" Border, White on Green;
[N. Adams MA] B; [12] C; 90 Deg Advanced Turn Arrow Custom 9.000" X 9.000";

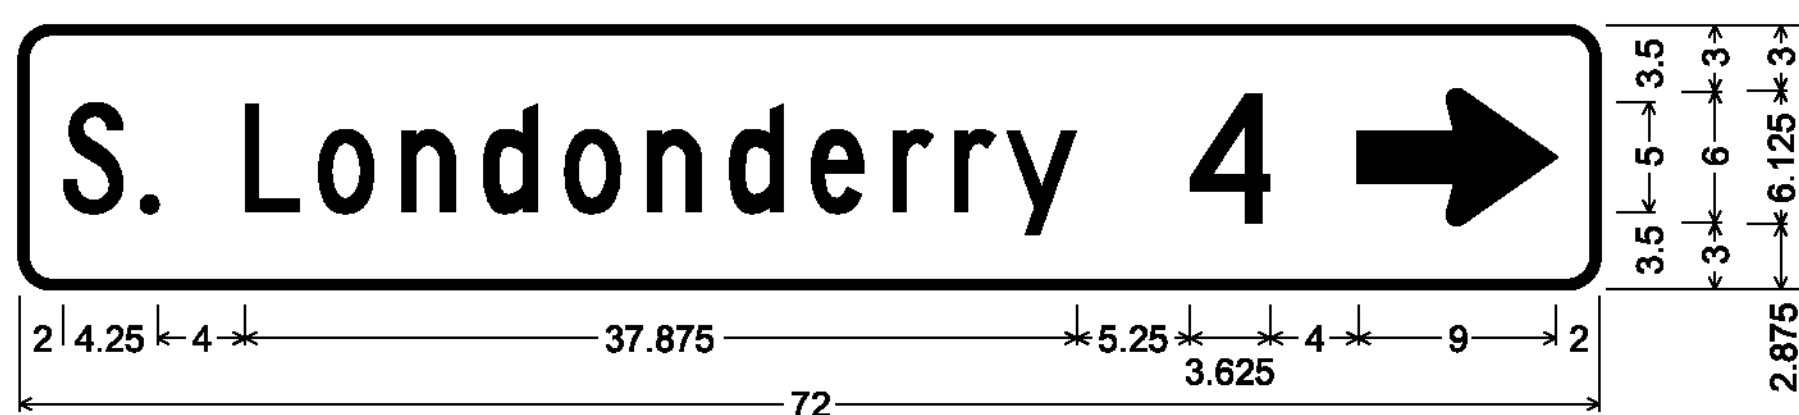

1.500" Radius, 0.375" Border, White on Green;
[S. Londonderry] C; [4] C; Standard Arrow Custom 9.000" X 6.125" 0°;



1.500" Radius, 0.375" Border, White on Green;
Standard Arrow Custom 9.000" X 6.125" 90°; [Ski Areas] C;




1.500" Radius, 0.375" Border, White on Green;
Standard Arrow Custom 9.000" X 6.125" 180°; [Bennington] C; [14] C;



1.500" Radius, 0.375" Border, White on Green;
[Londonderry] C; [7] C; Standard Arrow Custom 9.000" X 6.125" 0°;



1.500" Radius, 0.375" Border, White on Green;
Standard Arrow Custom 9.000" X 6.125" 90°; [Jamaica] C; [5] C;

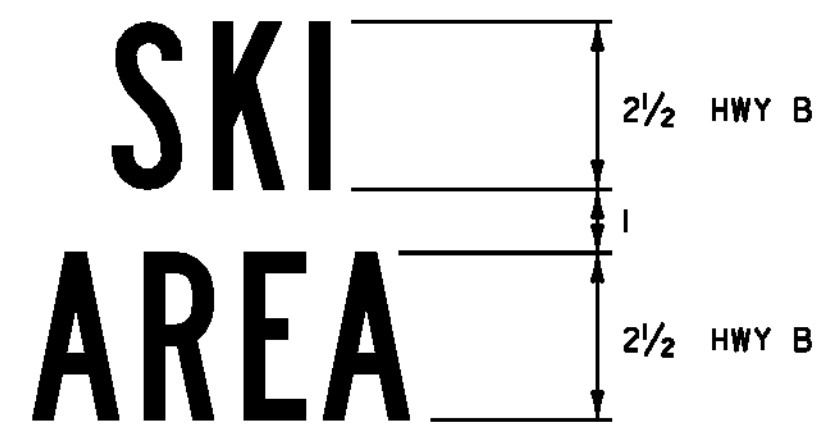


ALL SIGNS ON THIS PAGE ARE SIGN CODE VDI-1A

NOT TO SCALE

NOTES

- ALL DIMENSIONS SHOWN IN INCHES, EXCEPT WHERE NOTED.
- SEE SHEET 4 FOR ADDITIONAL DESTINATION SIGN DETAILS.

PROJECT NAME:	STATEWIDE SW REGION
PROJECT NUMBER:	STPG SIGN (4I)
FILE NAME:	I2CI18.SD_6
PROJECT LEADER:	A. GAMBLE
DESIGNED BY:	J. KELLY
SIGN DETAILS:	6
PLOT DATE:	13-FEB-2013
DRAWN BY:	J. KELLY
CHECKED BY:	A. GAMBLE
SHEET:	9 OF 97

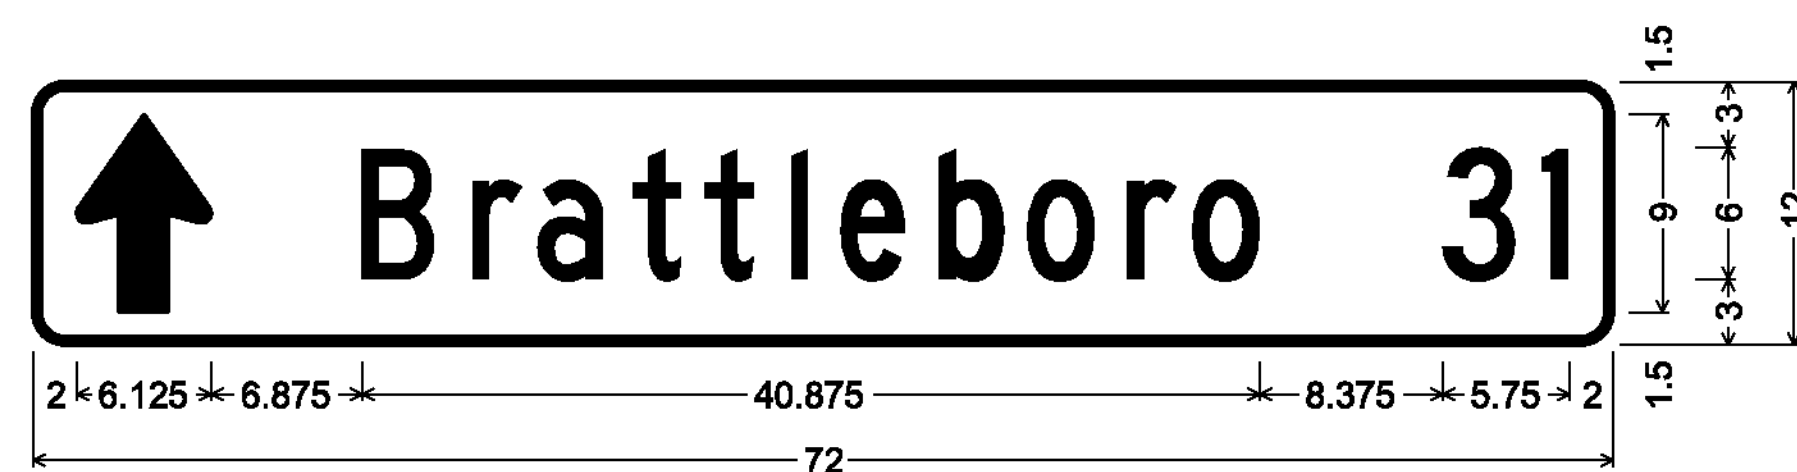

1.500" Radius, 0.375" Border, White on Green;
Standard Arrow Custom 9.000" X 6.125" 90°; [Brattleboro] C; [31] C;




1.500" Radius, 0.375" Border, White on Green;
Standard Arrow Custom 9.000" X 6.125" 135°; [Pownal Center] B; [3] C;



1.500" Radius, 0.375" Border, White on Green;
Standard Arrow Custom 9.000" X 6.125" 180°; [S. Londonderry] B specified length;
[4] C;




1.500" Radius, 0.375" Border, White on Green;
Standard Arrow Custom 9.000" X 6.125" 180°; [Pownal] B [Center] C 80% spacing;
[3] C;

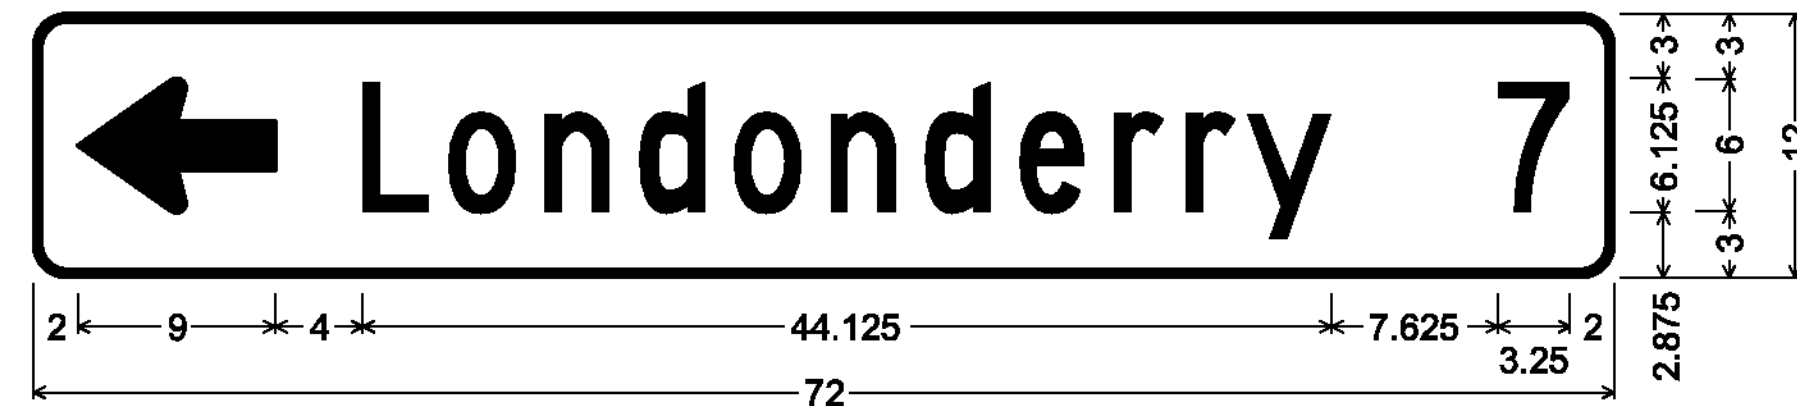

1.500" Radius, 0.375" Border, White on Green;
Standard Arrow Custom 9.000" X 6.125" 180°; [Londonderry] C 90% spacing; [7] C;




1.500" Radius, 0.375" Border, White on Green;
Standard Arrow Custom 9.000" X 6.125" 180°; [Bennington] C; [9] C;

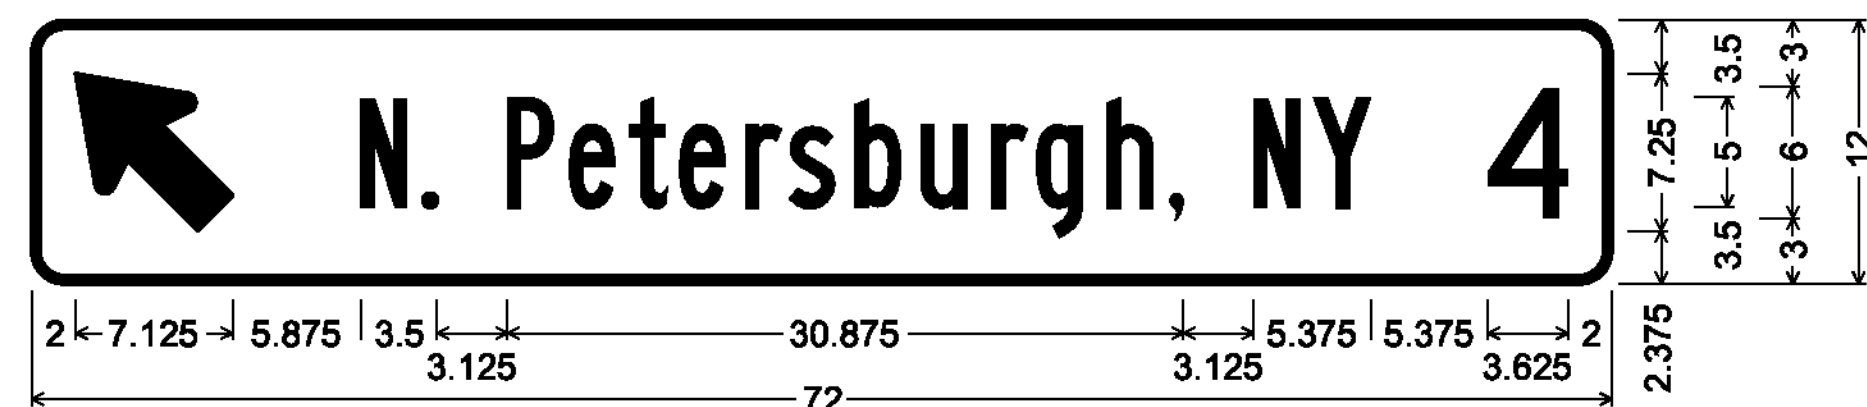

1.500" Radius, 0.375" Border, White on Green;
Standard Arrow Custom 9.000" X 6.125" 135°; [N. Petersburgh, NY] B 80% spacing;
[4] C;



1.500" Radius, 0.375" Border, White on Green;
[Williamstown MA] B; [4] C; Standard Arrow Custom 9.000" X 6.125" 0°;

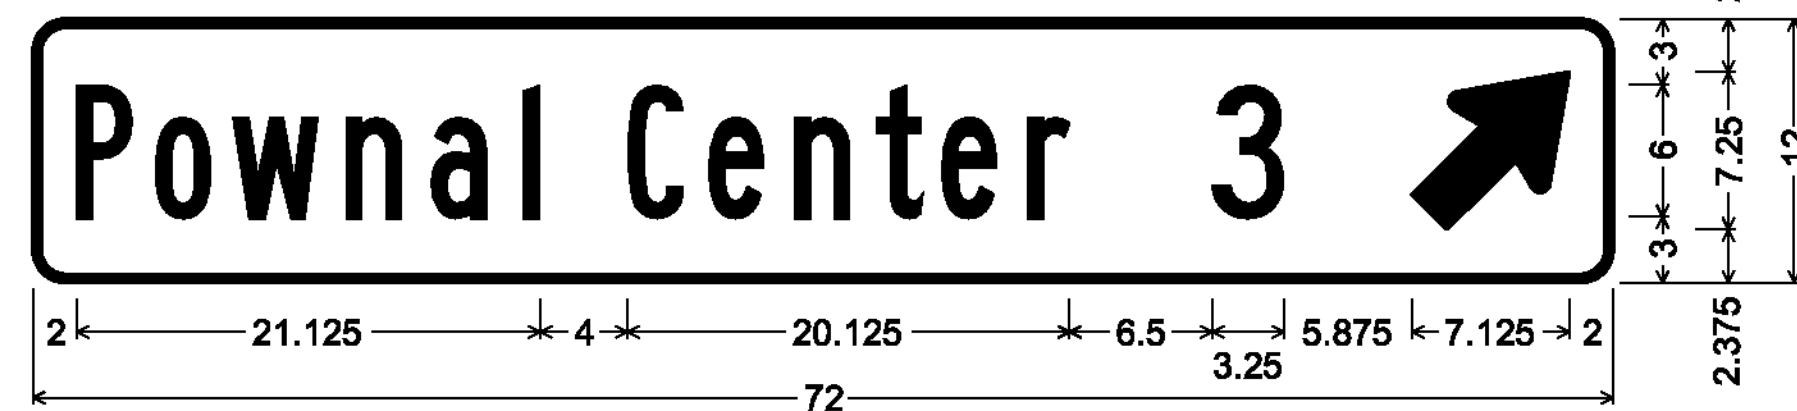

1.500" Radius, 0.375" Border, White on Green;
[Pownal Center] B; [3] C; Standard Arrow Custom 9.000" X 6.125" 45°;


NOTES

1. ALL DIMENSIONS SHOWN IN INCHES, EXCEPT WHERE NOTED.
2. SEE SHEET 4 FOR ADDITIONAL DESTINATION SIGN DETAILS.

PROJECT NAME:	STATEWIDE SW REGION
PROJECT NUMBER:	STPG SIGN (4I)
FILE NAME:	I2CI18.SD_7
PROJECT LEADER:	A. GAMBLE
DESIGNED BY:	J. KELLY
SIGN DETAILS:	7
PLOT DATE:	13-FEB-2013
DRAWN BY:	J. KELLY
CHECKED BY:	A. GAMBLE
SHEET:	10 OF 97

ALL SIGNS ON THIS PAGE ARE SIGN CODE VDI-IA

NOT TO SCALE

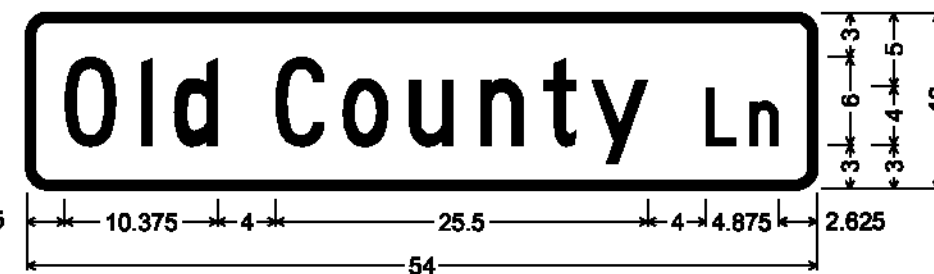


DOUBLE-SIDED STREET SIGN (READSBORO);
1.500" Radius, 0.500" Border, White on Green;
[Old County] C; [Ln] C;




DOUBLE-SIDED STREET SIGN (JAMAICA);
1.500" Radius, 0.500" Border, White on Green;
[Depot] C; [St] C; [J19] C;



DOUBLE-SIDED STREET SIGN (JAMAICA);
1.500" Radius, 0.500" Border, White on Green;
[Wild Turkey Run] B || C; [J86] B;

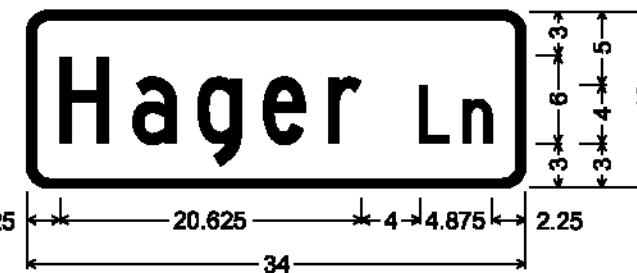


DOUBLE-SIDED STREET SIGN (SEARSBURG);
1.500" Radius, 0.500" Border, White on Green;
[Hager] C; [Ln] C;

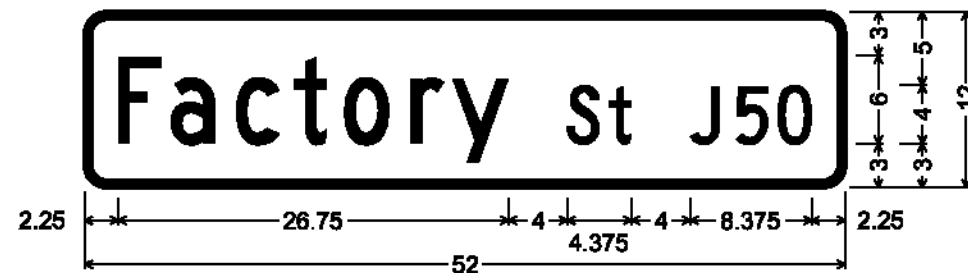


DOUBLE-SIDED STREET SIGN (JAMAICA);
1.500" Radius, 0.500" Border, White on Green;
[Factory] C; [St] C; [J50] C;



DOUBLE-SIDED STREET SIGN (JAMAICA);
1.500" Radius, 0.500" Border, White on Green;
[Bourbon Run] C; [Rd] C; [J65] C;

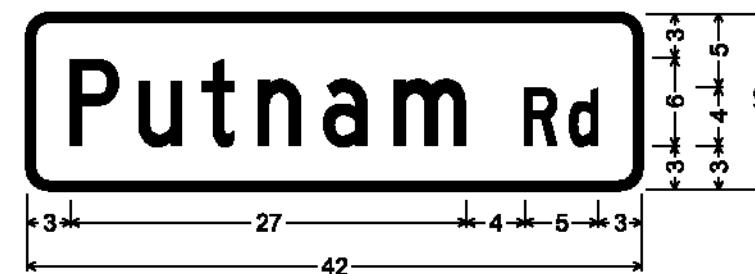


DOUBLE-SIDED STREET SIGN (SEARSBURG);
1.500" Radius, 0.500" Border, White on Green;
[Putnam] C; [Rd] C;

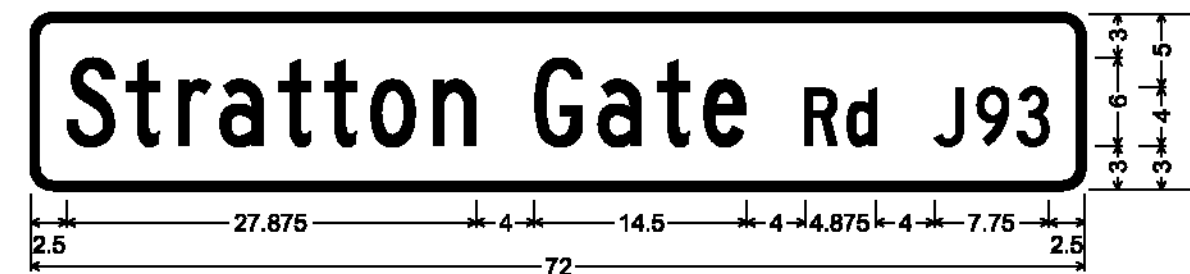


DOUBLE-SIDED STREET SIGN (JAMAICA);
1.500" Radius, 0.500" Border, White on Green;
[Stratton Gate] C 80% spacing; [Rd] C 80% spacing; [J93] C 80% spacing;




DOUBLE-SIDED STREET SIGN (JAMAICA);
1.500" Radius, 0.500" Border, White on Green;
[Mtn Acres] C; [Rd] C; [J11] C;

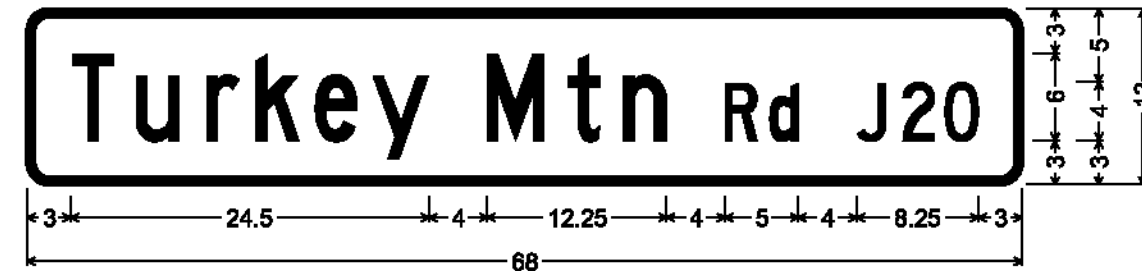


DOUBLE-SIDED STREET SIGN (JAMAICA);
1.500" Radius, 0.500" Border, White on Green;
[Turkey Mtn] C; [Rd] C; [J20] C;

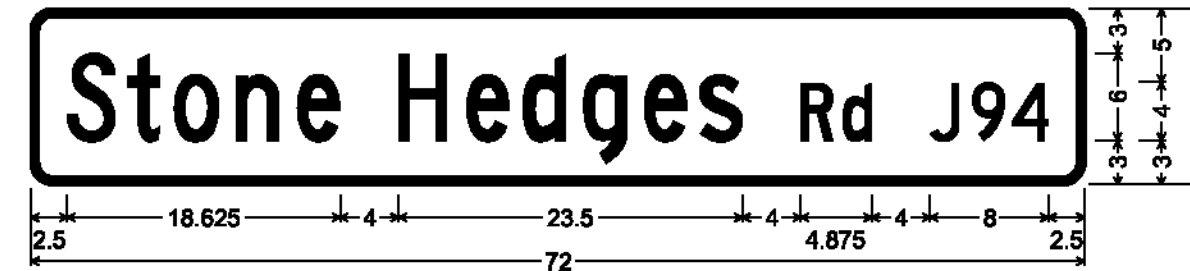


DOUBLE-SIDED STREET SIGN (JAMAICA);
1.500" Radius, 0.500" Border, White on Green;
[Stone Hedges] C 80% spacing; [Rd] C 80% spacing; [J94] C 80% spacing;

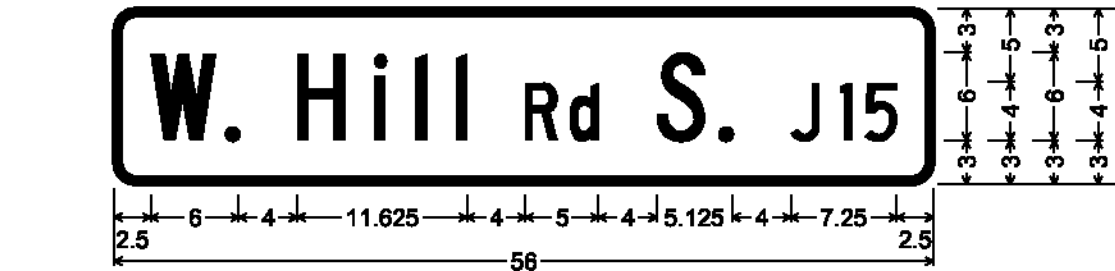

DOUBLE-SIDED STREET SIGN (JAMAICA);
1.500" Radius, 0.500" Border, White on Green;
[W. Hill] C; [Rd] C; [S.] C; [J15] C;

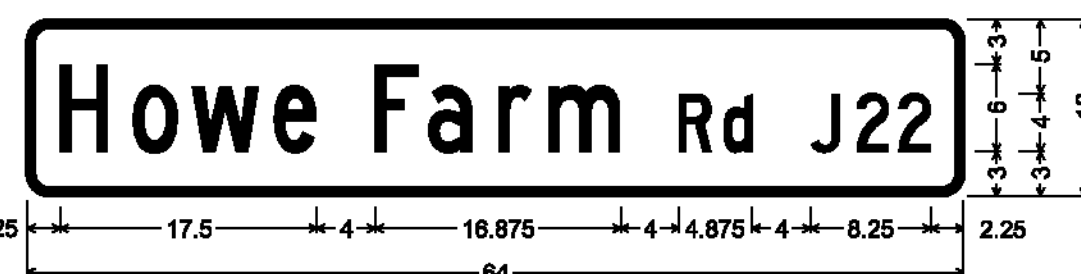

DOUBLE-SIDED STREET SIGN (JAMAICA);
1.500" Radius, 0.500" Border, White on Green;
[Howe Farm] C; [Rd] C; [J22] C;

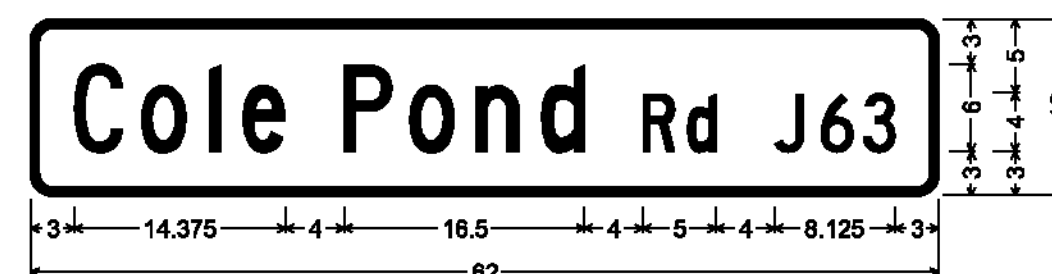

DOUBLE-SIDED STREET SIGN (JAMAICA);
1.500" Radius, 0.500" Border, White on Green;
[Cole Pond] C; [Rd] C; [J63] C;




DOUBLE-SIDED STREET SIGN (JAMAICA);
1.500" Radius, 0.500" Border, White on Green;
[Pikes Falls] C; [Rd] C; [J1] C;




DOUBLE-SIDED STREET SIGN (JAMAICA);
1.500" Radius, 0.500" Border, White on Green;
[Gilfeather] C; [Ln] C; [J21] C;



DOUBLE-SIDED STREET SIGN (JAMAICA);
1.500" Radius, 0.500" Border, White on Green;
[Goodaleville] C; [Rd] C; [J4] C;

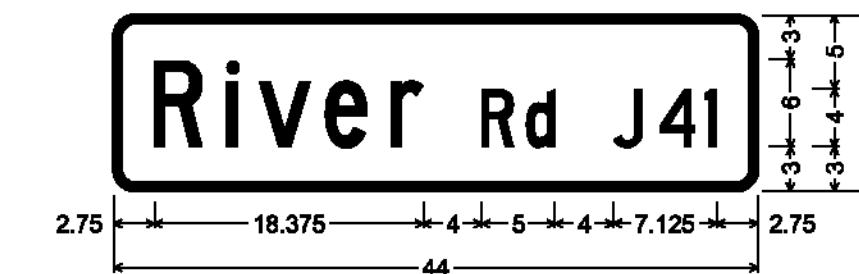

DOUBLE-SIDED STREET SIGN (JAMAICA);
1.500" Radius, 0.500" Border, White on Green;
[River] C; [Rd] C; [J41] C;

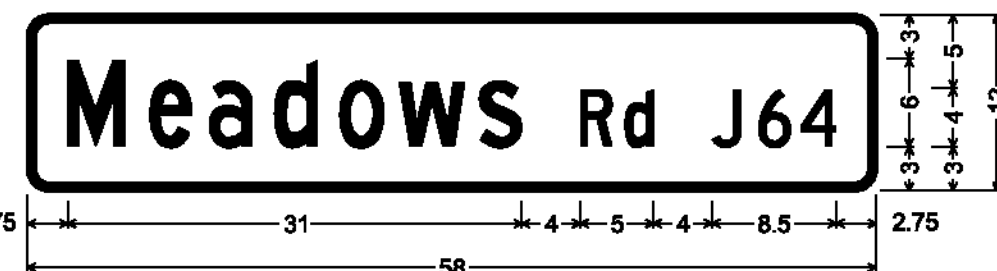

DOUBLE-SIDED STREET SIGN (JAMAICA);
1.500" Radius, 0.500" Border, White on Green;
[Meadows] C; [Rd] C; [J64] C;



DOUBLE-SIDED STREET SIGN (JAMAICA);
1.500" Radius, 0.500" Border, White on Green;
[Diers] C; [Rd] C; [J9] C;

ALL SIGNS ON THIS PAGE ARE SIGN CODE D3-I
(ALL SIGNS ARE DOUBLE-SIDED)

NOT TO SCALE

ALL DIMENSIONS SHOWN IN INCHES, EXCEPT WHERE NOTED.

PROJECT NAME:	STATEWIDE SW REGION	PLOT DATE:	13-FEB-2013
PROJECT NUMBER:	STPG SIGN (41)	DRAWN BY:	J. KELLY
FILE NAME:	I2CI18.SD_8	CHECKED BY:	A. GAMBLE
PROJECT LEADER:	A. GAMBLE	SIGN DETAILS:	8
DESIGNED BY:	J. KELLY	SHEET:	II
		OF:	97



DOUBLE-SIDED STREET SIGN (WELLS);
1.500" Radius, 0.500" Border, White on Green;
[Hilltop] C; [Rd] C;



DOUBLE-SIDED STREET SIGN (POWNA);
1.500" Radius, 0.500" Border, White on Green;
[Cedar Hill] C; [Rd] C;



DOUBLE-SIDED STREET SIGN (POWNA);
1.500" Radius, 0.500" Border, White on Green;
[Church] C; [St] C;



DOUBLE-SIDED STREET SIGN (POULTNEY);
1.500" Radius, 0.500" Border, White on Green;
[Ruby] C; [Rd] C;



DOUBLE-SIDED STREET SIGN (POWNA);
1.500" Radius, 0.500" Border, White on Green;
[Tubs] C; [Rd] C;



DOUBLE-SIDED STREET SIGN (POULTNEY);
1.500" Radius, 0.500" Border, White on Green;
[Upper] C; [Rd] C;



DOUBLE-SIDED STREET SIGN (POWNA);
1.500" Radius, 0.500" Border, White on Green;
[Indian Massacre] C; [Rd] C;



DOUBLE-SIDED STREET SIGN (POULTNEY);
1.500" Radius, 0.500" Border, White on Green;
[Jones] C; [Rd] C;



DOUBLE-SIDED STREET SIGN (POWNA);
1.500" Radius, 0.500" Border, White on Green;
[Dean] C; [Rd] C;



DOUBLE-SIDED STREET SIGN (POULTNEY);
1.500" Radius, 0.500" Border, White on Green;
[New Boston] C; [Rd] C;



DOUBLE-SIDED STREET SIGN (POWNA);
1.500" Radius, 0.500" Border, White on Green;
[Lincoln] C; [St] C;



DOUBLE-SIDED STREET SIGN (POWNA);
1.500" Radius, 0.500" Border, White on Green;
[Oak Hill School] C; [Rd] C;



DOUBLE-SIDED STREET SIGN (POWNA);
1.500" Radius, 0.500" Border, White on Green;
[Main] C; [St] C;




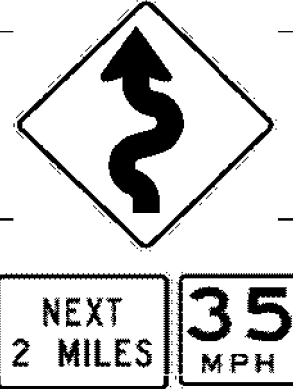
ALL DIMENSIONS SHOWN IN INCHES, EXCEPT WHERE NOTED.



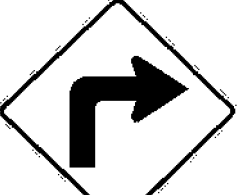

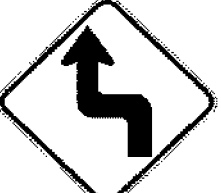

ALL SIGNS ON THIS PAGE ARE SIGN CODE D3-1
(ALL SIGNS ARE DOUBLE-SIDED)



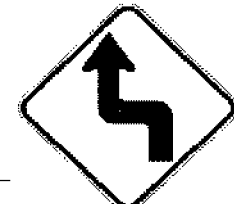

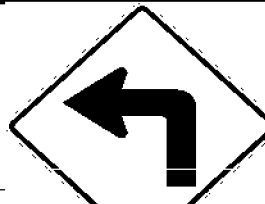

NOT TO SCALE




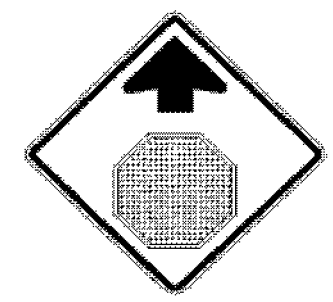




PROJECT NAME: STATEWIDE SW REGION	
PROJECT NUMBER: STPG SIGN (41)	
FILE NAME: I2CI18.SD_9	PLOT DATE: 13-FEB-2013
PROJECT LEADER: A. GAMBLE	DRAWN BY: J. KELLY
DESIGNED BY: J. KELLY	CHECKED BY: A. GAMBLE
SIGN DETAILS 9	SHEET 12 OF 97

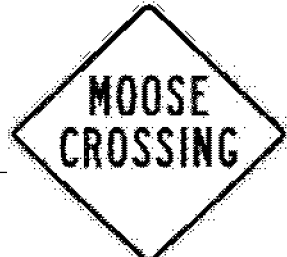

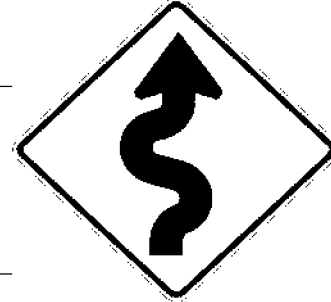

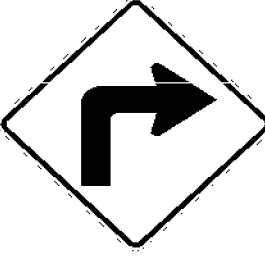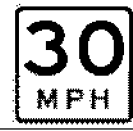

DIRECTION	MILEPOINT	LOCATION CODE (SHEET 2)	SIGN CODE	WIDTH (IN)	HEIGHT (IN)	SHEETING REMARKS	SIGN LEGEND	NEW SIGNS		EXISTING SIGNS				EXIST POST		NUMBER OF NEW POSTS	SQUARE STEEL (IN)			TUBULAR STEEL Ø (IN)				SIGN FRAME REQUIRED	REMARKS	SIGN DETAIL LOCATION			
								"A"	"B"	RETAIN	SALVAGE FROM	SALVAGE TO	REMOVE	RETAIN	REMOVE		1.75	2.00	2.50	FOUNDATION	3.00	3.50	4.00			5.00	SHSM	PROJECT SHEET #	STANDARD SHEET #
																	(LB / FT)				(LB / FT)								
READSBORO VT-8 NB							FY-FLUORESCENT YELLOW FYG-FLUORESCENT YELLOW GREEN																"SHSM"-STANDARD HIGHWAY SIGNS AND MARKINGS						
NB	0.009	A	VD-700	6	10																								
		B	R1-1	30	30																								
		A	VD-700	6	10			0.42																INSTALL NEW SIGN ON EXISTING FLANGED CHANNEL SIGN POST.	X				
		B	R1-1	30	30			6.25																					
NB	0.027	A	M3-1	24	12		ROUTE MARKER ASSEMBLY.																						
		A	M1-5	24	24																								
		A	M4-5	24	12																								
		A	M1-5	24	24																			SIGN NOT FOUND IN THE FIELD					
		A	M3-1	24	12			2.00																			5	E-136B	
		A	M1-5	24	24			4.00																				E-136B	
		A	M4-5	24	12			2.00																				E-136B	
		A	M1-5	24	24			4.00																				E-136B	
NB	0.050	A	W1-1L	30	30		LEFT TURN																						
		A	W13-1	18	18		30 MPH ADVISORY																						
		A	VD2-1	72	12			6.00																			8		
		A	VD2-1	72	12			6.00																			8		
		A	VD2-1	72	12			6.00																			8		
SIGN SUMMARY SHEET							SHEET TOTALS	36.67 36.25	0.00	0	0	0	7	0	0	4	60.0	0	0.0	0.0	0.0	0.0		PROJECT NAME: STATEWIDE SOUTHWEST REGION PROJECT NUMBER: STPG SIGN(41)					
								SF	SF	EA	EA	EA	EA	EA	EA	EA	FT	EA	LB	LB	LB	LB		FILE NAME: 12C118 PROJECT MANAGER: A. GAMBLE DESIGNED BY: J. KELLY READSBORO NB SHEET 1					
VERMONT AGENCY OF TRANSPORTATION							TOWN DIRECTIONAL TOTALS	90.59 89.8	0.0	1	0	0	18	0	0	13	195.0	0		0.0				PLOT DATE: 2/21/2013 DRAWN BY: J. KELLY CHECKED: A. GAMBLE SHEET 13 OF 97					








DIRECTION	MILEPOINT	LOCATION CODE (SHEET 2)	SIGN CODE	WIDTH (IN)	HEIGHT (IN)	SHEETING REMARKS	SIGN LEGEND	NEW SIGNS		EXISTING SIGNS				EXIST POST		NUMBER OF NEW POSTS	SQUARE STEEL (IN)			TUBULAR STEEL Ø (IN)				SIGN FRAME REQUIRED	REMARKS	SIGN DETAIL LOCATION			
								"A"	"B"	RETAIN	SALVAGE FROM	SALVAGE TO	REMOVE	RETAIN	REMOVE		1.75	2.00	2.50	FOUNDATION	3.00	3.50	4.00			5.00	SHSM	PROJECT SHEET #	STANDARD SHEET #
																	(LB / FT)				(LB / FT)								
READSBORO VT-8 NB							FY-FLUORESCENT YELLOW FYG-FLUORESCENT YELLOW GREEN															"SHSM"-STANDARD HIGHWAY SIGNS AND MARKINGS							
NB	0.057	A	D3-1	UNK	UNK																		OLD COUNTY LN (TH-31)						
		A	D3-1	54	12			4.50																FIELD LOCATE AS TO NOT BLOCK ANY OTHER SIGNAGE.		11			
NB	0.065	C	VR-017	24	30																			OLD COUNTY LN (TH-31)					
		C	VR-017	24	30			5.00																		6			
NB	0.071	C	VD-700	6	10																			OLD COUNTY LN (TH-31)					
		D	R1-1	30	30			0.42																					
		D	R1-1	30	30			6.25																	X				
NB	0.105	A	D2-1	72	10		DESTINATION SIGN ASSEMBLY																						
		A	D2-1	72	10																								
		A	D2-1	72	10																								
NB	0.268	A	W1-5L	48	48		LEFT WINDING CURVES																	SIGN ASSEMBLY NOT FOUND					
		A	W7-3A	24	18		NEXT 2 MILES																						
		A	W13-1	18	18		35 MPH ADVISORY																						
NB	0.279	A	W1-5L	30	30																			INSTALL 60 FEET NORTH OF EXISTING WINDING ROAD SIGN ASSEMBLY.	X				
		A	W7-3A	24	18			3.00																	X				
		A	W13-1P	18	18			2.25																	X				
SIGN SUMMARY SHEET							SHEET TOTALS	27.67 27.25	0.00	0	0	0	7 9	0	0	6	90.0	0	0.0	0.0	0.0	0.0	PROJECT NAME: STATEWIDE SOUTHWEST REGION PROJECT NUMBER: STPG SIGN(41)						
VERMONT AGENCY OF TRANSPORTATION							TOWN DIRECTIONAL TOTALS	90.59 89.8	0.0	1	0	0	18	0	0	13	195.0	0		0.0			FILE NAME: 12C118 PROJECT MANAGER: A. GAMBLE DESIGNED BY: J. KELLY READSBORO NB SHEET 2						
																						PLOT DATE: 2/21/2013 DRAWN BY: J. KELLY CHECKED: A. GAMBLE SHEET 14 OF 97							






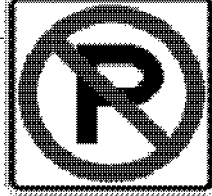


DIRECTION	MILEPOINT	LOCATION CODE (SHEET 2)	SIGN CODE	WIDTH (IN)	HEIGHT (IN)	SHEETING REMARKS	SIGN LEGEND	NEW SIGNS		EXISTING SIGNS				EXIST POST		NUMBER OF NEW POSTS	SQUARE STEEL (IN)			TUBULAR STEEL Ø (IN)				SIGN FRAME REQUIRED	REMARKS	SIGN DETAIL LOCATION			
								"A"	"B"	RETAIN	SALVAGE FROM	SALVAGE TO	REMOVE	RETAIN	REMOVE		1.75	2.00	2.50	FOUNDATION	3.00	3.50	4.00			5.00	SHSM	PROJECT SHEET #	STANDARD SHEET #
																	(LB / FT)				(LB / FT)								
READSBORO VT-8 NB							FY-FLUORESCENT YELLOW FYG-FLUORESCENT YELLOW GREEN															"SHSM"-STANDARD HIGHWAY SIGNS AND MARKINGS							
NB	0.380	A	VW-000	30	30		 	6.25							1	14'-6" X								INSTALL 525 FEET NORTH OF NEW WINDING ROAD SIGN ASSEMBLY (& SOUTH OF BRIDGE).		7			
		A	W7-3A	24	18			3.00															X						
NB	0.860	A	W1-1R	30	30		 	6.25							1	16'-4" X								INSTALL 325 FEET SOUTH OF EXISTING LEFT REVERSE TURN SIGN ASSEMBLY.	X				
		A	W13-1P	18	18			2.25															X						
NB	0.920	A	W1-3L	30	30		LEFT REVERSE TURN																						
		A	W13-1	18	18		30 MPH ADVISORY																						
NB	0.960	A	W1-3L	30	30		 	6.25							1	15'-0" X								INSTALL 200 FEET NORTH OF EXISTING LEFT REVERSE TURN SIGN ASSEMBLY.	X				
		A	W13-1P	18	18			2.25															X						
NB	1.275	A	VD11-6H	30	30		FOLDING SNOWMOBILE			1																			
NB	0.800	A	W1-1R	30	30		RIGHT TURN																						
		A	W13-1	18	18		30 MPH ADVISORY																						
SIGN SUMMARY SHEET							SHEET TOTALS	26.25	0.00	1	0	0	4 2-	0	0	3	45.0	0	0.0	0.0	0.0	0.0	PROJECT NAME: STATEWIDE SOUTHWEST REGION PROJECT NUMBER: STPG SIGN(41)						
VERMONT AGENCY OF TRANSPORTATION							TOWN DIRECTIONAL TOTALS	90.59 -89.8	0.0	1	0	0	18	0	0	13	195.0	0		0.0			FILE NAME: 12C118 PROJECT MANAGER: A. GAMBLE DESIGNED BY: J. KELLY READSBORO NB SHEET 3						
																					PLOT DATE: 2/21/2013 DRAWN BY: J. KELLY CHECKED: A. GAMBLE SHEET 15 OF 97								

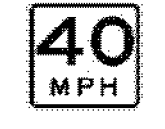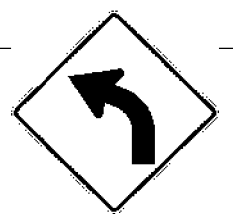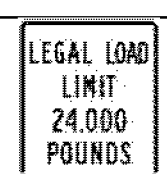DIRECTION	MILEPOINT	LOCATION CODE (SHEET 2)	SIGN CODE	WIDTH (IN)	HEIGHT (IN)	SHEETING REMARKS	SIGN LEGEND	NEW SIGNS		EXISTING SIGNS				EXIST POST		NUMBER OF NEW POSTS	SQUARE STEEL (IN)			TUBULAR STEEL Ø (IN)				SIGN FRAME REQUIRED	REMARKS	SIGN DETAIL LOCATION									
								"A"	"B"	RETAIN	SALVAGE FROM	SALVAGE TO	REMOVE	RETAIN	REMOVE		1.75	2.00	2.50	FOUNDATION	3.00	3.50	4.00			5.00	SHSM	PROJECT SHEET #	STANDARD SHEET #						
																	(LB / FT)				(LB / FT)														
READSBORO VT-8 SB							FY-FLUORESCENT YELLOW FYG-FLUORESCENT YELLOW GREEN																"SHSM"-STANDARD HIGHWAY SIGNS AND MARKINGS												
SB	2.060	F	W1-5R	30	30			6.25															2	14'-3" 14'-2" X								INSTALL 425 FEET SOUTH OF SMALL GRAVEL PULL-OFF (AT MP 2.14).	X		
		F	W7-3A	24	18				3.00																							X			
		F	W13-1P	18	18				2.25																								X		
SB	1.435	F	VW11-6H	30	30		FOLDING SNOWMOBILE			1																									
SB	1.163	F	W1-3L	30	30			6.25															1	13'-9" X								X			
		F	W13-1P	18	18				2.25																								X		
SB	1.135	F	W1-3L	30	30		LEFT REVERSE TURN																												
		F	W13-1P	18	18		30 MPH ADVISORY																												
SB	0.948	F	W1-1L	30	30		LEFT TURN																												
		F	W13-1P	18	18		30 MPH ADVISORY																												
SB	0.908	F	W1-1L	30	30			6.25															1	15'-0" X								X			
		F	W13-1	18	18				2.25																								X		
SB	0.200	F	W1-1MR	30	30		MODIFIED RIGHT TURN WITH SIDE ROADS																												
		F	W13-1	18	18																														
		F	VD-700	6	10																														
SIGN SUMMARY SHEET							SHEET TOTALS	28.50	0.00	1	0	0	7	0	0	4	60.0	0	0.0	0.0	0.0	0.0		PROJECT NAME: STATEWIDE SOUTHWEST REGION											
								SF	SF	EA	EA	EA	EA	EA	EA	EA	FT	EA	LB	LB	LB	LB		PROJECT NUMBER: STPG SIGN(41)											
																								FILE NAME: 12C118											
VERMONT AGENCY OF TRANSPORTATION							TOWN DIRECTIONAL TOTALS	124.27	0.0	1	0	0	27	0	0	12	180.0	0		0.0				PROJECT MANAGER: A. GAMBLE											
																							DESIGNED BY: J. KELLY												
																							CHECKED: A. GAMBLE												
																							READSBORO SB SHEET 1												
																							PLOT DATE: 2/13/2013												
																							DRAWN BY: J. KELLY												
																							SHEET 16 OF 97												






DIRECTION	MILEPOINT	LOCATION CODE (SHEET 2)	SIGN CODE	WIDTH (IN)	HEIGHT (IN)	SHEETING REMARKS	SIGN LEGEND	NEW SIGNS		EXISTING SIGNS				EXIST POST		NUMBER OF NEW POSTS	SQUARE STEEL (IN)			TUBULAR STEEL Ø (IN)				SIGN FRAME REQUIRED	REMARKS	SIGN DETAIL LOCATION			
								"A"	"B"	RETAIN	SALVAGE FROM	SALVAGE TO	REMOVE	RETAIN	REMOVE		1.75	2.00	2.50	FOUNDATION	3.00	3.50	4.00			5.00	SHSM	PROJECT SHEET #	STANDARD SHEET #
																	(LB / FT)				(LB / FT)								
READSBORO VT-8 SB							FY-FLUORESCENT YELLOW FYG-FLUORESCENT YELLOW GREEN															"SHSM"-STANDARD HIGHWAY SIGNS AND MARKINGS							
		F	W1-1R	30	30			6.25								1	18'-3" X								X				
		F	W13-1P	18	18			2.25																	X				
		F	VD-700	6	10			0.42																			E-138		
SB	0.161	F	W3-1	30	30								1																
		F	W3-1	30	30			6.25								1	14'-4" X								X				
SB	0.123	F	M2-1	21	15								1																
		F	M1-5	30	24								1																
		F	M2-1	21	15			2.19								1	15'-0" X										E-136B		
		F	M1-5	30	24			5.00																			E-136B		
SB	0.086	F	D1-1A	72	10		DESTINATION SIGN ASSEMBLY						1																
		F	D1-1A	72	10								1																
		F	D1-1A	72	10								1																
		F	D1-1M	72	10								1																
		F	VD1-1A	72	12			6.00							2	14'-8" 15'-2" X										9			
		F	VD1-1A	72	12			6.00																			9		
SIGN SUMMARY SHEET							SHEET TOTALS	34.36	0.00	0	0	0	7	0	0	5	75.0	0	0.0	0.0	0.0	0.0	0.0	PROJECT NAME: STATEWIDE SOUTHWEST REGION					
								SF	SF	EA	EA	EA	EA	EA	EA	EA	FT	EA	LB	LB	LB	LB	LB	PROJECT NUMBER: STPG SIGN(41)					
VERMONT AGENCY OF TRANSPORTATION							TOWN DIRECTIONAL TOTALS	124.27 123.4	0.0	1	0	0	27	0	0	12	180.0	0		0.0			FILE NAME: 12C118	PROJECT MANAGER: A. GAMBLE	PLOT DATE: 2/13/2013				
																						DESIGNED BY: J. KELLY	CHECKED: A. GAMBLE	DRAWN BY: J. KELLY					
																							READSBORO SB SHEET 2	SHEET 17	OF 97				

DIRECTION	MILEPOINT	LOCATION CODE (SHEET 2)	SIGN CODE	WIDTH (IN)	HEIGHT (IN)	SHEETING REMARKS	SIGN LEGEND	NEW SIGNS		EXISTING SIGNS				EXIST POST		NUMBER OF NEW POSTS	SQUARE STEEL (IN)			TUBULAR STEEL Ø (IN)				SIGN FRAME REQUIRED	REMARKS	SIGN DETAIL LOCATION			
								"A"	"B"	RETAIN	SALVAGE FROM	SALVAGE TO	REMOVE	RETAIN	REMOVE		1.75	2.00	2.50	FOUNDATION	3.00	3.50	4.00			5.00	SHSM	PROJECT SHEET #	STANDARD SHEET #
																	(LB / FT)				(LB / FT)								
READSBORO VT-8 SB							FY-FLUORESCENT YELLOW FYG-FLUORESCENT YELLOW GREEN																"SHSM"-STANDARD HIGHWAY SIGNS AND MARKINGS						
		F	VD1-1A	72	12			6.00																		9			
		F	VD1-1A	72	12			6.00																		9			
SB	0.073	G	VR-017	24	30								1	X									OLD COUNTY LN (TH-31)						
		C	VR-017	24	30			5.00																	6				
SB	0.067	A	D3-1	UNK	UNK																		SIGN NOT FOUND IN FIELD OLD COUNTY LN (TH-31)						
		A	D3-1	54	12			4.50							2								FIELD LOCATE AS TO NOT BLOCK ANY OTHER SIGNAGE.		11				
SB	0.067	G	VD-700	6	10																		OLD COUNTY LN (TH-31)						
		H	R1-1	30	30																		OLD COUNTY LN (TH-31)						
		G	VD-700	6	10																		INSTALL ON EXISTING FLANGED CHANNEL SIGN POST.	X					
		H	R1-1	30	30		 	0.42 6.25																					
SB	0.048	F	M3-1	24	12		ROUTE MARKER ASSEMBLY																RETAIN POSTS, FRAME AND FOUNDATIONS.						
		F	M1-5	30	24																								
		F	M6-1	21	15																		SIGN NOT FOUND IN FIELD						
		F	M3-3	24	12																								
		F	M1-5	24	24																								
		F	M6-1	21	15																								
		F	M3-3	24	12																								
SIGN SUMMARY SHEET							SHEET TOTALS	28.17 27.75	0.00	0	0	0	9 10	0	0	2	30.0	0	0.0	0.0	0.0	0.0	PROJECT NAME: STATEWIDE SOUTHWEST REGION PROJECT NUMBER: STPG SIGN(41)						
VERMONT AGENCY OF TRANSPORTATION							TOWN DIRECTIONAL TOTALS	124.27 123.4	0.0	1	0	0	27	0	0	12	180.0	0		0.0			FILE NAME: 12C118 PROJECT MANAGER: A. GAMBLE DESIGNED BY: J. KELLY READSBORO SB SHEET 3	PLOT DATE: 2/13/2013 DRAWN BY: J. KELLY CHECKED: A. GAMBLE SHEET 18 OF 97					




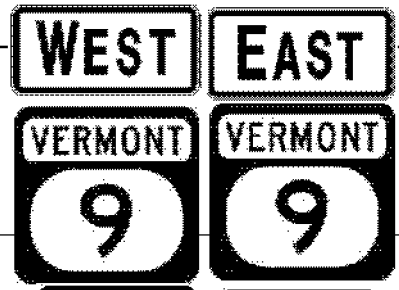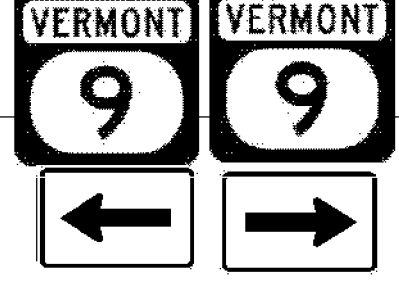


DIRECTION	MILEPOINT	LOCATION CODE (SHEET 2)	SIGN CODE	WIDTH (IN)	HEIGHT (IN)	SHEETING REMARKS	SIGN LEGEND	NEW SIGNS		EXISTING SIGNS				EXIST POST		NUMBER OF NEW POSTS	SQUARE STEEL (IN)			TUBULAR STEEL Ø (IN)				SIGN FRAME REQUIRED	REMARKS	SIGN DETAIL LOCATION				
								"A"	"B"	RETAIN	SALVAGE FROM	SALVAGE TO	REMOVE	RETAIN	REMOVE		1.75	2.00	2.50	FOUNDATION	3.00	3.50	4.00			5.00	SHSM	PROJECT SHEET #	STANDARD SHEET #	
																	(LB / FT)				(LB / FT)									
SEARSBURG VT-8 NB							FY-FLUORESCENT YELLOW FYG-FLUORESCENT YELLOW GREEN																"SHSM"-STANDARD HIGHWAY SIGNS AND MARKINGS							
NB	0.000	C	VD-700	6	10		MILEMARKERS (2)			2																				
		C	VD-024	72	10		TOWN LINE SIGN ASSEMBLY			1				X																
NB	0.200	A	W1-5L	30	30		LEFT WINDING ROAD																							
		A	W7-3A	24	18		NEXT 2 MILES																							
NB	0.510	A	W1-2L	30	30		LEFT CURVE																							
		A	W13-1	18	18		40 MPH ADVISORY																							
		A	W1-5L	30	30			6.25																					X	
		A	W7-3A	24	18			3.00																					X	
NB	0.560	A	W1-2L	30	30			6.25																					X	
NB	0.825	A	VW-054R	30	30		HIDDEN DRIVE RIGHT																							
NB	1.140	A	W1-2L	30	30			6.25																					X	
		A	W13-1P	18	18			2.25																					X	
NB	1.645	A	W7-1	30	30		HILL SYMBOL																							
		A	W1-2L	30	30			6.25																					X	
NB	1.670	C	VR-017	24	30																									
		C	VR-017	24	30			5.00																						
SIGN SUMMARY SHEET							SHEET TOTALS	35.25	0.00	3 1	0	0	6 7	0	0	5	75.0	0	0.0	0.0	0.0	0.0	0.0	0.0	0.0	PROJECT NAME: STATEWIDE SOUTHWEST REGION				
								SF	SF	EA	EA	EA	EA	EA	EA	EA	FT	EA	LB	LB	LB	LB	LB	LB	PROJECT NUMBER: STPG SIGN(41)					
VERMONT AGENCY OF TRANSPORTATION							TOWN DIRECTIONAL TOTALS	158.57 151.9	0.0	3 1	0	0	37 32	0	0	23 22	345.0 330.0	0			0.0				FILE NAME: 12C118					
																								PROJECT MANAGER: A. GAMBLE						
																								PLOT DATE: 2/13/2013						
																								DRAWN BY: J. KELLY						
																								CHECKED: A. GAMBLE						
																								SEARSBURG NB SHEET 1						
																								SHEET 20 OF 97						






DIRECTION	MILEPOINT	LOCATION CODE (SHEET 2)	SIGN CODE	WIDTH (IN)	HEIGHT (IN)	SHEETING REMARKS	SIGN LEGEND	NEW SIGNS		EXISTING SIGNS				EXIST POST		NUMBER OF NEW POSTS	SQUARE STEEL (IN)			TUBULAR STEEL Ø (IN)				SIGN FRAME REQUIRED	REMARKS	SIGN DETAIL LOCATION			
								"A"	"B"	RETAIN	SALVAGE FROM	SALVAGE TO	REMOVE	RETAIN	REMOVE		1.75	2.00	2.50	FOUNDATION	3.00	3.50	4.00			5.00	SHSM	PROJECT SHEET #	STANDARD SHEET #
																	(LB / FT)				(LB / FT)								
SEARSBURG VT-8 NB							FY-FLUORESCENT YELLOW FYG-FLUORESCENT YELLOW GREEN															"SHSM"-STANDARD HIGHWAY SIGNS AND MARKINGS							
NB	1.675	A	D3-1	UNK	UNK																		HAGER LN (TH-5)						
		A	D3-1	34	12			2.83															INSTALL ABOVE STOP SIGN WITH BRACKET.		11				
		C	VD-700	6	10																								
		D	R1-1	30	30																		HAGER LN (TH-5)						
		C	VD-700	6	10			0.42																					
		D	R1-1	30	30			6.25																X					
NB	1.692	A	VW-054L	30	30			6.25															INSTALL 90 FEET NORTH OF STOP SIGN FOR HAGER LANE AND SOUTH OF UTILITY POLE.		7				
NB	2.000	A	R8-3A	24	24																								
		A	R7-201a	12	6																								
		A	VR-644P	24	12																								
		A	R3-9cP	30	12			2.50																X					
		A	R8-3	24	24			4.00																X					
NB	2.038	A	W1-5L	30	30		LEFT WINDING ROAD																						
		A	W13-1	18	18		35 MPH ADVISORY																						
NB	2.080	A	R7-201a	12	6																								
		A	R8-3A	24	30																								
		A	R8-3	24	30			4.00																X					
NB	2.120	A	W1-2L	30	30			6.25															INSTALL AT NORTHERLY END OF GRAVEL PULL OFF AND 10 FEET SOUTH OF UTILITY POLE WITH GUY WIRES.	X					
NB	2.156	A	R7-201a	12	6																								
		A	R8-3A	24	24																								
SIGN SUMMARY SHEET							SHEET TOTALS	32.50 32.08	0.00	0	0	0	12 8	0	0	5	75.0	0	0.0	0.0	0.0	0.0	PROJECT NAME: STATEWIDE SOUTHWEST REGION						
								SF	SF	EA	EA	EA	EA	EA	EA	EA	FT	EA	LB	LB	LB	LB	PROJECT NUMBER: STPG SIGN(41)						
VERMONT AGENCY OF TRANSPORTATION							TOWN DIRECTIONAL TOTALS	158.57 151.9	0.0	3 1	0	0	37 32	0	0	23 22	345.0 330.0	0		0.0			FILE NAME: 12C118	PROJECT MANAGER: A. GAMBLE	PLOT DATE: 2/13/2013				
																						DESIGNED BY: J. KELLY	CHECKED: A. GAMBLE	DRAWN BY: J. KELLY					
																						SEARSBURG NB SHEET 2	SHEET 21	OF 97					

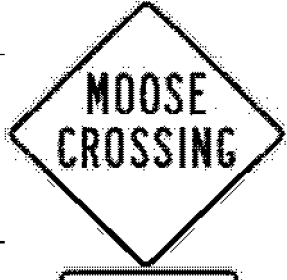


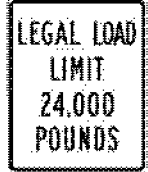

DIRECTION	MILEPOINT	LOCATION CODE (SHEET 2)	SIGN CODE	WIDTH (IN)	HEIGHT (IN)	SHEETING REMARKS	SIGN LEGEND	NEW SIGNS		EXISTING SIGNS				EXIST POST		NUMBER OF NEW POSTS	SQUARE STEEL (IN)			TUBULAR STEEL Ø (IN)				SIGN FRAME REQUIRED	REMARKS	SIGN DETAIL LOCATION									
								"A"	"B"	RETAIN	SALVAGE FROM	SALVAGE TO	REMOVE	RETAIN	REMOVE		1.75	2.00	2.50	FOUNDATION	3.00	3.50	4.00			5.00	SHSM	PROJECT SHEET #	STANDARD SHEET #						
																	(LB / FT)				(LB / FT)														
SEARSBURG VT-8 NB							FY-FLUORESCENT YELLOW FYG-FLUORESCENT YELLOW GREEN																"SHSM"-STANDARD HIGHWAY SIGNS AND MARKINGS												
		A	R8-3	24	24			4.00							1	15'-0" X									X										
NB	2.236	A	R8-3A	24	24																														
		A	R7-201a	12	6																														
		A	M4-6P	24	12																														
		A	R3-9dP	30	12			2.50							1	14'-7" X									X										
		A	R8-3	24	24			4.00																	X										
NB	2.270	A	W1-2R	30	30			6.25							1	15'-0" X									X		INSTALL 180 FEET NORTH OF "END NO PARKING" ASSEMBLY.								
NB	2.540	A	W3-1	30	30																														
		A	W3-1	30	30			6.25							1	14'-6" X									X										
NB	2.595	A	M2-1	21	15		ROUTE MARKER SIGN ASSEMBLY.																												
		A	M1-5	24	24																														
		A	M4-6	24	12																														
		A	M1-5	24	24																														
		A	M2-1	21	15			2.19							2	14'-3" X 14'-2"								#1		5	E-136B								
		A	M1-5	24	24			4.00																			E-136B								
		A	M4-6	24	12			2.00																			E-136B								
SIGN SUMMARY SHEET							SHEET TOTALS			31.19	0.00	0	0	0	8	0	0	6	90.0	0	0.0	0.0	0.0	0.0	PROJECT NAME: STATEWIDE SOUTHWEST REGION										
										SF	SF	EA	EA	EA	EA	EA	EA	EA	FT	EA	LB	LB	LB	LB	PROJECT NUMBER: STPG SIGN(41)										
																													FILE NAME: 12C118						
																														PROJECT MANAGER: A. GAMBLE					
																														DESIGNED BY: J. KELLY					
																														SEARSBURG NB SHEET 3					
																														PLOT DATE: 2/13/2013					
																														DRAWN BY: J. KELLY					
																														CHECKED: A. GAMBLE					
																														SHEET 22 OF 97					
VERMONT AGENCY OF TRANSPORTATION							TOWN DIRECTIONAL TOTALS			158.57		3	0	0	37	0	0	23	345.0	0					0.0										
										151.9	0.0	1	0	0	32	0	0	22	330.0																

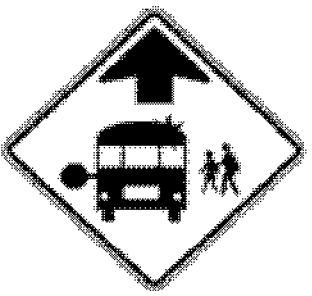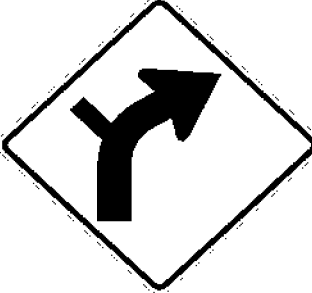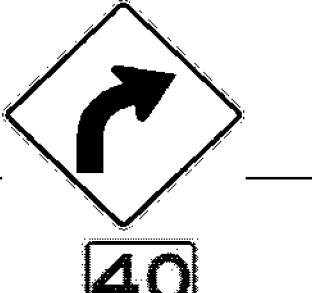
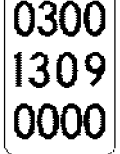
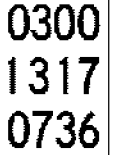

DIRECTION	MILEPOINT	LOCATION CODE (SHEET 2)	SIGN CODE	WIDTH (IN)	HEIGHT (IN)	SHEETING REMARKS	SIGN LEGEND	NEW SIGNS		EXISTING SIGNS				EXIST POST		NUMBER OF NEW POSTS	SQUARE STEEL (IN)			TUBULAR STEEL Ø (IN)				SIGN FRAME REQUIRED	REMARKS	SIGN DETAIL LOCATION												
								"A"	"B"	RETAIN	SALVAGE FROM	SALVAGE TO	REMOVE	RETAIN	REMOVE		1.75	2.00	2.50	FOUNDATION	3.00	3.50	4.00			5.00	SHSM	PROJECT SHEET #	STANDARD SHEET #									
																	(LB / FT)				(LB / FT)																	
SEARSBURG VT-8 NB							FY-FLUORESCENT YELLOW FYG-FLUORESCENT YELLOW GREEN															"SHSM"-STANDARD HIGHWAY SIGNS AND MARKINGS																
		A	M1-5	24	24			4.00																											E-136B			
		A	M6-1L	21	15			2.19																											E-136B			
		A	M3-2	24	12			2.00																												E-136B		
		A	M1-5	24	24			4.00																													E-136B	
		A	M6-1R	21	15			2.19																													E-136B	
NB	2.695	A	R1-1	30	30																																	
		A	R1-1	36	36			9.00																														
NB	2.400	A	W7-1	30	30		HILL SYMBOL																															
		A	W7-1a	30	30			6.25																														
SIGN SUMMARY SHEET								SHEET TOTALS		29.63 23.38	0.00	0	0	0	2 1	0	0	3 2		45.0 30.0	0	0.0	0.0	0.0	0.0	0.0	PROJECT NAME: STATEWIDE SOUTHWEST REGION PROJECT NUMBER: STPG SIGN(41)											
VERMONT AGENCY OF TRANSPORTATION								SF	SF	EA	EA	EA	EA	EA	EA	EA	EA	EA		FT	EA	LB	LB	LB	LB	LB	FILE NAME: 12C118 PROJECT MANAGER: A. GAMBLE DESIGNED BY: J. KELLY SEARSBURG NB SHEET 5			PLOT DATE: 2/13/2013 DRAWN BY: J. KELLY CHECKED: A. GAMBLE SHEET 24 OF 97								
TOWN DIRECTIONAL TOTALS								158.57 151.9	0.0	3 1	0	0	37 32	0	0	23 22		345.0 330.0	0			0.0																


DIRECTION	MILEPOINT	LOCATION CODE (SHEET 2)	SIGN CODE	WIDTH (IN)	HEIGHT (IN)	SHEETING REMARKS	SIGN LEGEND	NEW SIGNS		EXISTING SIGNS				EXIST POST		NUMBER OF NEW POSTS	SQUARE STEEL (IN)			TUBULAR STEEL Ø (IN)				SIGN FRAME REQUIRED	REMARKS	SIGN DETAIL LOCATION						
								"A"	"B"	RETAIN	SALVAGE FROM	SALVAGE TO	REMOVE	RETAIN	REMOVE		1.75	2.00	2.50	FOUNDATION	3.00	3.50	4.00			5.00	SHSM	PROJECT SHEET #	STANDARD SHEET #			
																														(LB / FT)		
SEARSBURG VT-8 SB							FY-FLUORESCENT YELLOW FYG-FLUORESCENT YELLOW GREEN															"SHSM"-STANDARD HIGHWAY SIGNS AND MARKINGS										
SB	2.695	E	R1-1	36	36			9.00								2	13'-5" 13'-11" X								X			ANCHORS IN LEDGE INSTALL DIRECTLY ACROSS FROM EXISTING STOP SIGN.				
SB	2.685	F	M3-3	24	12			2.00								2	14'-2" 14'-4" X						#1A				INSTALL 10 FEET NORTH OF UTILITY POLE.		5	E-136B		
		F	M1-5	24	24			4.00																						E-136B		
		F	M4-5	24	12			2.00																							E-136B	
		F	M1-5	30	24			5.00																							E-136B	
SB	2.670	F	VR-041	24	24		THROUGH WAY BEGINS HERE																									
		E	VR-040	24	24		THROUGH WAY ENDS HERE																									
SB	2.635	F	M3-3	24	12		SOUTH																									
		F	M1-5	24	24		VERMONT 8																									
		F	M4-5	24	12		TO																									
		F	M1-5	30	24		VERMONT 100																									
		F	VD2-1	72	12			6.00								2	13'-3" 13'-6" X															8
		F	VD2-1	72	12			6.00																								8
SB	2.595	F	VD-700	6	10		MILEMARKER																									
		F	D2-1	72	10		HEARTWELLVILLE 6																									
		F	D2-1	72	10		STAMFORD 12																									
SIGN SUMMARY SHEET							SHEET TOTALS	34.00	0.00	0	0	0	0	0	0	6	90.0	0	0.0	0.0	0.0	0.0		PROJECT NAME: STATEWIDE SOUTHWEST REGION								
								SF	SF	EA	EA	EA	EA	EA	EA	EA	FT	EA	LB	LB	LB	LB		PROJECT NUMBER: STPG SIGN(41)								
VERMONT AGENCY OF TRANSPORTATION							TOWN DIRECTIONAL TOTALS	121.5	0.0	0	0	0	0	0	0	19	285.0	0		0.0				FILE NAME: 12C118	PROJECT MANAGER: A. GAMBLE	PLOT DATE: 2/13/2013						
																							DESIGNED BY: J. KELLY	CHECKED: A. GAMBLE	DRAWN BY: J. KELLY							
																							SEARSBURG SB SHEET 1	SHEET 25	OF 97							

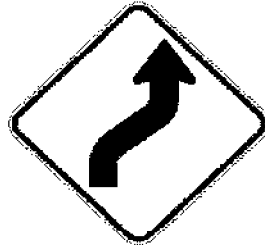





DIRECTION	MILEPOINT	LOCATION CODE (SHEET 2)	SIGN CODE	WIDTH (IN)	HEIGHT (IN)	SHEETING REMARKS	SIGN LEGEND	NEW SIGNS		EXISTING SIGNS				EXIST POST		NUMBER OF NEW POSTS	SQUARE STEEL (IN)			TUBULAR STEEL Ø (IN)				SIGN FRAME REQUIRED	REMARKS	SIGN DETAIL LOCATION			
								"A"	"B"	RETAIN	SALVAGE FROM	SALVAGE TO	REMOVE	RETAIN	REMOVE		1.75	2.00	2.50	FOUNDATION	3.00	3.50	4.00			5.00	SHSM	PROJECT SHEET #	STANDARD SHEET #
																	(LB / FT)				(LB / FT)								
SEARSBURG VT-8 SB							FY-FLUORESCENT YELLOW FYG-FLUORESCENT YELLOW GREEN															"SHSM"-STANDARD HIGHWAY SIGNS AND MARKINGS							
		F	D2-1	72	10		READSBORO 11																	ANCHORS IN LEDGE					
SB	2.542	F	W1-5L	30	30		WINDING ROAD LEFT																						
		F	W13-1	18	18		35 MPH ADVISORY																						
SB	2.510	F	W11-21	30	30		MOOSE SYMBOL																						
		F	W7-3A	24	18																								
		F	VW-000	30	30			6.25																					
		F	W7-3aP	24	18			3.00																					
SB	2.335	F	W1-10L	36	36			9.00																					
		F	W1-10L	36	36																								
SB	2.291	G	VR-017	24	30																								
		G	VR-017	24	30			5.00																					
		F	D3-1	UNK	UNK		PUTNAM RD STREET SIGN																						
SB	2.282	H	R1-1	30	30																								
		F	D3-1	42	12			3.50																					
		H	R1-1	30	30			6.25																					
SB	1.800	F	S3-1T	30	30		SCHOOL BUS STOP AHEAD																						
SIGN SUMMARY SHEET							SHEET TOTALS	33.00	0.00	0	0	0	9	0	0	4	60.0	0	0.0	0.0	0.0	0.0	PROJECT NAME: STATEWIDE SOUTHWEST REGION						
								SF	SF	EA	EA	EA	EA	EA	EA	EA	FT	EA	LB	LB	LB	LB	PROJECT NUMBER: STPG SIGN(41)						
VERMONT AGENCY OF TRANSPORTATION							TOWN DIRECTIONAL TOTALS	121.5	0.0	0	0	0	29 -30	0	0	19	285.0	0		0.0				FILE NAME: 12C118					
																							PLOT DATE: 2/13/2013						
																							PROJECT MANAGER: A. GAMBLE						
																							DRAWN BY: J. KELLY						
																							CHECKED: A. GAMBLE						
																							DESIGNED BY: J. KELLY						
																							SEARSBURG SB SHEET 2						
																							SHEET 26 OF 97						





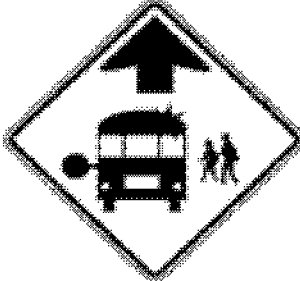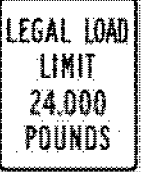


DIRECTION	MILEPOINT	LOCATION CODE (SHEET 2)	SIGN CODE	WIDTH (IN)	HEIGHT (IN)	SHEETING REMARKS	SIGN LEGEND	NEW SIGNS		EXISTING SIGNS				EXIST POST		NUMBER OF NEW POSTS	SQUARE STEEL (IN)			TUBULAR STEEL Ø (IN)				SIGN FRAME REQUIRED	REMARKS	SIGN DETAIL LOCATION			
								"A"	"B"	RETAIN	SALVAGE FROM	SALVAGE TO	REMOVE	RETAIN	REMOVE		1.75	2.00	2.50	FOUNDATION	3.00	3.50	4.00			5.00	SHSM	PROJECT SHEET #	STANDARD SHEET #
																	(LB / FT)				(LB / FT)								
SEARSBURG VT-8 SB							FY-FLUORESCENT YELLOW FYG-FLUORESCENT YELLOW GREEN															"SHSM"-STANDARD HIGHWAY SIGNS AND MARKINGS							
		F	S3-1	36	36	FYG		9.00										14'-2" 15'-2" X								ANCHORS IN LEDGE	X		
SB	1.763	F	W1-2MR	30	30		MODIFIED RIGHT CURVE 					1			X										REMOVE ENTIRE SIGN ASSEMBLY.				
SB	1.730	F	W1-10R	36	36			9.00										17'-7" 16'-7" X								INSTALL 175 FEET SOUTH OF EXISTING RIGHT CURVE SIGN ASSEMBLY.	X		
SB	1.315	F	W1-2R	30	30		RIGHT CURVE					1			X														
		F	W13-1	18	18		35 MPH ADVISORY					1																	
SB	1.253	F	W1-2R	30	30			6.25										13'-0" X								INSTALL 325 FEET SOUTH OF EXISTING RIGHT CURVE SIGN ASSEMBLY.	X		
		F	W13-1P	18	18			2.25																					X
SB	1.070	F	VW-054L	30	30		HIDDEN DRIVE LEFT					1			X														
SB	1.005	F	W1-2L	30	30		LEFT CURVE					4			X											SIGN ASSEMBLY NOT FOUND IN THE FIELD			
		F	W13-1	18	18		40 MPH ADVISORY					4																	
SB	0.338	F	W1-4R	30	30		RIGHT REVERSE CURVE					1			X														
		F	W13-1	18	18		35 MPH ADVISORY					1																	
SB	0.300	F	W2-2L	30	30		SIDE ROAD LEFT					1			X														
		F	W13-1	18	18		35 MPH ADVISORY					1																	
SB	0.270	F	VW-133L	30	30			6.25										14'-10" X								INSTALL 160 FEET SOUTH OF EXISTING SIDE ROAD LEFT ASSEMBLY.		7	
SIGN SUMMARY SHEET							SHEET TOTALS	32.75	0.00	0	0	0	8 10	0	0	6	90.0	0	0.0	0.0	0.0	0.0	0.0	PROJECT NAME: STATEWIDE SOUTHWEST REGION PROJECT NUMBER: STPG SIGN(41)					
VERMONT AGENCY OF TRANSPORTATION							TOWN DIRECTIONAL TOTALS	121.5	0.0	0	0	0	29 30	0	0	19	285.0	0		0.0				FILE NAME: 12C118 PROJECT MANAGER: A. GAMBLE DESIGNED BY: J. KELLY SEARSBURG SB SHEET 3	PROJECT DATE: 2/13/2013 DRAWN BY: J. KELLY CHECKED: A. GAMBLE SHEET 27 OF 97				










DIRECTION	MILEPOINT	LOCATION CODE (SHEET 2)	SIGN CODE	WIDTH (IN)	HEIGHT (IN)	SHEETING REMARKS	SIGN LEGEND	NEW SIGNS		EXISTING SIGNS				EXIST POST		NUMBER OF NEW POSTS	SQUARE STEEL (IN)			TUBULAR STEEL Ø (IN)				SIGN FRAME REQUIRED	REMARKS	SIGN DETAIL LOCATION			
								"A"	"B"	RETAIN	SALVAGE FROM	SALVAGE TO	REMOVE	RETAIN	REMOVE		1.75	2.00	2.50	FOUNDATION	3.00	3.50	4.00			5.00	SHSM	PROJECT SHEET #	STANDARD SHEET #
																	(LB / FT)				(LB / FT)								
SEARSBURG VT-8 SB							FY-FLUORESCENT YELLOW FYG-FLUORESCENT YELLOW GREEN															"SHSM"-STANDARD HIGHWAY SIGNS AND MARKINGS							
SB	0.232	F	W1-4R	30	30			6.25							1	14'-4" X							INSTALL 660 FEET SOUTH OF EXISTING RIGHT REVERSE CURVE SIGN ASSEMBLY.	X					
SB	0.200	F	W7-1	30	30		HILL SYMBOL					1																	
SB	0.095	F	W1-4R	30	30		RIGHT REVERSE CURVE					1																	
		F	W13-1	18	18		35 MPH ADVISORY					1																	
		F	W7-1a	30	30			6.25							1	18'-3" X										X			
		F	W7-3aP	24	18			3.00																		X			
SB	0.010	F	W1-4R	30	30		 	6.25							1	15'-0" X							INSTALL 50 FEET NORTH OF AND ACROSS FROM TOWN LINE SIGN.	X					
SIGN SUMMARY SHEET							SHEET TOTALS	21.75	0.00	0	0	0	3	0	0	3	45.0	0	0.0	0.0	0.0	0.0	PROJECT NAME: STATEWIDE SOUTHWEST REGION	PROJECT NUMBER: STPG SIGN(41)					
VERMONT AGENCY OF TRANSPORTATION							TOWN DIRECTIONAL TOTALS	121.5	0.0	0	0	0	29	0	0	19	285.0	0		0.0		FILE NAME: 12C118	PROJECT MANAGER: A. GAMBLE	PLOT DATE: 2/13/2013	DESIGNED BY: J. KELLY	CHECKED: A. GAMBLE	DRAWN BY: J. KELLY	SHEET 28 OF 97	



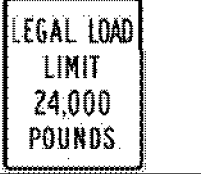





DIRECTION	MILEPOINT	LOCATION CODE (SHEET 2)	SIGN CODE	WIDTH (IN)	HEIGHT (IN)	SHEETING REMARKS	SIGN LEGEND	NEW SIGNS		EXISTING SIGNS				EXIST POST		NUMBER OF NEW POSTS	SQUARE STEEL (IN)			TUBULAR STEEL Ø (IN)				SIGN FRAME REQUIRED	REMARKS	SIGN DETAIL LOCATION			
								"A"	"B"	RETAIN	SALVAGE FROM	SALVAGE TO	REMOVE	RETAIN	REMOVE		1.75	2.00	2.50	FOUNDATION	3.00	3.50	4.00			5.00	SHSM	PROJECT SHEET #	STANDARD SHEET #
																	(LB / FT)				(LB / FT)								
JAMAICA VT-30 NB							FY-FLUORESCENT YELLOW FYG-FLUORESCENT YELLOW GREEN																"SHSM"-STANDARD HIGHWAY SIGNS AND MARKINGS						
NB	0.000	C	VD-700	6	10		MILEMARKERS (2)						2																
		C	VD-024	60	7.5			5.00					1		X											4, 8			
		C	VD-024	72	10			0.42																			E-138		
		C	VD-700	6	10			0.42																			E-138		
NB	0.175	A	VW-202	30	30								1	X															
		A	VW-202	30	30			6.25																			7		
NB	0.600	A	M2-1	21	15		JCT			1					X														
		A	M1-5	30	24		VERMONT ROUTE 100			1																			
NB	0.622	A	D1-1A	72	10		DESTINATION SIGN ASSEMBLY			1					X														
		A	D1-1S	72	10					1																			
		A	D1-1A	72	10					1																			
		A	D1-1A	72	10					1																			
NB	0.662	A	M3-3	24	12		ROUTE MARKER ASSEMBLY			1					X														
		A	M1-5	30	24					1																			
		A	M6-1	21	15					1																			
SIGN SUMMARY SHEET							SHEET TOTALS	12.09	0.00	9	0	0	4 2	0	0	2	30.0	0	0.0	0.0	0.0	0.0	0.0	0.0	PROJECT NAME: STATEWIDE SOUTHWEST REGION				
								SF	SF	EA	EA	EA	EA	EA	EA	EA	FT	EA	LB	LB	LB	LB	LB	LB	PROJECT NUMBER: STPG SIGN(41)				
																									FILE NAME: 12C118				
VERMONT AGENCY OF TRANSPORTATION							TOWN DIRECTIONAL TOTALS	438.5 443.5	0.0	32 29	2 1	2 1	88 78	0	0	63 62	945.0 930.0	0			0.0				PROJECT MANAGER: A. GAMBLE				
																									DESIGNED BY: J. KELLY				
																									PLOT DATE: 2/13/2013				
																									DRAWN BY: J. KELLY				
																									CHECKED: A. GAMBLE				
																									JAMAICA NB SHEET 1				
																									SHEET 29 OF 97				


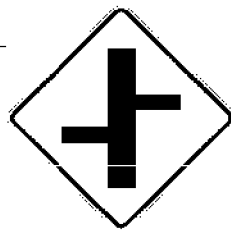
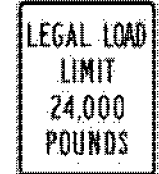


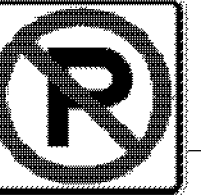
DIRECTION	MILEPOINT	LOCATION CODE (SHEET 2)	SIGN CODE	WIDTH (IN)	HEIGHT (IN)	SHEETING REMARKS	SIGN LEGEND	NEW SIGNS		EXISTING SIGNS				EXIST POST		NUMBER OF NEW POSTS	SQUARE STEEL (IN)			TUBULAR STEEL Ø (IN)				SIGN FRAME REQUIRED	REMARKS	SIGN DETAIL LOCATION								
								"A"	"B"	RETAIN	SALVAGE FROM	SALVAGE TO	REMOVE	RETAIN	REMOVE		1.75	2.00	2.50	FOUNDATION	3.00	3.50	4.00			5.00	SHSM	PROJECT SHEET #	STANDARD SHEET #					
																	(LB / FT)				(LB / FT)													
JAMAICA VT-30 NB							FY-FLUORESCENT YELLOW FYG-FLUORESCENT YELLOW GREEN																"SHSM"-STANDARD HIGHWAY SIGNS AND MARKINGS											
		A	M3-1	24	12					1																								
		A	M1-5	24	24					1																								
		A	M6-3	21	15					1																								
		A	M3-1	24	12					1																								
		A	M1-5	30	24					1																								
		A	M6-3	21	15					1																								
NB	0.675	C	W1-7	48	24		DOUBLE ARROW			1																								
NB	0.700	A	M3-1	24	12		ROUTE MARKER ASSEMBLY			1																								
		A	M1-5	24	24					1																								
		A	M3-1	24	12					1																								
		A	M1-5	30	24					1																								
NB	0.740	A	D2-1	72	10		DESTINATION SIGN ASSEMBLY			1																								
		A	D1-1S	72	10					1																								
NB	0.773	A	R2-1	24	30																													
		A	R2-1	24	30					5.00 6.25																								
SIGN SUMMARY SHEET							SHEET TOTALS			5.00 6.25	0.00	13	0	0	1	0	0	0	0.0	0	0.0	0.0	0.0	0.0	PROJECT NAME: STATEWIDE SOUTHWEST REGION									
										SF	SF	EA	EA	EA	EA	EA	EA	EA	FT	EA	LB	LB	LB	LB	PROJECT NUMBER: STPG SIGN(41)									
VERMONT AGENCY OF TRANSPORTATION							TOWN DIRECTIONAL TOTALS			438.5 443.5	0.0	32 29	2 1	2 1	88 78	0	0	63 62	945.0 930.0	0		0.0				FILE NAME: 12C118 PROJECT MANAGER: A. GAMBLE DESIGNED BY: J. KELLY JAMAICA NB SHEET 2								
																									PLOT DATE: 2/13/2013 DRAWN BY: J. KELLY CHECKED BY: A. GAMBLE SHEET 30 OF 97									

DIRECTION	MILEPOINT	LOCATION CODE (SHEET 2)	SIGN CODE	WIDTH (IN)	HEIGHT (IN)	SHEETING REMARKS	SIGN LEGEND	NEW SIGNS		EXISTING SIGNS				EXIST POST		NUMBER OF NEW POSTS	SQUARE STEEL (IN)			TUBULAR STEEL Ø (IN)				SIGN FRAME REQUIRED	REMARKS	SIGN DETAIL LOCATION			
								"A"	"B"	RETAIN	SALVAGE FROM	SALVAGE TO	REMOVE	RETAIN	REMOVE		1.75	2.00	2.50	FOUNDATION	3.00	3.50	4.00			5.00	SHSM	PROJECT SHEET #	STANDARD SHEET #
																	(LB / FT)				(LB / FT)								
JAMAICA VT-30 NB							FY-FLUORESCENT YELLOW FYG-FLUORESCENT YELLOW GREEN																"SHSM"-STANDARD HIGHWAY SIGNS AND MARKINGS						
NB	0.982	A	D3-1	68	12		Turkey Mtn Rd J20	5.67							2	12'-1" 11'-8" X									INSTALL BEHIND GUARDRAIL AT SOUTH SIDE OF INTERSECTION.		11		
NB	0.984	C	VR-017	24	30							1	X	X											TURKEY MTN RD (TH-20)				
		C	VR-017	24	30			5.00							1	13'-4" X									INSTALL ON EXISTING FLANGED CHANNEL SIGN POST.		6		
NB	0.990	A	D3-1	UNK	UNK		TURKEY MTN RD STREET SIGN					1													TURKEY MTN RD (TH-20)				
		C	VD-700	6	10		MILEMARKER SALVAGED FROM			1																			
		D	R1-1	30	30						1	X	X																
		C	VD-700	6	10			6.25			1					13'-6" X									INSTALL ON EXISTING FLANGED CHANNEL SIGN POST.	X			
		D	R1-1	30	30						1																		
NB	1.380	A	S3-1T	30	30		SCHOOL BUS STOP AHEAD 					1																	
		A	S3-1	36	36	FYG		9.00							2	13'-4" 13'-5" X											X		
NB	1.562	C	VR-017	24	30							1	X												HOWE FARM RD (TH-22)				
		C	VR-017	24	30			5.00																	INSTALL ON EXISTING FLANGED CHANNEL SIGN POST.		6		
NB	1.568	C	VD-700	6	10					1															HOWE FARM RD (TH-22)				
		D	R1-1	30	30			6.25				1	X												INSTALL ON EXISTING FLANGED CHANNEL SIGN POST.	X			
NB	1.571	A	D3-1	UNK	UNK							1													HOWE FARM RD (TH-22)				
		A	D3-1	64	12		Howe Farm Rd J22	5.33							2	13'-9" 13'-0" X									INSTALL ON TWO POSTS AT EXISTING LOCATION.		11		
NB	1.894	C	VR-017	24	30							1	X												GILFEATHER LA (TH-21)				
SIGN SUMMARY SHEET							SHEET TOTALS	42.50	0.00	10	10	10	8	0	0	8	120.0 -90.0									PROJECT NAME: STATEWIDE SOUTHWEST REGION			
								SF	SF	EA	EA	EA	EA	EA	EA	EA	FT	EA	LB	LB	LB	LB	LB		PROJECT NUMBER: STPG SIGN(41)				
VERMONT AGENCY OF TRANSPORTATION							TOWN DIRECTIONAL TOTALS	438.5 -443.5	0.0	32 -29	2 -1	2 -1	88 -78	0	0	63 -62	945.0 -930.0				0.0					FILE NAME: 12C118	PROJECT MANAGER: A. GAMBLE	PLOT DATE: 2/13/2013	
																								DESIGNED BY: J. KELLY	CHECKED: A. GAMBLE	DRAWN BY: J. KELLY	SHEET 31 OF 97		

DIRECTION	MILEPOINT	LOCATION CODE (SHEET 2)	SIGN CODE	WIDTH (IN)	HEIGHT (IN)	SHEETING REMARKS	SIGN LEGEND	NEW SIGNS		EXISTING SIGNS				EXIST POST		NUMBER OF NEW POSTS	SQUARE STEEL (IN)			TUBULAR STEEL Ø (IN)				SIGN FRAME REQUIRED	REMARKS	SIGN DETAIL LOCATION			
								"A"	"B"	RETAIN	SALVAGE FROM	SALVAGE TO	REMOVE	RETAIN	REMOVE		1.75	2.00	2.50	FOUNDATION	3.00	3.50	4.00			5.00	SHSM	PROJECT SHEET #	STANDARD SHEET #
																	(LB / FT)				(LB / FT)								
JAMAICA VT-30 NB							FY-FLUORESCENT YELLOW FYG-FLUORESCENT YELLOW GREEN															"SHSM"-STANDARD HIGHWAY SIGNS AND MARKINGS							
		C	VR-017	24	30			5.00															INSTALL ON EXISTING FLANGED CHANNEL SIGN POST.		6				
NB	1.904	C D	VD-700 R1-1	6 30	10 30					1			1	X									GILFEATHER LA (TH-21)						
		D	R1-1	30	30			6.25															INSTALL ON EXISTING FLANGED CHANNEL SIGN POST.	X					
NB	1.905	A	D3-1	UNK	UNK																		GILFEATHER LA (TH-21)						
		A	D3-1	62	12			5.17															INSTALL ON TWO POSTS AT EXISTING LOCATION.		11				
NB	1.949	A	VW-619	30	30		SHOULDER NARROWS																						
		A	VW-619	36	36			9.00															INSTALL 475 FEET NORTH OF EXISTING, AT SOUTH SIDE OF POLE AND BEFORE END OF RAIL. ANCHORS IN LEDGE		7				
NB	2.646	A	VW-054R	30	30		HIDDEN DRIVE RIGHT			1				X									RELOCATE SIGN 240 FT NORTH TO MP 2.691						
NB	2.691	A	VW-054R	30	30		HIDDEN DRIVE RIGHT				1												RELOCATE SIGN FROM MP 2.646 AND INSTALL AT NORTH END OF SMALL PULL OFF. POST SALVAGED						
NB	3.139	A	W3-5	36	36		SPEED REDUCTION (40)					1		X															
NB	3.243	A	VD-018	30	18		JAMAICA RAWSONVILLE 5 VILLAGE SIGN.					1		X															
		A	W3-5	36	36			9.00																					
NB	3.310	A	R2-1	24	30							1		X															
		A	R2-1	30	36			7.50																					
NB	3.364	A	D3-1	UNK	UNK							1											MEADOWS RD (TH-64)						
SIGN SUMMARY SHEET							SHEET TOTALS	41.92	0.00	1	1	7	0	0	8	120.0	0	0.0	0.0	0.0	0.0	0.0	0.0	PROJECT NAME: STATEWIDE SOUTHWEST REGION					
								SF	SF	EA	EA	EA	EA	EA	EA	FT	EA	LB	LB	LB	LB	LB	LB	PROJECT NUMBER: STPG SIGN(41)					
																								FILE NAME: 12C118	PLOT DATE: 2/13/2013				
VERMONT AGENCY OF TRANSPORTATION							TOWN DIRECTIONAL TOTALS	438.5	443.5	0.0	32	29	2	1	2	88	78	0	0	63	62	945.0	930.0	0	0.0	PROJECT MANAGER: A. GAMBLE	DRAWN BY: J. KELLY		
																									DESIGNED BY: J. KELLY	CHECKED: A. GAMBLE			
																										JAMAICA NB SHEET 4	SHEET 32	OF 97	

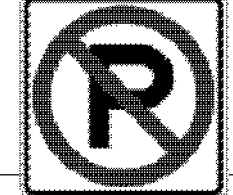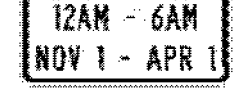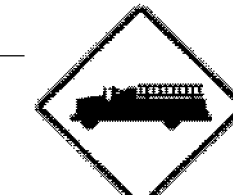



DIRECTION	MILEPOINT	LOCATION CODE (SHEET 2)	SIGN CODE	WIDTH (IN)	HEIGHT (IN)	SHEETING REMARKS	SIGN LEGEND	NEW SIGNS		EXISTING SIGNS				EXIST POST		NUMBER OF NEW POSTS	SQUARE STEEL (IN)			TUBULAR STEEL Ø (IN)				SIGN FRAME REQUIRED	REMARKS	SIGN DETAIL LOCATION			
								"A"	"B"	RETAIN	SALVAGE FROM	SALVAGE TO	REMOVE	RETAIN	REMOVE		1.75	2.00	2.50	FOUNDATION	3.00	3.50	4.00			5.00	SHSM	PROJECT SHEET #	STANDARD SHEET #
																	(LB / FT)				(LB / FT)								
JAMAICA VT-30 NB							FY-FLUORESCENT YELLOW FYG-FLUORESCENT YELLOW GREEN															"SHSM"-STANDARD HIGHWAY SIGNS AND MARKINGS							
NB	3.732	A	VD-062BRN	72	16		BUSINESS SIGN			1				X															
NB	3.606 3.658	A	W11-2	30	30	FYG		6.25								1	13'-11"							X					
		A	W16-9P	24	12	FYG		2.00																X					
NB	3.785	C	VR-017	24	30								1	X															
		C	VR-017	24	30			5.00																			6		
NB	3.787	D	R1-1	30	30								1	X															
		D	R1-1	30	30			6.25								1	9'-6"							X					
NB	3.787	D	D3-1	UNK	UNK		STREET NAME SIGN.						1	X															
		D	D3-1	44	12			3.67								2	11'-9"										11		
NB	3.795	D	R1-1	30	30					1				X															
		D	R1-1	30	30			6.25								4	X							X					
NB	3.810	A	R2-1	24	30			5.00								4	X							X					
NB	3.810	A	R8-3	24	24			4.00								4	X							X					
		A	VR-122	24	12			2.00																			6		
NB	3.853	C	VR-017	24	24								1	X															
SIGN SUMMARY SHEET								SHEET TOTALS		34.17 40.42	0.00	2 1	0	0	4 5	0	0	4 7	60.0 105.0	0	0.0	0.0	0.0	0.0	PROJECT NAME: STATEWIDE SOUTHWEST REGION				
								SF	SF	EA	EA	EA	EA	EA	EA	EA	EA	EA	EA	EA	EA	EA	EA	PROJECT NUMBER: STPG SIGN(41)					
VERMONT AGENCY OF TRANSPORTATION								TOWN DIRECTIONAL TOTALS		438.5 443.5	0.0	32 29	2 1	2 1	88 78	0	0	63 62	945.0 930.0	0		0.0	0.0	0.0	FILE NAME: 12C118	PROJECT MANAGER: A. GAMBLE	PLOT DATE: 2/13/2013		
																							DESIGNED BY: J. KELLY	CHECKED: A. GAMBLE	DRAWN BY: J. KELLY	SHEET 34 OF 97			

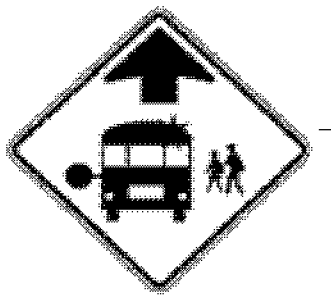






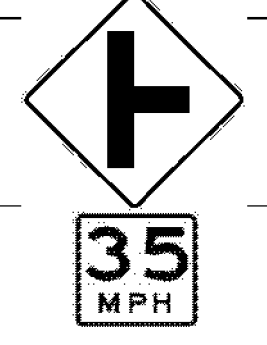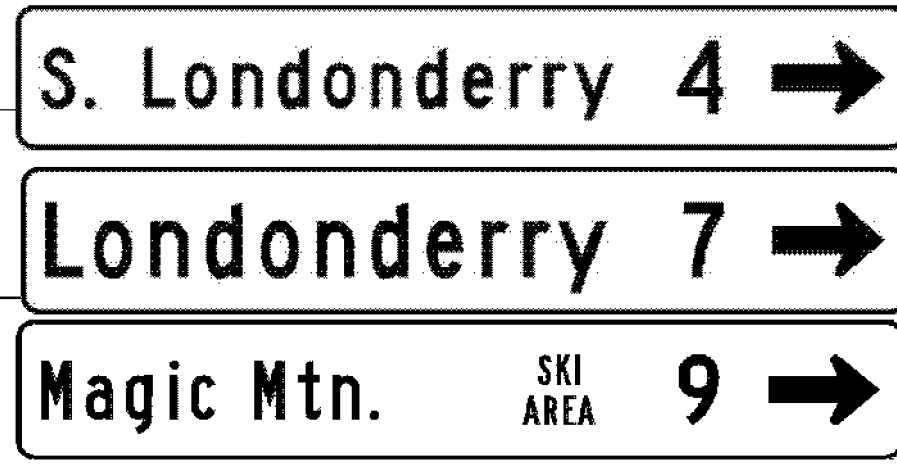

DIRECTION	MILEPOINT	LOCATION CODE (SHEET 2)	SIGN CODE	WIDTH (IN)	HEIGHT (IN)	SHEETING REMARKS	SIGN LEGEND	NEW SIGNS		EXISTING SIGNS				EXIST POST		NUMBER OF NEW POSTS	SQUARE STEEL (IN)			TUBULAR STEEL Ø (IN)				SIGN FRAME REQUIRED	REMARKS	SIGN DETAIL LOCATION					
								"A"	"B"	RETAIN	SALVAGE FROM	SALVAGE TO	REMOVE	RETAIN	REMOVE		1.75	2.00	2.50	FOUNDATION	3.00	3.50	4.00			5.00	SHSM	PROJECT SHEET #	STANDARD SHEET #		
																	(LB / FT)				(LB / FT)										
JAMAICA VT-30 NB							FY-FLUORESCENT YELLOW FYG-FLUORESCENT YELLOW GREEN																"SHSM"-STANDARD HIGHWAY SIGNS AND MARKINGS								
		C	VR-017	24	30			5.00																				6			
NB	3.859	A	W11-2	30	30	FYG	PEDESTRIAN AHEAD ADVANCE WARNING SIGN			1					X																
		A	W16-7	24	12	FYG	DOWNWARD ARROW			1																					
NB	3.859	A	D3-1	UNK	UNK								1		X																
		A	D3-1	52	12			4.33								2												11			
NB	3.859	C	VD-700	6	10								1																		
		D	R1-1	30	30								1	*	X																
		C	VD-700	6	10																										
		D	R1-1	30	30		 	0.42 6.25								1										X					
NB	3.892	A	R7-2S	24	36		NO PARKING 12AM TO 6 AM, NOV 1 -APR 1						1		X																
		A	R8-3	24	24			4.00																		X					
		A	VR-122	24	12			2.00																				6			
NB	3.915	A	W11-8	30	30								1		X																
		A	W11-8	30	30			6.25																		X					
SKIP TO NORTH SIDE OF BRIDGE #30																															
NB	4.180	A	R2-1	24	30								1		X																
		A	R2-1	24	30			5.00								1											X				
SIGN SUMMARY SHEET							SHEET TOTALS	33.25 32.83	0.00	2	0	0	6 5	0	0	4 3				60.0 45.0	0	0.0	0.0	0.0	0.0						PROJECT NAME: STATEWIDE SOUTHWEST REGION PROJECT NUMBER: STPG SIGN(41)
								SF	SF	EA	EA	EA	EA	EA	EA	EA			FT	EA	LB	LB	LB	LB						FILE NAME: 12C118 PROJECT MANAGER: A. GAMBLE DESIGNED BY: J. KELLY JAMAICA NB SHEET 7	
VERMONT AGENCY OF TRANSPORTATION							TOWN DIRECTIONAL TOTALS	438.5 443.5	0.0	32 29	2 1	2 1	88 78	0	0	63 62			945.0 930.0	0			0.0							PLOT DATE: 2/13/2013 DRAWN BY: J. KELLY CHECKED: A. GAMBLE SHEET 35 OF 97	

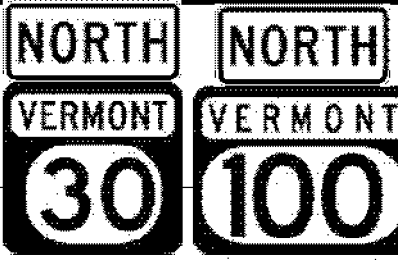





DIRECTION	MILEPOINT	LOCATION CODE (SHEET 2)	SIGN CODE	WIDTH (IN)	HEIGHT (IN)	SHEETING REMARKS	SIGN LEGEND	NEW SIGNS		EXISTING SIGNS				EXIST POST		NUMBER OF NEW POSTS	SQUARE STEEL (IN)			TUBULAR STEEL Ø (IN)				SIGN FRAME REQUIRED	REMARKS	SIGN DETAIL LOCATION			
								"A"	"B"	RETAIN	SALVAGE FROM	SALVAGE TO	REMOVE	RETAIN	REMOVE		1.75	2.00	2.50	FOUNDATION	3.00	3.50	4.00			5.00	SHSM	PROJECT SHEET #	STANDARD SHEET #
																	(LB / FT)				(LB / FT)								
JAMAICA VT-30 NB							FY-FLUORESCENT YELLOW FYG-FLUORESCENT YELLOW GREEN																"SHSM"-STANDARD HIGHWAY SIGNS AND MARKINGS						
NB	4.440	A	R2-1	24	30																								
		A	R2-1	24	30			5.00										15'-7" X								X			
NB	5.748	B	W7-1B	48	48		HILL SYMBOL - 8%																						
		B	W7-3A	24	18		NEXT 2 MILES																						
NB	6.323	A	W2-2ML	30	30		LEFT SIDE ROAD																						
		A	VW2-7L Mo	30	30			6.25											15'-10" X									7	
NB	6.515	C	VR-017	24	24																								
		C	VR-017	24	30			5.00																				6	
NB	6.521	C	VD-700	6	10																								
		A	D3-1	UNK	UNK																								
		C	VD-700	6	10																								
		D	R1-1	30	30																								
		D	R1-1	30	30			0.42 6.25																			X		
		A	D3-1	72	12			6.00																					
NB	6.581	A	S3-1T	30	30		SCHOOL BUS STOP AHEAD																						
		A	S3-1	36	36	FYG		9.00																		X			
NB	6.957	C	VR-017	24	30																								
		C	VR-017	24	30																								
SIGN SUMMARY SHEET							SHEET TOTALS	37.92 37.50	0.00	0	0	0	10 9	0	0	8	120.0	0	0.0	0.0	0.0	0.0	PROJECT NAME: STATEWIDE SOUTHWEST REGION	PROJECT NUMBER: STPG SIGN(41)					
								SF	SF	EA	EA	EA	EA	EA	EA	EA	FT	EA	LB	LB	LB	LB	FILE NAME: 12C118	PLOT DATE: 2/13/2013					
VERMONT AGENCY OF TRANSPORTATION							TOWN DIRECTIONAL TOTALS	438.5 443.5	0.0	32 29	2 1	2 1	88 78	0	0	63 62	945.0 930.0	0	0.0	0.0	0.0	0.0	PROJECT MANAGER: A. GAMBLE	DRAWN BY: J. KELLY					
																						DESIGNED BY: J. KELLY	CHECKED: A. GAMBLE						
																						JAMAICA NB SHEET 8	SHEET 36 OF 97						

DIRECTION	MILEPOINT	LOCATION CODE (SHEET 2)	SIGN CODE	WIDTH (IN)	HEIGHT (IN)	SHEETING REMARKS	SIGN LEGEND	NEW SIGNS		EXISTING SIGNS				EXIST POST		NUMBER OF NEW POSTS	SQUARE STEEL (IN)			TUBULAR STEEL Ø (IN)				SIGN FRAME REQUIRED	REMARKS	SIGN DETAIL LOCATION			
								"A"	"B"	RETAIN	SALVAGE FROM	SALVAGE TO	REMOVE	RETAIN	REMOVE		1.75	2.00	2.50	FOUNDATION	3.00	3.50	4.00			5.00	SHSM	PROJECT SHEET #	STANDARD SHEET #
																	(LB / FT)				(LB / FT)								
JAMAICA VT-30 NB							FY-FLUORESCENT YELLOW FYG-FLUORESCENT YELLOW GREEN																"SHSM"-STANDARD HIGHWAY SIGNS AND MARKINGS						
		C	VR-017	24	30			5.00																INSTALL ON EXISTING SIGN POST.		6			
NB	6.963	C	VD-700	6	10							1												STONE HEDGES RD (TH-94)					
		D	R1-1	30	30							1	X																
		C	VD-700	6	10			0.42																INSTALL ON EXISTING SIGN POST.	X				
		D	R1-1	30	30			6.25																					
NB	6.963	A	D3-1	UNK	UNK																			STONE HEDGES RD (TH-94)					
NB	6.957	A	D3-1	72	12			6.00							2		15'-6"	15'-0"	X						FIELD LOCATE AT LEAST 8 FEET FROM ANY OTHER SIGN ASSEMBLY.		11		
NB	7.194	A	VW-092	36	36		UNSAFE TO PASS			1																			
NB	7.520	A	W1-2R	30	30		RIGHT CURVE																						
		A	W13-1	18	18		40 MPH ADVISORY																						
		A	W1-2R	30	30			6.25							1		13'-10"	X											
		A	W13-1P	18	18			2.25																					
NB	7.784	C	VR-017	24	30																				COLE POND RD (TH-63)				
		C	VR-017	24	30			5.00																					
NB	7.790	C	VD-700	6	10																				COLE POND RD (TH-63)				
		D	R1-1	30	30																								
		C	VD-700	6	10			6.25							1		13'-6"	X											
		D	R1-1	30	30																								
NB	7.790	A	D3-1	UNK	UNK																				COLE POND RD (TH-63)				
SIGN SUMMARY SHEET							SHEET TOTALS	37.84 37.00	0.00	1	0	0	9	0	0	4	45.0	0	0.0	0.0	0.0	0.0		PROJECT NAME: STATEWIDE SOUTHWEST REGION PROJECT NUMBER: STPG SIGN(41)					
								SF	SF	EA	EA	EA	EA	EA	EA	EA	FT	EA	LB	LB	LB	LB		FILE NAME: 12C118 PROJECT MANAGER: A. GAMBLE DESIGNED BY: J. KELLY JAMAICA NB SHEET 9					
VERMONT AGENCY OF TRANSPORTATION							TOWN DIRECTIONAL TOTALS	438.5 443.5	0.0	32	2	2	88	0	0	63	945.0	0		0.0				PLOT DATE: 2/13/2013 DRAWN BY: J. KELLY CHECKED: A. GAMBLE SHEET 37 OF 97					






DIRECTION	MILEPOINT	LOCATION CODE (SHEET 2)	SIGN CODE	WIDTH (IN)	HEIGHT (IN)	SHEETING REMARKS	SIGN LEGEND	NEW SIGNS		EXISTING SIGNS				EXIST POST		NUMBER OF NEW POSTS	SQUARE STEEL (IN)			TUBULAR STEEL Ø (IN)				SIGN FRAME REQUIRED	REMARKS	SIGN DETAIL LOCATION				
								"A"	"B"	RETAIN	SALVAGE FROM	SALVAGE TO	REMOVE	RETAIN	REMOVE		1.75	2.00	2.50	FOUNDATION	3.00	3.50	4.00			5.00	SHSM	PROJECT SHEET #	STANDARD SHEET #	
																	(LB / FT)				(LB / FT)									
JAMAICA VT-30 NB							FY-FLUORESCENT YELLOW FYG-FLUORESCENT YELLOW GREEN																"SHSM"-STANDARD HIGHWAY SIGNS AND MARKINGS							
		A	D3-1	62	12			5.17								2	12'-3" 11'-10" X								FIELD LOCATE AT LEAST 8 FEET FROM ANY OTHER SIGN ASSEMBLY.		11			
NB	8.061	A	VW-060	30	30		HIDDEN DRIVES			1																				
NB	8.386	A	W3-5	36	36		SPEED REDUCTION (40)			1																				
NB	8.425	A	VW-054L	30	30		HIDDEN DRIVE LEFT			1																				
NB	8.467	A	VD-018	30	18							1																		
		A	VD-018	30	18			3.75								1	11'-8" X									5				
NB	8.518	A	R2-1	24	30							1																		
		A	R2-1	30	36			7.50								1	14'-0" X								X					
NB	8.639	A	M2-1	21	15							1																		
		A	M1-5	30	24							1																		
		A	M2-1	21	15			2.19								1	14'-11" X										E-136B			
		A	M3-1	24	12			2.00																			E-136B			
		A	M1-5	30	24			5.00																			E-136B			
NB	8.660	C	VR-017	24	30							1																		
		C	VR-017	24	30			5.00																						
SIGN SUMMARY SHEET							SHEET TOTALS	30.61	0.00	3	0	0	7	5	0	0	7	75.0	0	0.0	0.0	0.0	0.0	PROJECT NAME: STATEWIDE SOUTHWEST REGION PROJECT NUMBER: STPG SIGN(41)						
								SF	SF	EA	EA	EA	EA	EA	EA	EA	FT	EA	LB	LB	LB	LB	FILE NAME: 12C118 PROJECT MANAGER: A. GAMBLE DESIGNED BY: J. KELLY JAMAICA NB SHEET 10							
VERMONT AGENCY OF TRANSPORTATION							TOWN DIRECTIONAL TOTALS	438.5	443.5	0.0	32	29	2	1	2	1	88	78	0	0	0	0	0	0	PLOT DATE: 2/13/2013 DRAWN BY: J. KELLY CHECKED BY: A. GAMBLE SHEET 38 OF 97					






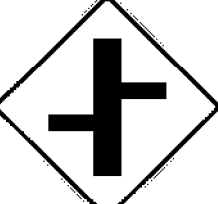
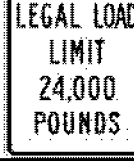


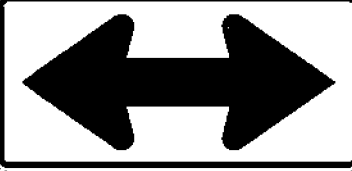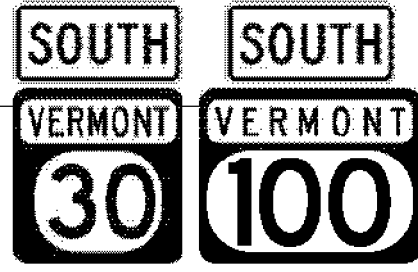
DIRECTION	MILEPOINT	LOCATION CODE (SHEET 2)	SIGN CODE	WIDTH (IN)	HEIGHT (IN)	SHEETING REMARKS	SIGN LEGEND	NEW SIGNS		EXISTING SIGNS				EXIST POST		NUMBER OF NEW POSTS	SQUARE STEEL (IN)			TUBULAR STEEL Ø (IN)				SIGN FRAME REQUIRED	REMARKS	SIGN DETAIL LOCATION			
								"A"	"B"	RETAIN	SALVAGE FROM	SALVAGE TO	REMOVE	RETAIN	REMOVE		1.75	2.00	2.50	FOUNDATION	3.00	3.50	4.00			5.00	SHSM	PROJECT SHEET #	STANDARD SHEET #
																	(LB / FT)				(LB / FT)								
JAMAICA VT-30 NB							FY-FLUORESCENT YELLOW FYG-FLUORESCENT YELLOW GREEN															"SHSM"-STANDARD HIGHWAY SIGNS AND MARKINGS							
NB	8.666	C D	VD-700 R1-1	6 30	10 30																								
		C D	VD-700 R1-1	6 30	10 30			0.42 6.25															X						
NB	8.666	A	D3-1	UNK	UNK																								
NB	8.660	A	D3-1	68	12			5.67																	11				
NB	8.675	A	W2-2R	36	36																								
		A	W13-1	18	18																								
		A	W2-2R	30	30			6.25															X						
		A	W13-1P	18	18			2.25															X						
NB	8.710	A	VD1-1A	72	12			6.00																	9				
		A	VD1-1A	72	12			6.00																	9				
		A	VD1-1A	72	12			6.00																	9				
NB	8.723	A	D1-1A	72	12		DESTINATION SIGN ASSEMBLY.																						
		A	D1-1A	72	12																								
		A	D1-1S	72	12																								
NB	8.740	A	D1-1A	72	12		DESTINATION SIGN ASSEMBLY.																						
SIGN SUMMARY SHEET							SHEET TOTALS	38.84 38.42	0.00	0	0	0	9 8	0	0	5	75.0	0	0.0	0.0	0.0	0.0	PROJECT NAME: STATEWIDE SOUTHWEST REGION						
								SF	SF	EA	EA	EA	EA	EA	EA	EA	FT	EA	LB	LB	LB	LB	PROJECT NUMBER: STPG SIGN(41)						
VERMONT AGENCY OF TRANSPORTATION							TOWN DIRECTIONAL TOTALS	438.5 443.5	0.0	32 29	2 1	2 1	88 78	0	0	63 62	945.0 930.0	0		0.0			FILE NAME: 12C118	PROJECT MANAGER: A. GAMBLE	PLOT DATE: 2/13/2013				
																						DESIGNED BY: J. KELLY	CHECKED: A. GAMBLE	DRAWN BY: J. KELLY					
																						JAMAICA NB SHEET 11	SHEET 39	OF 97					




DIRECTION	MILEPOINT	LOCATION CODE (SHEET 2)	SIGN CODE	WIDTH (IN)	HEIGHT (IN)	SHEETING REMARKS	SIGN LEGEND	NEW SIGNS		EXISTING SIGNS				EXIST POST		NUMBER OF NEW POSTS	SQUARE STEEL (IN)			TUBULAR STEEL Ø (IN)				SIGN FRAME REQUIRED	REMARKS	SIGN DETAIL LOCATION				
								"A"	"B"	RETAIN	SALVAGE FROM	SALVAGE TO	REMOVE	RETAIN	REMOVE		1.75	2.00	2.50	FOUNDATION	3.00	3.50	4.00			5.00	SHSM	PROJECT SHEET #	STANDARD SHEET #	
																	(LB / FT)				(LB / FT)									
JAMAICA VT-30 NB							FY-FLUORESCENT YELLOW FYG-FLUORESCENT YELLOW GREEN																"SHSM"-STANDARD HIGHWAY SIGNS AND MARKINGS							
		A	M1-5	30	24			5.00																				E-136B		
		A	M6-1R	21	15			2.19																				E-136B		
NB	8.860	A	M3-1	24	12																									
		A	M1-5	24	24																									
		A	M3-1	24	12			2.00																				E-136B		
		A	M1-5	24	24			4.00																				E-136B		
NB	8.917	A	R2-1	24	30																									
		A	R2-1	24	30			5.00																				X		
NB	9.180	A	VD-700	6	10																									
		A	R2-1	24	30																									
		A	VD-700	6	10			5.00																				X		
		A	R2-1	24	30																									
NB	9.885	A	R2-5A	24	30		REDUCED SPEED AHEAD																							
		A	W3-5	36	36			9.00																				X		
NB	10.015	A	R2-1	24	30																									
		A	R2-1	30	36			7.50																				X		
NB	10.104	C	VR-017	24	30																									
SIGN SUMMARY SHEET							SHEET TOTALS	40.11 39.69	0.00	0	0	0	8 7	0	0	5 4	75.0 60.0	0	0.0	0.0	0.0	0.0				PROJECT NAME: STATEWIDE SOUTHWEST REGION				
								SF	SF	EA	EA	EA	EA	EA	EA	EA	FT	EA	LB	LB	LB	LB				PROJECT NUMBER: STPG SIGN(41)				
VERMONT AGENCY OF TRANSPORTATION							TOWN DIRECTIONAL TOTALS	438.5 443.5	0.0	32 29	2 1	2 1	88 78	0	0	63 62	945.0 930.0	0		0.0						FILE NAME: 12C118				
																									PROJECT MANAGER: A. GAMBLE					
																									DESIGNED BY: J. KELLY					
																									AMEDEN RD (TH-22)					
																									PLOT DATE: 2/13/2013					
																										DRAWN BY: J. KELLY				
																											CHECKED: A. GAMBLE			
																												SHEET 41 OF 97		

DIRECTION	MILEPOINT	LOCATION CODE (SHEET 2)	SIGN CODE	WIDTH (IN)	HEIGHT (IN)	SHEETING REMARKS	SIGN LEGEND	NEW SIGNS		EXISTING SIGNS				EXIST POST		NUMBER OF NEW POSTS	SQUARE STEEL (IN)			TUBULAR STEEL Ø (IN)				SIGN FRAME REQUIRED	REMARKS	SIGN DETAIL LOCATION			
								"A"	"B"	RETAIN	SALVAGE FROM	SALVAGE TO	REMOVE	RETAIN	REMOVE		1.75	2.00	2.50	FOUNDATION	3.00	3.50	4.00			5.00	SHSM	PROJECT SHEET #	STANDARD SHEET #
																	(LB / FT)				(LB / FT)								
JAMAICA VT-30 SB							FY-FLUORESCENT YELLOW FYG-FLUORESCENT YELLOW GREEN																"SHSM"-STANDARD HIGHWAY SIGNS AND MARKINGS						
SB	10.015	F	R2-1	24	30																								
		F	R2-1	24	30			5.00																INSTALL DIRECTLY ACROSS FROM NB SPEED LIMIT 40 SIGN ASSEMBLY.	X				
SB	9.302	F	W3-5	36	36		SPEED REDUCTION ADVANCE WARNING SIGN (40 MPH)			1																			
SB	9.245	F	VD-018	30	18																								
		F	VD-018	30	18			3.75																		5			
SB	9.150	F	R2-1	24	30																								
		F	R2-1	30	36			7.50																	X				
SB	9.110	F	VW-054R	30	30		HIDDEN DRIVE RIGHT																						
		F	VW-054R	30	30			6.25																		7			
		F	W11-5M	30	30		FARM MACHINERY																						
SB	8.983	A	D3-1	UNK	UNK																			DIERS RD (TH-9)					
		A	D3-1	40	12			3.33																INSTALL ABOVE STOP SIGN LEGAL LOAD SIGN WITH BRACKET.			11		
SB	8.983	G	VR-017	24	30																			DIERS RD (TH-9)					
		G	VR-017	24	30			5.00																			6		
SB	8.977	H	R1-1	30	30																			DIERS RD (TH-9)					
SIGN SUMMARY SHEET							SHEET TOTALS	30.83	0.00	1	0	0	9 8	0	0	7 5	105.0 75.0	0	0.0	0.0	0.0	0.0		PROJECT NAME: STATEWIDE SOUTHWEST REGION					
								SF	SF	EA	EA	EA	EA	EA	EA	EA	EA	EA	EA	EA	EA	EA	EA	EA	PROJECT NUMBER: STPG SIGN(41)				
																								FILE NAME: 12C118	PROJECT MANAGER: A. GAMBLE	PLOT DATE: 2/13/2013			
VERMONT AGENCY OF TRANSPORTATION							TOWN DIRECTIONAL TOTALS	431.84 430.2	0.0	31 29	2 0	2 0	85 82	0	0	66 63	990.0 945.0	0		0.0			DESIGNED BY: J. KELLY	CHECKED: A. GAMBLE	DRAWN BY: J. KELLY	SHEET 43 OF 97			


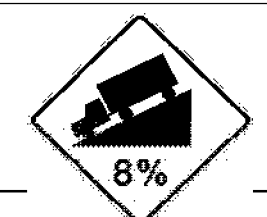





DIRECTION	MILEPOINT	LOCATION CODE (SHEET 2)	SIGN CODE	WIDTH (IN)	HEIGHT (IN)	SHEETING REMARKS	SIGN LEGEND	NEW SIGNS		EXISTING SIGNS				EXIST POST		NUMBER OF NEW POSTS	SQUARE STEEL (IN)			TUBULAR STEEL Ø (IN)				SIGN FRAME REQUIRED	REMARKS	SIGN DETAIL LOCATION			
								"A"	"B"	RETAIN	SALVAGE FROM	SALVAGE TO	REMOVE	RETAIN	REMOVE		1.75	2.00	2.50	FOUNDATION	3.00	3.50	4.00			5.00	SHSM	PROJECT SHEET #	STANDARD SHEET #
																	(LB / FT)				(LB / FT)								
JAMAICA VT-30 SB							FY-FLUORESCENT YELLOW FYG-FLUORESCENT YELLOW GREEN															"SHSM"-STANDARD HIGHWAY SIGNS AND MARKINGS							
		G	VD-700	6	10			0.42								1	13'-3" X								X				
SB	8.960	F	R2-1	24	30								1			X										X			
		F	R2-1	24	30			5.00								1	12'-4" X												
SB	8.920	F	D1-1A	72	12		DESTINATION SIGNS						1		X														
		F	D1-1A	72	12								1																
		F	D1-1A	72	12								1																
		F	D1-1A	72	12								1																
		F	VD1-1A	72	12			6.00																		9			
		F	VD1-1A	72	12			6.00																		10			
		F	VD1-1A	72	12			6.00																		10			
		F	VD1-1A	72	12			6.00																		10			
SB	8.866	F	M3-1	24	12		ROUTE MARKER ASSEMBLY						1		X														
		F	M1-5	30	24								1																
		F	M6-1	21	15								1																
		F	M3-3	24	12								1																
SIGN SUMMARY SHEET							SHEET TOTALS	35.67 35.25	0.00	0	0	0	9 9	0	0	7 2	105.0 30.0	0	0.0	0.0	0.0	0.0	PROJECT NAME: STATEWIDE SOUTHWEST REGION	PROJECT NUMBER: STPG SIGN(41)					
VERMONT AGENCY OF TRANSPORTATION							TOWN DIRECTIONAL TOTALS	431.84 430.2	0.0	31 29	2 0	2 0	85 82	0	0	66 63	990.0 945.0	0	0.0				FILE NAME: 12C118	PROJECT MANAGER: A. GAMBLE		PLOT DATE: 2/13/2013	DRAWN BY: J. KELLY		
																							CHECKED: A. GAMBLE	SHEET 44	OF 97				


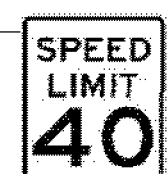




DIRECTION	MILEPOINT	LOCATION CODE (SHEET 2)	SIGN CODE	WIDTH (IN)	HEIGHT (IN)	SHEETING REMARKS	SIGN LEGEND	NEW SIGNS		EXISTING SIGNS				EXIST POST		NUMBER OF NEW POSTS	SQUARE STEEL (IN)			TUBULAR STEEL Ø (IN)				SIGN FRAME REQUIRED	REMARKS	SIGN DETAIL LOCATION			
								"A"	"B"	RETAIN	SALVAGE FROM	SALVAGE TO	REMOVE	RETAIN	REMOVE		1.75	2.00	2.50	FOUNDATION	3.00	3.50	4.00			5.00	SHSM	PROJECT SHEET #	STANDARD SHEET #
																	(LB / FT)				(LB / FT)								
JAMAICA VT-30 SB							FY-FLUORESCENT YELLOW FYG-FLUORESCENT YELLOW GREEN															"SHSM"-STANDARD HIGHWAY SIGNS AND MARKINGS							
		F	W1-7	48	24			8.00							2	14'-9" 13'-7" X									X				
SB	8.785	F	M3-3	24	12		ROUTE MARKER ASSEMBLY.						1																
		F	M1-5	24	24								1																
		F	M3-3	24	12								1																
		F	M1-5	30	24								1																
		F	M3-3	24	12										2	15'-1" 14'-11" X						#2A			5	E-136B			
		F	M1-5	24	24																						E-136B		
		F	M3-3	24	12			2.00																			E-136B		
		F	M1-5	30	24			5.00																			E-136B		
SB	8.745	F	R2-1	24	30								1																
		F	R2-1	24	30			5.00							1	13'-2" X									X				
SB	8.720	F	D2-1	72	10								1																
		F	D2-1	72	10								1																
		F	VD2-1	72	12			6.00							2	12'-8" 12'-4" X										8			
		F	VD2-1	72	12			6.00																			8		
SIGN SUMMARY SHEET							SHEET TOTALS	38.00	0.00	0	0	0	7	0	0	7	105.0	0	0.0	0.0	0.0	0.0	0.0	0.0	PROJECT NAME: STATEWIDE SOUTHWEST REGION PROJECT NUMBER: STPG SIGN(41)				
								SF	SF	EA	EA	EA	EA	EA	EA	EA	FT	EA	LB	LB	LB	LB	LB	FILE NAME: 12C118 PROJECT MANAGER: A. GAMBLE DESIGNED BY: J. KELLY JAMAICA SB SHEET 4					
VERMONT AGENCY OF TRANSPORTATION							TOWN DIRECTIONAL TOTALS	431.84 430.2	0.0	31 29	2 0	2 0	85 82	0	0	66 63	990.0 945.0	0		0.0					PLOT DATE: 2/13/2013 DRAWN BY: J. KELLY CHECKED: A. GAMBLE SHEET 46 OF 97				

DIRECTION	MILEPOINT	LOCATION CODE (SHEET 2)	SIGN CODE	WIDTH (IN)	HEIGHT (IN)	SHEETING REMARKS	SIGN LEGEND	NEW SIGNS		EXISTING SIGNS				EXIST POST		NUMBER OF NEW POSTS	SQUARE STEEL (IN)			TUBULAR STEEL Ø (IN)				SIGN FRAME REQUIRED	REMARKS	SIGN DETAIL LOCATION			
								"A"	"B"	RETAIN	SALVAGE FROM	SALVAGE TO	REMOVE	RETAIN	REMOVE		1.75	2.00	2.50	FOUNDATION	3.00	3.50	4.00			5.00	SHSM	PROJECT SHEET #	STANDARD SHEET #
																	(LB / FT)				(LB / FT)								
JAMAICA VT-30 SB							FY-FLUORESCENT YELLOW FYG-FLUORESCENT YELLOW GREEN																"SHSM"-STANDARD HIGHWAY SIGNS AND MARKINGS						
SB	8.518	F	R2-1	24	30																								
		F	R2-1	24	30			5.00																INSTALL DIRECTLY ACROSS FROM NB SPEED LIMIT 40 ASSEMBLY.	X				
SB	7.965	F	D3-1	UNK	UNK																								
		F	D3-1	68	12			5.67																WILD TURKEY RUN (TH-86) FIELD LOCATE AT LEAST 8 FEET FROM ANY OTHER SIGN ASSEMBLY. ANCHORS IN LEDGE		11			
SB	7.965	G	VR-017	24	24																								
		G	VR-017	24	30			5.00																		6			
SB	7.957	G	VD-700	6	10																								
		H	R1-1	30	30			0.42																					
		H	R1-1	30	30			6.25																	X				
SB	7.865	F	VW2-7L Mo	30	30			6.25																INSTALL 425 NORTH AND ACROSS FROM COLE POND RD.		7			
SB	7.768	G	VR-017	24	30																								
		F	D3-1	UNK	UNK		BOURBON RUN RD STREET SIGN																						
		G	VR-017	24	30			5.00																		6			
SB	7.768	F	D3-1	72	12			6.00																FIELD LOCATE AT LEAST 8 FEET FROM ANY OTHER SIGN ASSEMBLY.		11			
SB	7.760	G	VD-700	6	10																								
		H	R1-1	30	30			0.42																	X				
		H	R1-1	30	30			6.25																					
SIGN SUMMARY SHEET							SHEET TOTALS	46.26 45.42	0.00	0	0	0	9 7	0	0	9	135.0	0	0.0	0.0	0.0	0.0	0.0	PROJECT NAME: STATEWIDE SOUTHWEST REGION PROJECT NUMBER: STPG SIGN(41)					
								SF	SF	EA	EA	EA	EA	EA	EA	EA	FT	EA	LB	LB	LB	LB	FILE NAME: 12C118 PROJECT MANAGER: A. GAMBLE DESIGNED BY: J. KELLY JAMAICA SB SHEET 5						
VERMONT AGENCY OF TRANSPORTATION							TOWN DIRECTIONAL TOTALS	431.84 430.2	0.0	31	2	2	85 82	0	0	66 63	990.0	0		0.0				PLOT DATE: 2/13/2013 DRAWN BY: J. KELLY CHECKED: A. GAMBLE SHEET 47 OF 97					

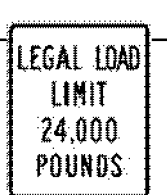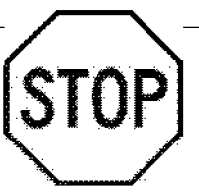


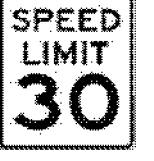


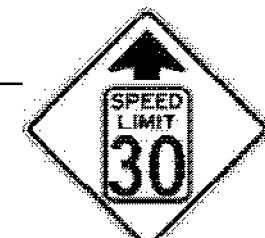


DIRECTION	MILEPOINT	LOCATION CODE (SHEET 2)	SIGN CODE	WIDTH (IN)	HEIGHT (IN)	SHEETING REMARKS	SIGN LEGEND	NEW SIGNS		EXISTING SIGNS				EXIST POST		NUMBER OF NEW POSTS	SQUARE STEEL (IN)			TUBULAR STEEL Ø (IN)				SIGN FRAME REQUIRED	REMARKS	SIGN DETAIL LOCATION			
								"A"	"B"	RETAIN	SALVAGE FROM	SALVAGE TO	REMOVE	RETAIN	REMOVE		1.75	2.00	2.50	FOUNDATION	3.00	3.50	4.00			5.00	SHSM	PROJECT SHEET #	STANDARD SHEET #
																	(LB / FT)				(LB / FT)								
JAMAICA VT-30 SB							FY-FLUORESCENT YELLOW FYG-FLUORESCENT YELLOW GREEN															"SHSM"-STANDARD HIGHWAY SIGNS AND MARKINGS							
SB	7.677	F	W1-2L	30	30		LEFT CURVE																						
		F	W13-1	18	18		40 MPH																						
		F	W1-2L	30	30	FY		6.25																X					
		F	W13-1P	18	18	FY		2.25																X					
SB	7.614	F	W1-8L	24	30		CHEVRON			1																			
		E	W1-8R	24	30		CHEVRON			1																			
SB	7.586	F	W1-8L	24	30		CHEVRON			1																			
		E	W1-8R	24	30		CHEVRON			1																			
SB	7.560	F	W1-8L	24	30		CHEVRON			1																			
		E	W1-8R	24	30		CHEVRON			1																			
SB	7.535	F	W1-8L	24	30		CHEVRON			1																			
		E	W1-8R	24	30		CHEVRON			1																			
SB	7.397	F	VW-092	36	36																								
		F	VW-092	36	36			9.00																		7			
SB	6.900	F	VW-060	30	30																								
SIGN SUMMARY SHEET							SHEET TOTALS	17.50	0.00	8	0	0	4	0	0	3	45.0	0	0.0	0.0	0.0	0.0	PROJECT NAME: STATEWIDE SOUTHWEST REGION						
								SF	SF	EA	EA	EA	EA	EA	EA	EA	FT	EA	LB	LB	LB	LB	PROJECT NUMBER: STPG SIGN(41)						
																							FILE NAME: 12C118						
																						PROJECT MANAGER: A. GAMBLE							
																					DESIGNED BY: J. KELLY								
																					DRAWN BY: J. KELLY								
																					CHECKED: A. GAMBLE								
																					SHEET 48 OF 97								
VERMONT AGENCY OF TRANSPORTATION							TOWN DIRECTIONAL TOTALS	431.84		31	2	2	85	0	0	66	990.0	0		0.0			JAMAICA SB SHEET 6						
								430.2	0.0	29	0	0	82	0	0	63	945.0												






DIRECTION	MILEPOINT	LOCATION CODE (SHEET 2)	SIGN CODE	WIDTH (IN)	HEIGHT (IN)	SHEETING REMARKS	SIGN LEGEND	NEW SIGNS		EXISTING SIGNS				EXIST POST		NUMBER OF NEW POSTS	SQUARE STEEL (IN)			TUBULAR STEEL Ø (IN)				SIGN FRAME REQUIRED	REMARKS	SIGN DETAIL LOCATION						
								"A"	"B"	RETAIN	SALVAGE FROM	SALVAGE TO	REMOVE	RETAIN	REMOVE		1.75	2.00	2.50	FOUNDATION	3.00	3.50	4.00			5.00	SHSM	PROJECT SHEET #	STANDARD SHEET #			
																	(LB / FT)				(LB / FT)											
JAMAICA VT-30 SB							FY-FLUORESCENT YELLOW FYG-FLUORESCENT YELLOW GREEN																"SHSM"-STANDARD HIGHWAY SIGNS AND MARKINGS									
		F	VW-060	30	30			6.25									1	15'-0" X										7				
SB	6.830	F	S3-1T	30	30		SCHOOL BUS STOP AHEAD 						1		X																	
		F	S3-1	36	36	FYG		9.00									2	15'-0" 15'-0" X							X							
SB	6.575	F	VW2-7L Mo	30	30			6.25									1	16'-5" X										7				
SB	6.500	F	W2-2R	30	30		RIGHT SIDE ROAD						1		X																	
SB	6.408	G	VR-017	24	30								1		X																	
		G	VR-017	24	30			5.00									1	13'-3" X										6				
SB	6.403	F	D3-1	UNK	UNK								1		X																	
		F	D3-1	60	12			5.00									2	13'-0" 14'-0" X										11				
SB	6.403	G	VD-700	6	10								1																			
		H	R1-1	30	30																											
		H	R1-1	30	30			6.25																		X						
SB	5.748	F	W7-1B	36	36																											
		F	W7-3A	24	18																											
		F	W7-1a	36	36	FY		9.00									2	15'-3" 14'-4" X								X						
		F	W7-3A	24	18	FY		3.00																		X						
SIGN SUMMARY SHEET							SHEET TOTALS	49.75	0.00	1 0	0	0	7	0	0	3 0		135.0	0	0.0	0.0	0.0	0.0									
							SF	SF	EA	EA	EA	EA	EA	EA	EA	EA	EA	FT	EA	LB	LB	LB	LB	LB								
VERMONT AGENCY OF TRANSPORTATION							TOWN DIRECTIONAL TOTALS	431.84 430.2	0.0	31 29	2 0	2 0	85 82	0	0	66 63		990.0 945.0	0			0.0										

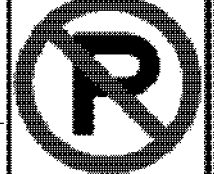



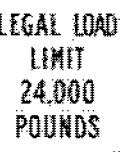


DIRECTION	MILEPOINT	LOCATION CODE (SHEET 2)	SIGN CODE	WIDTH (IN)	HEIGHT (IN)	SHEETING REMARKS	SIGN LEGEND	NEW SIGNS		EXISTING SIGNS				EXIST POST		NUMBER OF NEW POSTS	SQUARE STEEL (IN)			TUBULAR STEEL Ø (IN)				SIGN FRAME REQUIRED	REMARKS	SIGN DETAIL LOCATION			
								"A"	"B"	RETAIN	SALVAGE FROM	SALVAGE TO	REMOVE	RETAIN	REMOVE		1.75	2.00	2.50	FOUNDATION	3.00	3.50	4.00			5.00	SHSM	PROJECT SHEET #	STANDARD SHEET #
																	(LB / FT)				(LB / FT)								
JAMAICA VT-30 SB							FY-FLUORESCENT YELLOW FYG-FLUORESCENT YELLOW GREEN																"SHSM"-STANDARD HIGHWAY SIGNS AND MARKINGS						
SB	5.450	F	VW-054R	30	30																								
		F	VW-054R	30	30				6.25																		7		
SB	5.410	F	W7-1B	36	36		HILL SYMBOL																						
SB	4.960	F	W7-1B	36	36																								
		F	W7-3A	24	18																								
		F	W7-1A	36	36		 																						
		F	W7-3A	24	18				9.00																		X		
		F	W7-3A	24	18				3.00																	X			
SB	4.705	G	D3-1	UNK	UNK																								
		G	D3-1	56	12																								
		G	D3-1	56	12				4.67																				
SB	4.705	G	VR-017	24	30																								
		G	VR-017	24	30																								
		G	VR-017	24	30				5.00																				
SB	4.697	G	VD-700	6	10						1																		
		H	R1-1	30	30																								
		G	VD-700	6	10																								
		H	R1-1	30	30						1																		
		H	R1-1	30	30				6.25																X				
SB	4.605	F	W3-5	36	36																								
		F	W3-5	36	36																								
		F	W3-5	36	36				9.00																X				
SIGN SUMMARY SHEET							SHEET TOTALS	43.17	0.00	0	1	1	8	0	0	9	135.0	0	0.0	0.0	0.0	0.0	PROJECT NAME: STATEWIDE SOUTHWEST REGION PROJECT NUMBER: STPG SIGN(41)						
							SF	SF	EA	EA	EA	EA	EA	EA	EA	EA	FT	EA	LB	LB	LB	LB	FILE NAME: 12C118 PROJECT MANAGER: A. GAMBLE DESIGNED BY: J. KELLY JAMAICA SB SHEET 8						
VERMONT AGENCY OF TRANSPORTATION							TOWN DIRECTIONAL TOTALS	431.84	0.0	31	29	2	2	85	0	0	66	990.0	0		0.0			PLOT DATE: 2/13/2013 DRAWN BY: J. KELLY CHECKED: A. GAMBLE SHEET 50 OF 97					










DIRECTION	MILEPOINT	LOCATION CODE (SHEET 2)	SIGN CODE	WIDTH (IN)	HEIGHT (IN)	SHEETING REMARKS	SIGN LEGEND	NEW SIGNS		EXISTING SIGNS				EXIST POST		NUMBER OF NEW POSTS	SQUARE STEEL (IN)			TUBULAR STEEL Ø (IN)				SIGN FRAME REQUIRED	REMARKS	SIGN DETAIL LOCATION			
								"A"	"B"	RETAIN	SALVAGE FROM	SALVAGE TO	REMOVE	RETAIN	REMOVE		1.75	2.00	2.50	FOUNDATION	3.00	3.50	4.00			5.00	SHSM	PROJECT SHEET #	STANDARD SHEET #
																	(LB / FT)				(LB / FT)								
JAMAICA VT-30 SB							FY-FLUORESCENT YELLOW FYG-FLUORESCENT YELLOW GREEN																"SHSM"-STANDARD HIGHWAY SIGNS AND MARKINGS						
SB	4.500	F	W7-1B	36	36		HILL SYMBOL																						
SB	4.480	F	VD-018	30	18			3.75																		5			
SB	4.460	F	VD-018	30	18		JAMAICA EAST JAMAICA 3																						
SB	4.440	F	R2-1	24	30																								
		F	R2-1	30	36			7.50																		X			
SB	4.390	F	W1-2L	30	30		LEFT CURVE																						
		F	W13-1	18	18		35 MPH ADVISORY																						
SB	4.340	F	W1-2L	30	30			6.25																		X			
		F	W13-1P	18	18			2.25																		X			
SB	4.300	F	W3-5	36	36																								
		F	W3-5	36	36			9.00																		X			
SB	4.255	F	VD-062B	72	16		BUSINESS SIGN			1																			
		F	VD-062BRN	72	16		BUSINESS SIGN			1																			
SB	4.220	F	VW-054L	30	30																								
		F	VW-054L	30	30			6.25																			7		
SIGN SUMMARY SHEET							SHEET TOTALS	35.00	0.00	2	0	0	7	0	0	6	90.0	0	0.0	0.0	0.0	0.0	0.0	PROJECT NAME: STATEWIDE SOUTHWEST REGION					
								SF	SF	EA	EA	EA	EA	EA	EA	EA	FT	EA	LB	LB	LB	LB	PROJECT NUMBER: STPG SIGN(41)						
																								FILE NAME: 12C118					
VERMONT AGENCY OF TRANSPORTATION							TOWN DIRECTIONAL TOTALS	431.84	0.0	31	2	2	85	0	0	66	990.0	0				0.0		PROJECT MANAGER: A. GAMBLE					
								430.2		29	0	0	82			63	945.0						DESIGNED BY: J. KELLY						
																							PLOT DATE: 2/13/2013						
																							DRAWN BY: J. KELLY						
																							CHECKED: A. GAMBLE						
																							SHEET 51 OF 97						


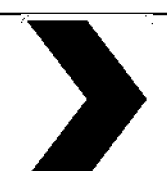




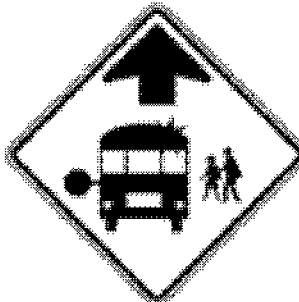
DIRECTION	MILEPOINT	LOCATION CODE (SHEET 2)	SIGN CODE	WIDTH (IN)	HEIGHT (IN)	SHEETING REMARKS	SIGN LEGEND	NEW SIGNS		EXISTING SIGNS				EXIST POST		NUMBER OF NEW POSTS	SQUARE STEEL (IN)			TUBULAR STEEL Ø (IN)				SIGN FRAME REQUIRED	REMARKS	SIGN DETAIL LOCATION						
								"A"	"B"	RETAIN	SALVAGE FROM	SALVAGE TO	REMOVE	RETAIN	REMOVE		1.75	2.00	2.50	FOUNDATION	3.00	3.50	4.00			5.00	SHSM	PROJECT SHEET #	STANDARD SHEET #			
																	(LB / FT)				(LB / FT)											
JAMAICA VT-30 SB							FY-FLUORESCENT YELLOW FYG-FLUORESCENT YELLOW GREEN															"SHSM"-STANDARD HIGHWAY SIGNS AND MARKINGS										
SB	4.180	F	R2-1	30	36																											
		F	R2-1	30	36			7.50															1	13'-1" X				INSTALL NEW SIGN DIRECTLY ACROSS FROM THE NB SPEED LIMIT 40 SIGN.	X			
SB	4.132	F	W11-8	36	36																											
		F	W11-8	30	30			6.25															1	14'-3" X					X			
SKIP TO SOUTH SIDE OF BRIDGE #30																																
SB	3.903	F	R8-3	24	24			4.00															1	12'-10" X				INSTALL AT END OF STONE WALL.	X			
		F	VR-122	24	12			2.00																						6		
SB	3.878	F	W11-2	30	30		PEDESTRIAN ADVANCE WARNING SIGN			1																						
		F	W16-7	24	12		DOWNWARD ARROW			1																						
SB	3.851	G	VR-017	24	24																											
		G	R2-1	24	30																											
SB	3.858	G	VR-017	24	30			5.00															1	14'-4" X				PIKES FALLS RD (TH-1) INSTALLED ON POST WITH VILLAGE SPEED LIMIT 25 SIGN INSTALL ON EXISTING SIGN POST.			6	
SB	3.858	H	R1-1	30	30		STOP																									
		G	VD-700	6	10																											
SB	3.851	H	R1-1	30	30																											
		G	VD-700	6	10			0.42																								
		H	R1-1	30	30			6.25																								
SB	3.851	F	D3-1	60	12			5.00																								
SIGN SUMMARY SHEET							SHEET TOTALS	36.42 36.00	0.00	2	1	1	5	0	0	4	5															
							SF	SF	EA	EA	EA	EA	EA	EA	EA	EA	EA	EA	EA	EA	EA	EA	EA	EA	EA	EA	EA	EA	EA	EA	EA	
							TOWN DIRECTIONAL TOTALS	431.84 430.2	0.0	31	29	2	2	85	0	0	66	63														


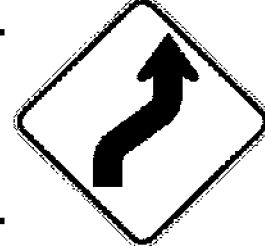




DIRECTION	MILEPOINT	LOCATION CODE (SHEET 2)	SIGN CODE	WIDTH (IN)	HEIGHT (IN)	SHEETING REMARKS	SIGN LEGEND	NEW SIGNS		EXISTING SIGNS				EXIST POST		NUMBER OF NEW POSTS	SQUARE STEEL (IN)			TUBULAR STEEL Ø (IN)				SIGN FRAME REQUIRED	REMARKS	SIGN DETAIL LOCATION				
								"A"	"B"	RETAIN	SALVAGE FROM	SALVAGE TO	REMOVE	RETAIN	REMOVE		1.75	2.00	2.50	FOUNDATION	3.00	3.50	4.00			5.00	SHSM	PROJECT SHEET #	STANDARD SHEET #	
																	(LB / FT)				(LB / FT)									
																	1.88	2.42	3.35		7.60	9.00	10.80			14.60				
JAMAICA VT-30 SB							FY-FLUORESCENT YELLOW FYG-FLUORESCENT YELLOW GREEN															"SHSM"-STANDARD HIGHWAY SIGNS AND MARKINGS								
SB	3.815	F	R2-1	24	30																									
		F	R7-2S	24	36		NO PARKING (DATES)																							
		F	R2-1	24	30			5.00															INSTALL NEW SIGNS ON EXISTING FLANGED CHANNEL SIGN POST.	X						
		F	R8-3	24	24			4.00																X						
		F	VR-122	24	12			2.00																	6					
SB	3.755	F	R2-1	24	30			5.00							1	12'-8" X							INSTALL NORTH OF UTILITY POLE WITH CONDUIT, ACROSS FROM THREE MOUNTAIN INN.	X						
SB	3.590	F	R2-1	24	30																									
		F	R2-1	24	30			5.00							1	13'-11" X							INSTALL DIRECTLY ACROSS FROM NB SPEED LIMIT 30 SIGN ASSEMBLY.	X						
SB	3.590	F	R7-2S	24	36		NO PARKING (DATES)																							
		F	M4-6	24	12		END																							
		F	R3-9dP	30	12			2.50							1	11'-11" X							INSTALL TO THE RIGHT OF SPEED LIMIT 40 ASSEMBLY.	X						
		F	R8-3	24	24			4.00																X						
		F	VR-122	24	12			2.00																	6					
SB	3.310	F	R2-1	24	30																									
		F	R2-1	24	30			5.00							1	13'-6" X								X						
SIGN SUMMARY SHEET							SHEET TOTALS			34.50	0.00	0	0	0	6	0	0	4	60.0	0	0.0	0.0	0.0	0.0	PROJECT NAME: STATEWIDE SOUTHWEST REGION					
							SF	SF	EA	EA	EA	EA	EA	EA	EA	EA	EA	EA	EA	EA	EA	EA	EA	EA	EA	EA	PROJECT NUMBER: STPG SIGN(41)			
							TOWN DIRECTIONAL TOTALS			431.84 430.2	0.0	31 29	2 0	2 0	85 82	0	0	66 63	990.0 945.0	0	0.0	0.0	0.0	0.0	0.0	0.0	FILE NAME: 12C118	PROJECT MANAGER: A. GAMBLE	PLOT DATE: 2/13/2013	
VERMONT AGENCY OF TRANSPORTATION																						DESIGNED BY: J. KELLY	CHECKED: A. GAMBLE	DRAWN BY: J. KELLY						
																						SHEET 53 OF 97								


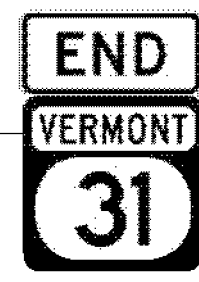
DIRECTION	MILEPOINT	LOCATION CODE (SHEET 2)	SIGN CODE	WIDTH (IN)	HEIGHT (IN)	SHEETING REMARKS	SIGN LEGEND	NEW SIGNS		EXISTING SIGNS				EXIST POST		NUMBER OF NEW POSTS	SQUARE STEEL (IN)			TUBULAR STEEL Ø (IN)				SIGN FRAME REQUIRED	REMARKS	SIGN DETAIL LOCATION		
								"A"	"B"	RETAIN	SALVAGE FROM	SALVAGE TO	REMOVE	RETAIN	REMOVE		1.75	2.00	2.50	3.00	3.50	4.00	5.00			SHSM	PROJECT SHEET #	STANDARD SHEET #
																	(LB / FT)			(LB / FT)								
																	1.88	2.42	3.35	FOUNDATION	7.60	9.00	10.80					
JAMAICA VT-30 SB							FY-FLUORESCENT YELLOW FYG-FLUORESCENT YELLOW GREEN															"SHSM"-STANDARD HIGHWAY SIGNS AND MARKINGS						
SB	1.952	G	VR-017	24	24																							
		G	VR-017	24	30			5.00																6				
		G	UNK	18	24		CHILDREN AT PLAY																					
SB	1.945	G	VD-700	6	10																							
		H	R1-1	30	30			6.25																	X			
SB	1.945	F	D3-1	UNK	UNK																							
		F	D3-1	44	12			3.67																	11			
SB	1.856	F	VW-619	30	30		SHOULDER NARROWS																					
																												
SB	1.704	F	VW-619	36	36			9.00																	7			
SB	0.834	F	M2-1	21	15		JCT																					
		F	M1-5	30	24		VERMONT ROUTE 100																					
SB	0.789	F	D1-1A	72	10		DESTINATION SIGN ASSEMBLY																					
		F	D1-1A	72	10																							
		F	D1-1A	72	10																							
		F	D1-1A	72	10																							
SIGN SUMMARY SHEET							SHEET TOTALS	23.92	0.00	7	0	0	5	0	0	4	60.0	0	0.0	0.0	0.0	0.0	PROJECT NAME: STATEWIDE SOUTHWEST REGION					
								SF	SF	EA	EA	EA	EA	EA	EA	EA	FT	EA	LB	LB	LB	LB	PROJECT NUMBER: STPG SIGN(41)					
VERMONT AGENCY OF TRANSPORTATION							TOWN DIRECTIONAL TOTALS	431.84	430.2	0.0	31	2	2	85	0	0	66	990.0	0		0.0		FILE NAME: 12C118	PLOT DATE: 2/13/2013				
										29	0	0	82	0	0	63	945.0	0		0.0		PROJECT MANAGER: A. GAMBLE	DRAWN BY: J. KELLY					
																					DESIGNED BY: J. KELLY	CHECKED: A. GAMBLE						
																					JAMAICA SB SHEET 12	SHEET 54	OF 97					

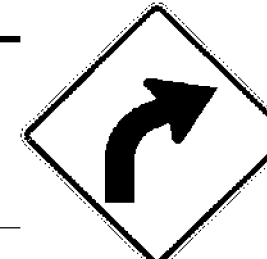


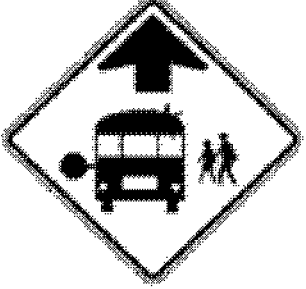
DIRECTION	MILEPOINT	LOCATION CODE (SHEET 2)	SIGN CODE	WIDTH (IN)	HEIGHT (IN)	SHEETING REMARKS	SIGN LEGEND	NEW SIGNS		EXISTING SIGNS				EXIST POST		NUMBER OF NEW POSTS	SQUARE STEEL (IN)			TUBULAR STEEL Ø (IN)				SIGN FRAME REQUIRED	REMARKS	SIGN DETAIL LOCATION			
								"A"	"B"	RETAIN	SALVAGE FROM	SALVAGE TO	REMOVE	RETAIN	REMOVE		1.75	2.00	2.50	FOUNDATION	3.00	3.50	4.00			5.00	SHSM	PROJECT SHEET #	STANDARD SHEET #
																	(LB / FT)				(LB / FT)								
WELLS VT-31 NB							FY-FLUORESCENT YELLOW FYG-FLUORESCENT YELLOW GREEN																"SHSM"-STANDARD HIGHWAY SIGNS AND MARKINGS						
NB	0.000	B	VR-040	24	24		THROUGH WAY ENDS HERE																						
		A	VR-041	24	24		THROUGH WAY BEGINS HERE																						
		A	R2-1	24	30																								
		A	VR-039	24	18																						6		
		A	R2-1	24	30		  																		X				
		B	VR-038	24	18																						6		
NB	0.025	A	VD-421	60	48																						5		
NB	0.061	A	M3-1	24	12																								
		A	M1-5	24	24																								
		A	M3-1	24	12																						E-136B		
		A	M1-5	24	24																						E-136B		
NB	0.095	A	VR-048	24	30		STATE LAW STOP FOR SCHOOL BUS																						
		A	VR-654	24	24																						6		
NB	0.187	A	VR-601A	24	30		BUCKLE UP IT'S THE LAW																						
		A	VR-601	36	36																						6		
SIGN SUMMARY SHEET							SHEET TOTALS	50.00	0.00	0	0	0	7	0	0	5	75.0	0	0.0	0.0	0.0	0.0	PROJECT NAME: STATEWIDE SOUTHWEST REGION PROJECT NUMBER: STPG SIGN(41)						
								SF	SF	EA	EA	EA	EA	EA	EA	EA	FT	EA	LB	LB	LB	LB	FILE NAME: 12C118 PROJECT MANAGER: A. GAMBLE DESIGNED BY: J. KELLY WELLS NB SHEET 1						
VERMONT AGENCY OF TRANSPORTATION							TOWN DIRECTIONAL TOTALS	136.7	0.0	0	0	0	31 30	0	0	19	285.0	0		0.0			PLOT DATE: 2/13/2013 DRAWN BY: J. KELLY CHECKED: A. GAMBLE SHEET 57 OF 97						




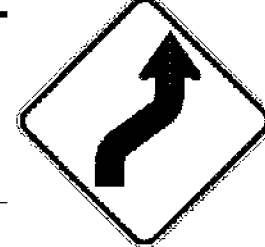



DIRECTION	MILEPOINT	LOCATION CODE (SHEET 2)	SIGN CODE	WIDTH (IN)	HEIGHT (IN)	SHEETING REMARKS	SIGN LEGEND	NEW SIGNS		EXISTING SIGNS				EXIST POST		NUMBER OF NEW POSTS	SQUARE STEEL (IN)			TUBULAR STEEL Ø (IN)				SIGN FRAME REQUIRED	REMARKS	SIGN DETAIL LOCATION			
								"A"	"B"	RETAIN	SALVAGE FROM	SALVAGE TO	REMOVE	RETAIN	REMOVE		1.75	2.00	2.50	FOUNDATION	3.00	3.50	4.00			5.00	SHSM	PROJECT SHEET #	STANDARD SHEET #
																	(LB / FT)				(LB / FT)								
WELLS VT-31 NB							FY-FLUORESCENT YELLOW FYG-FLUORESCENT YELLOW GREEN																"SHSM"-STANDARD HIGHWAY SIGNS AND MARKINGS						
		D	R1-1	30	30			6.25																	INSTALL IN ISLAND.	X			
NB	1.270	A	D3-1	38	12			3.17																	HILL TOP RD (TH-11) FIELD LOCATE AND INSTALL IN ISLAND.		12		
NB	1.280	C	VR-017	24	24																				HILL TOP RD (TH-11).				
		C	VR-017	24	30			5.00																	INSTALL WHERE BOTH LEGS COME TOGETHER.		6		
NB	1.285	D	R1-1	30	30			6.25																	HILL TOP RD (TH-11) NORTHERLY LEG.	X			
NB	1.330	A	R2-1	24	30			5.00																	INSTALL NEW SIGN 475 FEET SOUTH OF EXISTING SPEED LIMIT 50 ASSEMBLY.	X			
NB	1.420	A	R2-1	24	30		SPEED LIMIT 45 MPH																						
NB	1.490	A	W1-2L	30	30		LEFT CURVE																						
		A	W13-1	18	18		35 MPH ADVISORY																						
NB	1.540	A	W1-2L	30	30	FY		6.25																	INSTALL 265 FEET NORTH OF EXISTING LEFT CURVE SIGN ASSEMBLY.	X			
		A	W13-1P	18	18	FY		2.25																					
NB	1.565	A	W1-8L	18	24																								
		B	W1-8R	18	24																								
		A	W1-8L	18	24	FY		3.00																	INSTALL SIGNS BACK TO BACK ON SAME SIGN POST.	X			
		B	W1-8R	18	24	FY		3.00																					
SIGN SUMMARY SHEET							SHEET TOTALS	40.17	0.00	0	0	0	6	0	0	8	120.0	0	0.0	0.0	0.0	0.0	0.0	0.0	0.0	PROJECT NAME: STATEWIDE SOUTHWEST REGION	PROJECT NUMBER: STPG SIGN(41)		
VERMONT AGENCY OF TRANSPORTATION							TOWN DIRECTIONAL TOTALS	136.7	0.0	0	0	0	31	0	0	19	285.0	0		0.0						FILE NAME: 12C118	PROJECT MANAGER: A. GAMBLE	PLOT DATE: 2/13/2013	
																									DESIGNED BY: J. KELLY	CHECKED: A. GAMBLE	DRAWN BY: J. KELLY		
																										WELLS NB SHEET 3	SHEET 59	OF 97	




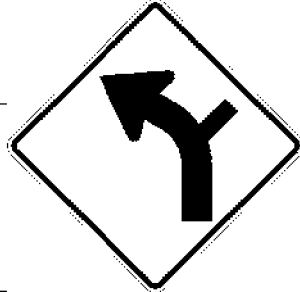


DIRECTION	MILEPOINT	LOCATION CODE (SHEET 2)	SIGN CODE	WIDTH (IN)	HEIGHT (IN)	SHEETING REMARKS	SIGN LEGEND	NEW SIGNS		EXISTING SIGNS				EXIST POST		NUMBER OF NEW POSTS	SQUARE STEEL (IN)			TUBULAR STEEL Ø (IN)				SIGN FRAME REQUIRED	REMARKS	SIGN DETAIL LOCATION					
								"A"	"B"	RETAIN	SALVAGE FROM	SALVAGE TO	REMOVE	RETAIN	REMOVE		1.75	2.00	2.50	FOUNDATION	3.00	3.50	4.00			5.00	SHSM	PROJECT SHEET #	STANDARD SHEET #		
																	(LB / FT)				(LB / FT)										
WELLS VT-31 SB							FY-FLUORESCENT YELLOW FYG-FLUORESCENT YELLOW GREEN																"SHSM"-STANDARD HIGHWAY SIGNS AND MARKINGS								
SB	1.738	F	W1-8L	18	24																										
		E	W1-8R	18	24																										
		F	W1-8L	18	24	FY		3.00							1			14'-3"	X									X		INSTALL SIGNS BACK TO BACK ON SAME SIGN POST.	
		E	W1-8R	18	24	FY		3.00																				X			
SB	1.710	F	W1-8	18	24																										
		E	W1-8	18	24																										
		F	W1-8L	18	24	FY		3.00							1			14'-5"	X									X		INSTALL SIGNS BACK TO BACK ON SAME SIGN POST.	
		E	W1-8R	18	24	FY		3.00																				X			
SB	1.680	F	W1-2R	30	30		RIGHT CURVE																								
		F	W13-1	18	18		35 MPH ADVISORY																								
																															
SB	1.660	F	W1-2R	30	30	FY		6.25							1			15'-2"	X									X		INSTALL 100 FEET SOUTH OF EXISTING RIGHT CURVE SIGN ASSEMBLY.	
		F	W13-1P	18	18	FY		2.25																				X			
SB	1.630	F	S3-1T	30	30		SCHOOL BUS STOP AHEAD																								
		F	S3-1	36	36	FYG		9.00							2			14'-6"	X									X			
SB	1.465	F	R2-1	24	30																										
SIGN SUMMARY SHEET							SHEET TOTALS		29.50	0.00	0	0	0	6 8	0	0	5	75.0	0	0.0	0.0	0.0	0.0	PROJECT NAME: STATEWIDE SOUTHWEST REGION							
									SF	SF	EA	EA	EA	EA	EA	EA	EA	FT	EA	LB	LB	LB	LB	PROJECT NUMBER: STPG SIGN(41)							
VERMONT AGENCY OF TRANSPORTATION							TOWN DIRECTIONAL TOTALS		75.8	0.0	1	0	0	15 18	0	0	11	165.0	0		0.0			FILE NAME: 12C118							
																								PROJECT MANAGER: A. GAMBLE							
																								PLOT DATE: 2/13/2013							
																								DRAWN BY: J. KELLY							
																								DESIGNED BY: J. KELLY							
																								CHECKED: A. GAMBLE							
																								WELLS SB SHEET 1							
																								SHEET 61 OF 97							


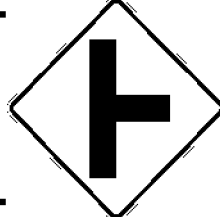




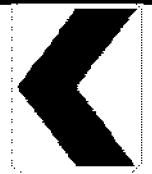


DIRECTION	MILEPOINT	LOCATION CODE (SHEET 2)	SIGN CODE	WIDTH (IN)	HEIGHT (IN)	SHEETING REMARKS	SIGN LEGEND	NEW SIGNS		EXISTING SIGNS				EXIST POST		NUMBER OF NEW POSTS	SQUARE STEEL (IN)			TUBULAR STEEL Ø (IN)				SIGN FRAME REQUIRED	REMARKS	SIGN DETAIL LOCATION						
								"A"	"B"	RETAIN	SALVAGE FROM	SALVAGE TO	REMOVE	RETAIN	REMOVE		1.75	2.00	2.50	FOUNDATION	3.00	3.50	4.00			5.00	SHSM	PROJECT SHEET #	STANDARD SHEET #			
																	(LB / FT)				(LB / FT)											
WELLS VT-31 SB							FY-FLUORESCENT YELLOW FYG-FLUORESCENT YELLOW GREEN																"SHSM"-STANDARD HIGHWAY SIGNS AND MARKINGS									
		F	R2-1	24	30			5.00								1	12'-5" X								X							
SB	1.360	F	W1-4R	30	30		RIGHT REVERSE CURVE																									
		F	W13-1	18	18		35 MPH ADVISORY																									
SB	1.300	F	W1-4R	30	30			6.25								1	14'-2" X								X		INSTALL 325 FEET SOUTH OF EXISTING REVERSE CURVE ASSEMBLY.					
SB	1.070	F	W1-4R	30	30		RIGHT REVERSE CURVE																									
SB	0.765	F	W11-5	30	30		FARM MACHINERY																				SIGN ASSEMBLY NOT FOUND IN THE FIELD					
		F	R2-1	24	30			5.00								1	14'-7" X								X							
SB	0.710	F	R2-1	24	30		SPEED LIMIT 45																									
SB	0.670	F	W1-4R	30	30		RIGHT REVERSE CURVE																									
		F	W13-1	18	18		35 MPH ADVISORY																									
SB	0.625	F	VW-060	30	30																											
		F	VW-060	30	30			6.25								1	11'-0" X										INSTALL ON EXISTING FLANGED CHANNEL SIGN POST.					
SB	0.587	F	W1-4R	30	30			6.25								1	15'-0" X								X		INSTALL 200 FEET SOUTH OF HIDDEN DRIVES SIGN ASSEMBLY.					
		F	W13-1P	18	18			2.25																	X							
SB		F	S3-1T	30	30		NEW YORK INSTALLED SCHOOL BUS STOP AHEAD				1																EXACT MILE POINT UNKNOWN. RETAIN ASSEMBLY.					
SIGN SUMMARY SHEET							SHEET TOTALS	31.00	0.00	1	0	0	7	0	0	4	60.0	0	0.0	0.0	0.0	0.0	0.0	0.0	PROJECT NAME: STATEWIDE SOUTHWEST REGION PROJECT NUMBER: STPG SIGN(41)							
VERMONT AGENCY OF TRANSPORTATION							TOWN DIRECTIONAL TOTALS	75.8	0.0	1	0	0	15	0	0	11	165.0	0		0.0						FILE NAME: 12C118 PROJECT MANAGER: A. GAMBLE DESIGNED BY: J. KELLY WELLS SB SHEET 2						
																												PLOT DATE: 2/13/2013 DRAWN BY: J. KELLY CHECKED: A. GAMBLE SHEET 62 OF 97				








DIRECTION	MILEPOINT	LOCATION CODE (SHEET 2)	SIGN CODE	WIDTH (IN)	HEIGHT (IN)	SHEETING REMARKS	SIGN LEGEND	NEW SIGNS		EXISTING SIGNS				EXIST POST		NUMBER OF NEW POSTS	SQUARE STEEL (IN)			TUBULAR STEEL Ø (IN)				SIGN FRAME REQUIRED	REMARKS	SIGN DETAIL LOCATION			
								"A"	"B"	RETAIN	SALVAGE FROM	SALVAGE TO	REMOVE	RETAIN	REMOVE		1.75	2.00	2.50	FOUNDATION	3.00	3.50	4.00			5.00	SHSM	PROJECT SHEET #	STANDARD SHEET #
																	(LB / FT)				(LB / FT)								
WELLS VT-31 SB							FY-FLUORESCENT YELLOW FYG-FLUORESCENT YELLOW GREEN															"SHSM"-STANDARD HIGHWAY SIGNS AND MARKINGS							
SB	0.050	F	W2-2MR	30	30		MODIFIED RIGHT SIDE ROAD					1		X															
		F	VW-202P	24	18							1																	
		F	W2-2R	30	30			6.25							1	13'-1"	X						X						
		F	VW-202P	24	18			3.00																6					
SB	0.000	F	M4-6	24	12			2.00							1	12'-9"	X						X						
		F	M1-5	24	24			4.00																	E-136B				
SIGN SUMMARY SHEET							SHEET TOTALS	15.25	0.00	0	0	0	2	0	0	2	30.0	0	0.0	0.0	0.0	0.0	PROJECT NAME: STATEWIDE SOUTHWEST REGION PROJECT NUMBER: STPG SIGN(41)						
VERMONT AGENCY OF TRANSPORTATION							TOWN DIRECTIONAL TOTALS	75.8	0.0	1	0	0	15	0	0	11	165.0	0		0.0			FILE NAME: 12C118 PROJECT MANAGER: A. GAMBLE DESIGNED BY: J. KELLY WELLS SB SHEET 3			PLOT DATE: 2/13/2013 DRAWN BY: J. KELLY CHECKED: A. GAMBLE SHEET 63 OF 97			

DIRECTION	MILEPOINT	LOCATION CODE (SHEET 2)	SIGN CODE	WIDTH (IN)	HEIGHT (IN)	SHEETING REMARKS	SIGN LEGEND	NEW SIGNS		EXISTING SIGNS				EXIST POST		NUMBER OF NEW POSTS	SQUARE STEEL (IN)			TUBULAR STEEL Ø (IN)				SIGN FRAME REQUIRED	REMARKS	SIGN DETAIL LOCATION			
								"A"	"B"	RETAIN	SALVAGE FROM	SALVAGE TO	REMOVE	RETAIN	REMOVE		1.75	2.00	2.50	FOUNDATION	3.00	3.50	4.00			5.00	SHSM	PROJECT SHEET #	STANDARD SHEET #
																	(LB / FT)				(LB / FT)								
POULTNEY VT-31 NB							FY-FLUORESCENT YELLOW FYG-FLUORESCENT YELLOW GREEN																"SHSM"-STANDARD HIGHWAY SIGNS AND MARKINGS						
NB	0.000	C	VD-700	6	10		MILE MARKERS (2)						2																
		C	VD-024	60	7.5		<div style="border: 1px solid black; padding: 5px; display: inline-block;"> Poultney Wells </div>						1													8			
		C	VD-024	72	10																								
		C	VD-700	6	10			0310 1117 0000																			E-138		
		C	VD-700	6	10			0310 1126 0176																			E-138		
NB	0.270	A	R2-1	24	30								1																
		A	R2-1	24	30																								
NB	0.340	A	UNK				UNKNOWN MISSING SIGN						1																
NB	0.570	A	W11-5	30	30								1																
		A	W11-5	30	30																								
NB	0.710	A	R2-1	24	30								1																
		A	R2-1	24	30																								
		A	W8-9	30	30		LOW SHOULDERS						1																
NB	0.768	A	S3-1T	30	30		SCHOOL BUS STOP AHEAD						1																
		A	VW-054L	30	30		HIDDEN DRIVE LEFT						1																
		A	S3-1	36	36	FYG																							
SIGN SUMMARY SHEET							SHEET TOTALS	31.09	0.00	0	0	0	9	0	0	4	60.0	0	0.0	0.0	0.0	0.0	PROJECT NAME: STATEWIDE SOUTHWEST REGION						
								SF	SF	EA	EA	EA	EA	EA	EA	EA	FT	EA	LB	LB	LB	LB	PROJECT NUMBER: STPG SIGN(41)						
VERMONT AGENCY OF TRANSPORTATION							TOWN DIRECTIONAL TOTALS	248.2	0.0	2	0	0	60	0	0	27	405.0	0	0.0	0.0	0.0	0.0	FILE NAME: 12C118	PROJECT MANAGER: A. GAMBLE	PLOT DATE: 2/13/2013				
								243.2	0.0	2	0	0	57	0	0	25	375.0	0	0.0	0.0	0.0	DESIGNED BY: J. KELLY	CHECKED: A. GAMBLE	DRAWN BY: J. KELLY					
																						POULTNEY NB SHEET 1	SHEET 64	OF 97					

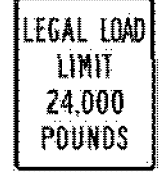



DIRECTION	MILEPOINT	LOCATION CODE (SHEET 2)	SIGN CODE	WIDTH (IN)	HEIGHT (IN)	SHEETING REMARKS	SIGN LEGEND	NEW SIGNS		EXISTING SIGNS				EXIST POST		NUMBER OF NEW POSTS	SQUARE STEEL (IN)			TUBULAR STEEL Ø (IN)				SIGN FRAME REQUIRED	REMARKS	SIGN DETAIL LOCATION			
								"A"	"B"	RETAIN	SALVAGE FROM	SALVAGE TO	REMOVE	RETAIN	REMOVE		1.75	2.00	2.50	FOUNDATION	3.00	3.50	4.00			5.00	SHSM	PROJECT SHEET #	STANDARD SHEET #
																	(LB / FT)				(LB / FT)								
POULTNEY VT-31 NB							FY-FLUORESCENT YELLOW FYG-FLUORESCENT YELLOW GREEN																"SHSM"-STANDARD HIGHWAY SIGNS AND MARKINGS						
NB	0.812	A	W1-2ML	30	30		MODIFIED LEFT CURVE																						
		A	W13-1	18	18		35 MPH ADVISORY																						
		A	W1-10L	36	36	FY		9.00																	X				
		A	W13-1P	18	18	FY		2.25																		X			
NB	0.847	A	D3-1	UNK	UNK		RUBY RD STREET SIGN																						
NB	0.848	C	VR-017	24	24																								
		C	VR-017	24	30			5.00																		6			
NB	0.860	A	D3-1	32	12			2.66																		12			
		D	R1-1	30	30																								
		D	R1-1	30	30			6.25																					
NB	0.878	A	W1-8L	18	24																								
		A	W1-8L	18	24	FY		3.00																	X				
NB	0.878	B	W1-8R	18	24																								
		B	W1-8R	18	24	FY		3.00																	X				
NB	0.902	A	W1-8L	18	24																								
SIGN SUMMARY SHEET							SHEET TOTALS	31.16	0.00	0	0	0	8	0	0	4	60.0	30.0	0	0.0	0.0	0.0	0.0	PROJECT NAME: STATEWIDE SOUTHWEST REGION PROJECT NUMBER: STPG SIGN(41)					
VERMONT AGENCY OF TRANSPORTATION							TOWN DIRECTIONAL TOTALS	248.2	0.0	2	0	0	60	0	0	27	405.0	375.0	0	0.0	0.0	0.0	0.0	FILE NAME: 12C118 PROJECT MANAGER: A. GAMBLE DESIGNED BY: J. KELLY POULTNEY NB SHEET 2					
																							PLOT DATE: 2/13/2013 DRAWN BY: J. KELLY CHECKED: A. GAMBLE SHEET 65 OF 97						






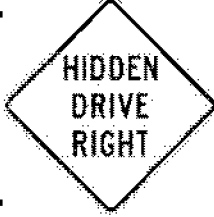

DIRECTION	MILEPOINT	LOCATION CODE (SHEET 2)	SIGN CODE	WIDTH (IN)	HEIGHT (IN)	SHEETING REMARKS	SIGN LEGEND	NEW SIGNS		EXISTING SIGNS				EXIST POST		NUMBER OF NEW POSTS	SQUARE STEEL (IN)			TUBULAR STEEL Ø (IN)				SIGN FRAME REQUIRED	REMARKS	SIGN DETAIL LOCATION			
								"A"	"B"	RETAIN	SALVAGE FROM	SALVAGE TO	REMOVE	RETAIN	REMOVE		1.75	2.00	2.50	FOUNDATION	3.00	3.50	4.00			5.00	SHSM	PROJECT SHEET #	STANDARD SHEET #
																	(LB / FT)				(LB / FT)								
POULTNEY VT-31 NB							FY-FLUORESCENT YELLOW FYG-FLUORESCENT YELLOW GREEN																"SHSM"-STANDARD HIGHWAY SIGNS AND MARKINGS						
		A	W1-8L	18	24	FY		3.00																INSTALL ON EXISTING FLANGED CHANNEL SIGN POST.	X				
NB	0.902	B	W1-8R	18	24							1	X											INSTALL ON EXISTING FLANGED CHANNEL SIGN POST.					
		B	W1-8R	18	24	FY		3.00																INSTALL ON EXISTING FLANGED CHANNEL SIGN POST.	X				
NB	0.920	A	W1-8L	18	24							1	X											INSTALL ON EXISTING FLANGED CHANNEL SIGN POST.					
		A	W1-8L	18	24	FY		3.00																INSTALL ON EXISTING FLANGED CHANNEL SIGN POST.	X				
NB	0.920	B	W1-8R	18	24							1	X											INSTALL ON EXISTING FLANGED CHANNEL SIGN POST.					
		B	W1-8R	18	24	FY		3.00																INSTALL ON EXISTING FLANGED CHANNEL SIGN POST.	X				
NB	0.961	A	W1-2R	30	30		RIGHT CURVE					1		X															
		A	W13-1	18	18		35 MPH					1																	
NB	1.065	A	W1-2R	30	30			6.25							1	14'-10" X								INSTALL 550 FEET NORTH OF EXISTING RIGHT CURVE SIGN ASSEMBLY.	X				
NB	1.225	A	VW16-18P	24	12	FY		2.00						1	15'-4" X									INSTALL 75 FEET SOUTH OF EXISTING SPEED LIMIT 50 SIGN ASSEMBLY.		6			
		A	R2-1	24	30			5.00																		X			
		A	R2-5P	24	18			3.00																		X			
NB	1.240	A	R2-1	24	30		SPEED LIMIT 50					1		X															
		A	VR-208	24	24		UNLESS OTHERWISE POSTED					1																	
SIGN SUMMARY SHEET							SHEET TOTALS	28.25	0.00	0	0	0	7	0	0	2	30.0	0	0.0	0.0	0.0	0.0	0.0	0.0	PROJECT NAME: STATEWIDE SOUTHWEST REGION				
								SF	SF	EA	EA	EA	EA	EA	EA	EA	FT	EA	LB	LB	LB	LB	LB	PROJECT NUMBER: STPG SIGN(41)					
VERMONT AGENCY OF TRANSPORTATION							TOWN DIRECTIONAL TOTALS	248.2	243.2	0.0	2	0	0	60	57	0	0	27	25	405.0	375.0	0	0.0	0.0	0.0	FILE NAME: 12C118	PROJECT MANAGER: A. GAMBLE	PLOT DATE: 2/13/2013	
																								DESIGNED BY: J. KELLY	CHECKED: A. GAMBLE	DRAWN BY: J. KELLY			
																									POULTNEY NB SHEET 3	SHEET 66	OF 97		






DIRECTION	MILEPOINT	LOCATION CODE (SHEET 2)	SIGN CODE	WIDTH (IN)	HEIGHT (IN)	SHEETING REMARKS	SIGN LEGEND	NEW SIGNS		EXISTING SIGNS				EXIST POST		NUMBER OF NEW POSTS	SQUARE STEEL (IN)			TUBULAR STEEL Ø (IN)				SIGN FRAME REQUIRED	REMARKS	SIGN DETAIL LOCATION			
								"A"	"B"	RETAIN	SALVAGE FROM	SALVAGE TO	REMOVE	RETAIN	REMOVE		1.75	2.00	2.50	FOUNDATION	3.00	3.50	4.00			5.00	SHSM	PROJECT SHEET #	STANDARD SHEET #
																	(LB / FT)				(LB / FT)								
POULTNEY VT-31 NB							FY-FLUORESCENT YELLOW FYG-FLUORESCENT YELLOW GREEN															"SHSM"-STANDARD HIGHWAY SIGNS AND MARKINGS							
NB	2.003	A	VD-700 W2-2R	6 30	10 30		RIGHT SIDE ROAD 					1																	
NB	2.050	A	W2-2R	30	30			6.25										13'-5" X						INSTALL 250 NORTH OF EXISTING RIGHT SIDE ROAD SIGN ASSEMBLY.	X				
NB	2.128	C	VR-079	24	30							1												UPPER RD (TH-11)					
		C	VR-079	24	30			5.00										12'-9" X										6	
NB	2.132	D	VD-700 R1-1	6 30	10 30		 	6.25		1			1	X											UPPER RD (TH-11) INSTALL ON EXISTING FLANGED CHANNEL SIGN POST.	X			
NB	2.133	A	D3-1	UNK	UNK		UPPER RD STREET SIGN 	2.83																	UPPER RD (TH-11)			12	
NB	2.390	A	R2-5A	24	30		REDUCED SPEED AHEAD 																						
		A	W3-5	36	36			9.00										14'-2" 14'-4" X								X			
NB	2.429	A	VD-018	30	18			3.75																	INSTALL SIGN ON EXISTING FLANGED CHANNEL SIGN POST.			5	
NB	2.470	A	R2-1	24	30		SPEED LIMIT 40																						
NB	2.473	A	R2-1	30	36			7.50											13'-7" X						INSTALL NEW 10+/- FEET NORTH OF AND ACROSS FROM UTILITY POLE.	X			
NB	2.506	C	R2-1 VR-017	18 24	24 30																				JONES RD (TH-35)				
SIGN SUMMARY SHEET							SHEET TOTALS	40.58	0.00	1 0	0	0	10 8	0	0	6	90.0	0	0.0	0.0	0.0	0.0	PROJECT NAME: STATEWIDE SOUTHWEST REGION PROJECT NUMBER: STPG SIGN(41)						
VERMONT AGENCY OF TRANSPORTATION							TOWN DIRECTIONAL TOTALS	248.2 243.2	0.0	2	0	0	60 57	0	0	27 25	405.0 375.0	0		0.0		FILE NAME: 12C118 PROJECT MANAGER: A. GAMBLE DESIGNED BY: J. KELLY POULTNEY NB SHEET 4	PLOT DATE: 2/13/2013 DRAWN BY: J. KELLY CHECKED: A. GAMBLE SHEET 67 OF 97						

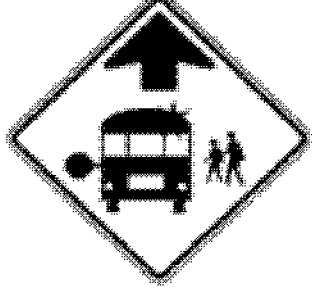DIRECTION	MILEPOINT	LOCATION CODE (SHEET 2)	SIGN CODE	WIDTH (IN)	HEIGHT (IN)	SHEETING REMARKS	SIGN LEGEND	NEW SIGNS		EXISTING SIGNS				EXIST POST		NUMBER OF NEW POSTS	SQUARE STEEL (IN)			TUBULAR STEEL Ø (IN)				SIGN FRAME REQUIRED	REMARKS	SIGN DETAIL LOCATION			
								"A"	"B"	RETAIN	SALVAGE FROM	SALVAGE TO	REMOVE	RETAIN	REMOVE		1.75	2.00	2.50	FOUNDATION	3.00	3.50	4.00			5.00	SHSM	PROJECT SHEET #	STANDARD SHEET #
																	(LB / FT)				(LB / FT)								
POULTNEY VT-31 NB							FY-FLUORESCENT YELLOW FYG-FLUORESCENT YELLOW GREEN																"SHSM"-STANDARD HIGHWAY SIGNS AND MARKINGS						
		C	R2-1	24	30		 	5.00																INSTALL SPEED LIMIT 25 BELOW LEGAL LOAD LIMIT		6			
		C	VR-017	24	30			5.00						1	14'-9"	X													
NB	2.510	D	R1-1	30	30								1											JONES RD (TH-35)					
		D	R1-1	30	30			6.25						1	8'-3"	X								INSTALL ON EAST SIDE OF TREE.	X				
NB	2.510	A	D3-1	UNK	UNK								1											JONES RD (TH-35)					
		A	D3-1	34	12			2.83						1	11'-6"	X								INSTALL ON WEST SIDE OF TREE.		12			
NB	2.700	A	W1-4R	30	30		RIGHT REVERSE CURVE						1																
		A	W13-1	18	18		35 MPH ADVISORY						1																
		A	R2-1	24	30			5.00																INSTALL NEW SIGN ON EXISTING FLANGED CHANNEL SIGN POST.	X				
NB	2.812 2.850	A	W1-4R	30	30		 	6.25						1	15'-0"	X								INSTALL SIGN ASSEMBLY 800 FEET NORTH OF EXISTING RIGHT REVERSE CURVE ASSEMBLY.	X				
		A	W13-1P	18	18			2.25																		X			
NB	3.117	A	R2-5A	24	30		REDUCED SPEED AHEAD						1																
NB	3.160	A	VD-062C	74.75	16		BUSINESS SIGN			1																			
		A	VD-062BC	74.75	16		BUSINESS SIGN			1																			
NB	3.202	B	VR-039	24	18		STATE HIGHWAY BEGINS						1																
		A	VR-040	24	24		THROUGH WAY ENDS HERE						1																
SIGN SUMMARY SHEET							SHEET TOTALS	32.58 27.58	0.00	2	0	0	7	0	0	4	60.0	0	0.0	0.0	0.0	0.0	0.0	PROJECT NAME: STATEWIDE SOUTHWEST REGION	PROJECT NUMBER: STPG SIGN(41)				
VERMONT AGENCY OF TRANSPORTATION							TOWN DIRECTIONAL TOTALS	248.2 243.2	0.0	2	0	0	60 57	0	0	27 25	405.0 375.0	0		0.0				FILE NAME: 12C118	PROJECT MANAGER: A. GAMBLE	PLOT DATE: 2/13/2013			
																							DESIGNED BY: J. KELLY	CHECKED: A. GAMBLE	DRAWN BY: J. KELLY	SHEET 68 OF 97			







DIRECTION	MILEPOINT	LOCATION CODE (SHEET 2)	SIGN CODE	WIDTH (IN)	HEIGHT (IN)	SHEETING REMARKS	SIGN LEGEND	NEW SIGNS		EXISTING SIGNS				EXIST POST		NUMBER OF NEW POSTS	SQUARE STEEL (IN)			TUBULAR STEEL Ø (IN)				SIGN FRAME REQUIRED	REMARKS	SIGN DETAIL LOCATION				
								"A"	"B"	RETAIN	SALVAGE FROM	SALVAGE TO	REMOVE	RETAIN	REMOVE		1.75	2.00	2.50	FOUNDATION	3.00	3.50	4.00			5.00	SHSM	PROJECT SHEET #	STANDARD SHEET #	
																	(LB / FT)				(LB / FT)									
POULTNEY VT-31 SB							FY-FLUORESCENT YELLOW FYG-FLUORESCENT YELLOW GREEN																"SHSM"-STANDARD HIGHWAY SIGNS AND MARKINGS							
BEGINNING OF CLASS 1 SECTION OF ROADWAY (SOUTHBOUND). NOTE: STICKERS ON BACK OF SIGNS IN CLASS 1 SECTION OF POULTNEY VILLAGE SHALL HAVE "POULTNEY (DATE) TH-2"																														
SB	3.768	F	W12-2	36	36		 																							
		F	W12-2	36	36																								X	
		F	W16-2P	24	18																									X
SB	3.757	F	R2-1	24	30																								X	
		F	M1-5	24	24																									
		F	M3-3	24	12																									
		F	M3-3	24	12																									E-136B
		F	M1-5	24	24																									E-136B
		F	W12-2	36	36																									
SB	3.609	F	W12-2	36	36																									X
		F	M1-5	24	24																									
		F	M3-3	24	12																									
STICKERS ON BACK OF SIGNS IN CLASS 1 SECTION OF POULTNEY TOWN SHALL HAVE "POULTNEY (DATE) TH-1"																														
SB	3.568	F	R2-1	24	30																									X
		F	R2-1	24	30																									X
		F	R2-1	24	30																									X
SB	3.400	F	R2-1	24	30																									X
		F	R2-1	24	30																									X
		F	R2-1	24	30																									X
END CLASS 1 AND BEGINNING OF STATE SECTION OF ROADWAY (SOUTHBOUND).																														
SIGN SUMMARY SHEET							SHEET TOTALS										PROJECT NAME: STATEWIDE SOUTHWEST REGION													
							42.00	0.00	0	0	0	4	0	0	7	105.0	0	0.0	0.0	0.0	0.0	PROJECT NUMBER: STPG SIGN(41)								
							SF	SF	EA	EA	EA	EA	EA	EA	EA	FT	EA	LB	LB	LB	LB	FILE NAME: 12C118								
VERMONT AGENCY OF TRANSPORTATION							TOWN DIRECTIONAL TOTALS										PROJECT MANAGER: A. GAMBLE													
							207.2	0.0	2	0	0	43	0	0	31	465.0	0				0.0	PLOT DATE: 2/13/2013								
												41			29	435.0						DRAWN BY: J. KELLY								
																						DESIGNED BY: J. KELLY								
																						CHECKED: A. GAMBLE								
																						POULTNEY SB SHEET 1								
																						SHEET 72 OF 97								

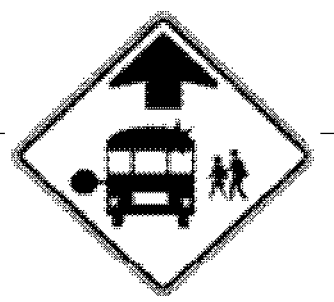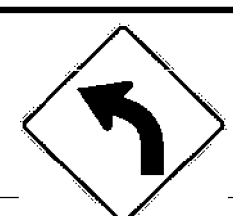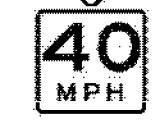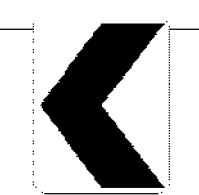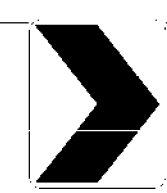DIRECTION	MILEPOINT	LOCATION CODE (SHEET 2)	SIGN CODE	WIDTH (IN)	HEIGHT (IN)	SHEETING REMARKS	SIGN LEGEND	NEW SIGNS		EXISTING SIGNS				EXIST POST		NUMBER OF NEW POSTS	SQUARE STEEL (IN)			TUBULAR STEEL Ø (IN)				SIGN FRAME REQUIRED	REMARKS	SIGN DETAIL LOCATION																									
								"A"	"B"	RETAIN	SALVAGE FROM	SALVAGE TO	REMOVE	RETAIN	REMOVE		1.75	2.00	2.50	FOUNDATION	3.00	3.50	4.00			5.00	SHSM	PROJECT SHEET #	STANDARD SHEET #																						
																	(LB / FT)				(LB / FT)																														
POULTNEY VT-31 SB							FY-FLUORESCENT YELLOW FYG-FLUORESCENT YELLOW GREEN																"SHSM"-STANDARD HIGHWAY SIGNS AND MARKINGS																												
SB	1.167	F	W1-2L	30	30			6.25							1	15'-0" X									INSTALL 200 FEET SOUTH OF EXISTING LEFT CURVE SIGN ASSEMBLY.	X																									
SB	1.150	F	W1-8L	18	24		CHEVRON																																												
SB	1.14-1.07	E/F	N/A	6	8		INSTALL ⁷ (8) NEW DELINEATOR POSTS																					4																							
SB	1.145	E	W1-8R	18	24		CHEVRON																																												
SB	1.120	F	W1-8L	18	24		CHEVRON																																												
SB	1.120	E	W1-8R	18	24		CHEVRON																																												
SB	1.090	F	W1-8R	18	24		CHEVRON																																												
SB	1.090	E	W1-8L	18	24		CHEVRON																																												
SB	1.000	F	VW-054R	30	30		HIDDEN DRIVE RIGHT																																												
		F	S3-1T	30	30		SCHOOL BUS STOP AHEAD																																												
		F	W1-10R	36	36	FY		9.00																	INSTALL NEW SIGNS ON EXISTING FLANGED CHANNEL SIGN POSTS.	X																									
		F	S3-1	36	36	FYG		9.00																			X																								
SB	0.955	F	W1-2MR	30	30		MODIFIED RIGHT CURVE																																												
		F	W13-1	18	18		35 MPH ADVISORY																																												
SB	0.940	F	VW-133R	30	30			6.25							1	12'-8" X										INSTALL 80 FEET SOUTH OF EXISTING RIGHT CURVE SIGN ASSEMBLY.		7																							
SIGN SUMMARY SHEET							SHEET TOTALS	30.50	0.00	0	0	0	10	0	0	2 1	30.0 15.0	0	0.0	0.0	0.0	0.0	0.0	0.0	0.0	0.0	0.0	0.0	0.0	0.0																					
VERMONT AGENCY OF TRANSPORTATION							TOWN DIRECTIONAL TOTALS	207.2	0.0	2	0	0	43 41	0	0	31 29	465.0 435.0	0			0.0																														
																						PROJECT NAME:	STATEWIDE SOUTHWEST REGION					PROJECT NUMBER:					STPG SIGN(41)					FILE NAME: 12C118					PLOT DATE: 2/13/2013								
																						PROJECT MANAGER: A. GAMBLE					DESIGNED BY: J. KELLY					POULTNEY SB SHEET 4					DRAWN BY: J. KELLY					CHECKED: A. GAMBLE					SHEET 75 OF 97				



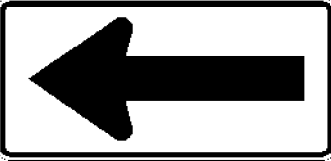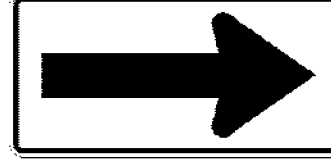


DIRECTION	MILEPOINT	LOCATION CODE (SHEET 2)	SIGN CODE	WIDTH (IN)	HEIGHT (IN)	SHEETING REMARKS	SIGN LEGEND	NEW SIGNS		EXISTING SIGNS				EXIST POST		NUMBER OF NEW POSTS	SQUARE STEEL (IN)			TUBULAR STEEL Ø (IN)				SIGN FRAME REQUIRED	REMARKS	SIGN DETAIL LOCATION			
								"A"	"B"	RETAIN	SALVAGE FROM	SALVAGE TO	REMOVE	RETAIN	REMOVE		1.75	2.00	2.50	FOUNDATION	3.00	3.50	4.00			5.00	SHSM	PROJECT SHEET #	STANDARD SHEET #
																	(LB / FT)				(LB / FT)								
POULTNEY VT-31 SB							FY-FLUORESCENT YELLOW FYG-FLUORESCENT YELLOW GREEN																"SHSM"-STANDARD HIGHWAY SIGNS AND MARKINGS						
SB	0.908	F	W11-5	30	30																		INSTALL NEW SIGN ON EXISTING FLANGED CHANNEL SIGN POST.	X					
SB	0.730	G	VR-017	24	30																		NEW BOSTON RD (TH-40)			6			
		G	VR-017	24	30																								
SB	0.724	H	R1-1	30	30																		NEW BOSTON RD (TH-40)		X				
		H	R1-1	30	30																								
SB	0.720	F	D3-1	UNK	UNK																		NEW BOSTON RD (TH-40)			12			
		F	D3-1	56	12																								
SB	0.715	F	UNK	UNK	UNK		EMPTY POST																EMPTY POST NOT FOUND IN THE FIELD REMOVE EMPTY POST.						
SB	0.710	F	R2-1	24	30																								
		F	R2-1	24	30																		INSTALL NEW SIGN AT LEAST 10 FEET NORTH OF UTILITY POLE.	X					
		F	R2-1	24	30																								
SB	0.600	F	VD-700 VW-054R	6 30	10 30		HIDDEN DRIVE RIGHT 																						
		F	VW-054R	30	30																								
SB	0.500	F	VW-054R	30	30																		INSTALL 525 FEET SOUTH OF EXISTING HIDDEN DRIVE RIGHT SIGN ASSEMBLY.			7			
		F	VW-054R	30	30																								
SB	0.274	F	R2-1	24	30																								
		F	R2-1	24	30																				X				
		F	R2-1	24	30																								
SIGN SUMMARY SHEET							SHEET TOTALS	38.42	0.00	0	0	0	8	0	0	7	105.0	0	0.0	0.0	0.0	0.0		PROJECT NAME: STATEWIDE SOUTHWEST REGION					
								SF	SF	EA	EA	EA	EA	EA	EA	EA	FT	EA	LB	LB	LB	LB		PROJECT NUMBER: STPG SIGN(41)					
																								FILE NAME: 12C118					
VERMONT AGENCY OF TRANSPORTATION							TOWN DIRECTIONAL TOTALS	207.2	0.0	2	0	0	43 41	0	0	31 29	465.0 435.0	0			0.0				PROJECT MANAGER: A. GAMBLE				
																								DESIGNED BY: J. KELLY					
																								PLOTTED DATE: 2/13/2013					
																								DRAWN BY: J. KELLY					
																								CHECKED: A. GAMBLE					
																								SHEET 76 OF 97					

DIRECTION	MILEPOINT	LOCATION CODE (SHEET 2)	SIGN CODE	WIDTH (IN)	HEIGHT (IN)	SHEETING REMARKS	SIGN LEGEND	NEW SIGNS		EXISTING SIGNS				EXIST POST		NUMBER OF NEW POSTS	SQUARE STEEL (IN)			TUBULAR STEEL Ø (IN)				SIGN FRAME REQUIRED	REMARKS	SIGN DETAIL LOCATION			
								"A"	"B"	RETAIN	SALVAGE FROM	SALVAGE TO	REMOVE	RETAIN	REMOVE		1.75	2.00	2.50	FOUNDATION	3.00	3.50	4.00			5.00	SHSM	PROJECT SHEET #	STANDARD SHEET #
																	(LB / FT)				(LB / FT)								
POULTNEY VT-31 SB							FY-FLUORESCENT YELLOW FYG-FLUORESCENT YELLOW GREEN																"SHSM"-STANDARD HIGHWAY SIGNS AND MARKINGS						
SB	0.200	F	S3-1T	30	30		SCHOOL BUS STOP AHEAD 																						
		F	S3-1	36	36	FYG		9.00																		X			
SB	0.074	F	W1-2L	30	30		LEFT CURVE																						
		F	W13-1	18	18		35 MPH ADVISORY																						
SB	0.040	F	W1-2L	30	30	FY		6.25																		X		INSTALL 180 FEET SOUTH OF EXISTING LEFT CURVE SIGN ASSEMBLY.	
		F	W13-1P	18	18	FY		2.25																		X			
SB	0.000	F	W1-8L	18	24																								
		E	W1-8R	18	24																								
		F	W1-8L	18	24	FY		3.00																		X		INSTALL SIGNS BACK TO BACK ON SAME SIGN POST.	
		E	W1-8R	18	24	FY		3.00																		X			
SIGN SUMMARY SHEET							SHEET TOTALS	23.50	0.00	0	0	0	5 3	0	0	4	60.0	0	0.0	0.0	0.0	0.0	0.0	0.0	0.0	0.0	PROJECT NAME: STATEWIDE SOUTHWEST REGION PROJECT NUMBER: STPG SIGN(41)		
VERMONT AGENCY OF TRANSPORTATION							TOWN DIRECTIONAL TOTALS	207.2	0.0	2	0	0	43 41	0	0	31 29	465.0 435.0	0		0.0						FILE NAME: 12C118 PROJECT MANAGER: A. GAMBLE DESIGNED BY: J. KELLY POULTNEY SB SHEET 6	PLOT DATE: 2/13/2013 DRAWN BY: J. KELLY CHECKED: A. GAMBLE SHEET 77 OF 97		








DIRECTION	MILEPOINT	LOCATION CODE (SHEET 2)	SIGN CODE	WIDTH (IN)	HEIGHT (IN)	SHEETING REMARKS	SIGN LEGEND	NEW SIGNS		EXISTING SIGNS				EXIST POST		NUMBER OF NEW POSTS	SQUARE STEEL (IN)			TUBULAR STEEL Ø (IN)				SIGN FRAME REQUIRED	REMARKS	SIGN DETAIL LOCATION			
								"A"	"B"	RETAIN	SALVAGE FROM	SALVAGE TO	REMOVE	RETAIN	REMOVE		1.75	2.00	2.50	FOUNDATION	3.00	3.50	4.00			5.00	SHSM	PROJECT SHEET #	STANDARD SHEET #
																	(LB / FT)				(LB / FT)								
POWNAI VT-346 NB							FY-FLUORESCENT YELLOW FYG-FLUORESCENT YELLOW GREEN																"SHSM"-STANDARD HIGHWAY SIGNS AND MARKINGS						
NB	0.020	A	VD-700 M3-1	6 24	10 12					1																			
		A	M1-5	30	24																								
		A	M3-1	24	12			2.00																				E-136B	
		A	M1-5	30	24			5.00																			E-136B		
NB	0.033	A	VR-644P	24	12																								
		A	R8-3A	24	24																								
		A	R3-9cP	30	12			2.50																					
		A	R8-3A	24	24			4.00																					
NB	0.070	A	R2-1	24	30																								
		A	R2-1	24	30			5.00																					
NB	0.087	A	D1-1M	72	10																								
		A	D2-1	72	10																								
		A	VD2-1	72	12			6.00																					
		A	VD2-1	72	12			6.00																					
NB	0.129	A	W11-8	30	30																								
SIGN SUMMARY SHEET							SHEET TOTALS	30.50	0.00	1 0	0	0	8	0	0	0	0.0	0	0.0	0.0	0.0	0.0	0.0	0.0	0.0	PROJECT NAME: STATEWIDE SOUTHWEST REGION PROJECT NUMBER: STPG SIGN(41)			
VERMONT AGENCY OF TRANSPORTATION							TOWN DIRECTIONAL TOTALS	224.3	0.0	31 28	3 0	3 0	47 44	0	0	32 31	480.0 465.0	0	0.0	0.0	0.0	0.0	0.0	0.0	FILE NAME: 12C118 PROJECT MANAGER: A. GAMBLE DESIGNED BY: J. KELLY POWNAI NB SHEET 1				
																									PLOT DATE: 2/15/2013 DRAWN BY: J. KELLY CHECKED: A. GAMBLE SHEET 78 OF 97				

DIRECTION	MILEPOINT	LOCATION CODE (SHEET 2)	SIGN CODE	WIDTH (IN)	HEIGHT (IN)	SHEETING REMARKS	SIGN LEGEND	NEW SIGNS		EXISTING SIGNS				EXIST POST		NUMBER OF NEW POSTS	SQUARE STEEL (IN)			TUBULAR STEEL Ø (IN)				SIGN FRAME REQUIRED	REMARKS	SIGN DETAIL LOCATION			
								"A"	"B"	RETAIN	SALVAGE FROM	SALVAGE TO	REMOVE	RETAIN	REMOVE		1.75	2.00	2.50	FOUNDATION	3.00	3.50	4.00			5.00	SHSM	PROJECT SHEET #	STANDARD SHEET #
																	(LB / FT)				(LB / FT)								
POWNAI VT-346 NB							FY-FLUORESCENT YELLOW FYG-FLUORESCENT YELLOW GREEN																"SHSM"-STANDARD HIGHWAY SIGNS AND MARKINGS						
NB	3.558	A	W1-6	48	24																								
		A	W1-6L	48	24			8.00																		X			
NB	3.559	B	W1-6	48	24																								
		B	W1-6R	48	24			8.00																		X			
NB	3.559	D	R1-1	30	30		STOP			1																			
NB	3.565	D	R1-1	30	30		STOP			1																			
NB	3.565	A	D3-1	UNK	UNK		NORTH POWNAI STREET SIGN			1																			
NB	3.578	A	OM-3R	12	36																								
		A	OM3-R	12	36			3.00																		X			
NB	3.587	B	OM-3L	12	36																								
		B	OM3-L	12	36			3.00																		X			
NB	3.589	C	VR-017	24	30																								
		C	VR-017	24	30			5.00																			6		
NB	3.596	A	D3-1	UNK	UNK																								
		C	VD-700	6	10		MILE MARKER																						
		D	R1-1	30	30																								
SIGN SUMMARY SHEET							SHEET TOTALS		27.00	0.00	3	0	0	8	0	0	5	75.0	0	0.0	0.0	0.0	0.0	PROJECT NAME: STATEWIDE SOUTHWEST REGION PROJECT NUMBER: STPG SIGN(41)					
VERMONT AGENCY OF TRANSPORTATION							TOWN DIRECTIONAL TOTALS		224.3	0.0	31	3	3	47	0	0	32	480.0	0		0.0			FILE NAME: 12C118 PROJECT MANAGER: A. GAMBLE DESIGNED BY: J. KELLY POWNAI NB SHEET 6 PLOT DATE: 2/15/2013 DRAWN BY: J. KELLY CHECKED: A. GAMBLE SHEET 83 OF 97					






DIRECTION	MILEPOINT	LOCATION CODE (SHEET 2)	SIGN CODE	WIDTH (IN)	HEIGHT (IN)	SHEETING REMARKS	SIGN LEGEND	NEW SIGNS		EXISTING SIGNS				EXIST POST		NUMBER OF NEW POSTS	SQUARE STEEL (IN)			TUBULAR STEEL Ø (IN)				SIGN FRAME REQUIRED	REMARKS	SIGN DETAIL LOCATION			
								"A"	"B"	RETAIN	SALVAGE FROM	SALVAGE TO	REMOVE	RETAIN	REMOVE		1.75	2.00	2.50	FOUNDATION	3.00	3.50	4.00			5.00	SHSM	PROJECT SHEET #	STANDARD SHEET #
																	(LB / FT)				(LB / FT)								
POWNAI VT-346 NB							FY-FLUORESCENT YELLOW FYG-FLUORESCENT YELLOW GREEN																"SHSM"-STANDARD HIGHWAY SIGNS AND MARKINGS						
		D	R1-1	30	30			6.25								1	14'-9"	X							X				
		A	D3-1	30	12			2.50																			12		
NB	3.618	A	M3-1	24	12																								
		A	M1-5A	30	24																								
		A	M3-1	24	12			2.00								1	15'-0"	X										E-136B	
		A	M1-5	30	24			5.00																			E-136B		
NB	3.695	A	VD-700	6	10					1																			
		A	R2-1	24	30			5.00																					
		A	R2-1	24	30																								
NB	3.829	A	VD-700	6	10																								
		A	W1-2MR	30	30		RIGHT CURVE WITH RIGHT SIDE ROAD																						
NB	3.864	A	W1-2MR	36	36			9.00								2	14'-1"	14'-2"	X								8		
NB	3.916	D	R1-1	30	30					1																			
		D	R1-1	30	30			6.25								1	12'-6"	X							X				
NB	3.924	C	VR-017	24	30																								
		C	VR-017	24	30			5.00								1	12'-6"	X									6		
NB	3.924	A	D3-1	UNK	UNK																								
SIGN SUMMARY SHEET							SHEET TOTALS	41.00	0.00	1	0	1	0	8	0	0	6	90.0	0	0.0	0.0	0.0	0.0	PROJECT NAME: STATEWIDE SOUTHWEST REGION	PROJECT NUMBER: STPG SIGN(41)				
VERMONT AGENCY OF TRANSPORTATION							TOWN DIRECTIONAL TOTALS	224.3	0.0	31	3	3	47	32	0	0	31	480.0	0	0.0	0.0	0.0	0.0	FILE NAME: 12C118	PROJECT MANAGER: A. GAMBLE	PLOT DATE: 2/15/2013			
										28	0	0	44	0	0	31	465.0	0	0.0	0.0	0.0	0.0	DESIGNED BY: J. KELLY	CHECKED: A. GAMBLE	DRAWN BY: J. KELLY	SHEET 84 OF 97			








DIRECTION	MILEPOINT	LOCATION CODE (SHEET 2)	SIGN CODE	WIDTH (IN)	HEIGHT (IN)	SHEETING REMARKS	SIGN LEGEND	NEW SIGNS		EXISTING SIGNS				EXIST POST		NUMBER OF NEW POSTS	SQUARE STEEL (IN)			TUBULAR STEEL Ø (IN)				SIGN FRAME REQUIRED	REMARKS	SIGN DETAIL LOCATION			
								"A"	"B"	RETAIN	SALVAGE FROM	SALVAGE TO	REMOVE	RETAIN	REMOVE		1.75	2.00	2.50	FOUNDATION	3.00	3.50	4.00			5.00	SHSM	PROJECT SHEET #	STANDARD SHEET #
																	(LB / FT)				(LB / FT)								
POWNAI VT-346 NB							FY-FLUORESCENT YELLOW FYG-FLUORESCENT YELLOW GREEN																"SHSM"-STANDARD HIGHWAY SIGNS AND MARKINGS						
		A	D3-1	72	12			6.00								2	12'-10" 13'-0" X								INSTALL AT POINT OF ISLAND AS EXISTING. DO NOT BLOCK ANY OTHER SIGNAGE.		12		
NB	3.931	D	R1-1	30	30							1														INDIAN MASSACRE RD (TH-11)			
		D	R1-1	30	30			6.25								1	13'-5" X										X		
NB	4.053	A	R2-1	24	30							1																	
		A	R2-1	24	30			5.00								1	14'-3" X										X		
NB	4.222	A	W10-1	36	36							1	X																
		A	W10-1	36	36			7.07																		INSTALL NEW SIGN ON EXISTING FLANGED CHANNEL SIGN POST.	X		
NB	4.335	A	R15-1	48	9		RAILROAD CROSSBUCKS			1				X															
NB	4.406	A	R2-1	24	30							1																	
		A	R2-1	24	30			5.00								1	13'-6" X										X		
SIGN SUMMARY SHEET							SHEET TOTALS	29.32	0.00	1	0	0	4	0	0	5	75.0	0	0.0	0.0	0.0	0.0	PROJECT NAME: STATEWIDE SOUTHWEST REGION PROJECT NUMBER: STPG SIGN(41)						
VERMONT AGENCY OF TRANSPORTATION							TOWN DIRECTIONAL TOTALS	224.3	0.0	31	3	3	47	0	0	32	480.0	0		0.0			FILE NAME: 12C118 PROJECT MANAGER: A. GAMBLE DESIGNED BY: J. KELLY POWNAI NB SHEET 8						
										28	0	0	44			31							PLOT DATE: 2/15/2013 DRAWN BY: J. KELLY CHECKED: A. GAMBLE SHEET 85 OF 97						




DIRECTION	MILEPOINT	LOCATION CODE (SHEET 2)	SIGN CODE	WIDTH (IN)	HEIGHT (IN)	SHEETING REMARKS	SIGN LEGEND	NEW SIGNS		EXISTING SIGNS				EXIST POST		NUMBER OF NEW POSTS	SQUARE STEEL (IN)			TUBULAR STEEL Ø (IN)				SIGN FRAME REQUIRED	REMARKS	SIGN DETAIL LOCATION			
								"A"	"B"	RETAIN	SALVAGE FROM	SALVAGE TO	REMOVE	RETAIN	REMOVE		1.75	2.00	2.50	FOUNDATION	3.00	3.50	4.00			5.00	SHSM	PROJECT SHEET #	STANDARD SHEET #
																	(LB / FT)				(LB / FT)								
POWNAVT-346 SB							FY-FLUORESCENT YELLOW FYG-FLUORESCENT YELLOW GREEN																"SHSM"-STANDARD HIGHWAY SIGNS AND MARKINGS						
SB	4.628	F	VR-039	24	12		STATE HIGHWAY BEGINS																						
		E	VR-038	24	12		STATE HIGHWAY ENDS																						
		F	VD-700	6	10					1																			
		F	R2-1	24	30																								
		F	VW16-18P	24	12	FY		2.00																			6		
		F	R2-1	24	30			5.00																			X		
		F	VD-700	6	10		MILE MARKER																						
		F	R2-5P	24	18			3.00			1																X		
SB	4.628	F	VR-039	24	12			3.00																			6		
		E	VR-038	24	12			3.00																			6		
SB	4.595	F	VW-619	30	30		SHOULDER NARROWS					1																	
		F	VD-421	60	48			20.00																			5		
SB	4.557	F	VD-421A	60	48		WELCOME TO VERMONT					1																	
		F	VW-619	36	36			9.00																			7		
SB	4.502	F	W3-5	36	36							1																	
		F	W3-5	36	36			9.00																			X		
SB	4.465	F	W10-1	36	36																								
SIGN SUMMARY SHEET							SHEET TOTALS	54.00	0.00	0	1	1	7	0	0	8	120.0	0	0.0	0.0	0.0	0.0	0.0	PROJECT NAME: STATEWIDE SOUTHWEST REGION					
								SF	SF	EA	EA	EA	EA	EA	EA	EA	FT	EA	LB	LB	LB	LB	LB	PROJECT NUMBER: STPG SIGN(41)					
VERMONT AGENCY OF TRANSPORTATION							TOWN DIRECTIONAL TOTALS	346.1	339.8	0.0	33	5	5	72	0	0	30	450.0	0		0.0				FILE NAME: 12C118				
																								PLOT DATE: 2/13/2013					
																								PROJECT MANAGER: A. GAMBLE					
																								DRAWN BY: J. KELLY					
																								CHECKED BY: A. GAMBLE					
																								POWNAVT SB SHEET 1					
																								SHEET 86 OF 97					






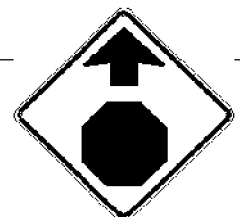
DIRECTION	MILEPOINT	LOCATION CODE (SHEET 2)	SIGN CODE	WIDTH (IN)	HEIGHT (IN)	SHEETING REMARKS	SIGN LEGEND	NEW SIGNS		EXISTING SIGNS				EXIST POST		NUMBER OF NEW POSTS	SQUARE STEEL (IN)			TUBULAR STEEL Ø (IN)				SIGN FRAME REQUIRED	REMARKS	SIGN DETAIL LOCATION						
								"A"	"B"	RETAIN	SALVAGE FROM	SALVAGE TO	REMOVE	RETAIN	REMOVE		1.75	2.00	2.50	FOUNDATION	3.00	3.50	4.00			5.00	SHSM	PROJECT SHEET #	STANDARD SHEET #			
																	(LB / FT)				(LB / FT)											
POWNA VT-346 SB							FY-FLUORESCENT YELLOW FYG-FLUORESCENT YELLOW GREEN																"SHSM"-STANDARD HIGHWAY SIGNS AND MARKINGS									
		F	W10-1	36	36			7.07								1	13'-6" X								X							
SB	4.406	F	R2-1	24	30								1	X																		
		F	R2-1	30	36			7.50								1	14'-0" X									X			INSTALL DIRECTLY ACROSS FROM NORTH BOUND SPEED LIMIT 50 SIGN ASSEMBLY.			
SB	4.345	F	R15-1	48	9		RAILROAD CROSSBUCKS			1				X																		
																																
SB	4.303	A	VR-601	36	36			9.00								2	14'-5" 15'-0" X										6		INSTALL 185 FEET NORTH OF EXISTING \$500 FINE SIGN ASSEMBLY (EDGE OF LAWN)			
SB	4.268	F	VR-023B	24	30		\$500 FINE FOR LITTERING						1	X																		
		F	VR-654	24	24			4.00																				6		INSTALL NEW SIGN ON EXISTING FLANGED CHANNEL SIGN POST.		
SB	4.178	F	R2-1	24	30								1	X																		
		F	R2-1	24	30			5.00																	X					INSTALL NEW SIGN ON EXISTING FLANGED CHANNEL SIGN POST.		
SB	4.053	F	R2-1	24	30								1	X																		
		F	R2-1	30	36			7.50																	X					INSTALL NEW SIGN ON EXISTING FLANGED CHANNEL SIGN POST.		
SB	4.015	F	W1-2ML	30	30		MODIFIED LEFT CURVE						1	X																		
SB	3.974	F	VR-048	24	30		STOP FOR SCHOOL BUS						1	X																		
SB	3.960	F	W1-2ML	36	36			9.00								2	15'-0" 15'-0" X											8		INSTALL 75 FEET SOUTH OF EXISTING "STOP FOR SCHOOL BUS" SIGN ASSEMBLY.		
SB	3.914	F	W1-6	48	24								1	X																		
SIGN SUMMARY SHEET							SHEET TOTALS	49.07	0.00	1	0	0	7	0	0	6	90.0	0	0.0	0.0	0.0	0.0										
								SF	SF	EA	EA	EA	EA	EA	EA	EA	FT	EA	LB	LB	LB	LB										
							TOWN DIRECTIONAL TOTALS	346.1 339.8	0.0	33 32	5 0	5 0	72 66	0	0	30 28	450.0 420.0	0			0.0											
VERMONT AGENCY OF TRANSPORTATION																		PROJECT NAME: STATEWIDE SOUTHWEST REGION						PROJECT NUMBER: STPG SIGN(41)								
																		FILE NAME: 12C118						PLOT DATE: 2/13/2013								
																		PROJECT MANAGER: A. GAMBLE						DRAWN BY: J. KELLY								
																		DESIGNED BY: J. KELLY						CHECKED: A. GAMBLE								
																		POWNA SB SHEET 2						SHEET 87	OF 97							

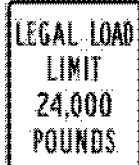DIRECTION	MILEPOINT	LOCATION CODE (SHEET 2)	SIGN CODE	WIDTH (IN)	HEIGHT (IN)	SHEETING REMARKS	SIGN LEGEND	NEW SIGNS		EXISTING SIGNS				EXIST POST		NUMBER OF NEW POSTS	SQUARE STEEL (IN)			TUBULAR STEEL Ø (IN)				SIGN FRAME REQUIRED	REMARKS	SIGN DETAIL LOCATION			
								"A"	"B"	RETAIN	SALVAGE FROM	SALVAGE TO	REMOVE	RETAIN	REMOVE		1.75	2.00	2.50	FOUNDATION	3.00	3.50	4.00			5.00	SHSM	PROJECT SHEET #	STANDARD SHEET #
																	(LB / FT)				(LB / FT)								
POWNAI VT-346 SB							FY-FLUORESCENT YELLOW FYG-FLUORESCENT YELLOW GREEN																"SHSM"-STANDARD HIGHWAY SIGNS AND MARKINGS						
		F	VD1-1A	72	12			6.00																INSTALL NEW ON EXISTING FLANGED CHANNEL SIGN POSTS.		10			
SB	3.588	F	OM-3R	12	36																								
		F	OM3-R	12	36			3.00																	INSTALL ON EXISTING FLANGED CHANNEL SIGN POST.	X			
SB	3.580	E	OM-3L	12	36																								
		E	OM3-L	12	36			3.00																	INSTALL ON EXISTING FLANGED CHANNEL SIGN POST.	X			
SB	3.534	F	M3-3	24	12																								
		F	M1-5	30	24																								
		F	M3-3	24	12			2.00																	INSTALL ON EXISTING FLANGED CHANNEL SIGN POST.			E-136B	
		F	M1-5	30	24			5.00																			E-136B		
SB	3.419	F	VD-700	6	10						1																		
		F	VW-622	30	30																								
		F	VD-700	6	10																								
		F	VW-622	30	30			6.25																			7		
SB	3.342	F	R2-1	24	30																								
		F	R2-1	24	30			5.00																	INSTALL ON EXISTING FLANGED CHANNEL SIGN POST.	X			
SB	3.233	F	VD-700	6	10						1																		
		F	W11-8	30	30																								
		F	VD-700	6	10																								
		F	W11-8	30	30			6.25																	INSTALL ON EXISTING FLANGED CHANNEL SIGN POST.	X			
SIGN SUMMARY SHEET							SHEET TOTALS	36.50	0.00	0	2	2	7	0	0	2	30.0	0	0.0	0.0	0.0	0.0		PROJECT NAME: STATEWIDE SOUTHWEST REGION					
								SF	SF	EA	EA	EA	EA	EA	EA	EA	FT	EA	LB	LB	LB	LB		PROJECT NUMBER: STPG SIGN(41)					
																							FILE NAME: 12C118	PLOT DATE: 2/13/2013					
																							PROJECT MANAGER: A. GAMBLE	DRAWN BY: J. KELLY					
																							DESIGNED BY: J. KELLY	CHECKED: A. GAMBLE					
VERMONT AGENCY OF TRANSPORTATION							TOWN DIRECTIONAL TOTALS	346.1	0.0	33	5	5	72	0	0	30	450.0	0		0.0				POWNAI SB SHEET 4	SHEET 89	OF 97			

DIRECTION	MILEPOINT	LOCATION CODE (SHEET 2)	SIGN CODE	WIDTH (IN)	HEIGHT (IN)	SHEETING REMARKS	SIGN LEGEND	NEW SIGNS		EXISTING SIGNS				EXIST POST		NUMBER OF NEW POSTS	SQUARE STEEL (IN)			TUBULAR STEEL Ø (IN)				SIGN FRAME REQUIRED	REMARKS	SIGN DETAIL LOCATION			
								"A"	"B"	RETAIN	SALVAGE FROM	SALVAGE TO	REMOVE	RETAIN	REMOVE		1.75	2.00	2.50	FOUNDATION	3.00	3.50	4.00			5.00	SHSM	PROJECT SHEET #	STANDARD SHEET #
																	(LB / FT)				(LB / FT)								
POWNAVT-346 SB							FY-FLUORESCENT YELLOW FYG-FLUORESCENT YELLOW GREEN															"SHSM"-STANDARD HIGHWAY SIGNS AND MARKINGS							
SB	3.146	F	R2-1	24	30			5.00							1	14'-3" X							INSTALL 460 FEET SOUTH OF FIRE TRUCK SYMBOL SIGN ASSEMBLY.	X					
SB	3.006	G	VR-017	24	30							1											DEAN RD (TH-24)						
		G	VR-017	24	30			5.00															INSTALL ON EXISTING FLANGED CHANNEL SIGN POST.		6				
SB	3.000	A	D3-1	UNK	UNK		DEAN RD STREET SIGN					1											DEAN RD (TH-24)						
		G	VD-700	6	10		MILE MARKERS UNREADABLE					2											MILE MARKERS UNREADABLE						
		H	R1-1	30	30							1																	
		A	D3-1	30	12			2.50							1	13'-0" X							INSTALL STREET SIGN ABOVE STOP SIGN.		12				
		H	R1-1	30	30			6.25																	X				
SB	2.971	F	R2-1	24	30		SPEED LIMIT 35			1																			
SB	2.941	F	S3-1	36	36		SCHOOL BUS STOP AHEAD			1																			
SB	2.911	F	VW-133L	30	30		HIDDEN DRIVES LEFT			1																			
SB	2.790	F	W1-4L	30	30		LEFT REVERSE CURVE			1																			
SB	2.600	F	R2-1	24	30		SPEED LIMIT 50			1																			
SB	2.491	F	VW-444	30	30		WATCH FOR FALLEN ROCK					1																	
		F	W1-4R	30	30		RIGHT REVERSE CURVE					1																	
		F	VD-700	6	10							1																	
		F	W13-1	18	18		40 MPH ADVISORY 					1																	
SIGN SUMMARY SHEET							SHEET TOTALS	18.75	0.00	5	0	0	9	0	0	2	30.0	0	0.0	0.0	0.0	0.0	PROJECT NAME: STATEWIDE SOUTHWEST REGION						
								SF	SF	EA	EA	EA	EA	EA	EA	EA	FT	EA	LB	LB	LB	PROJECT NUMBER: STPG SIGN(41)							
VERMONT AGENCY OF TRANSPORTATION							TOWN DIRECTIONAL TOTALS	346.1	0.0	33	5	5	72	0	0	30	450.0	0	0.0	0.0	0.0	FILE NAME: 12C118	PROJECT MANAGER: A. GAMBLE	PLOT DATE: 2/13/2013					
								339.8	0.0	32	0	0	66	0	0	28	420.0	0	0.0	0.0	DESIGNED BY: J. KELLY	CHECKED: A. GAMBLE	DRAWN BY: J. KELLY						
																					POWNAVT SB SHEET 5	SHEET 90	OF 97						

DIRECTION	MILEPOINT	LOCATION CODE (SHEET 2)	SIGN CODE	WIDTH (IN)	HEIGHT (IN)	SHEETING REMARKS	SIGN LEGEND	NEW SIGNS		EXISTING SIGNS				EXIST POST		NUMBER OF NEW POSTS	SQUARE STEEL (IN)			TUBULAR STEEL Ø (IN)				SIGN FRAME REQUIRED	REMARKS	SIGN DETAIL LOCATION					
								"A"	"B"	RETAIN	SALVAGE FROM	SALVAGE TO	REMOVE	RETAIN	REMOVE		1.75	2.00	2.50	FOUNDATION	3.00	3.50	4.00			5.00	SHSM	PROJECT SHEET #	STANDARD SHEET #		
																	(LB / FT)				(LB / FT)										
POWNAI VT-346 SB							FY-FLUORESCENT YELLOW FYG-FLUORESCENT YELLOW GREEN															"SHSM"-STANDARD HIGHWAY SIGNS AND MARKINGS									
SB	2.440	F	VW-285	30	30			6.25							1		15'-6" X							INSTALL 200 FEET NORTH OF THE 2.40 MILE MARKER		7					
SB	2.400	F	W1-4R	30	30			6.25							1		16'-9" X							INSTALL AT 2.40 MILE MARKER.	X						
		F	W13-1P	18	18			2.25																	X						
SB	1.518	F	VD-700 W11-5	6 30	10 30					1																					
		F	W11-5	30	30			6.25																INSTALL NEW SIGN ON EXISTING FLANGED CHANNEL SIGN POST.	X						
SB	1.074	F	VW-054R	30	30		HIDDEN DRIVE RIGHT																								
SB	0.826	A	D3-1	UNK	UNK																			LINCOLN ST (TH-30)							
		G	VR-017	24	30																										
		A	D3-1	40	12			3.33																INSTALL ABOVE LEGAL LOAD AS EXISTING.		12					
		G	VR-017	24	30			5.00							1		13'-0" X									6					
SB	0.820	H	R1-1	30	30		STOP			1														LINCOLN ST (TH-30)							
SB	0.815	F	R8-3A	24	24		NO PARKING			1																					
		F	VR-644P	24	12		BEGIN			1																					
SB	0.729	F	W3-5	36	36		SPEED REDUCTION (35)			1																					
SB	0.693	F	VD-018	30	18		POWNAI VILLAGE SIGN			1																					
SIGN SUMMARY SHEET							SHEET TOTALS	29.33	0.00	6 5	0	0	4	0	0	3 2	45.0 30.0	0	0.0	0.0	0.0	0.0	PROJECT NAME: STATEWIDE SOUTHWEST REGION								
VERMONT AGENCY OF TRANSPORTATION							TOWN DIRECTIONAL TOTALS	346.1 339.8	0.0	33 32	5 0	5 0	72 66	0	0	30 28	450.0 420.0	0	0.0	0.0	0.0	0.0	PROJECT NUMBER: STPG SIGN(41)	FILE NAME: 12C118	PROJECT MANAGER: A. GAMBLE	DESIGNED BY: J. KELLY	POWNAI SB SHEET 6	PLOT DATE: 2/13/2013	DRAWN BY: J. KELLY	CHECKED: A. GAMBLE	SHEET 91 OF 97

DIRECTION	MILEPOINT	LOCATION CODE (SHEET 2)	SIGN CODE	WIDTH (IN)	HEIGHT (IN)	SHEETING REMARKS	SIGN LEGEND	NEW SIGNS		EXISTING SIGNS				EXIST POST		NUMBER OF NEW POSTS	SQUARE STEEL (IN)			TUBULAR STEEL Ø (IN)				SIGN FRAME REQUIRED	REMARKS	SIGN DETAIL LOCATION			
								"A"	"B"	RETAIN	SALVAGE FROM	SALVAGE TO	REMOVE	RETAIN	REMOVE		1.75	2.00	2.50	FOUNDATION	3.00	3.50	4.00			5.00	SHSM	PROJECT SHEET #	STANDARD SHEET #
																	(LB / FT)				(LB / FT)								
POWNA VT-346 SB							FY-FLUORESCENT YELLOW FYG-FLUORESCENT YELLOW GREEN															"SHSM"-STANDARD HIGHWAY SIGNS AND MARKINGS							
SB	0.484	G	VR-017	24	30																		CHURCH ST (TH-1)						
		G	VR-017	24	30			5.00															INSTALL ON EXISTING FLANGED CHANNEL SIGN POST.		6				
SB	0.483	H	R1-1	30	30																		CHURCH ST (TH-1)						
		F	D3-1	38	12			3.17															INSTALL ABOVE STOP SIGN.		12				
		H	R1-1	30	30			6.25														X	INSTALL ON EXISTING FLANGED CHANNEL SIGN POST.						
SB	0.483	F	D3-1	UNK	UNK		CHURCH ST STREET NAME SIGN																						
SB	0.482	F	W1-6	48	24		LARGE LEFT ARROW			1																			
SB	0.481	F	M3-3	24	12		SOUTH			1																			
		F	M1-5	30	24		VERMONT ROUTE 346			1																			
		F	M6-1	21	15		LEFT ARROW			1																			
SB	0.456	F	M3-3	24	12		SOUTH			1																			
		F	M1-5	30	24		VERMONT ROUTE 346			1																			
SB	0.410	F	R8-3A	24	24		NO PARKING			1																			
SB	0.355	F	W1-4R	30	30		RIGHT REVERSE CURVE																						
		F	W11-8	30	30																								
SIGN SUMMARY SHEET							SHEET TOTALS	14.42	0.00	7	0	0	5	0	0	0	0.0	0	0.0	0.0	0.0	0.0	PROJECT NAME: STATEWIDE SOUTHWEST REGION						
								SF	SF	EA	EA	EA	EA	EA	EA	EA	FT	EA	LB	LB	LB	LB	PROJECT NUMBER: STPG SIGN(41)						
																							FILE NAME: 12C118	PLOT DATE: 2/13/2013					
VERMONT AGENCY OF TRANSPORTATION							TOWN DIRECTIONAL TOTALS	346.1		33	5	5	72	0	0	30	450.0	0		0.0			PROJECT MANAGER: A. GAMBLE	DRAWN BY: J. KELLY					
								339.8	0.0	32	0	0	66	0	0	28	420.0						DESIGNED BY: J. KELLY	CHECKED: A. GAMBLE					
																							POWNA SB SHEET 8	SHEET 93 OF 97					

DIRECTION	MILEPOINT	LOCATION CODE (SHEET 2)	SIGN CODE	WIDTH (IN)	HEIGHT (IN)	SHEETING REMARKS	SIGN LEGEND	NEW SIGNS		EXISTING SIGNS				EXIST POST		NUMBER OF NEW POSTS	SQUARE STEEL (IN)			TUBULAR STEEL Ø (IN)				SIGN FRAME REQUIRED	REMARKS	SIGN DETAIL LOCATION			
								"A"	"B"	RETAIN	SALVAGE FROM	SALVAGE TO	REMOVE	RETAIN	REMOVE		1.75	2.00	2.50	FOUNDATION	3.00	3.50	4.00			5.00	SHSM	PROJECT SHEET #	STANDARD SHEET #
																	(LB / FT)				(LB / FT)								
POWNAVT-346 SB							FY-FLUORESCENT YELLOW FYG-FLUORESCENT YELLOW GREEN																"SHSM"-STANDARD HIGHWAY SIGNS AND MARKINGS						
		F	W11-8	30	30			6.25							1	15'-0" X									X				
SB	0.300	F	R8-3A	24	24		NO PARKING			1																			
SB	0.300	F	R2-1	24	30		SPEED LIMIT 35			1																			
SB	0.250	E	W1-6	48	24		LARGE RIGHT ARROW			1																			
SB	0.248	G	VR-017	24	30							1																	
		G	VR-017	24	30			5.00						1	14'-4" X											6			
SB	0.242	F	D3-1	UNK	UNK							1																	
		G	VD-700	6	10					1																			
		H	R1-1	30	30							1	X																
		F	D3-1	38	12			3.17																		12			
		H	R1-1	30	30			6.25																	X				
SB	0.180	F	W3-1	36	36							1	X																
		F	W3-1	30	30			6.25																	X				
SB	0.151	F	M2-1	21	15							1																	
		F	M1-4	24	24							1																	
		F	M4-6	24	12							1																	
SIGN SUMMARY SHEET							SHEET TOTALS	26.92	0.00	4 3	0	0	7	0	0	2	30.0	0	0.0	0.0	0.0	0.0	0.0	0.0	PROJECT NAME: STATEWIDE SOUTHWEST REGION PROJECT NUMBER: STPG SIGN(41)				
VERMONT AGENCY OF TRANSPORTATION							TOWN DIRECTIONAL TOTALS	346.1 339.8	0.0	33 32	5 0	5 0	72 66	0	0	30 28	450.0 420.0	0		0.0					FILE NAME: 12C118 PROJECT MANAGER: A. GAMBLE DESIGNED BY: J. KELLY POWNAVT SB SHEET 9	PLOT DATE: 2/13/2013 DRAWN BY: J. KELLY CHECKED: A. GAMBLE SHEET 94 OF 97			

TOWN TOTAL SIGN SUMMARY SHEET

STATEWIDE STPG SIGN(41)

Town name-Route	County	Town Mileage	NEW SIGNS (SF)		EXISTING SIGNS (EA)				EXIST POST (EA)		NUMBER OF NEW POSTS (EA)				SQUARE STEEL (IN)			TUBULAR STEEL Ø (IN)				
			TYPE A	TYPE B	RETAIN	SALVAGE FROM	SALVAGE TO	REMOVE	RETAIN	REMOVE	1.75"	2"	2.5"	TOTAL POSTS	1.75	2.00	2.50	FOUNDATION	3.00	3.50	4.00	5.00
											(LB / FT)				(LB / FT)				(LB / FT)			
											1.88	2.42	3.35		1.88	2.42	3.35		7.60	9.00	10.80	14.60
Readsboro VT-8 NB	Bennington	2.507	89.8 90.6	0	1	0	0	18	0	0	0	13	0	13	0	195	0					
Readsboro VT-8 SB	Bennington	2.507	123.4 124.3	0	1	0	0	27	0	0	0	10	2	12	0	150	30					
Searsburg VT-8 NB	Bennington	2.703	151.9 158.6	0	3	1	0	32	0	0	21	20	2	23	23	300	30					
Searsburg VT-8 SB	Bennington	2.703	121.5	0	0	0	0	30	0	0	0	19	0	19	0	285	0					
Jamaica VT-30 NB	Windham	10.119	443.5 438.5	0	32	2	1	78	0	0	63	62	0	63	62	0	315	930	0			
Jamaica VT-30 SB	Windham	10.119	430.2 431.8	0	31	2	0	82	0	0	64	61	2	66	63	0	945	915	30			
Wells VT-31 NB	Rutland	1.756	136.7	0	0	0	0	30	0	0	0	17	2	19	0	255	30					
Wells VT-31 SB	Rutland	1.756	75.8	0	1	0	0	18	0	0	0	11	0	11	0	165	0					
Poultney VT-31 NB	Rutland	3.779	243.2 248.2	0	2	0	0	57	0	0	27	25	0	27	25	0	960	375	0			
Poultney VT-31 SB	Rutland	3.779	207.2	0	2	0	0	41	0	0	31	29	0	31	29	0	405	435	0			
Pownal VT-346 NB	Bennington	4.628	224.3	0	33	3	0	44	0	0	32	31	0	32	31	0	450	465	0			
Pownal VT-346 SB	Bennington	4.628	339.8 346.1	0	33	5	0	66	0	0	28	26	2	30	28	0	420	390	30			
			Sub-Total			1	1	523			Sub-Total				0	4860	150					
Estimated Salvaged Street Name Signs to be erected onto new posts =								0														
Estimated Salvaged Mile Markers to be erected onto new posts =								5														
Salvaged From signs to be added to Remove total =								1														
			REVISED TOTALS:			137	12	12	551			336	10	346	5190							
TOTAL =			2587.3	0	126	1	6	524	0	0	0	324	10	334	5010	0	0	0	0	0		

PROJECT NAME: STATEWIDE SW REGION
PROJECT NUMBER: STPG SIGN (41)
FILE NAME: I2CI18.SS
PROJECT LEADER: A. GAMBLE
DESIGNED BY: J. KELLY
TOWN TOTAL SIGN SUMMARY SHEET
PLOT DATE: 13-FEB-2013
DRAWN BY: J. KELLY
CHECKED BY: A. GAMBLE
SHEET 97 OF 97