



①
 SLOPE = 2.83%
 ABANDONED EXISTING PIPE IN-PLACE
 (FILL WITH CONTROLLED DENSITY (FLOWABLE) FILL)
 TYPE: CGMP
 LENGTH = 49.2 FT
 DIAMETER = 24 IN
 INV. IN = 803.21
 INV. OUT = 801.82

PIPE PROFILE - ①

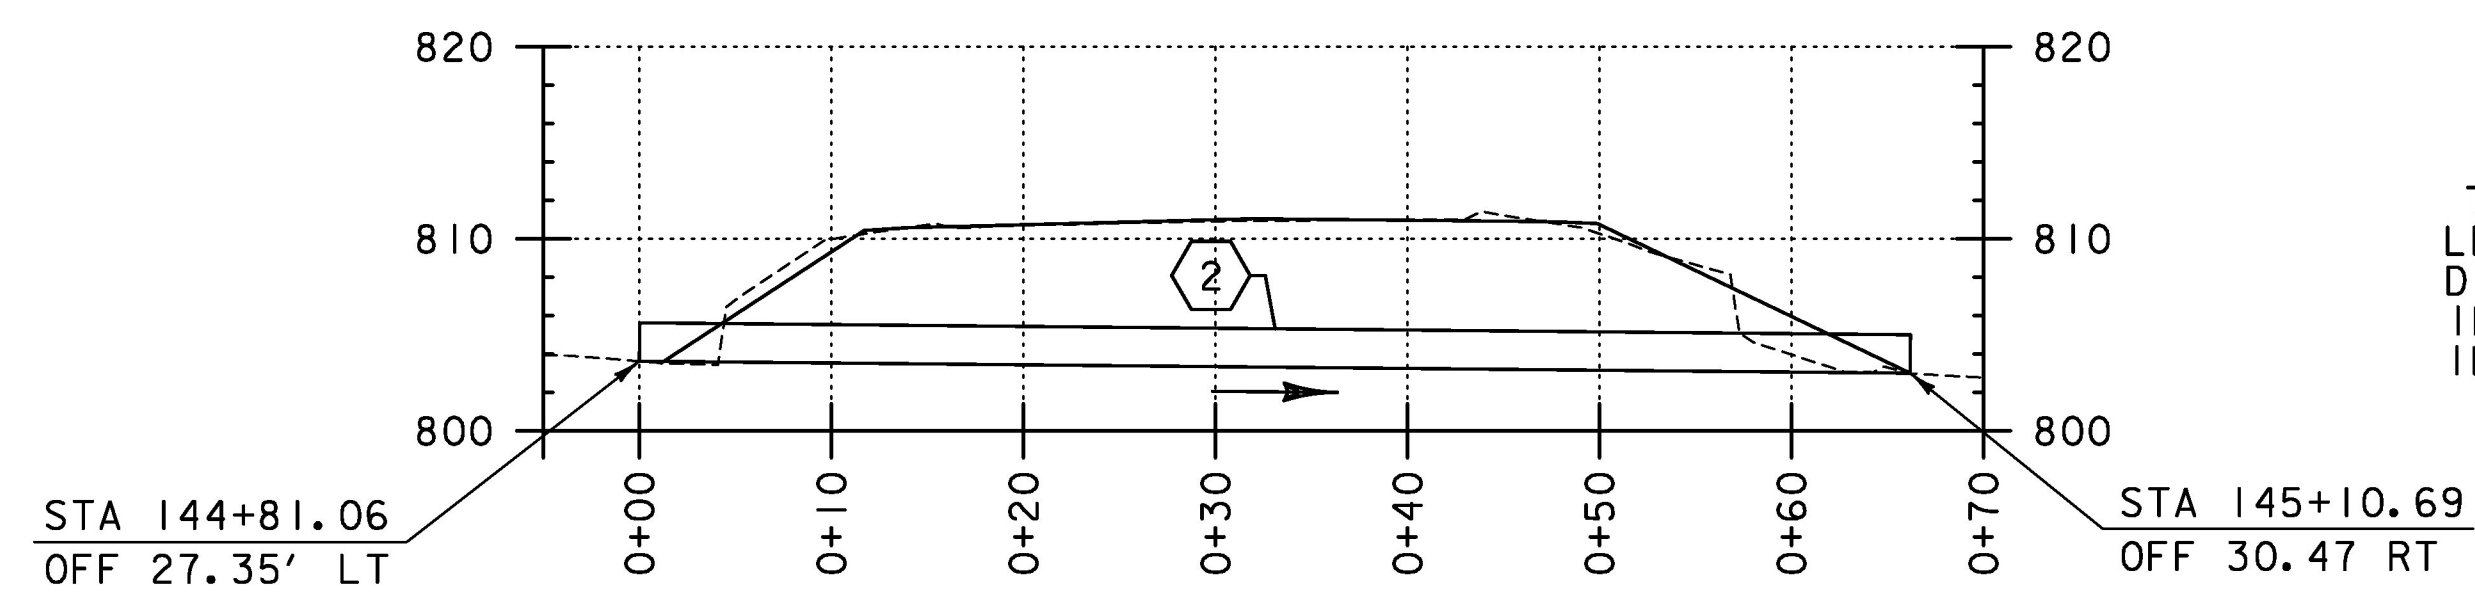

②
 SLOPE = 0.82%
 NEW PIPE
 TYPE: CPEP (SL)
 LENGTH = 65.0 FT
 DIAMETER = 24 IN
 INV. IN = 803.53
 INV. OUT = 803.00

PIPE PROFILE - ②

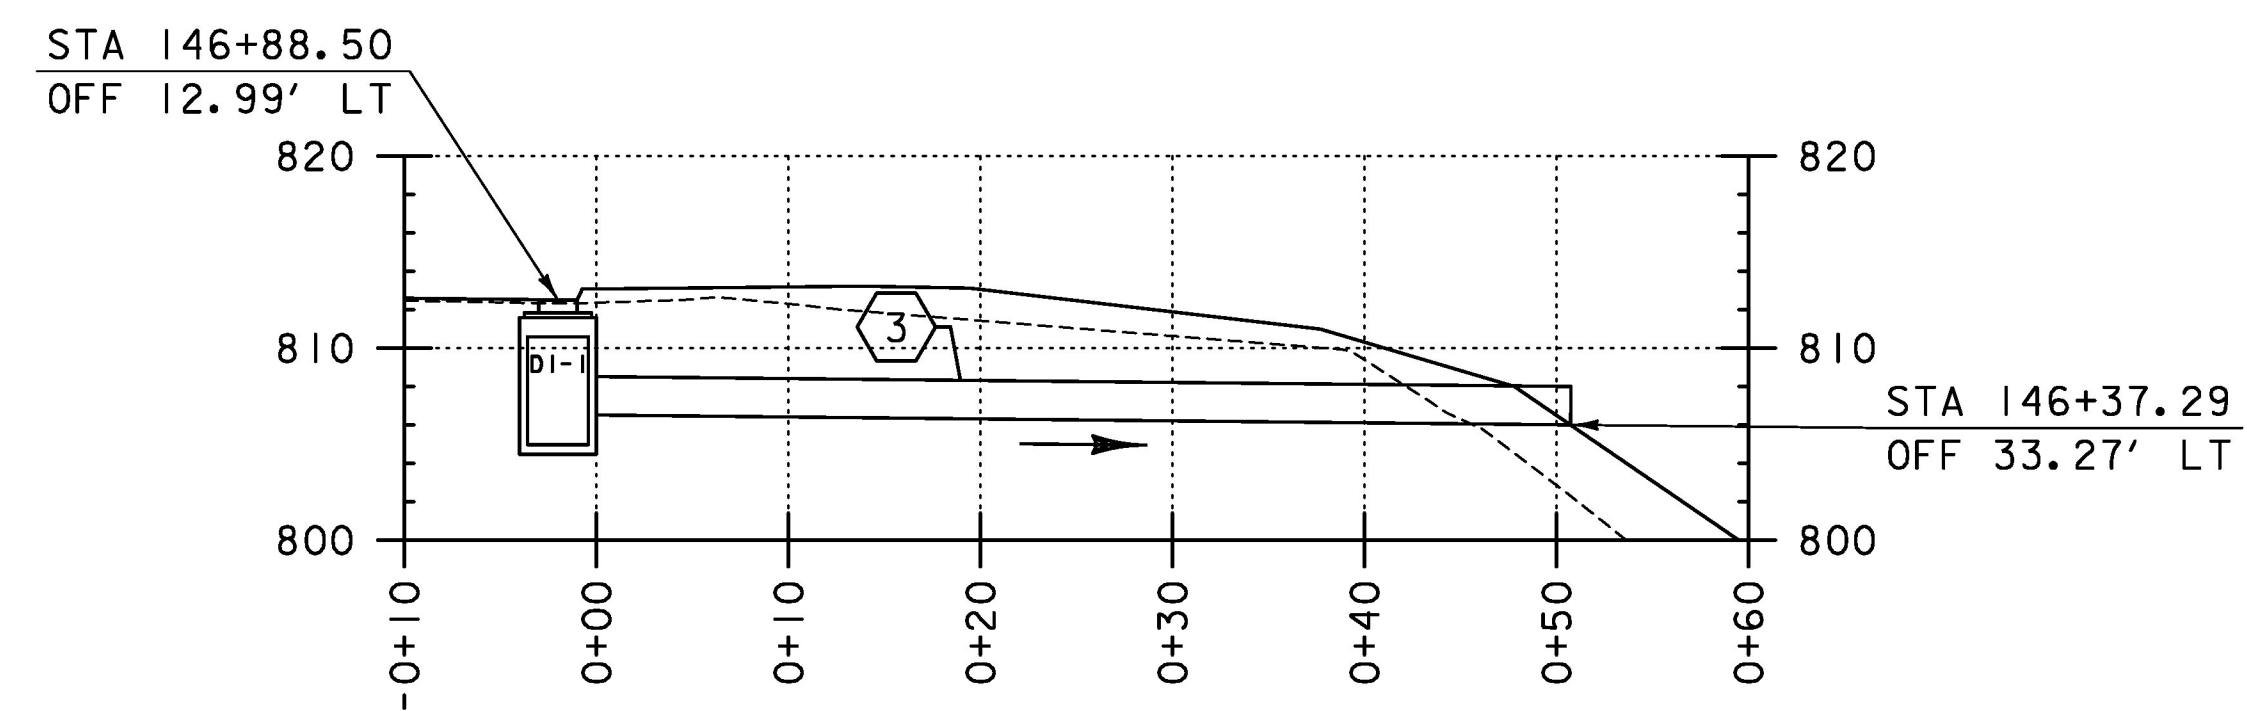

③
 SLOPE = 0.94%
 NEW PIPE
 TYPE: CPEP (SL)
 LENGTH = 54.0 FT
 DIAMETER = 12 IN
 INV. IN = 806.50
 INV. OUT = 806.00

DI-1
 GRATE: TYPE E
 RIM EL = 812.43
 DEPTH = 7.5 FT

PIPE PROFILE - ③

HORIZONTAL SCALE 1" = 20'-0"
 VERTICAL SCALE 1" = 10'-0"

TYLIN INTERNATIONAL

PROJECT NAME: CHelsea
 PROJECT NUMBER: BHF 0169(9)

FILE NAME: z12ci50p1pepro.dgn
 PROJECT LEADER: J. OLUND
 DESIGNED BY: B. TOOTHAKER
 PIPE PROFILE SHEET

PLOT DATE: 8/31/2016
 DRAWN BY: B. TOOTHAKER
 CHECKED BY: J. HOWE
 SHEET 27 OF 137