


**LEGEND:**

- AER E&T --- TEMPORARILY REMOVED ELECTRIC/TELEPHONE
- E --- TEMPORARILY REMOVED ELECTRIC
- T --- TEMPORARILY REMOVED TELEPHONE

NOTE: UTILITY RELOCATION EFFORTS SHOWN ON THIS SHEET ARE PERFORMED BY OTHERS AND ARE PROVIDED HEREIN FOR INFORMATION ONLY TO REFLECT CHANGED SITE CONDITIONS.

**UTILITY RELOCATION LAYOUT**

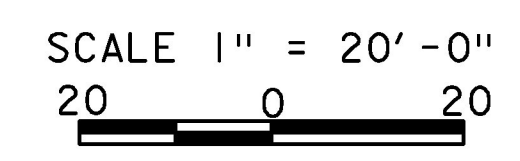

**TYLIN**INTERNATIONAL

PROJECT NAME: CHelsea	
PROJECT NUMBER: BHF 0169(9)	
FILE NAME: z12ci50u+11.dgn	PLOT DATE: 10/4/2016
PROJECT LEADER: J. OLUND	DRAWN BY: B. TOOTHAKER
DESIGNED BY: L. WHEELER	CHECKED BY: J. OLUND
APPROXIMATE UTILITY RELOCATION LAYOUT	SHEET 29 OF 137