



PLAN
 SCALE: 1" = 10'-0"

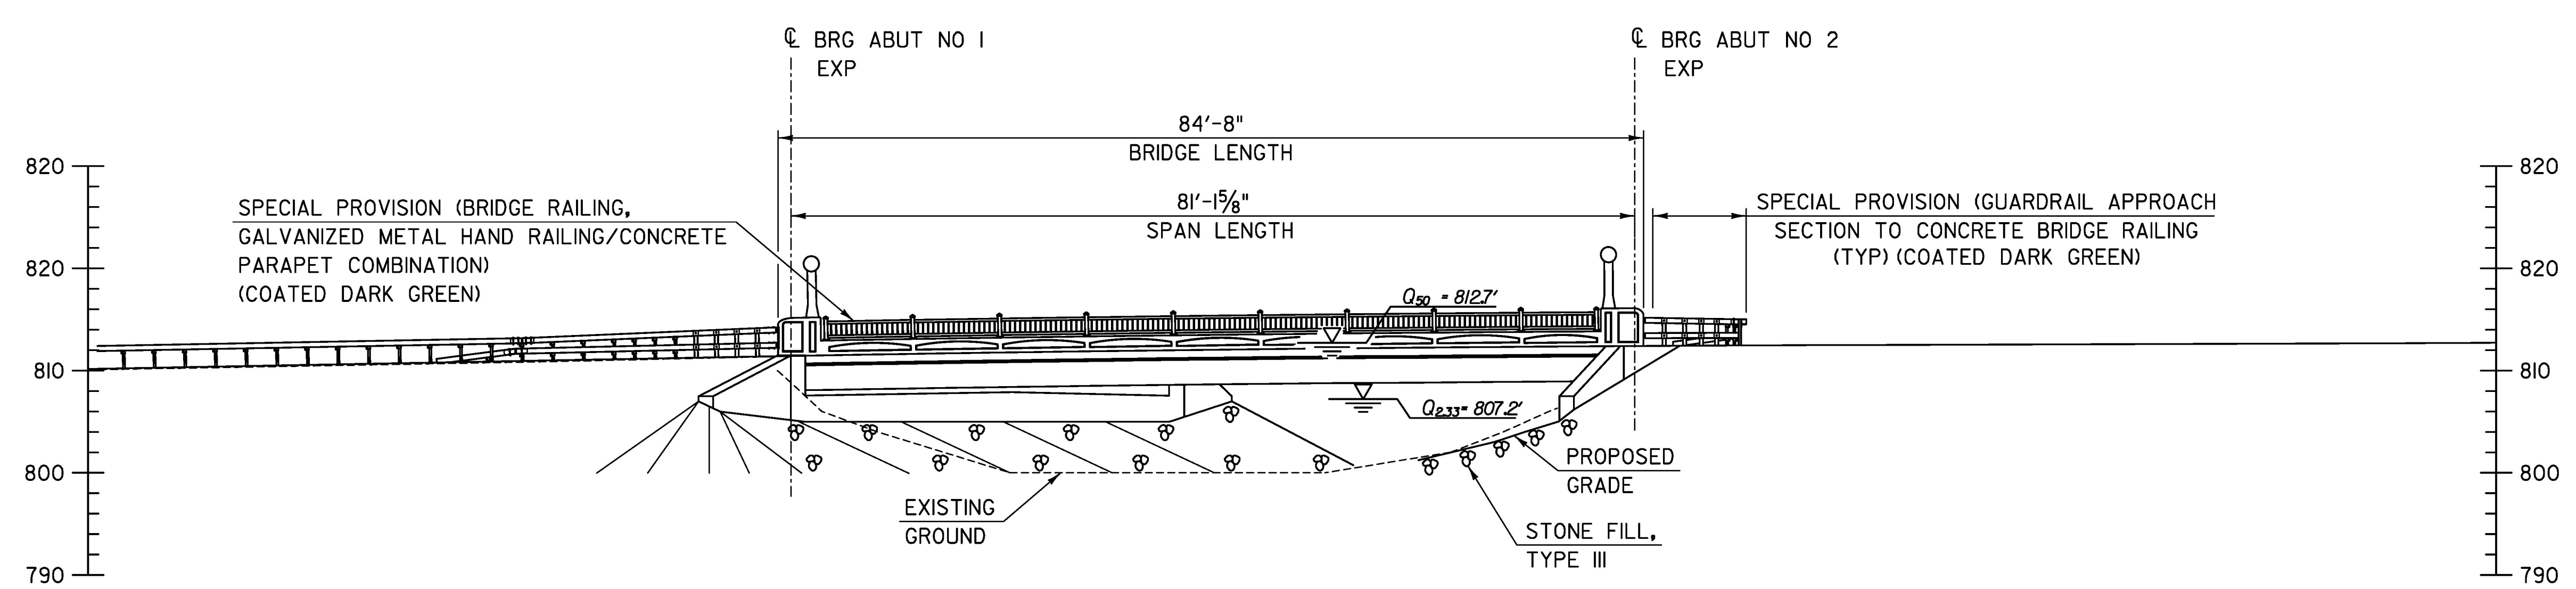

ELEVATION
 SCALE: 1" = 10'-0"

* NOTED DIMENSIONS AND/OR ELEVATIONS ARE BASED ON A FINAL DECK THICKNESS OF 8 1/2 INCHES. SEE PROJECT NOTES FOR ADDITIONAL INFORMATION.

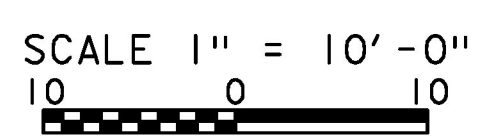

TYLIN INTERNATIONAL

PROJECT NAME: CHelsea PROJECT NUMBER: BHF 0169(9)	PLOT DATE: 8/31/2016 DRAWN BY: S. MORGAN
FILE NAME: z12cl50pe.dgn PROJECT LEADER: J. OLUND DESIGNED BY: B. TOOTHAKER PLAN AND ELEVATION	CHECKED BY: J. OLUND SHEET 38 OF 137