


NOTE:
SEE "ABUTMENT 1 PLAN & ELEVATION" SHEET FOR SECTION A-A.

ABUTMENT NO 2 - PLAN
SCALE: 3/8" = 1'-0"
(COLUMNS & FOOTINGS NOT SHOWN FOR CLARITY)

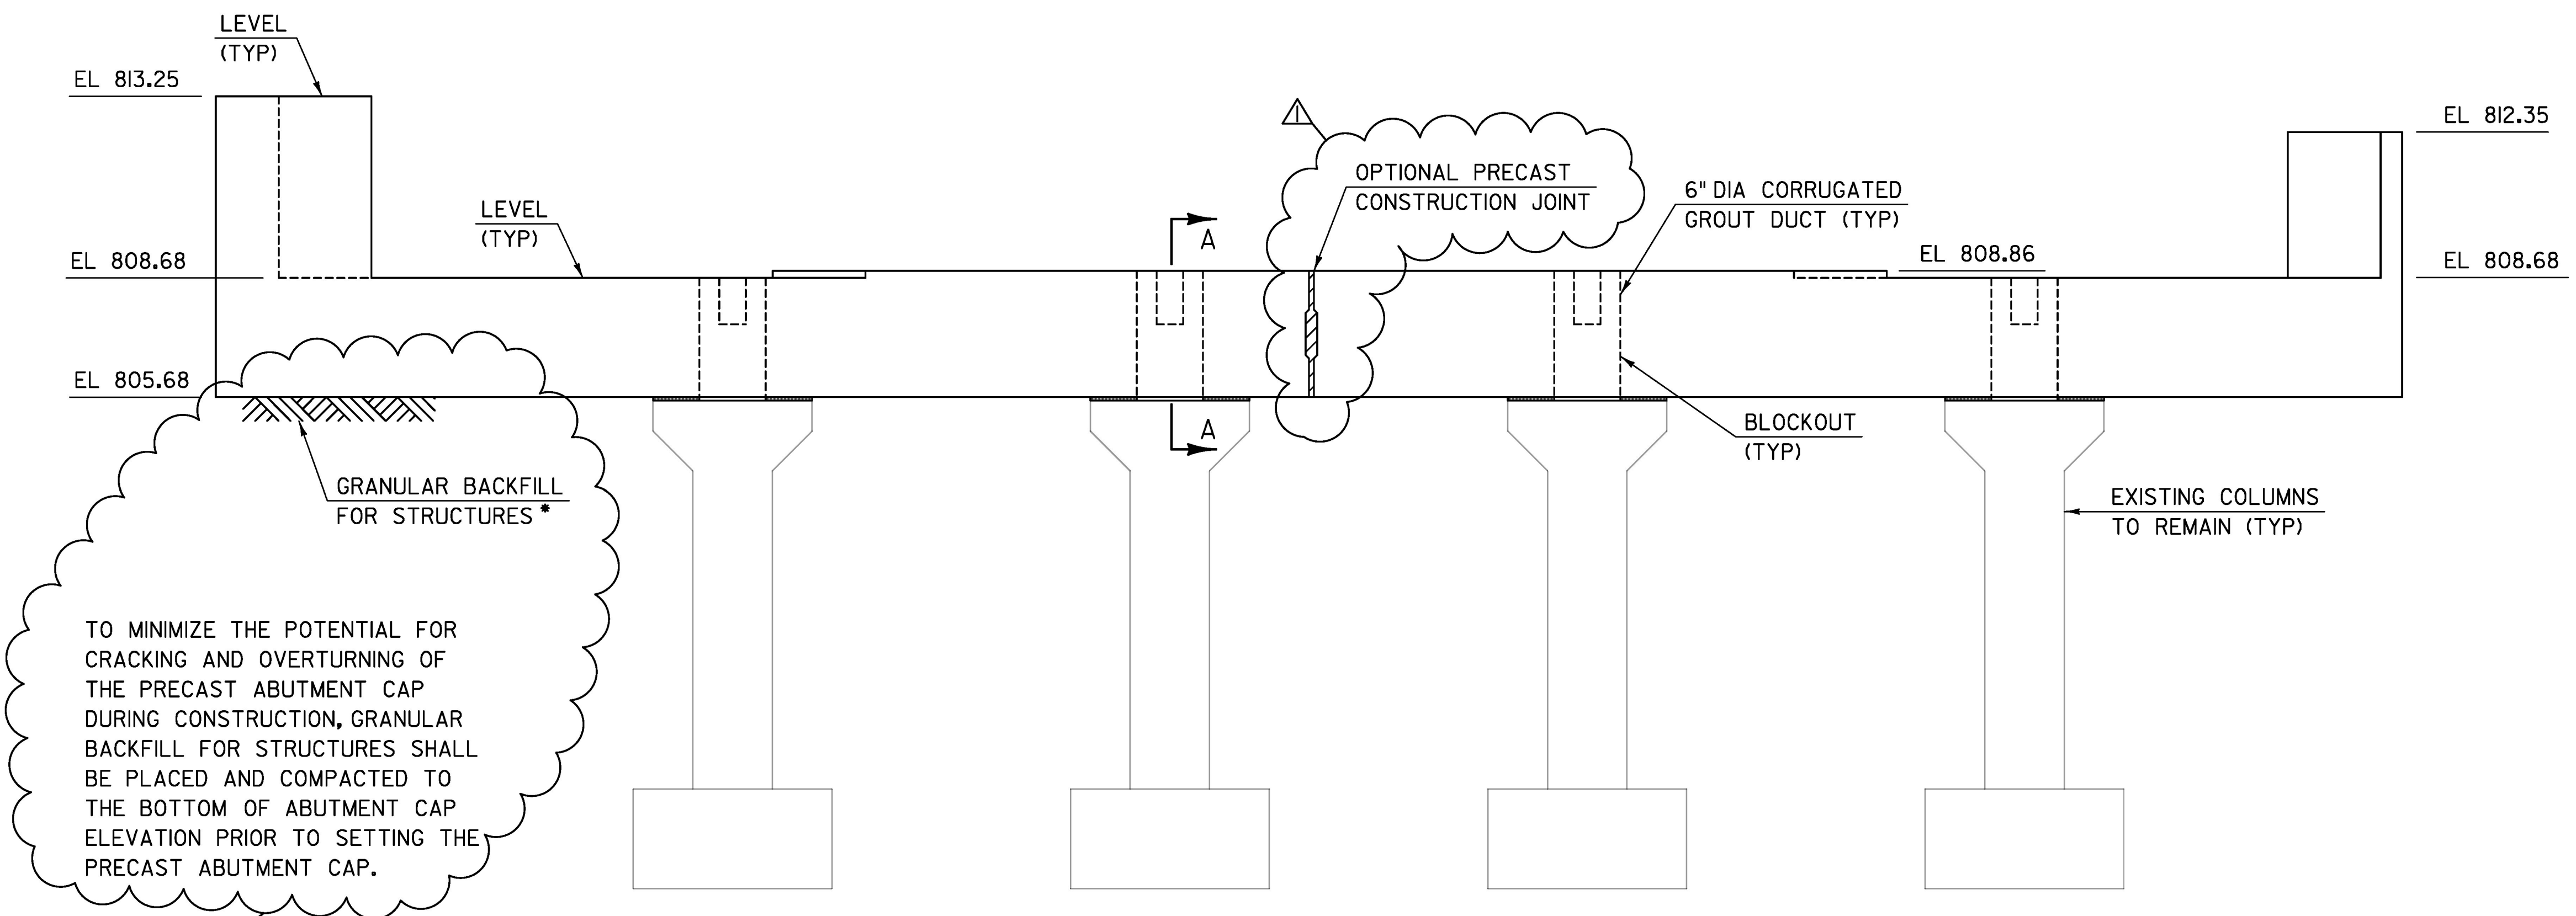

TO MINIMIZE THE POTENTIAL FOR CRACKING AND OVERTURNING OF THE PRECAST ABUTMENT CAP DURING CONSTRUCTION, GRANULAR BACKFILL FOR STRUCTURES SHALL BE PLACED AND COMPACTED TO THE BOTTOM OF ABUTMENT CAP ELEVATION PRIOR TO SETTING THE PRECAST ABUTMENT CAP.

ABUTMENT NO 2 - ELEVATION
SCALE: 3/8" = 1'-0"

REV	DATE	DESCRIPTION
△	10/26/2016	ADDED OPTIONAL PRECAST JOINT
△	10/31/2016	BACKFILL REQUIREMENT ADDED

TYLININTERNATIONAL

PROJECT NAME: CHelsea	PLOT DATE: 10/27/2016
PROJECT NUMBER: BHF 0169(9)	DRAWN BY: S. MORGAN
FILE NAME: z12ci50abu+2.dgn	CHECKED BY: J. OLUND
PROJECT LEADER: J. OLUND	SHEET 51 OF 137
DESIGNED BY: D. MYERS	
ABUTMENT 2 PLAN & ELEVATION	