


NOTE:

- FOR NOTES AND DETAIL "A", SEE APPROACH RAILING DETAILS 1 SHEET.

NORTHEAST APPROACH RAILING PLAN

1/2" = 1'-0"

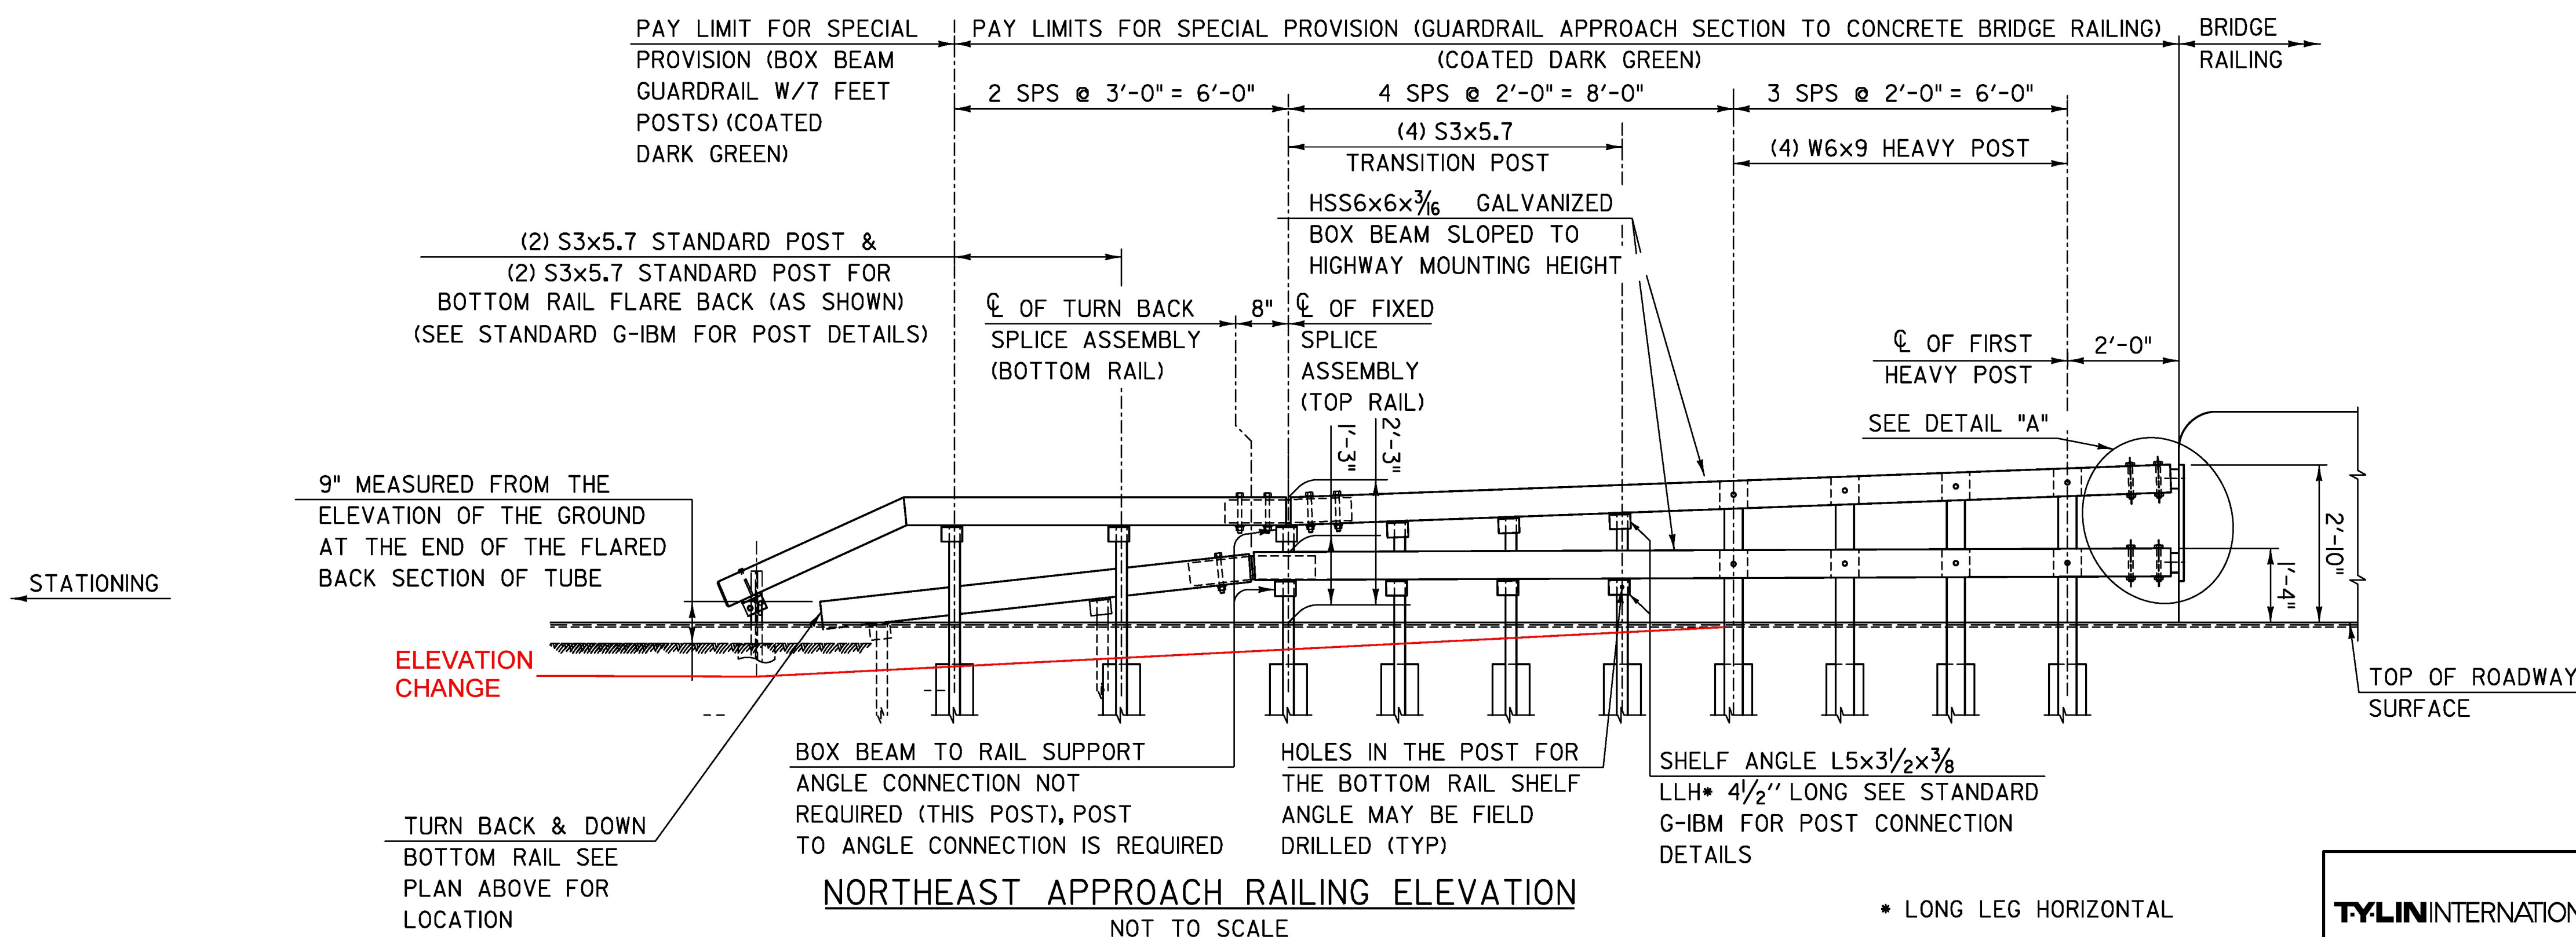

PROJECT NAME:	CHelsea
PROJECT NUMBER:	BHF 0169(9)
FILE NAME:	z12ci50appr2.dgn
PROJECT LEADER:	J. OLUND
DESIGNED BY:	B. TOOTHAKER
APPROACH RAILING DETAILS 2	
PLOT DATE:	8/31/2016
DRAWN BY:	S. MORGAN
CHECKED BY:	J. OLUND
SHEET	58 OF 137



* LONG LEG HORIZONTAL