




50+25

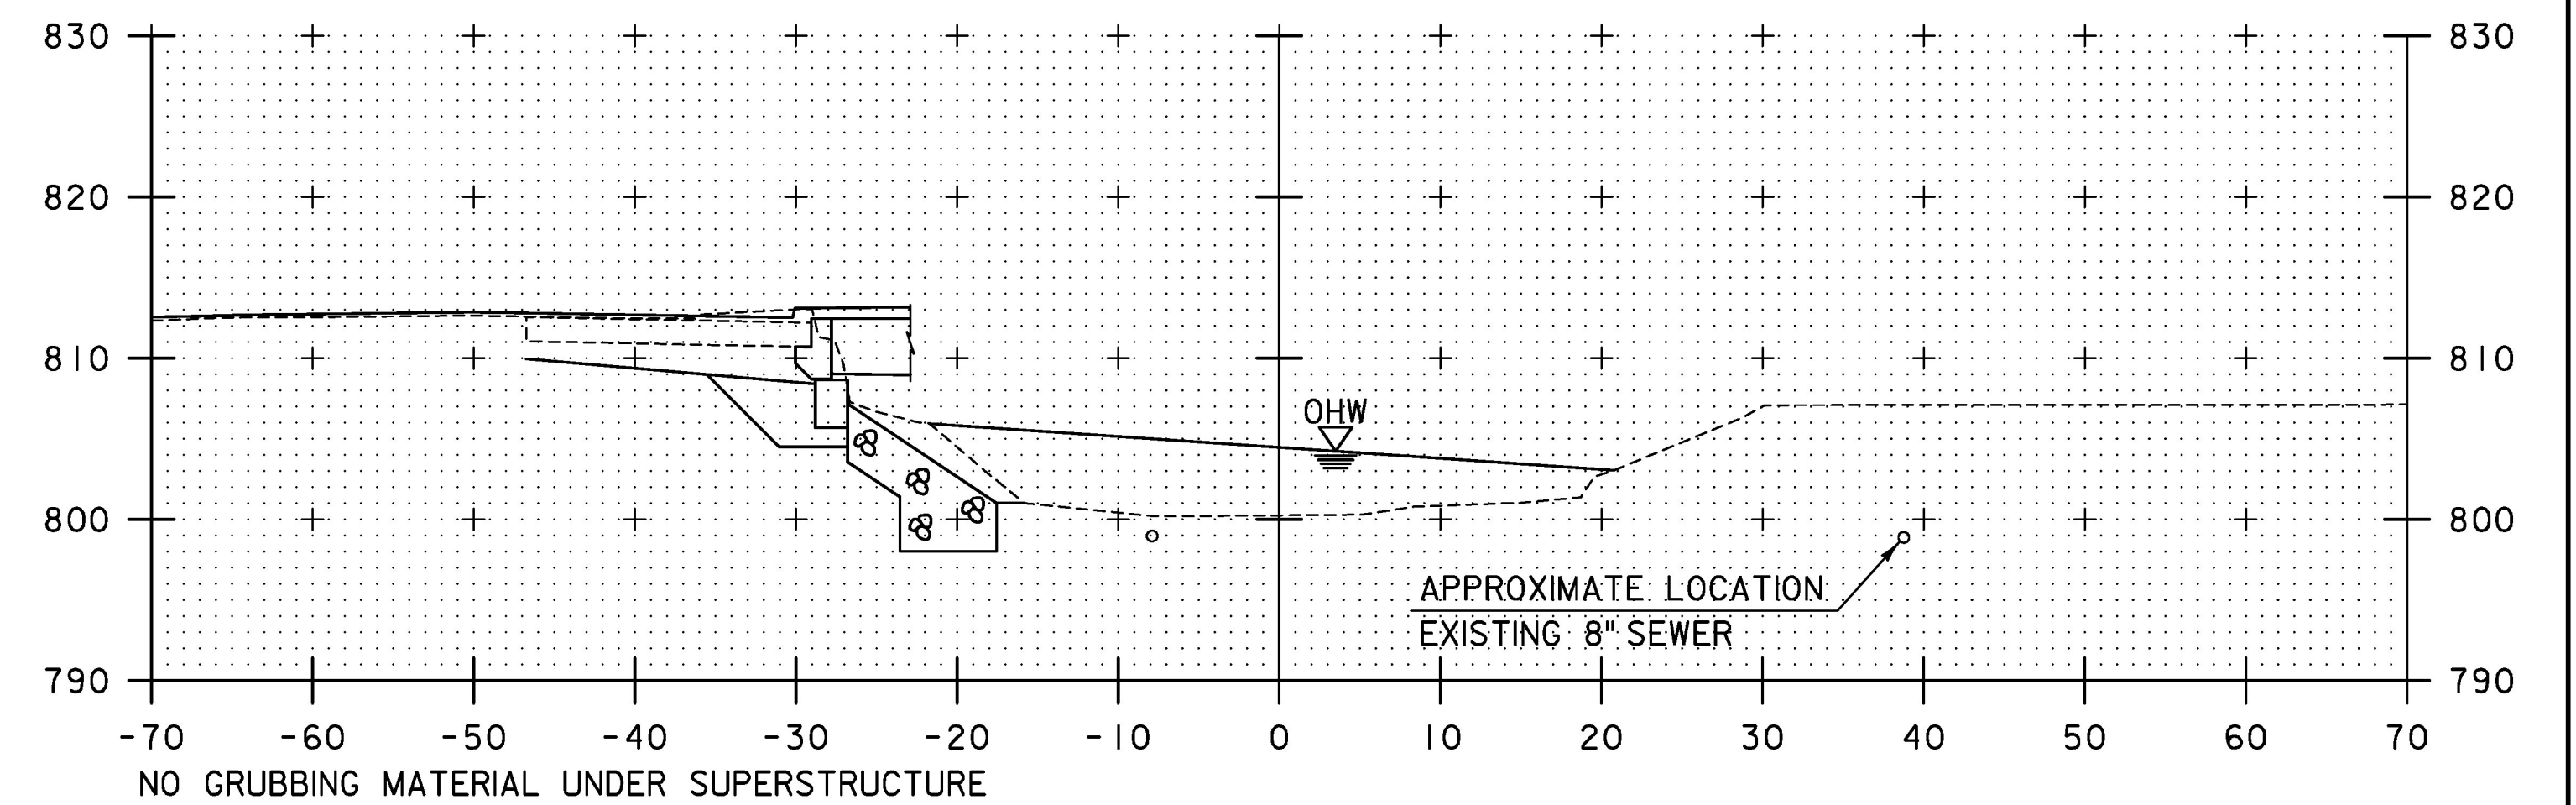

50+50

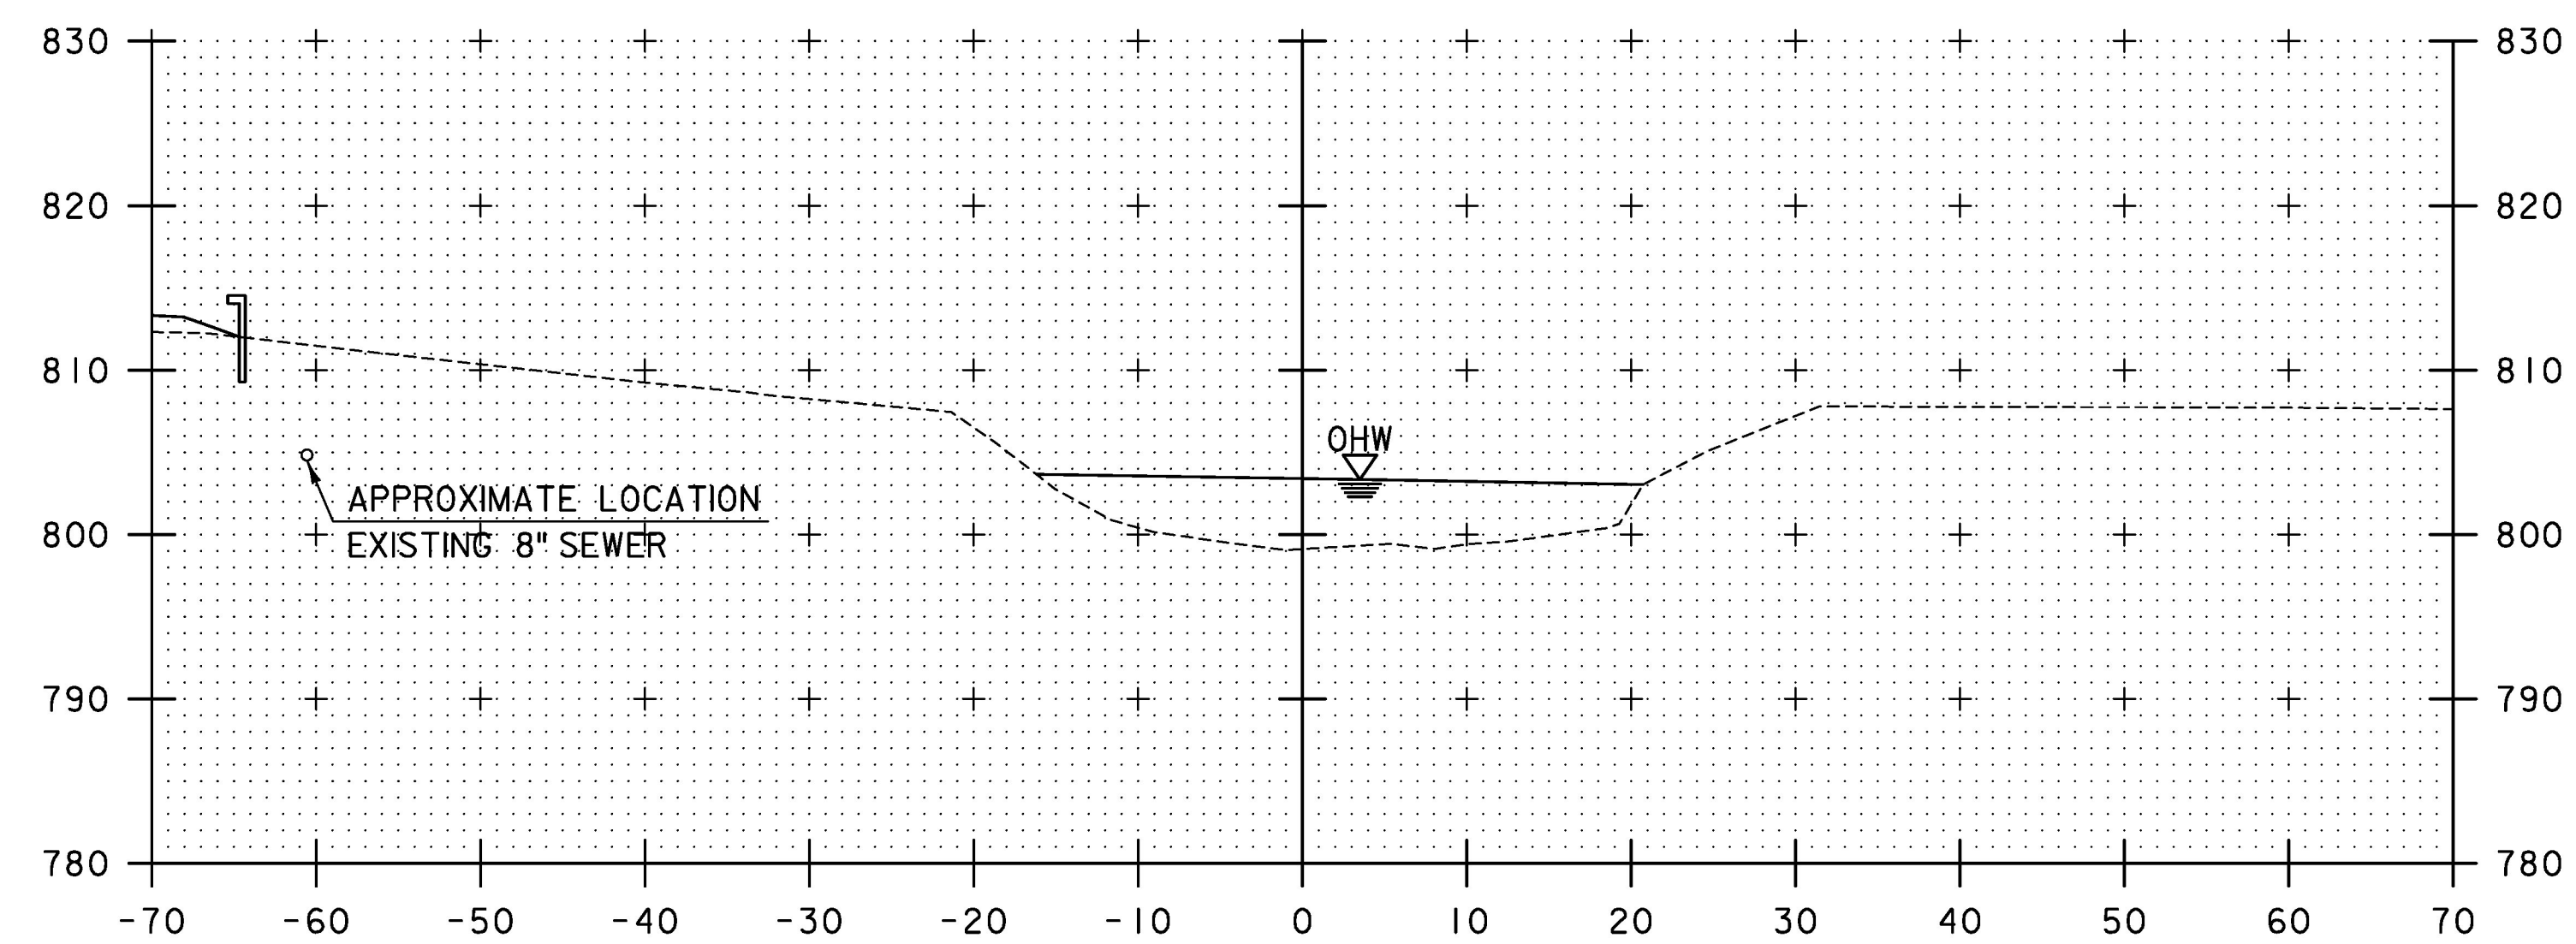

50+00

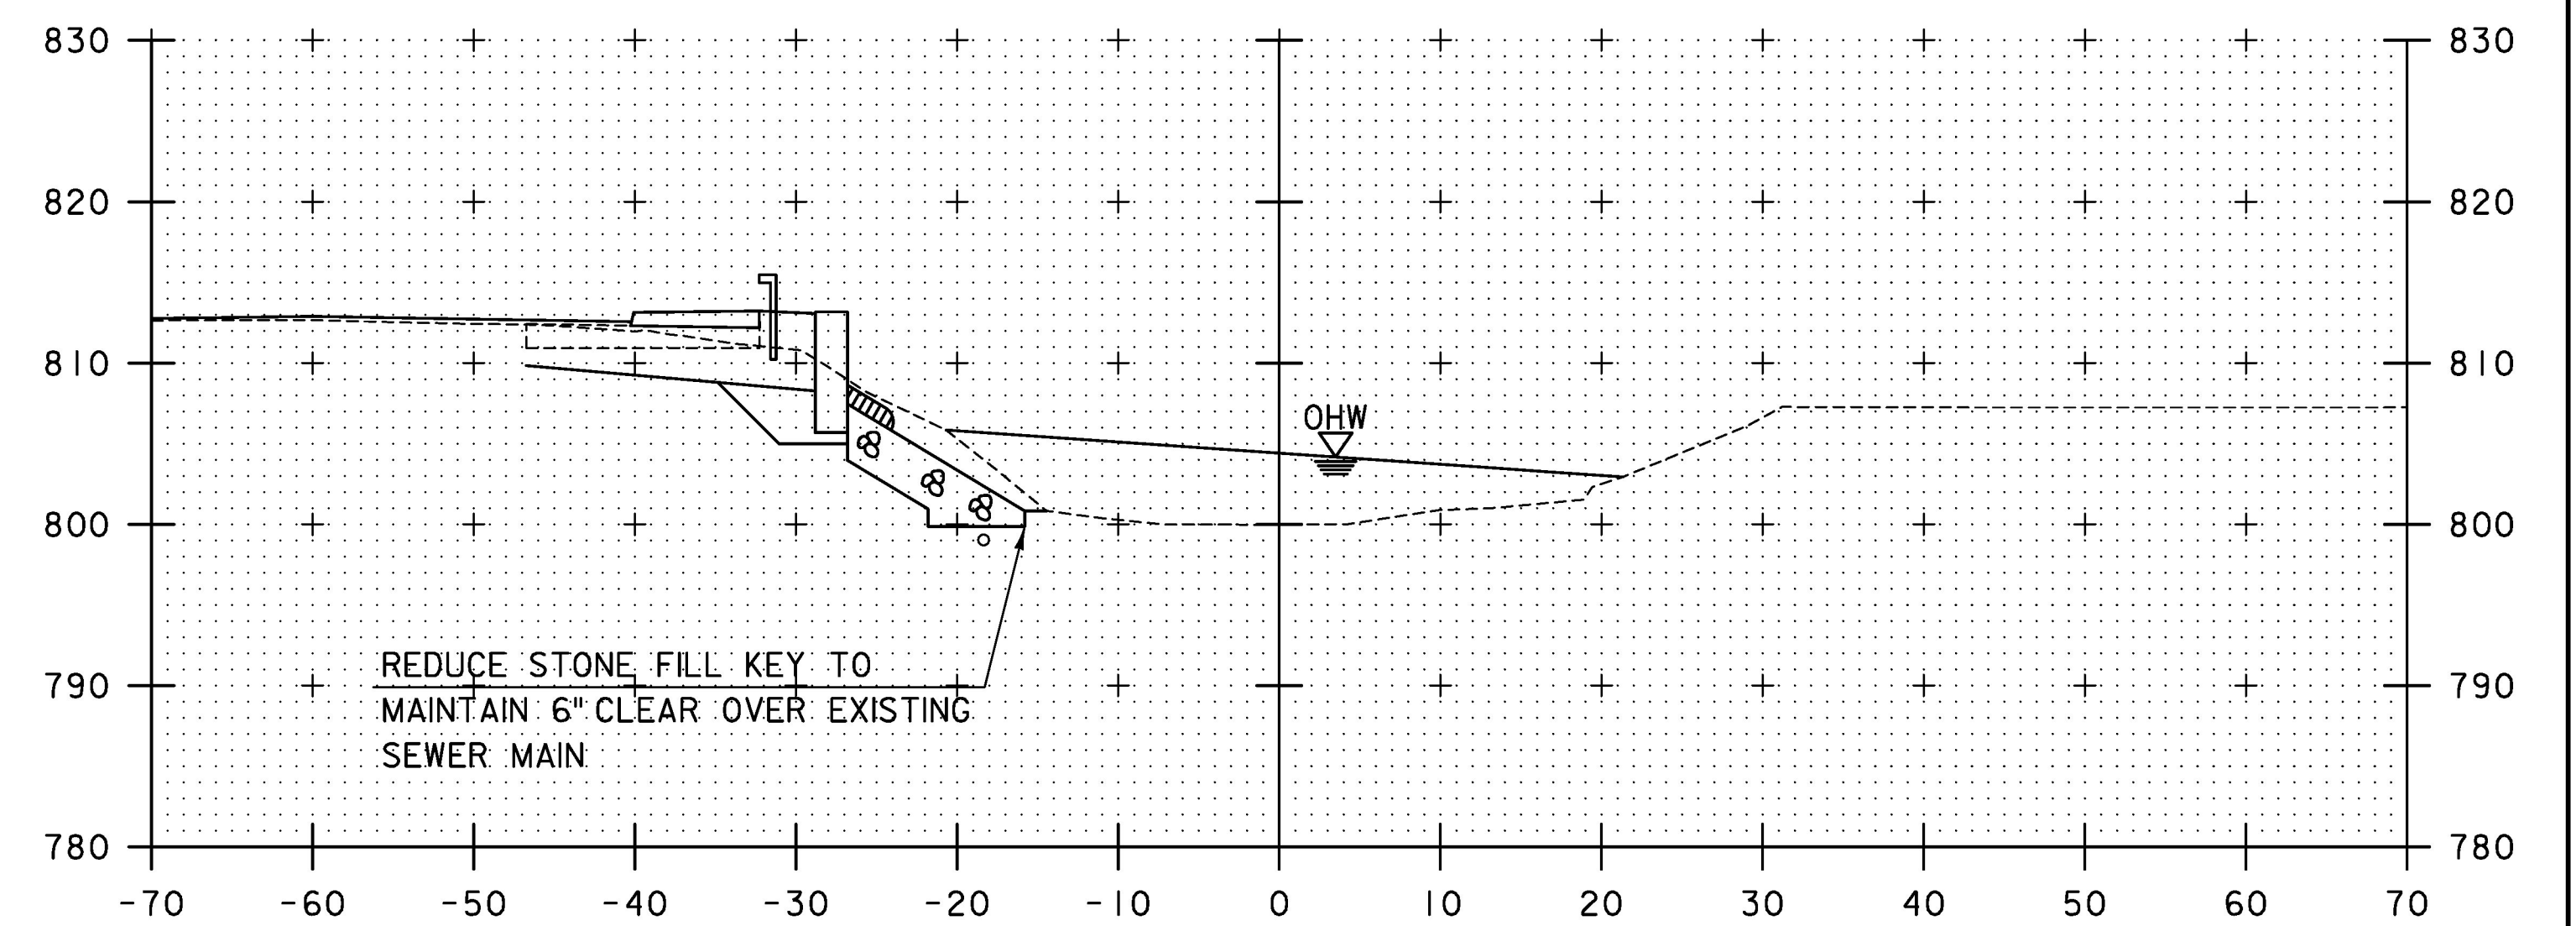

50+40

NO GRUBBING MATERIAL UNDER SUPERSTRUCTURE

REDUCE STONE FILL KEY TO
MAINTAIN 6" CLEAR OVER EXISTING
SEWER MAIN

STATION 50+27.65 LT
BEGIN UNCLASSIFIED CHANNEL EXCAVATION
BEGIN GEOTEXTILE UNDER STONE FILL
BEGIN STONE FILL, TYPE III
BEGIN GRUBBING MATERIAL

STA. 50+00 TO STA. 50+50

TYLIN INTERNATIONAL

PROJECT NAME: CHelsea
PROJECT NUMBER: BHF 0169(9)

FILE NAME: z12ci50chanxs.dgn
PROJECT LEADER: J. OLUND
DESIGNED BY: T. POULIN
CHANNEL SECTIONS I

PLOT DATE: 8/31/2016
DRAWN BY: T. POULIN
CHECKED BY: J. OLUND
SHEET 63 OF 137