



50+80

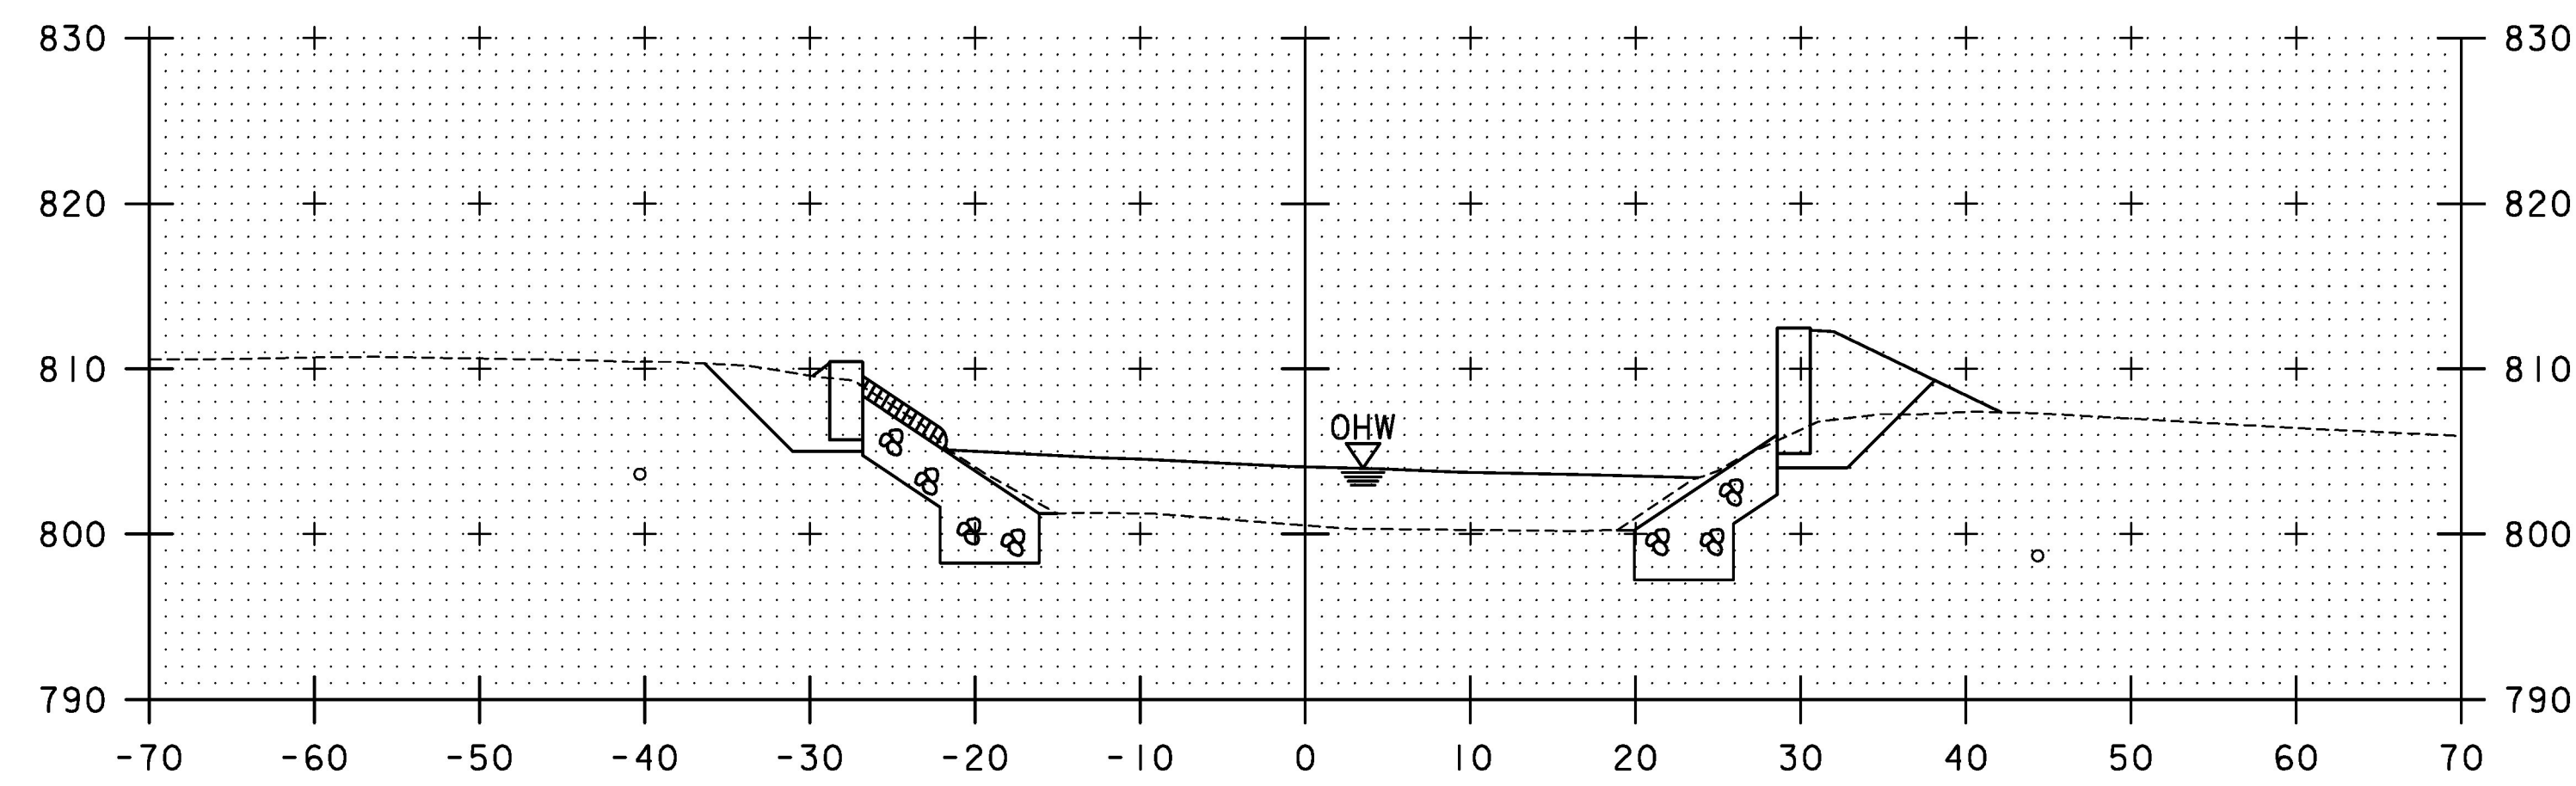


NO GRUBBING MATERIAL BENEATH SUPERSTRUCTURE

51+00

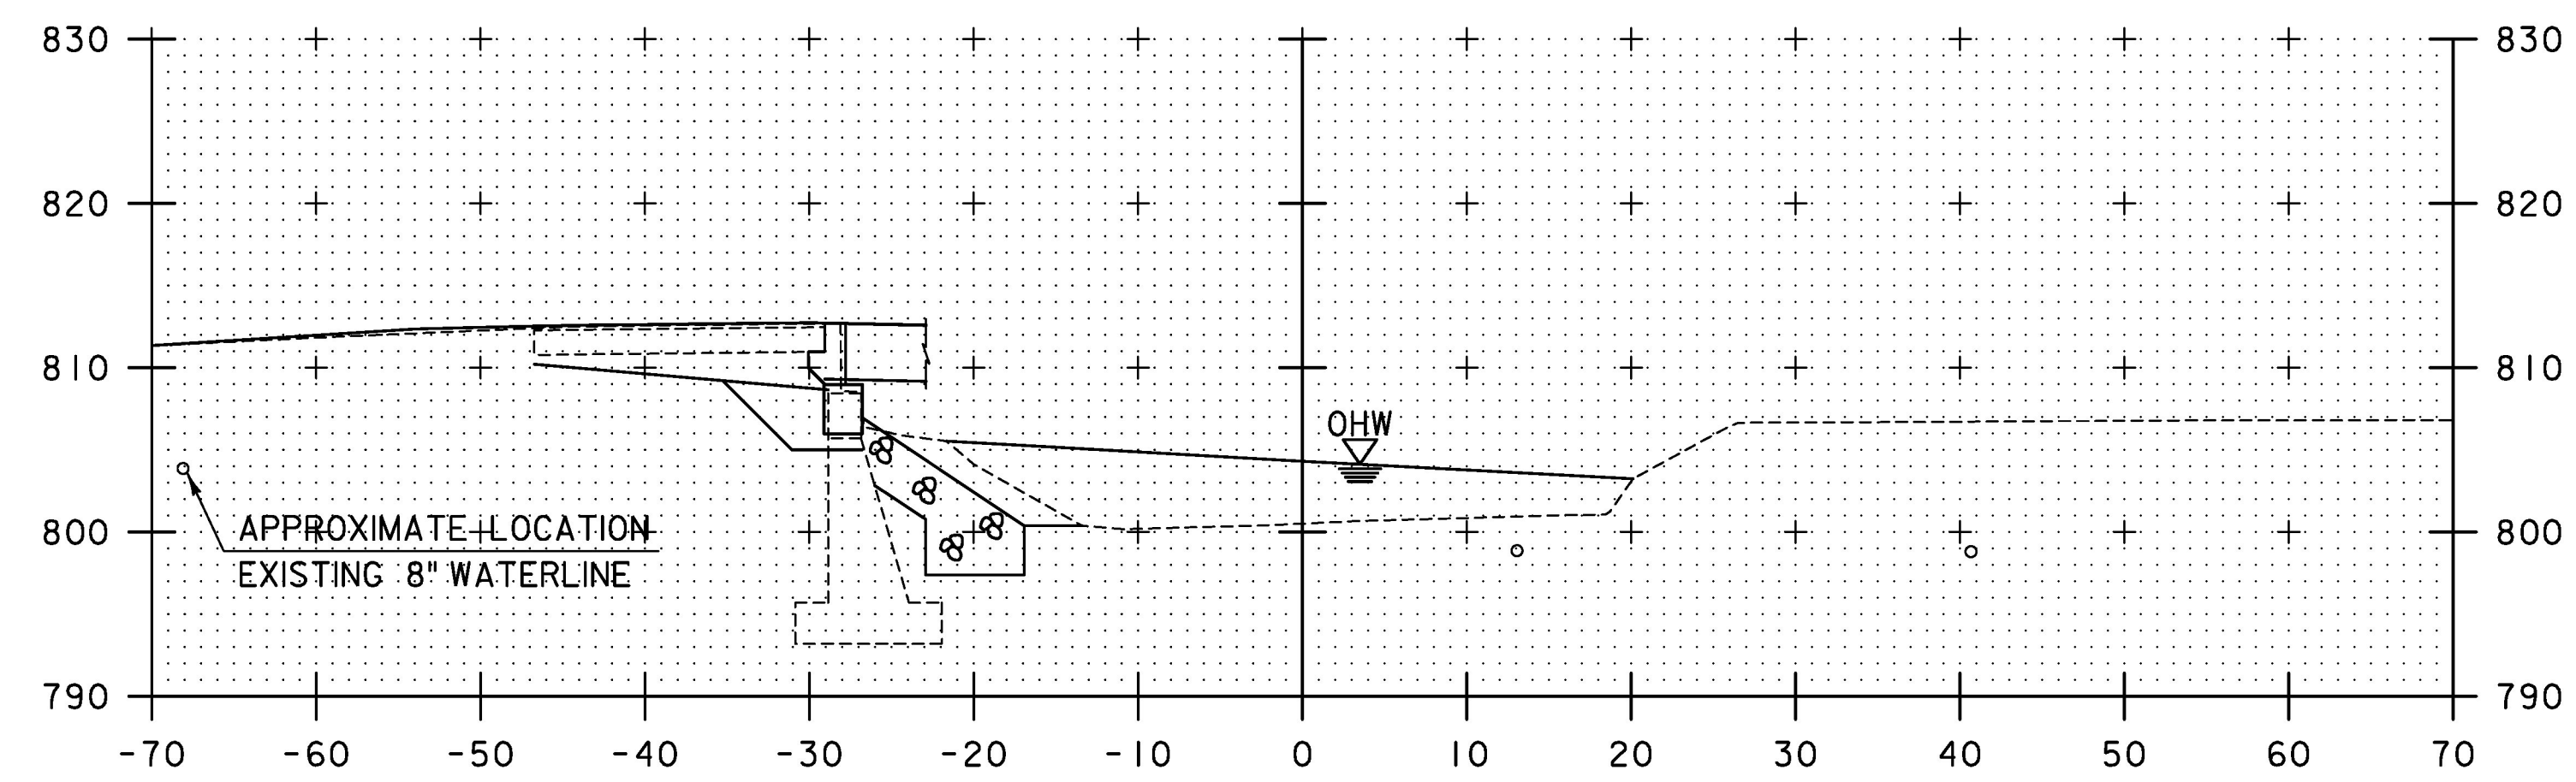


50+70

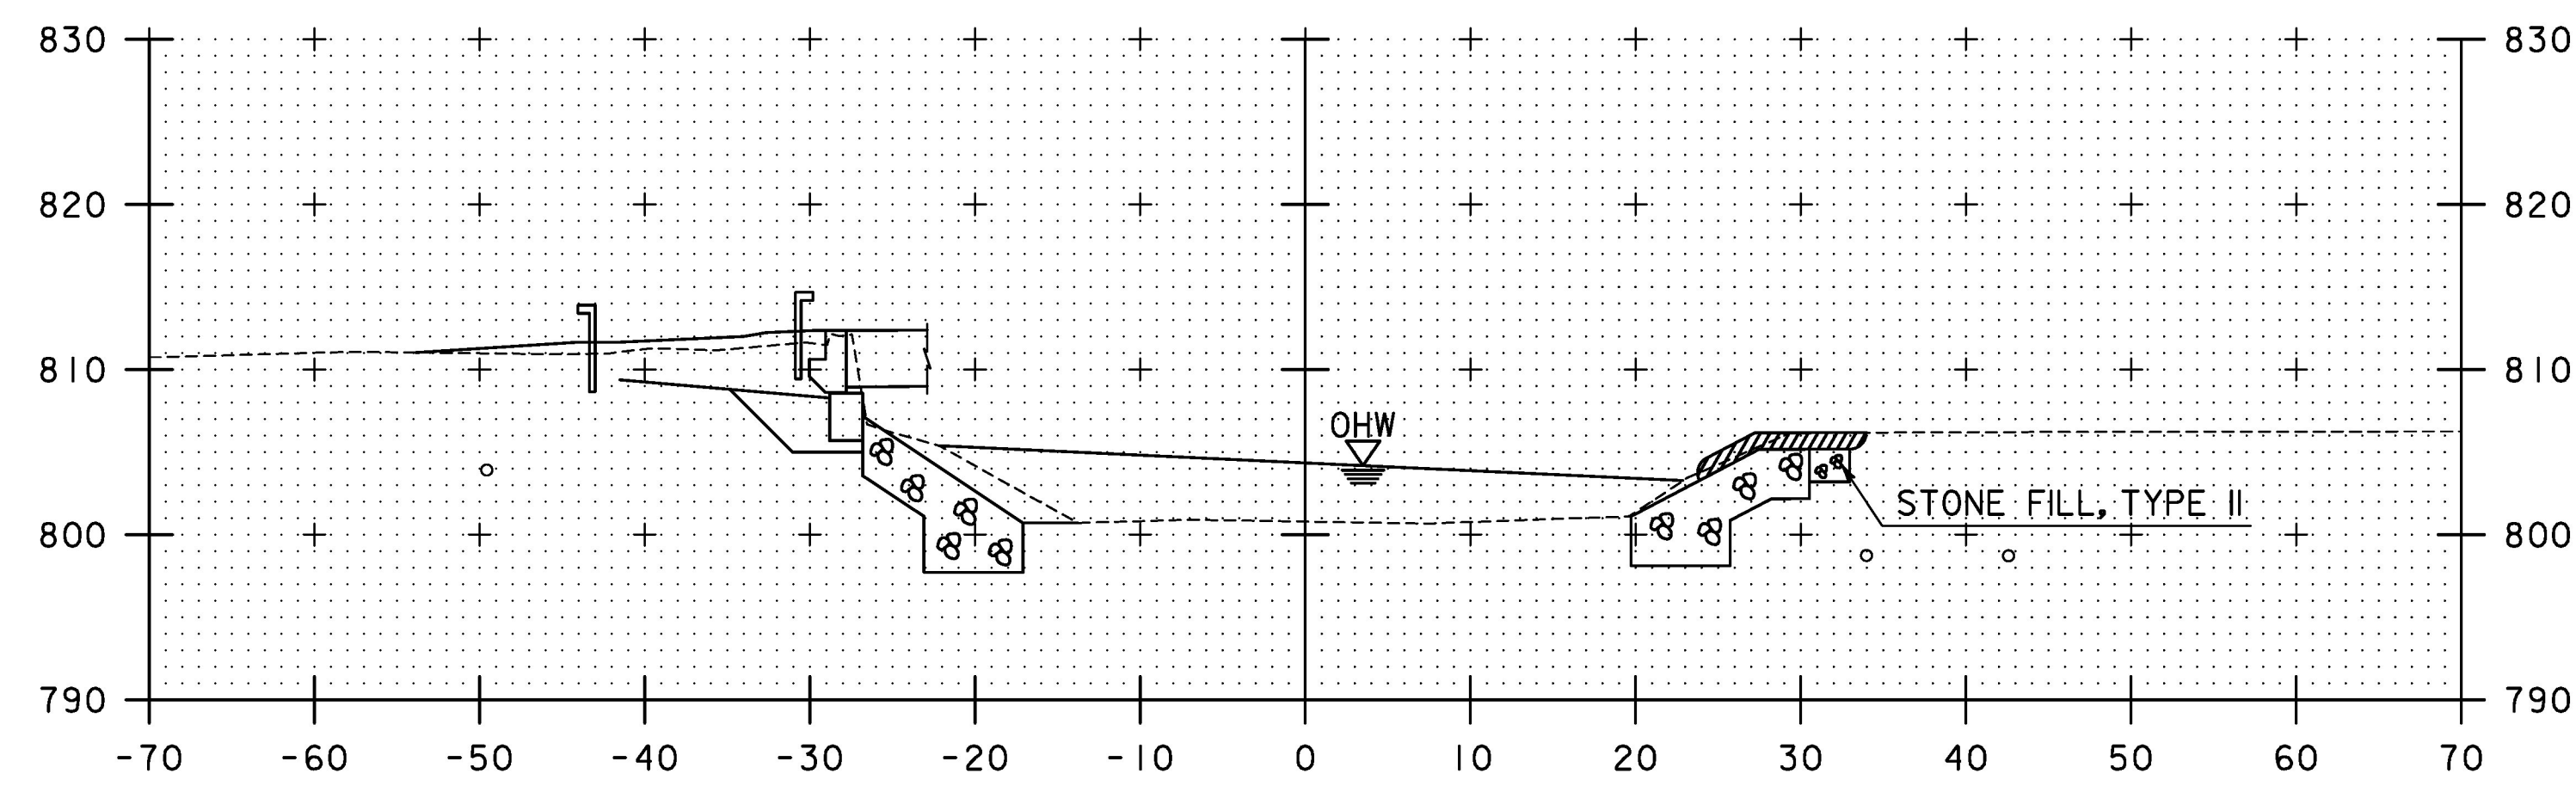

50+90

STATION 50+88.30 RT  
 BEGIN UNCLASSIFIED CHANNEL EXCAVATION  
 BEGIN GEOTEXTILE UNDER STONE FILL  
 BEGIN STONE FILL, TYPE III  
 BEGIN GRUBBING MATERIAL

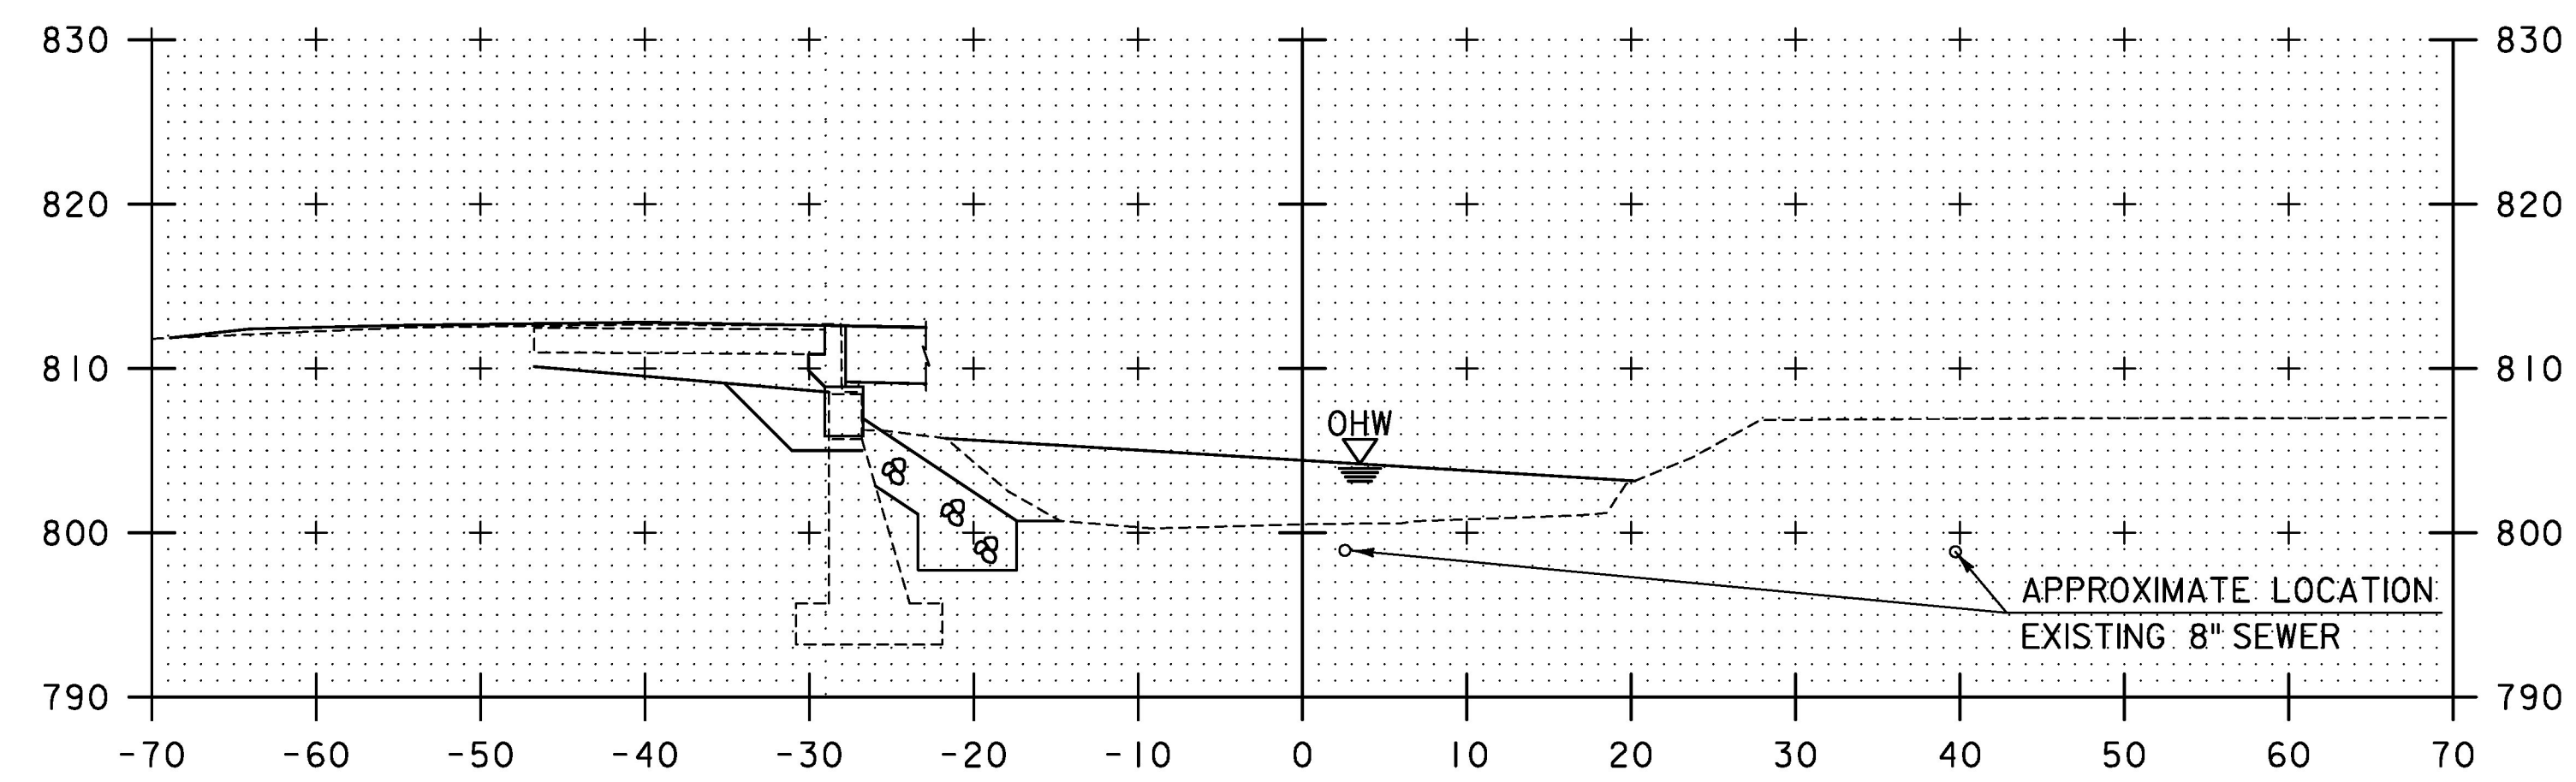

50+60

PROJECT NAME:	CHELSEA	
PROJECT NUMBER:	BHF 0169(9)	
FILE NAME:	z12ci50chanxs.dgn	PLOT DATE:
PROJECT LEADER:	J. OLUND	DRAWN BY:
DESIGNED BY:	T. POULIN	CHECKED BY:
CHANNEL SECTIONS 2		SHEET
		64 OF 137

TYLIN INTERNATIONAL

STA. 50+60 TO STA. 51+00