


VT 110 BANKING DIAGRAM


HORIZONTAL SCALE: 1"=20'
NO VERTICAL SCALE

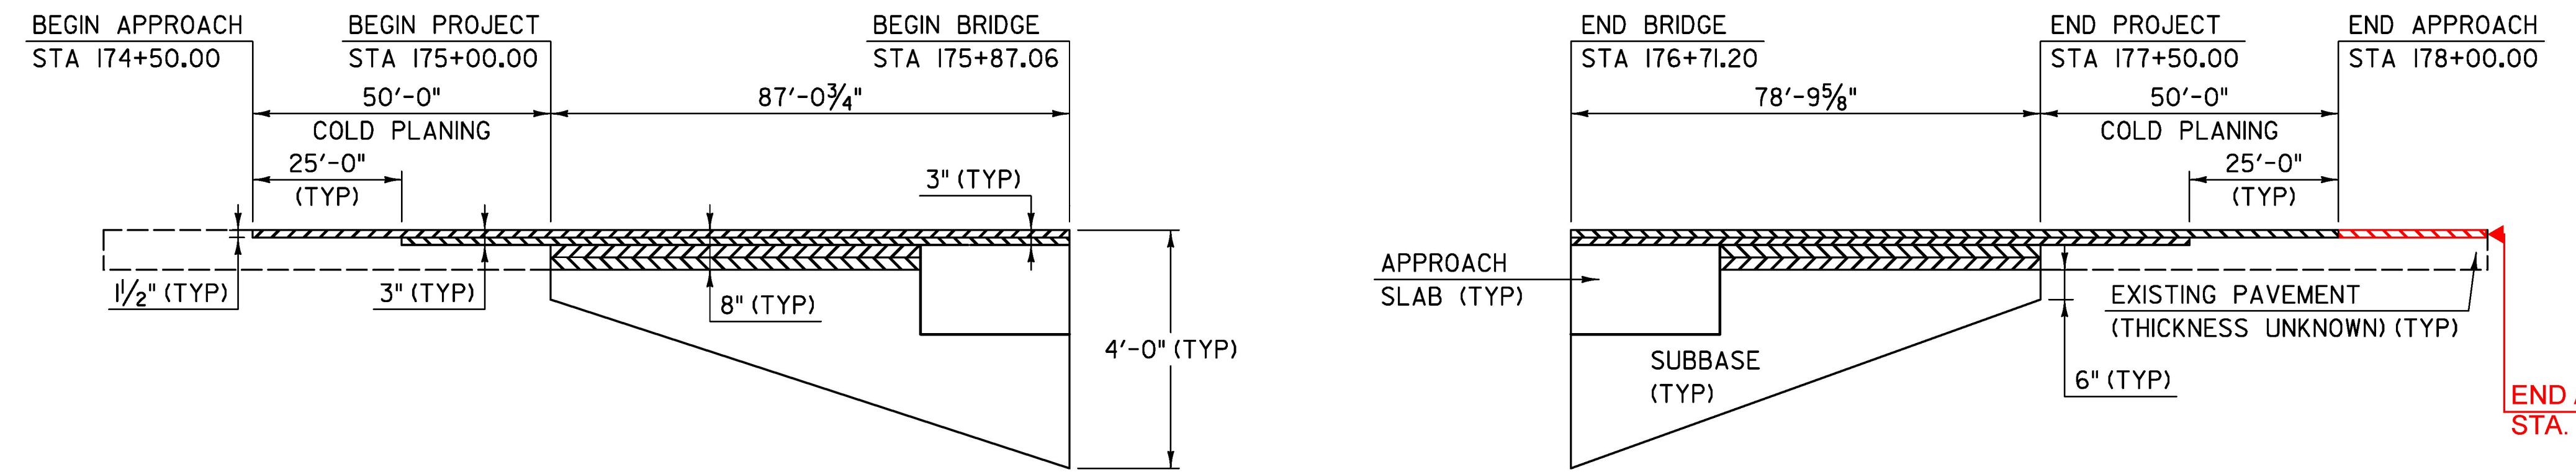

MATERIAL TRANSITION

HORIZONTAL SCALE 1" = 20'-0"
NO VERTICAL SCALE

NOTE:
GRADES SHOWN TO THE NEAREST TENTH ARE EXISTING GROUND ALONG ϕ
GRADES SHOWN TO THE NEAREST HUNDREDTH ARE FINISH GRADE ALONG ϕ

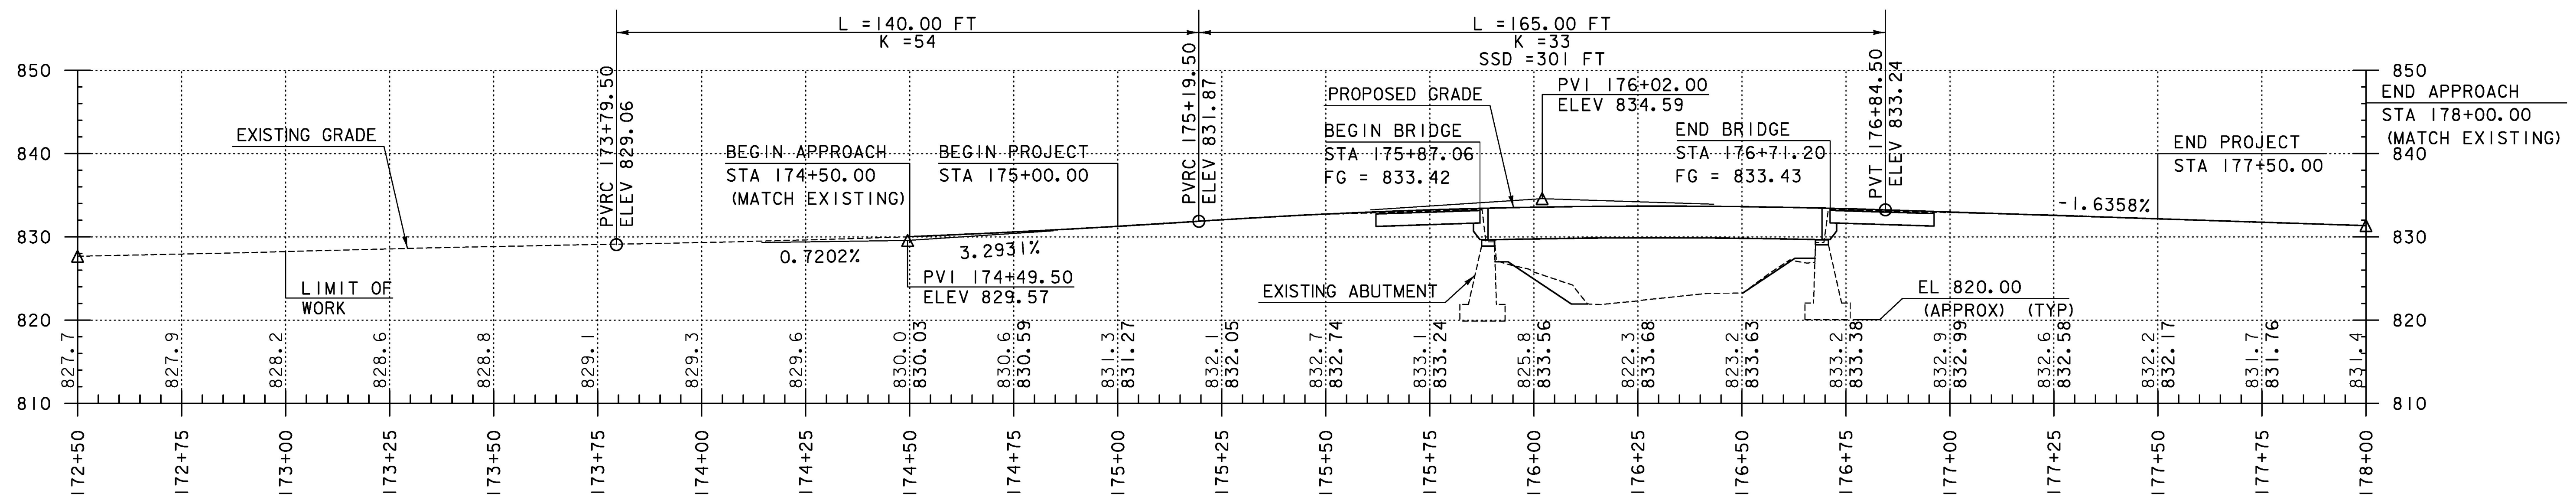

VT 110 PROFILE

HORIZONTAL SCALE: 1"=20'
VERTICAL SCALE: 1"=10'

TYLIN INTERNATIONAL	PROJECT NAME: CHelsea	PLOT DATE: 8/31/2016
	PROJECT NUMBER: BHF 0169(10)	DRAWN BY: T. POULIN
	FILE NAME: z12ci52pro.dgn	CHECKED BY: D. BURHANS
	DESIGNED BY: B. TOOTHAKER	SHEET 87 OF 137
	PROFILE AND BANKING DETAIL SHEET	