


PLAN
SCALE: 1" = 10'-0"

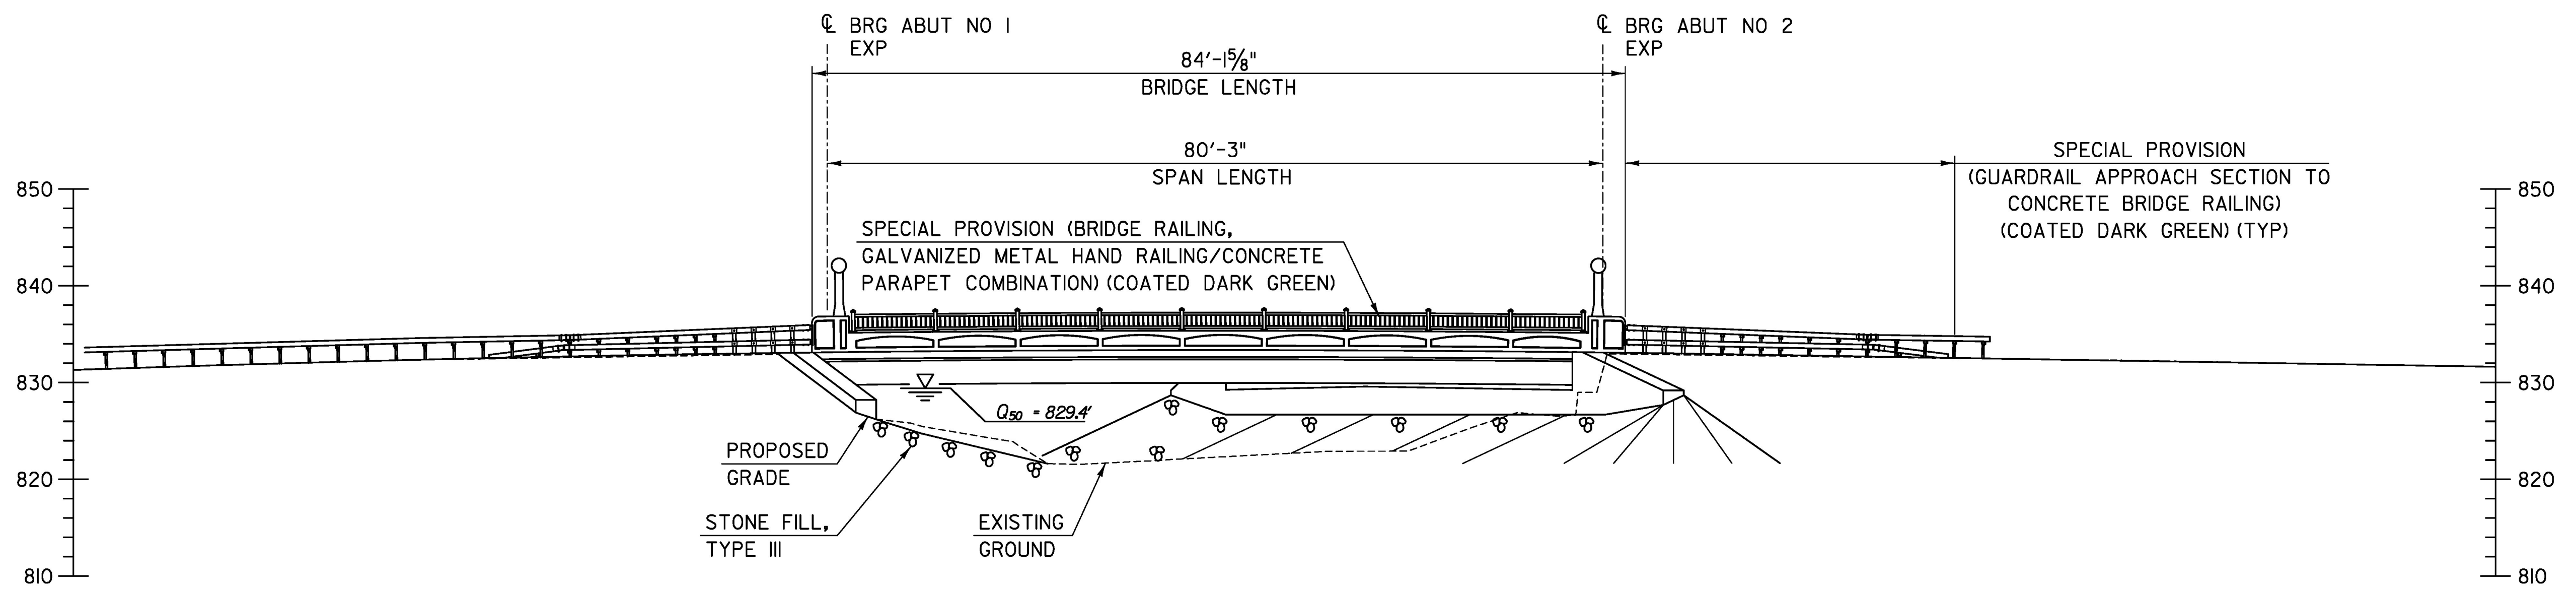

ELEVATION
SCALE: 1" = 10'-0"

*NOTED DIMENSIONS AND/OR ELEVATIONS ARE BASED ON A FINAL DECK THICKNESS OF 8 1/2 INCHES. SEE PROJECT NOTES FOR ADDITIONAL INFORMATION.

SCALE 1" = 10'-0"
10 0 10

TYLIN INTERNATIONAL	PROJECT NAME: CHelsea	PLOT DATE: 8/31/2016
	PROJECT NUMBER: BHF 0169(10)	DRAWN BY: S. MORGAN
	FILE NAME: z12cl52pe.dgn	CHECKED BY: J. OLUND
	DESIGNED BY: T. POULIN	SHEET 100 OF 137
	PLAN AND ELEVATION	