



ABUTMENT 2 RECONSTRUCTION PLAN

SCALE: 3/8" = 1'-0"

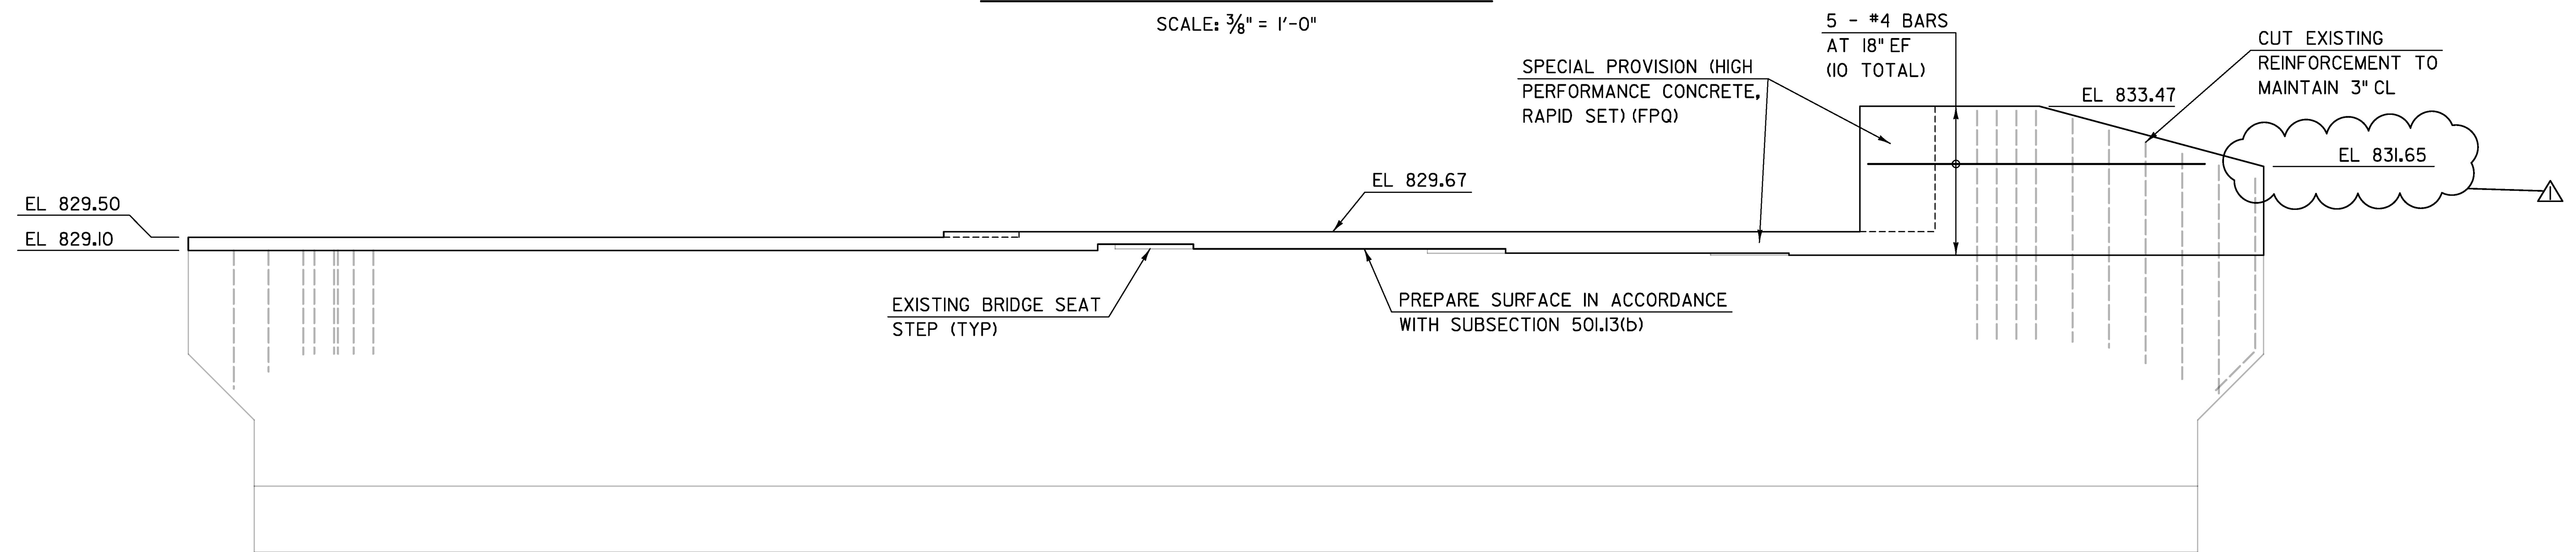

ABUTMENT 2 RECONSTRUCTION ELEVATION

SCALE: 3/8" = 1'-0"

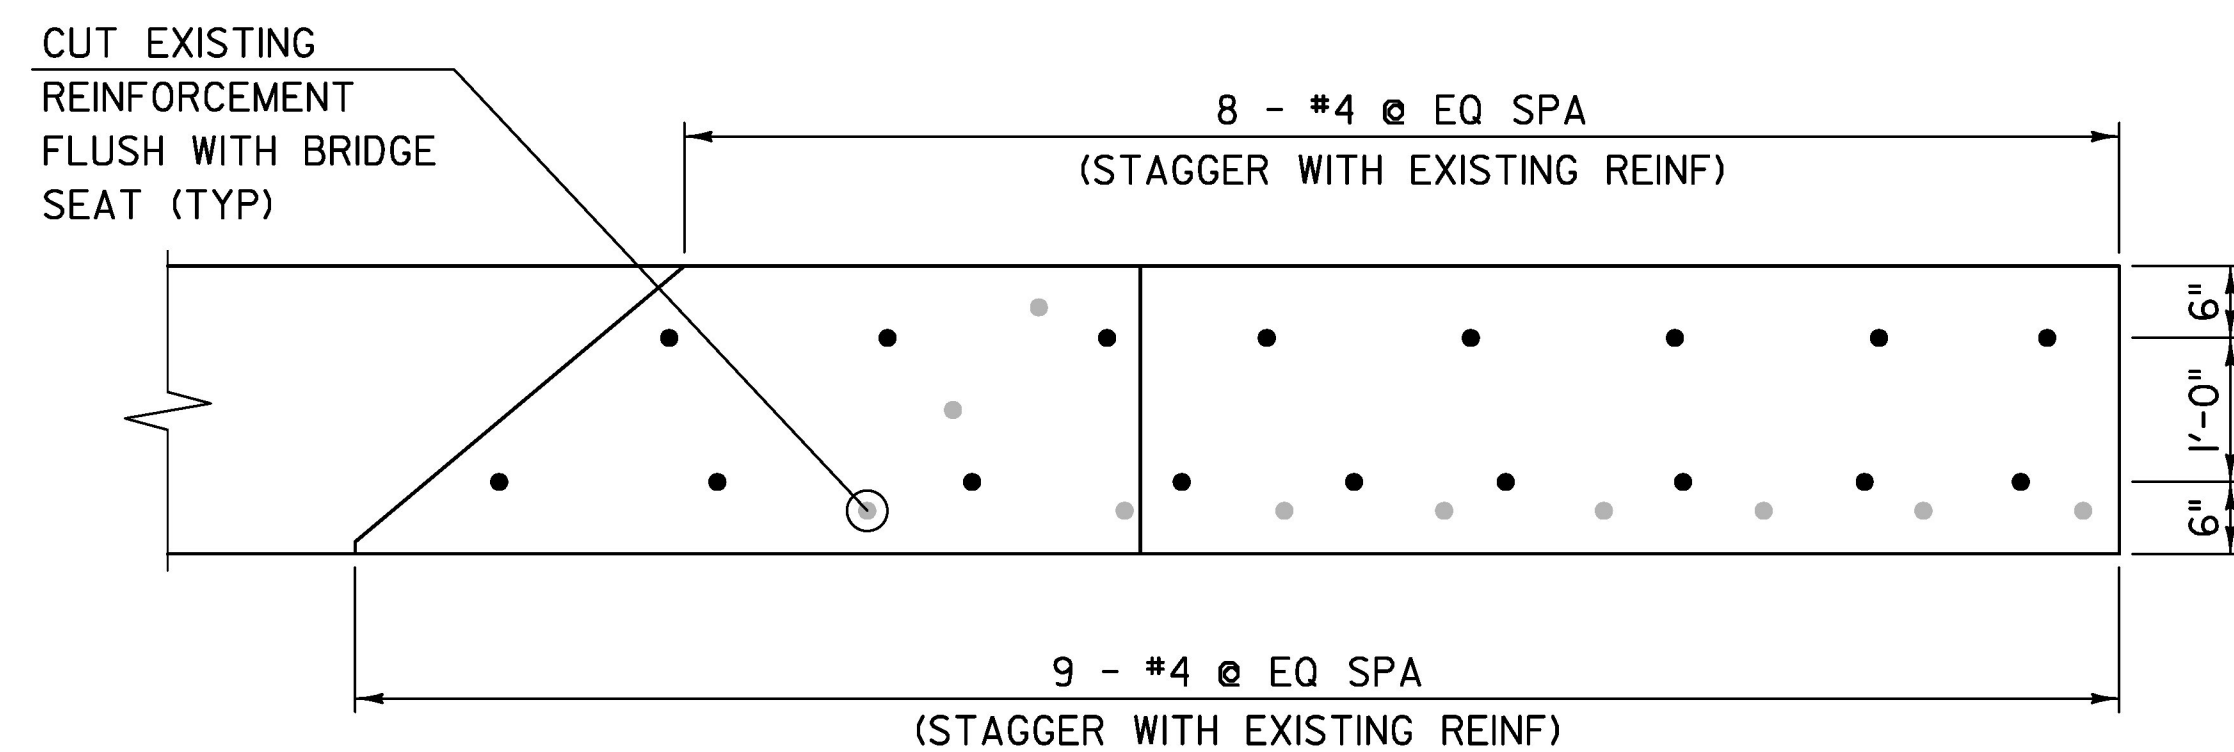

ALTERNATE WINGWALL 4 REINFORCEMENT DETAIL

(PROPOSED HORIZONTAL REINFORCEMENT NOT SHOWN FOR CLARITY)

SCALE: 3/4" = 1'-0"

NOTES:

- I. SEE "ABUTMENT 1 RECONSTRUCTION" SHEET FOR NOTES AND SECTION A-A.

PROJECT NAME: CHelsea
PROJECT NUMBER: BHF 0169(10)

FILE NAME: z12ci52abu+2.dgn
PROJECT LEADER: J. OLUND
DESIGNED BY: B. TOOTHAKER
ABUTMENT 2 RECONSTRUCTION

PLOT DATE: 10/28/2016
DRAWN BY: J. HOWE
CHECKED BY: J. OLUND
SHEET 114 OF 137

REV	DATE	DESCRIPTION
△	10/31/2016	ELEVATION CORRECTION

TYLININTERNATIONAL