




173+25

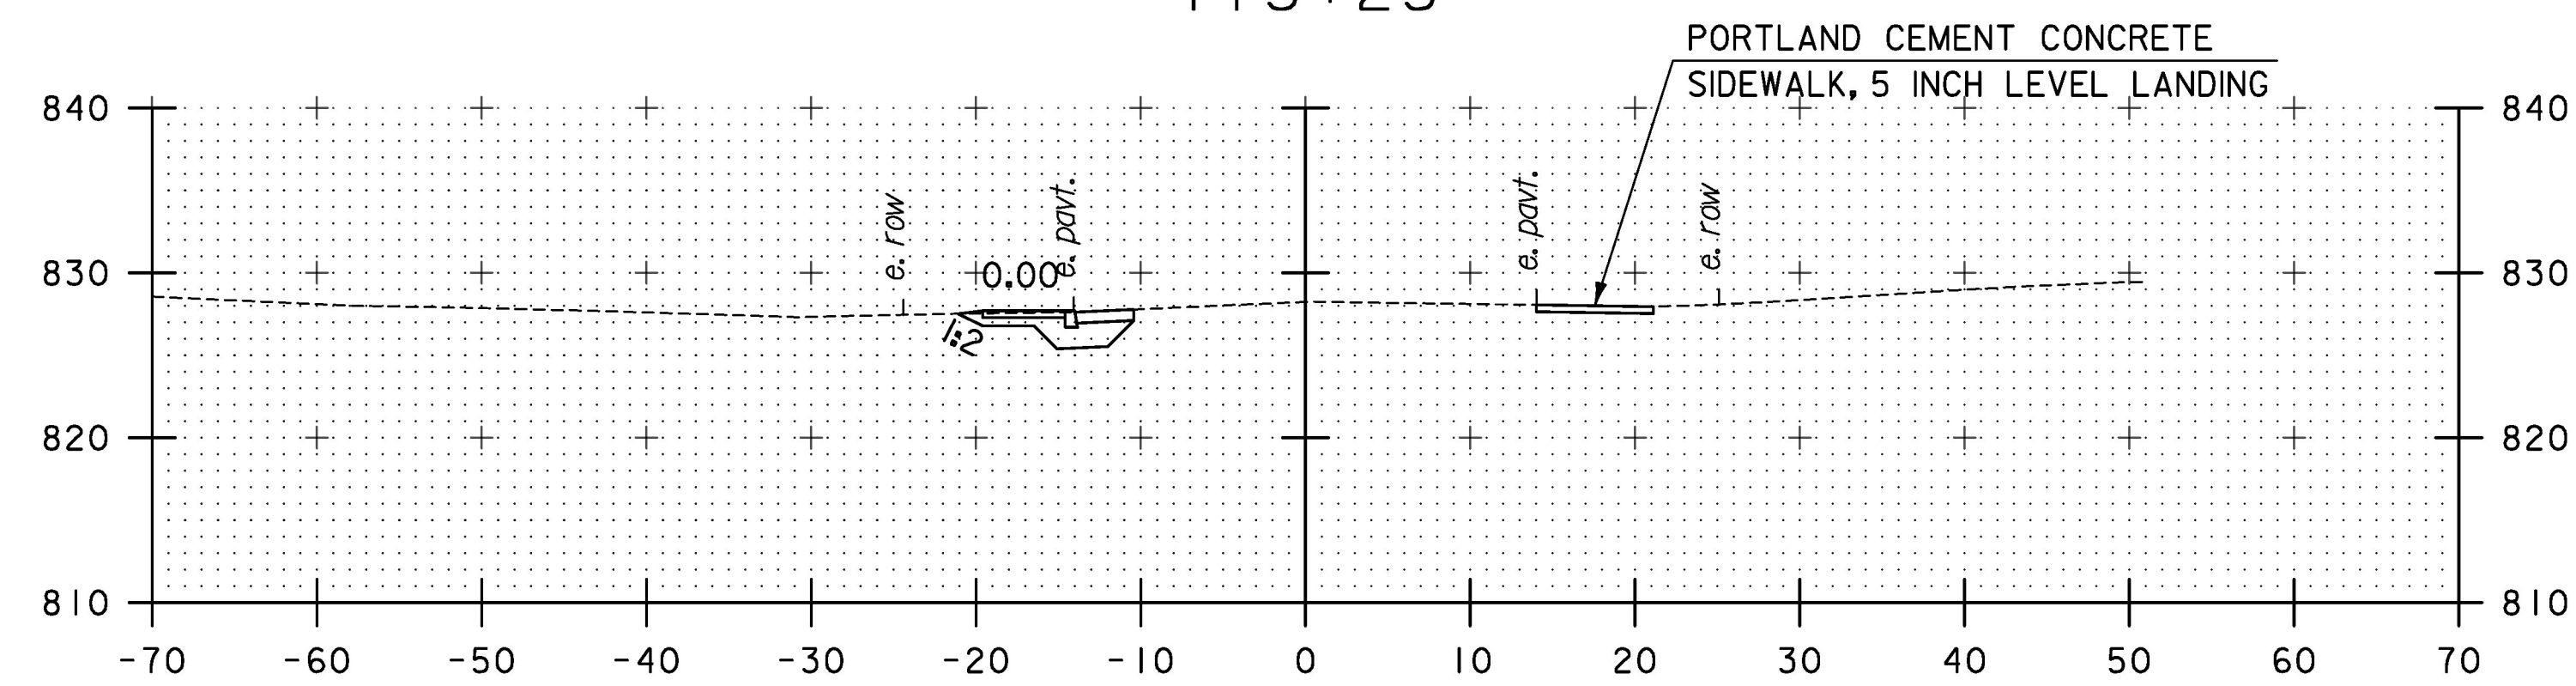


173+00
LIMIT OF WORK

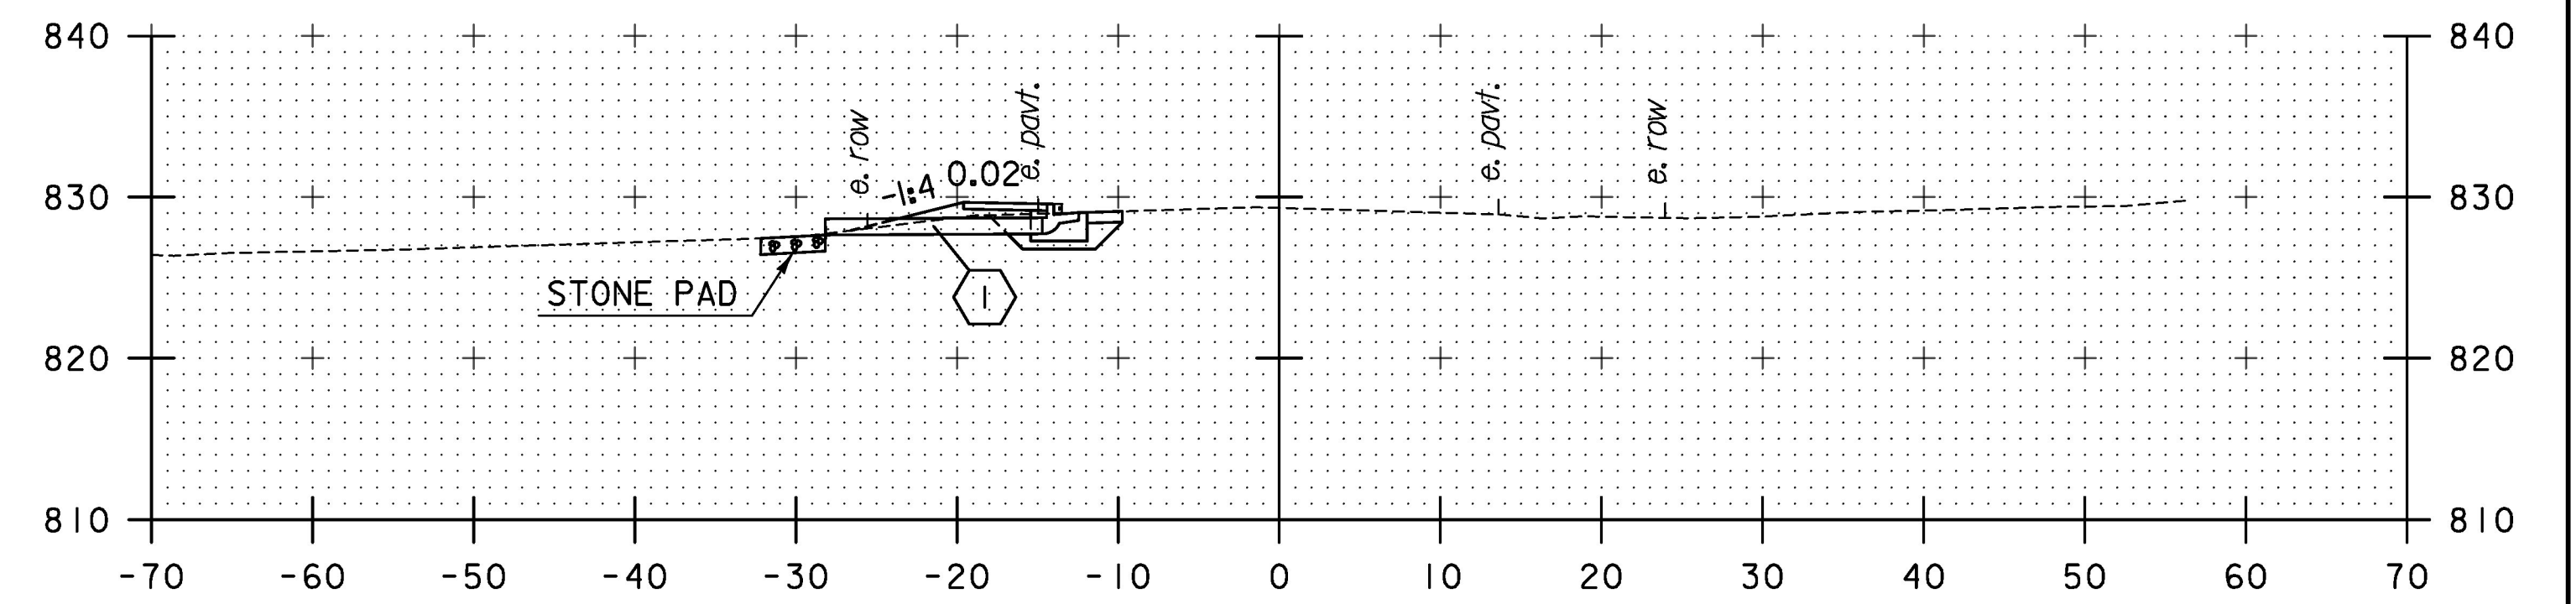

174+00

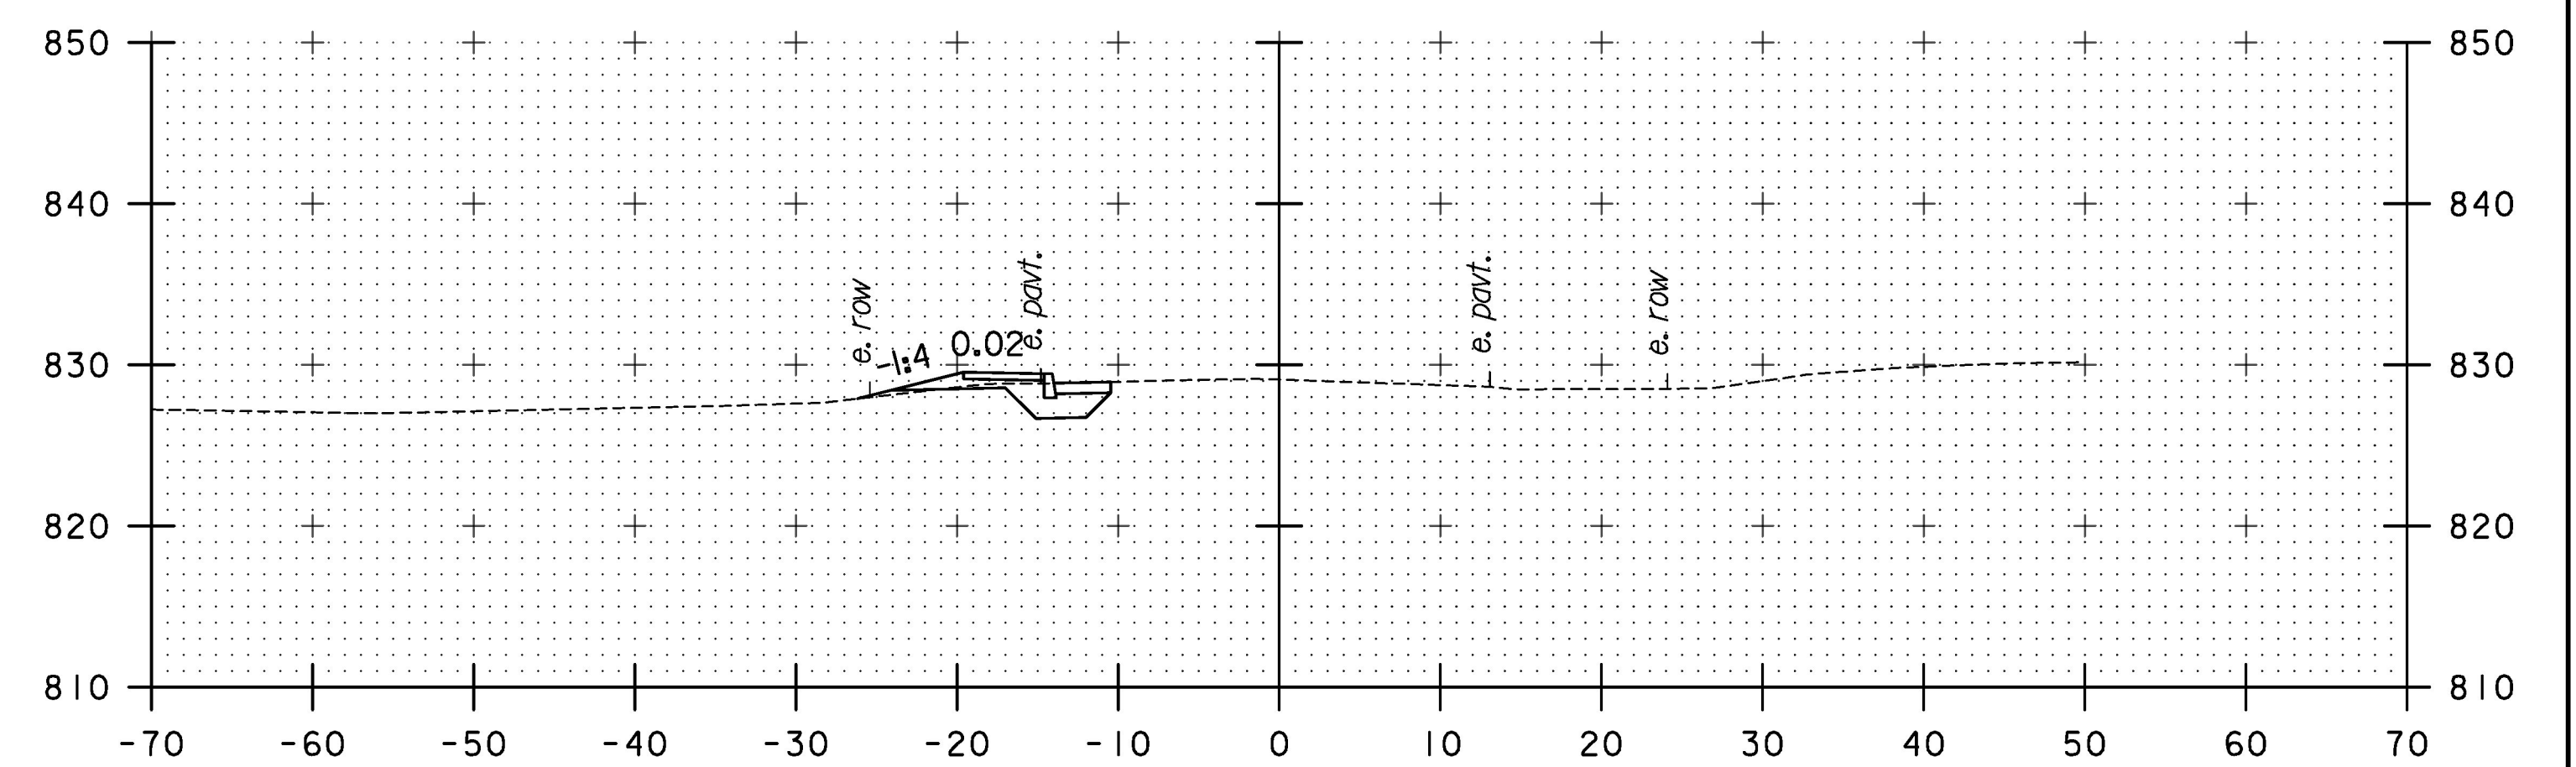

173+75

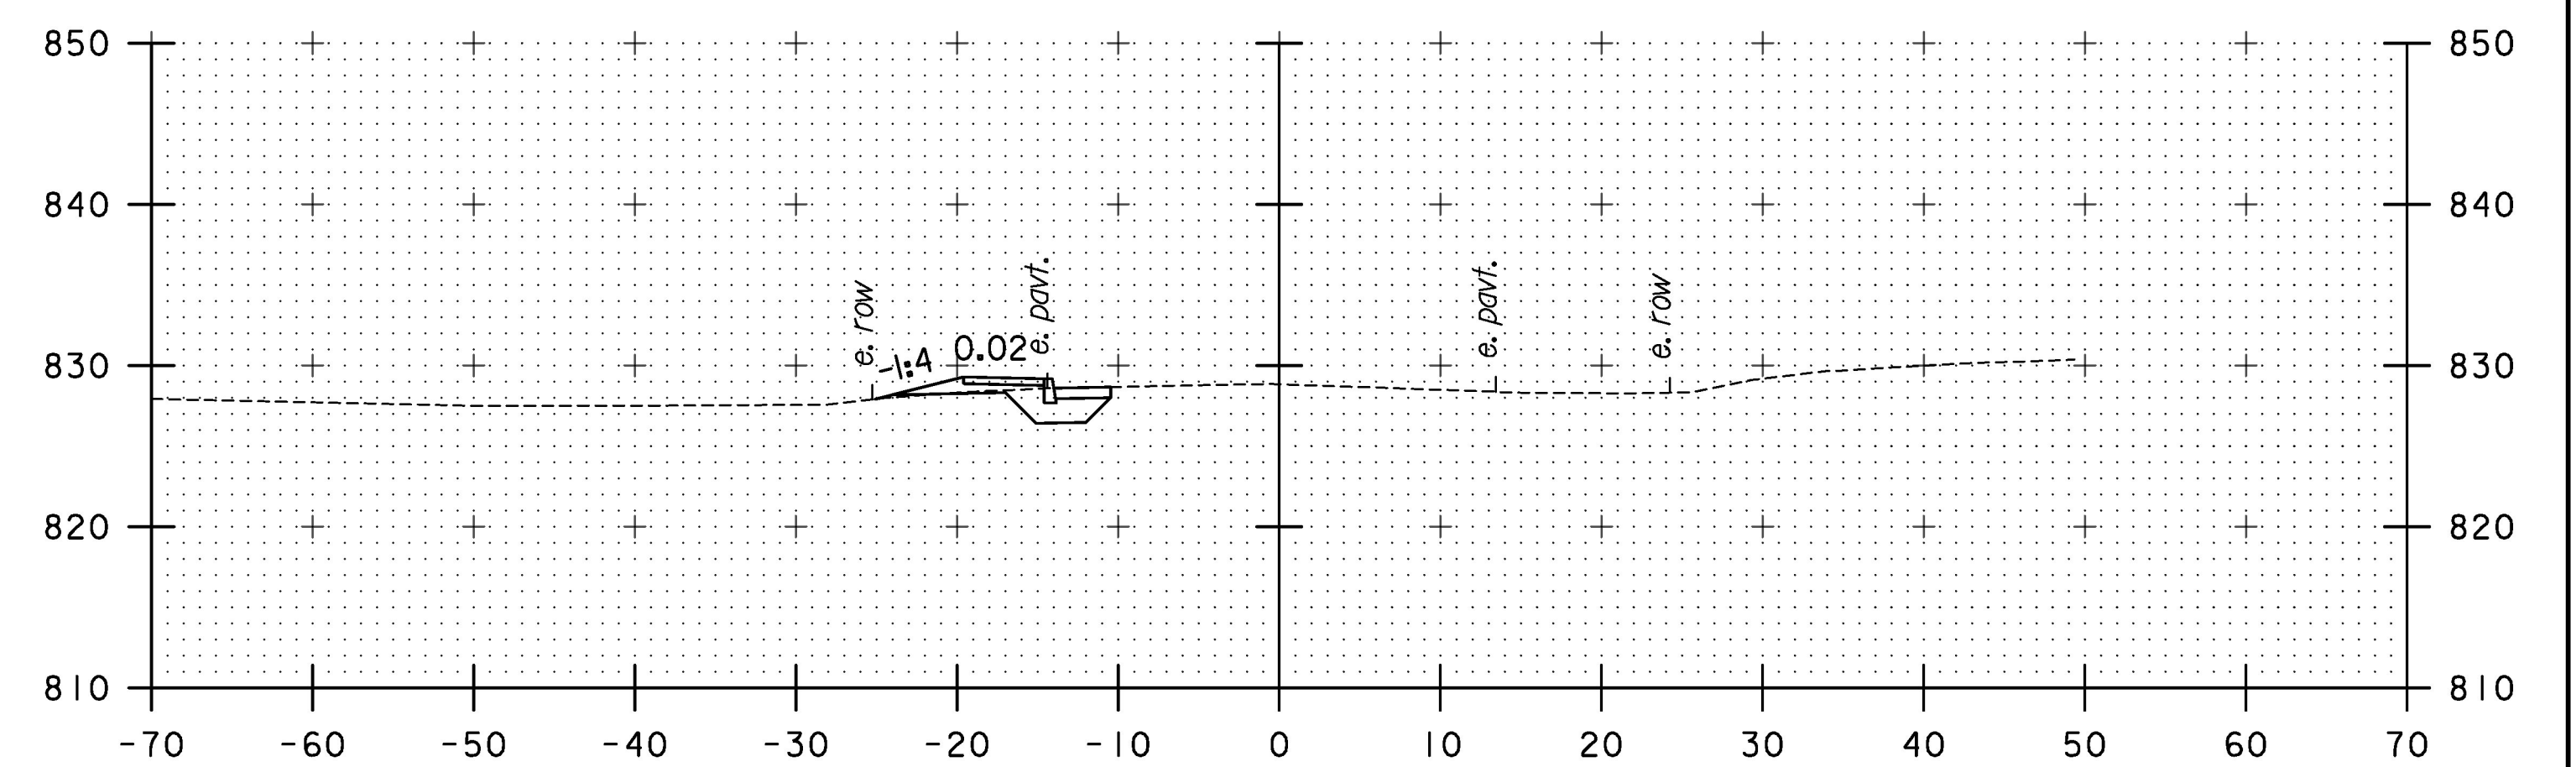

173+50

NOTE: WATER AND SEWER LINES ON THE RIGHT SIDE OF THE ROAD NOT SHOWN THIS SHEET.

STA. 173+00 TO STA. 174+00

TYLIN INTERNATIONAL

PROJECT NAME: CHelsea
PROJECT NUMBER: BHF 0169(10)

FILE NAME: z12ci52xs.dgn
PROJECT LEADER: J. OLUND
DESIGNED BY: T. POULIN
VT 110 CROSS SECTIONS I

PLOT DATE: 8/31/2016
DRAWN BY: T. POULIN
CHECKED BY: J. OLUND
SHEET 121 OF 137