




174+75

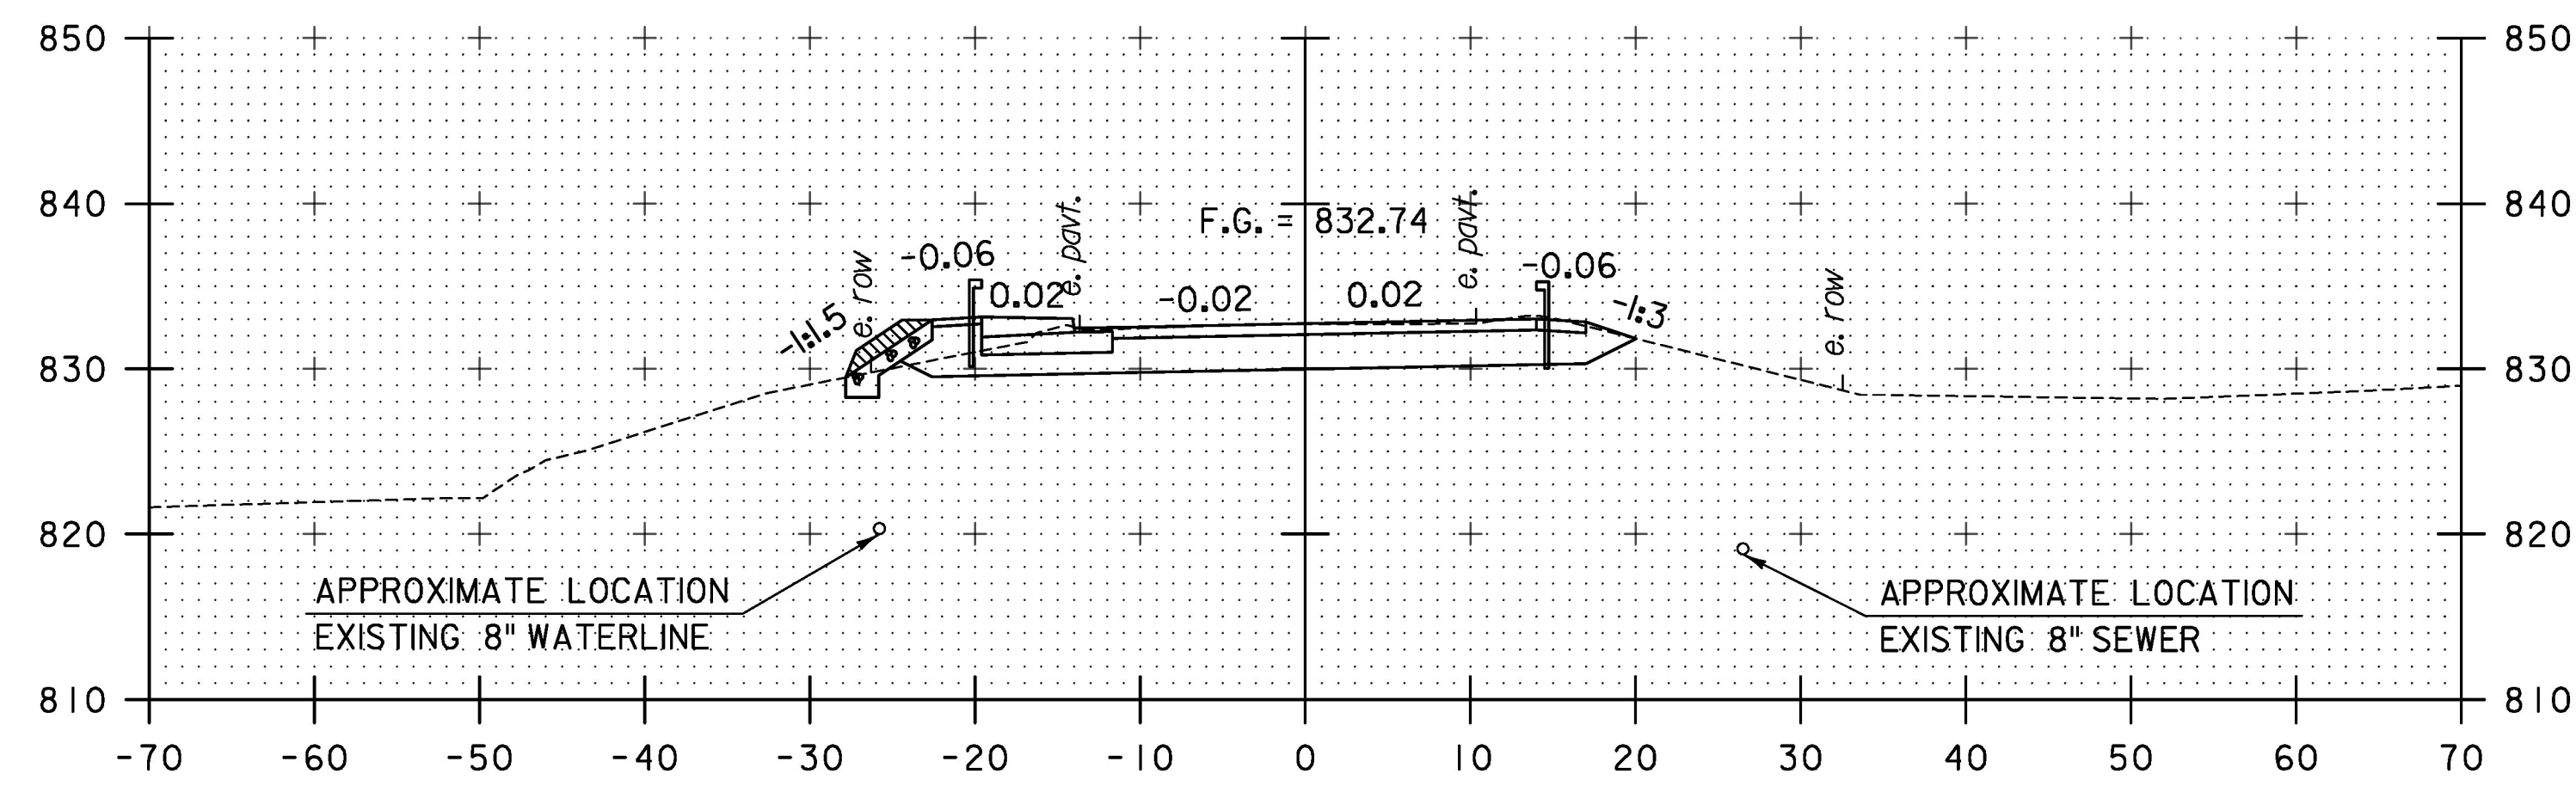


175+50

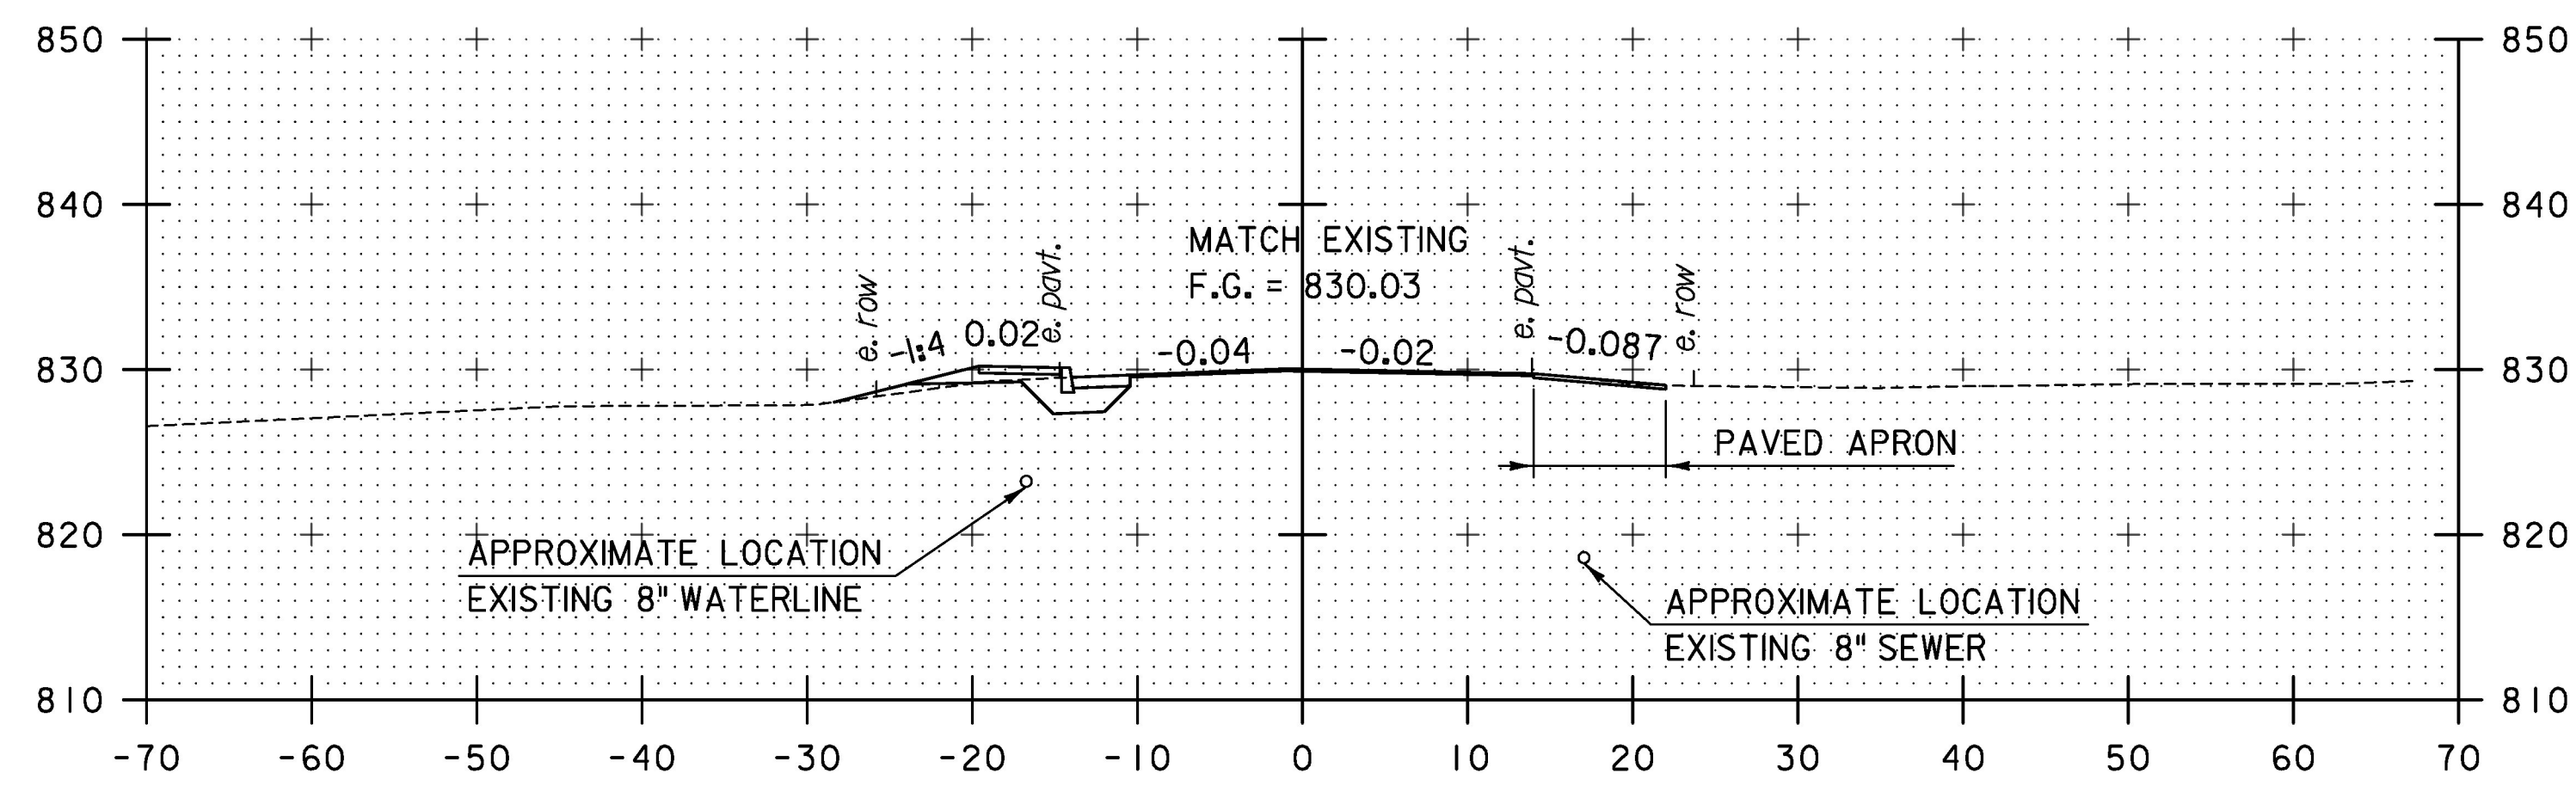


174+50
BEGIN APPROACH

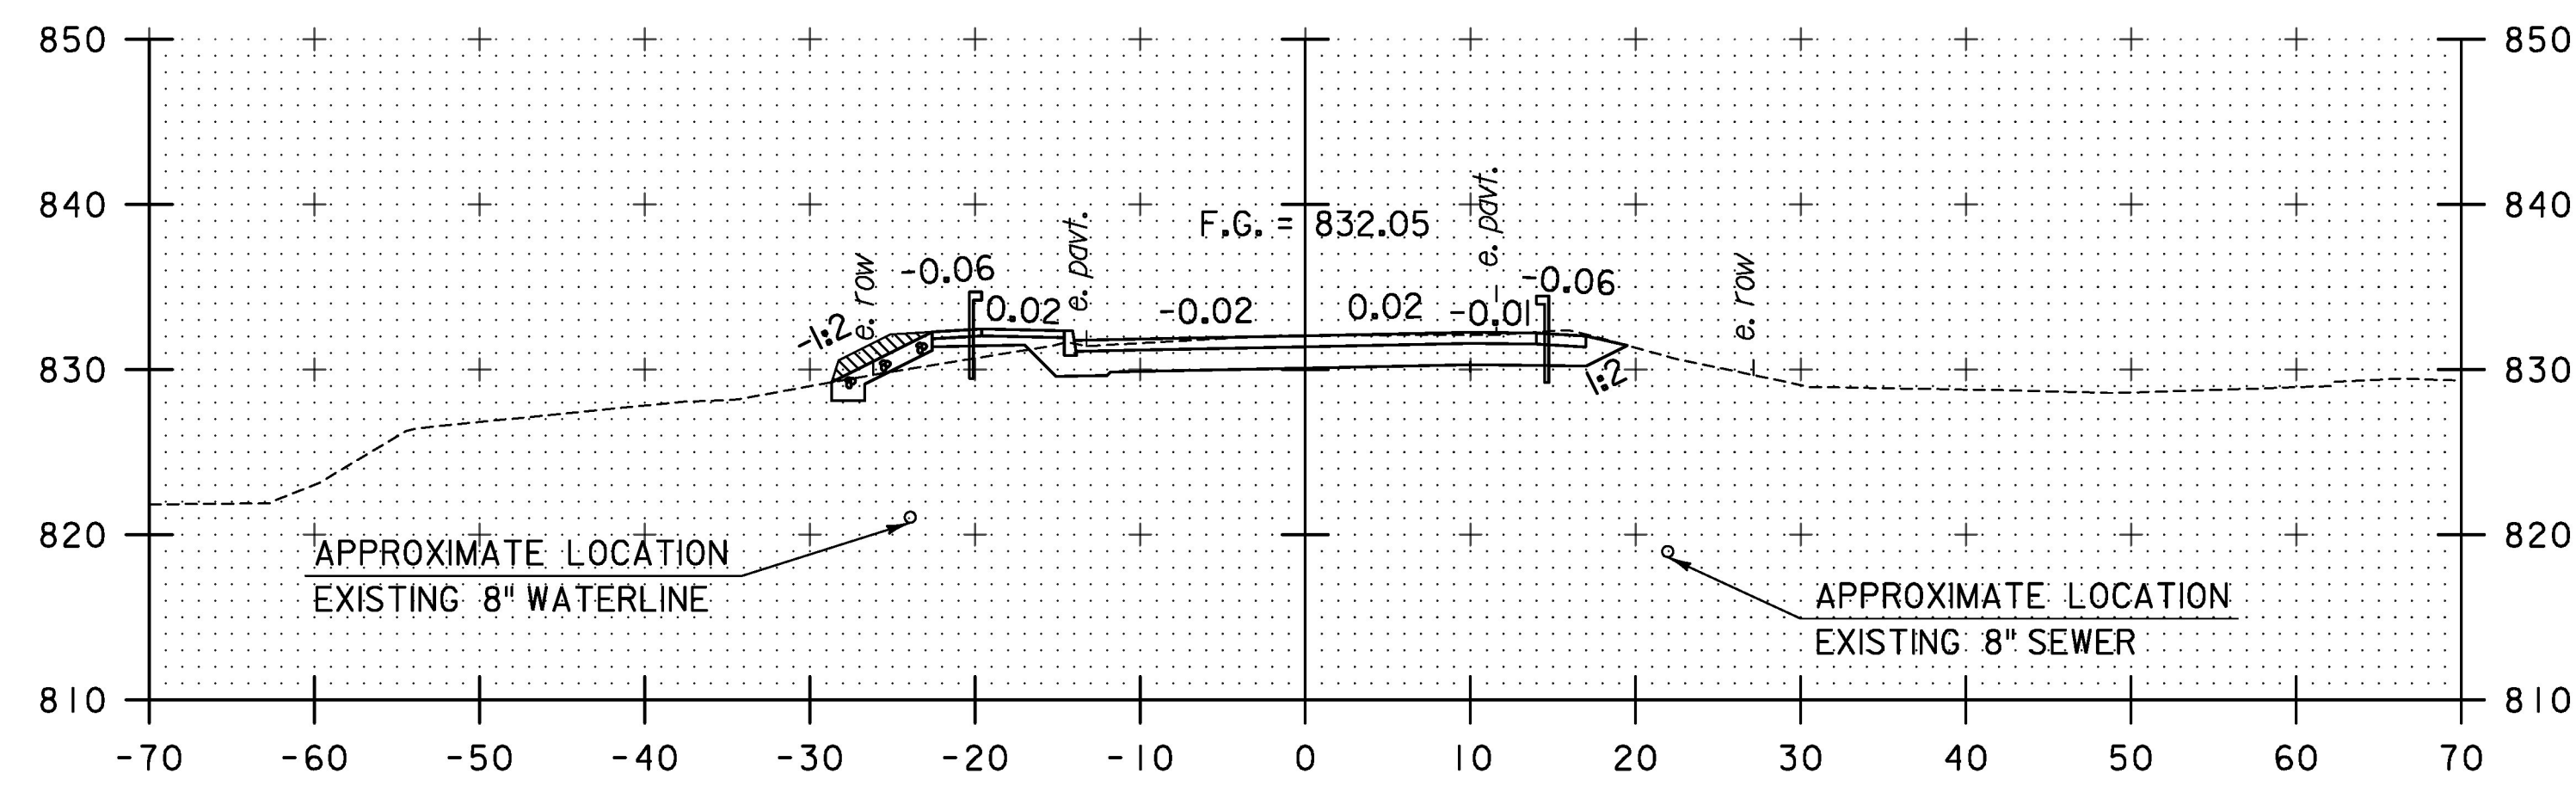

175+25

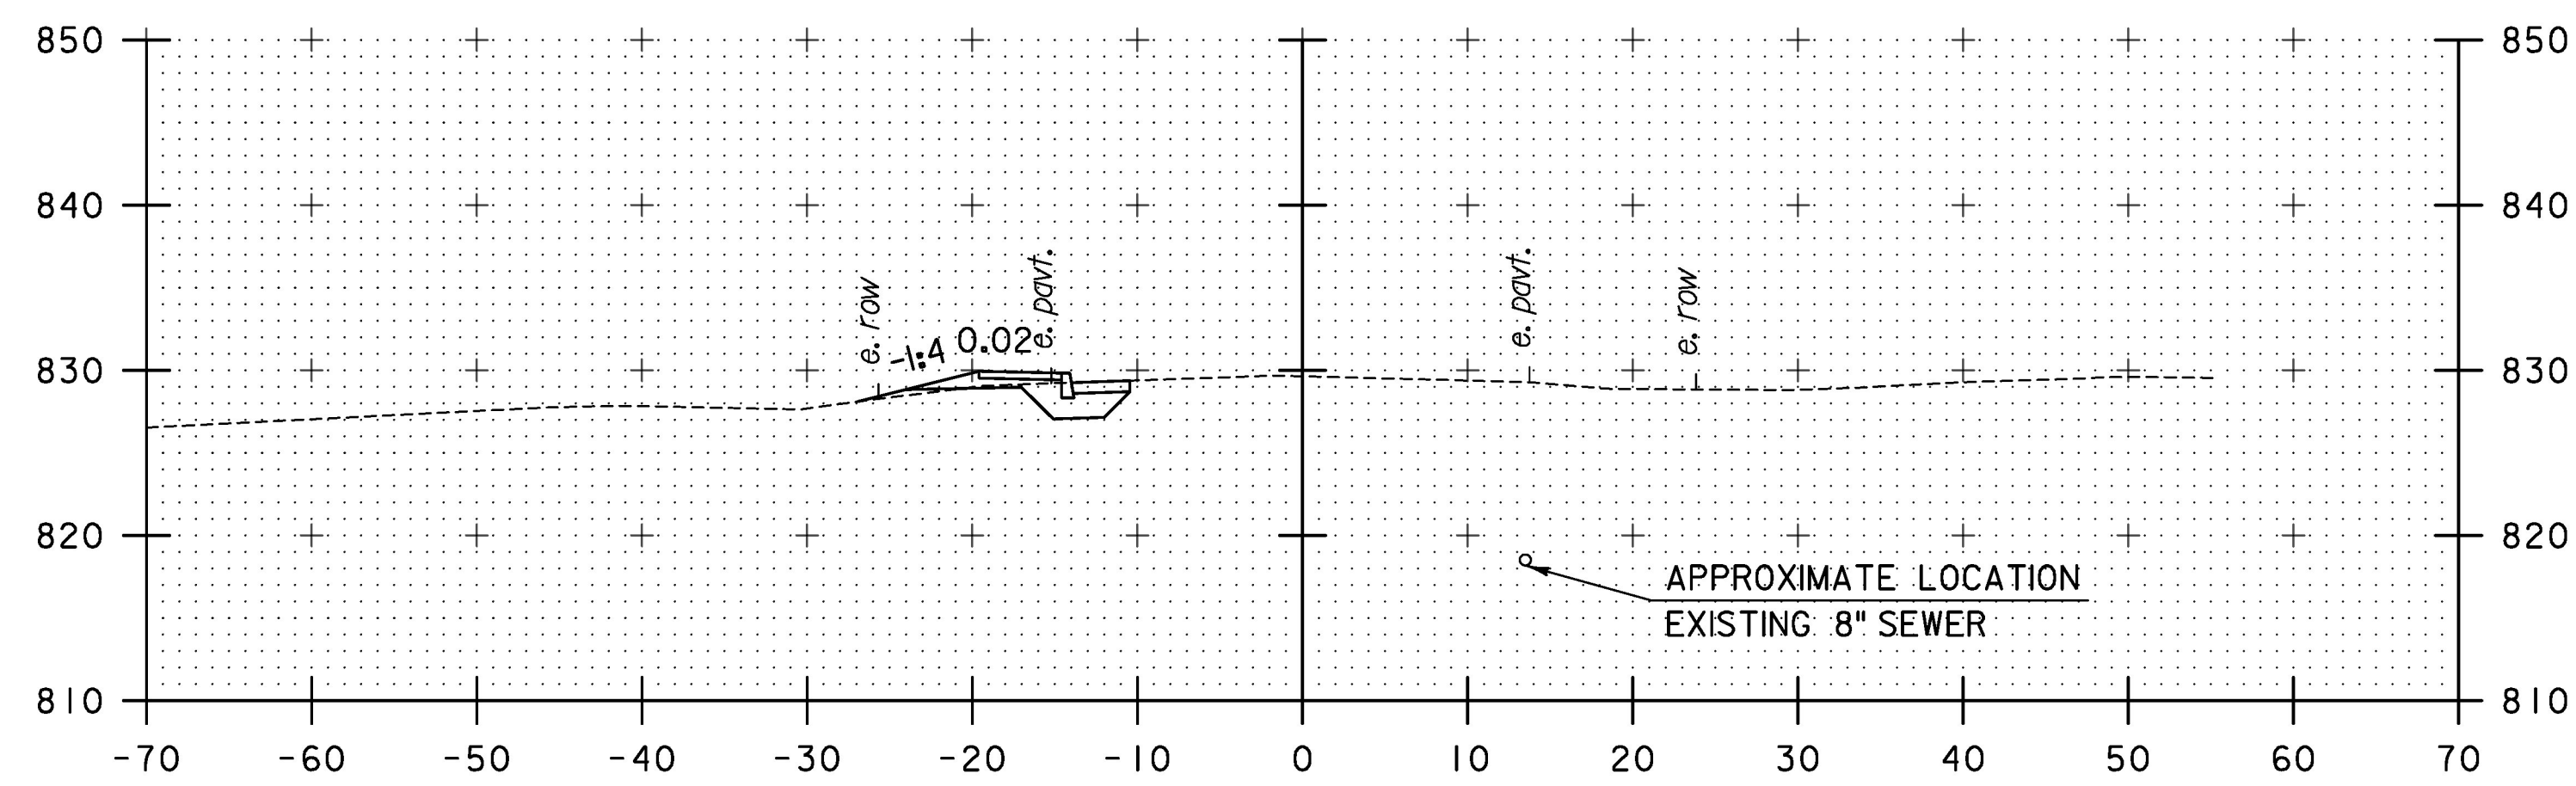

174+25

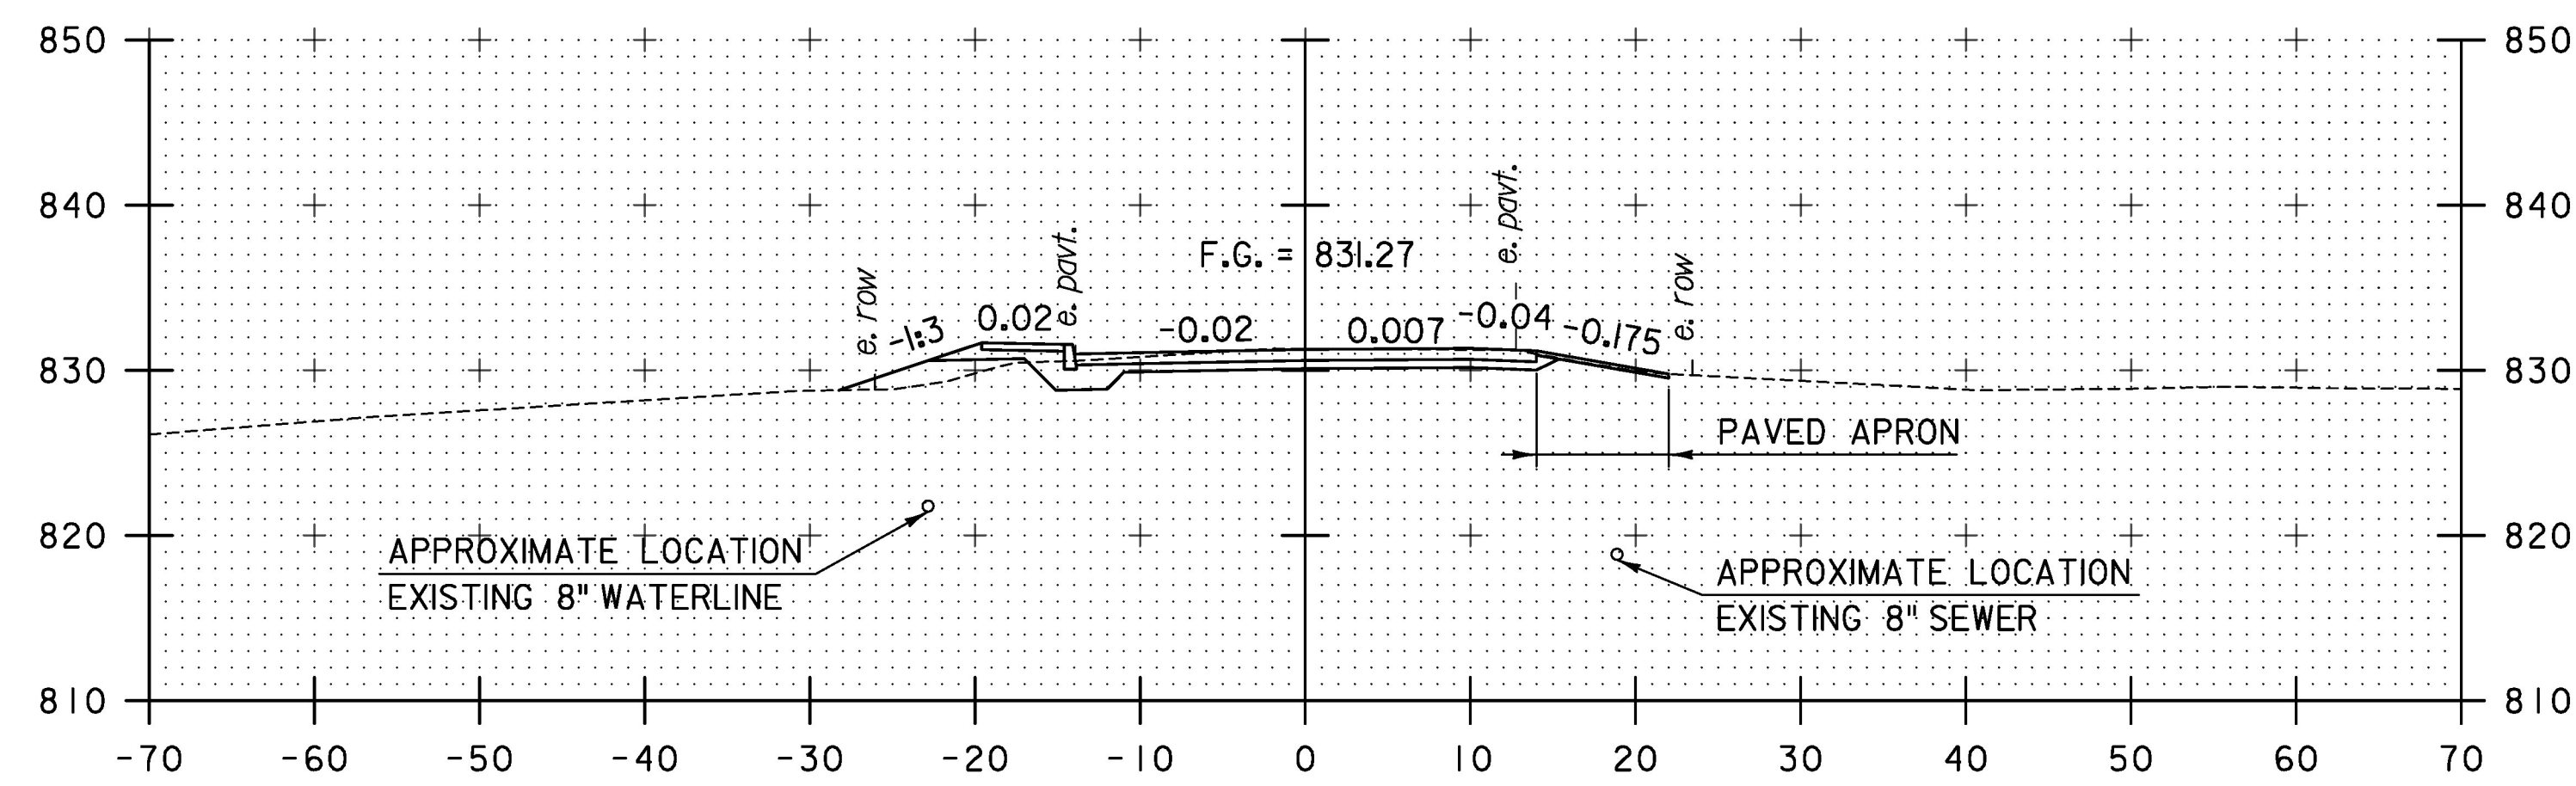

175+00
BEGIN PROJECT

STA. 174+25 TO STA. 175+50

TYLIN INTERNATIONAL	PROJECT NAME: CHelsea	PLOT DATE: 8/31/2016
	PROJECT NUMBER: BHF 0169(10)	DRAWN BY: T. POULIN
	FILE NAME: z12ci52xs.dgn	CHECKED BY: J. OLUND
	PROJECT LEADER: J. OLUND	SHEET 122 OF 137
	DESIGNED BY: T. POULIN	
	VT 110 CROSS SECTIONS 2	