




50+25

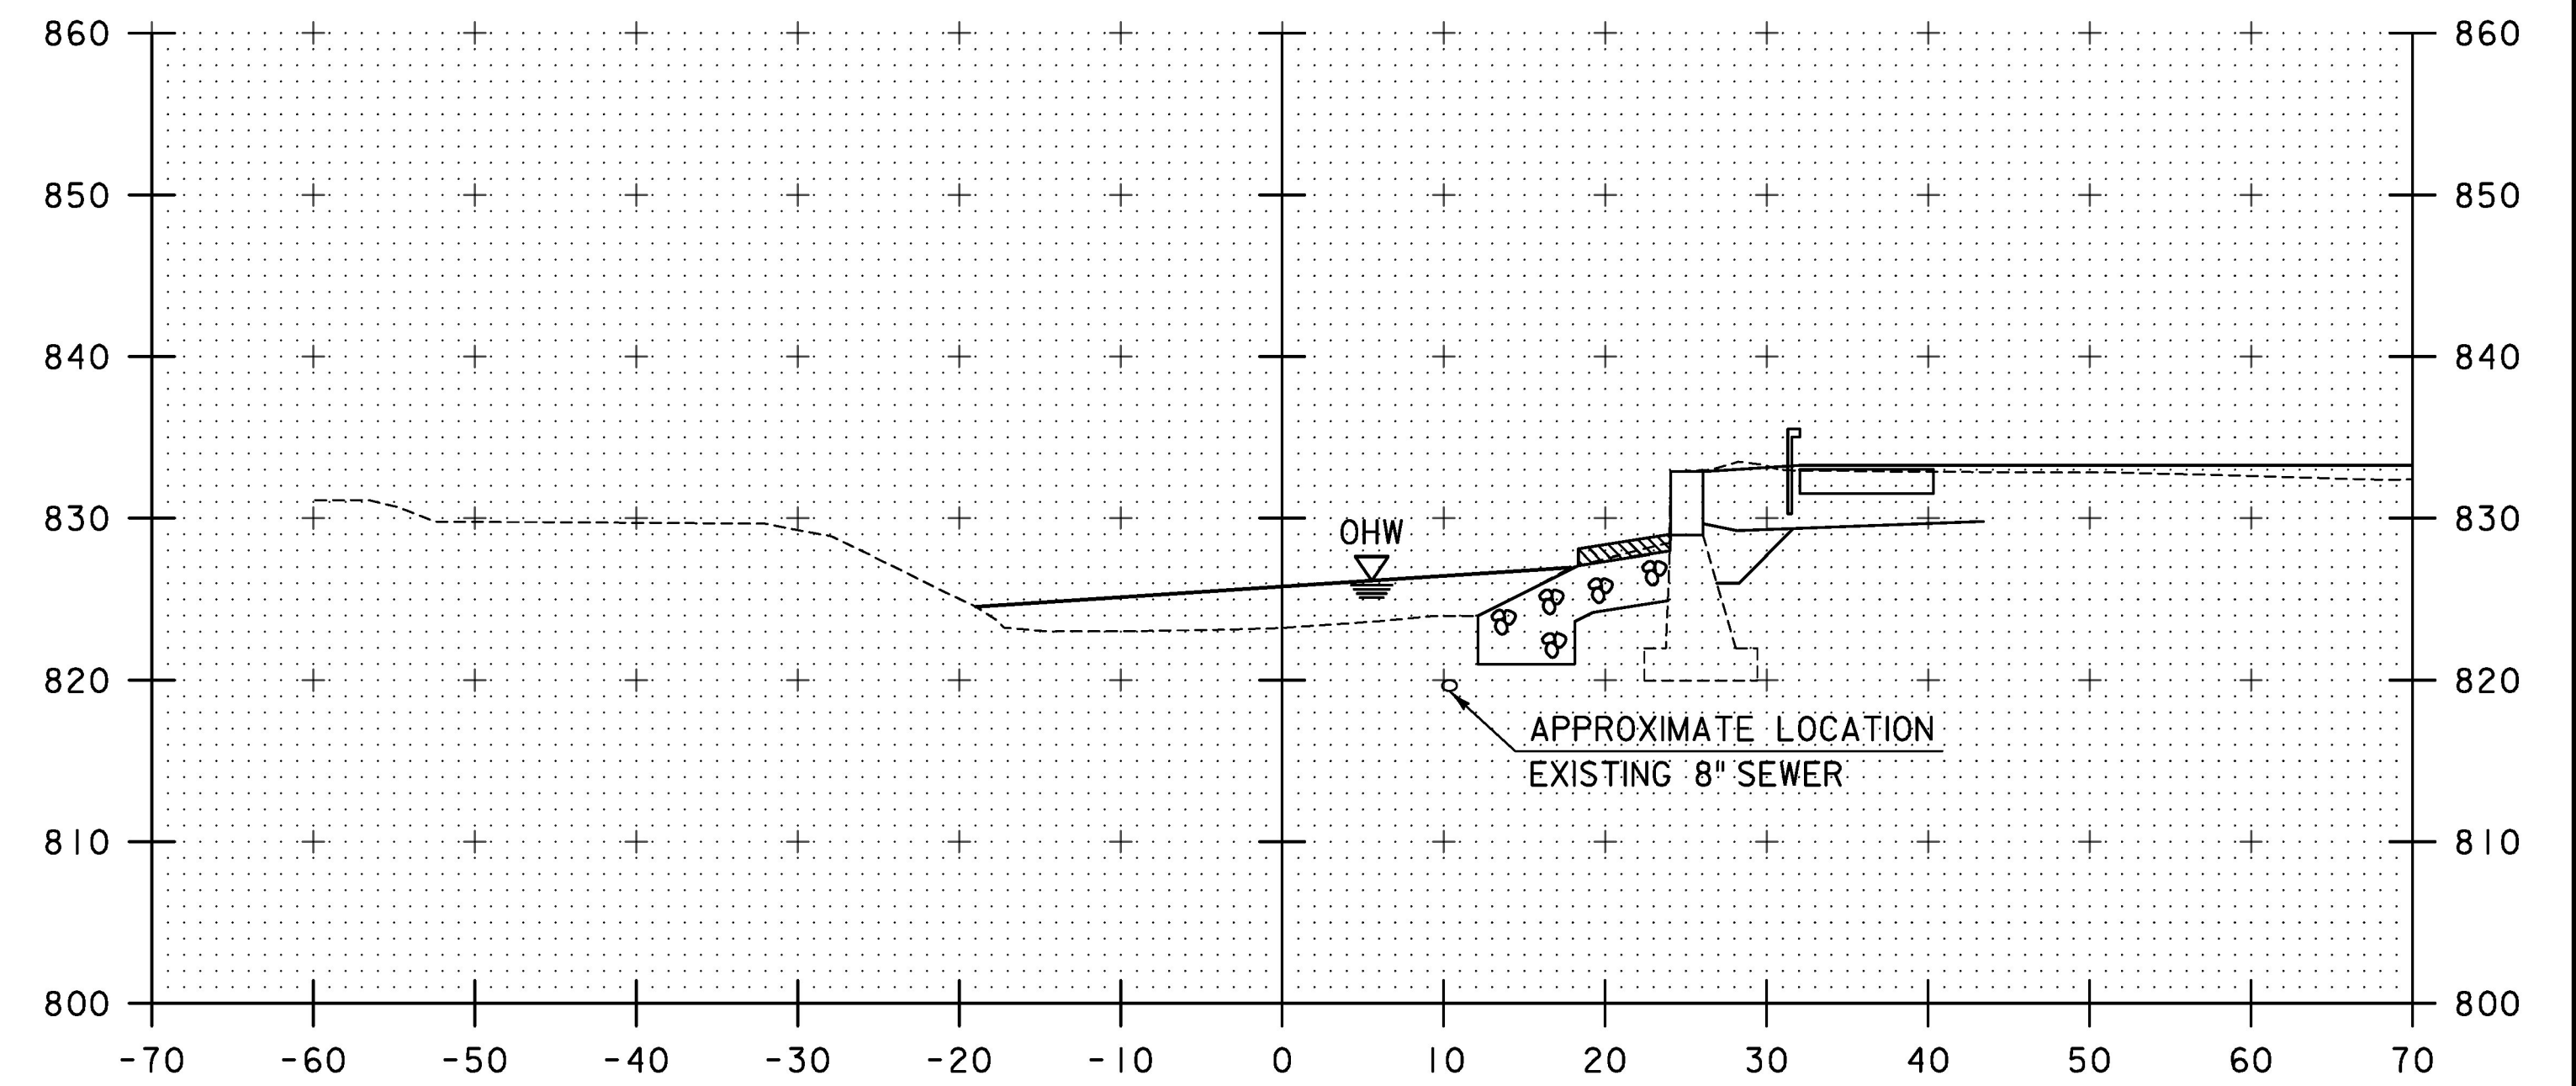

50+40

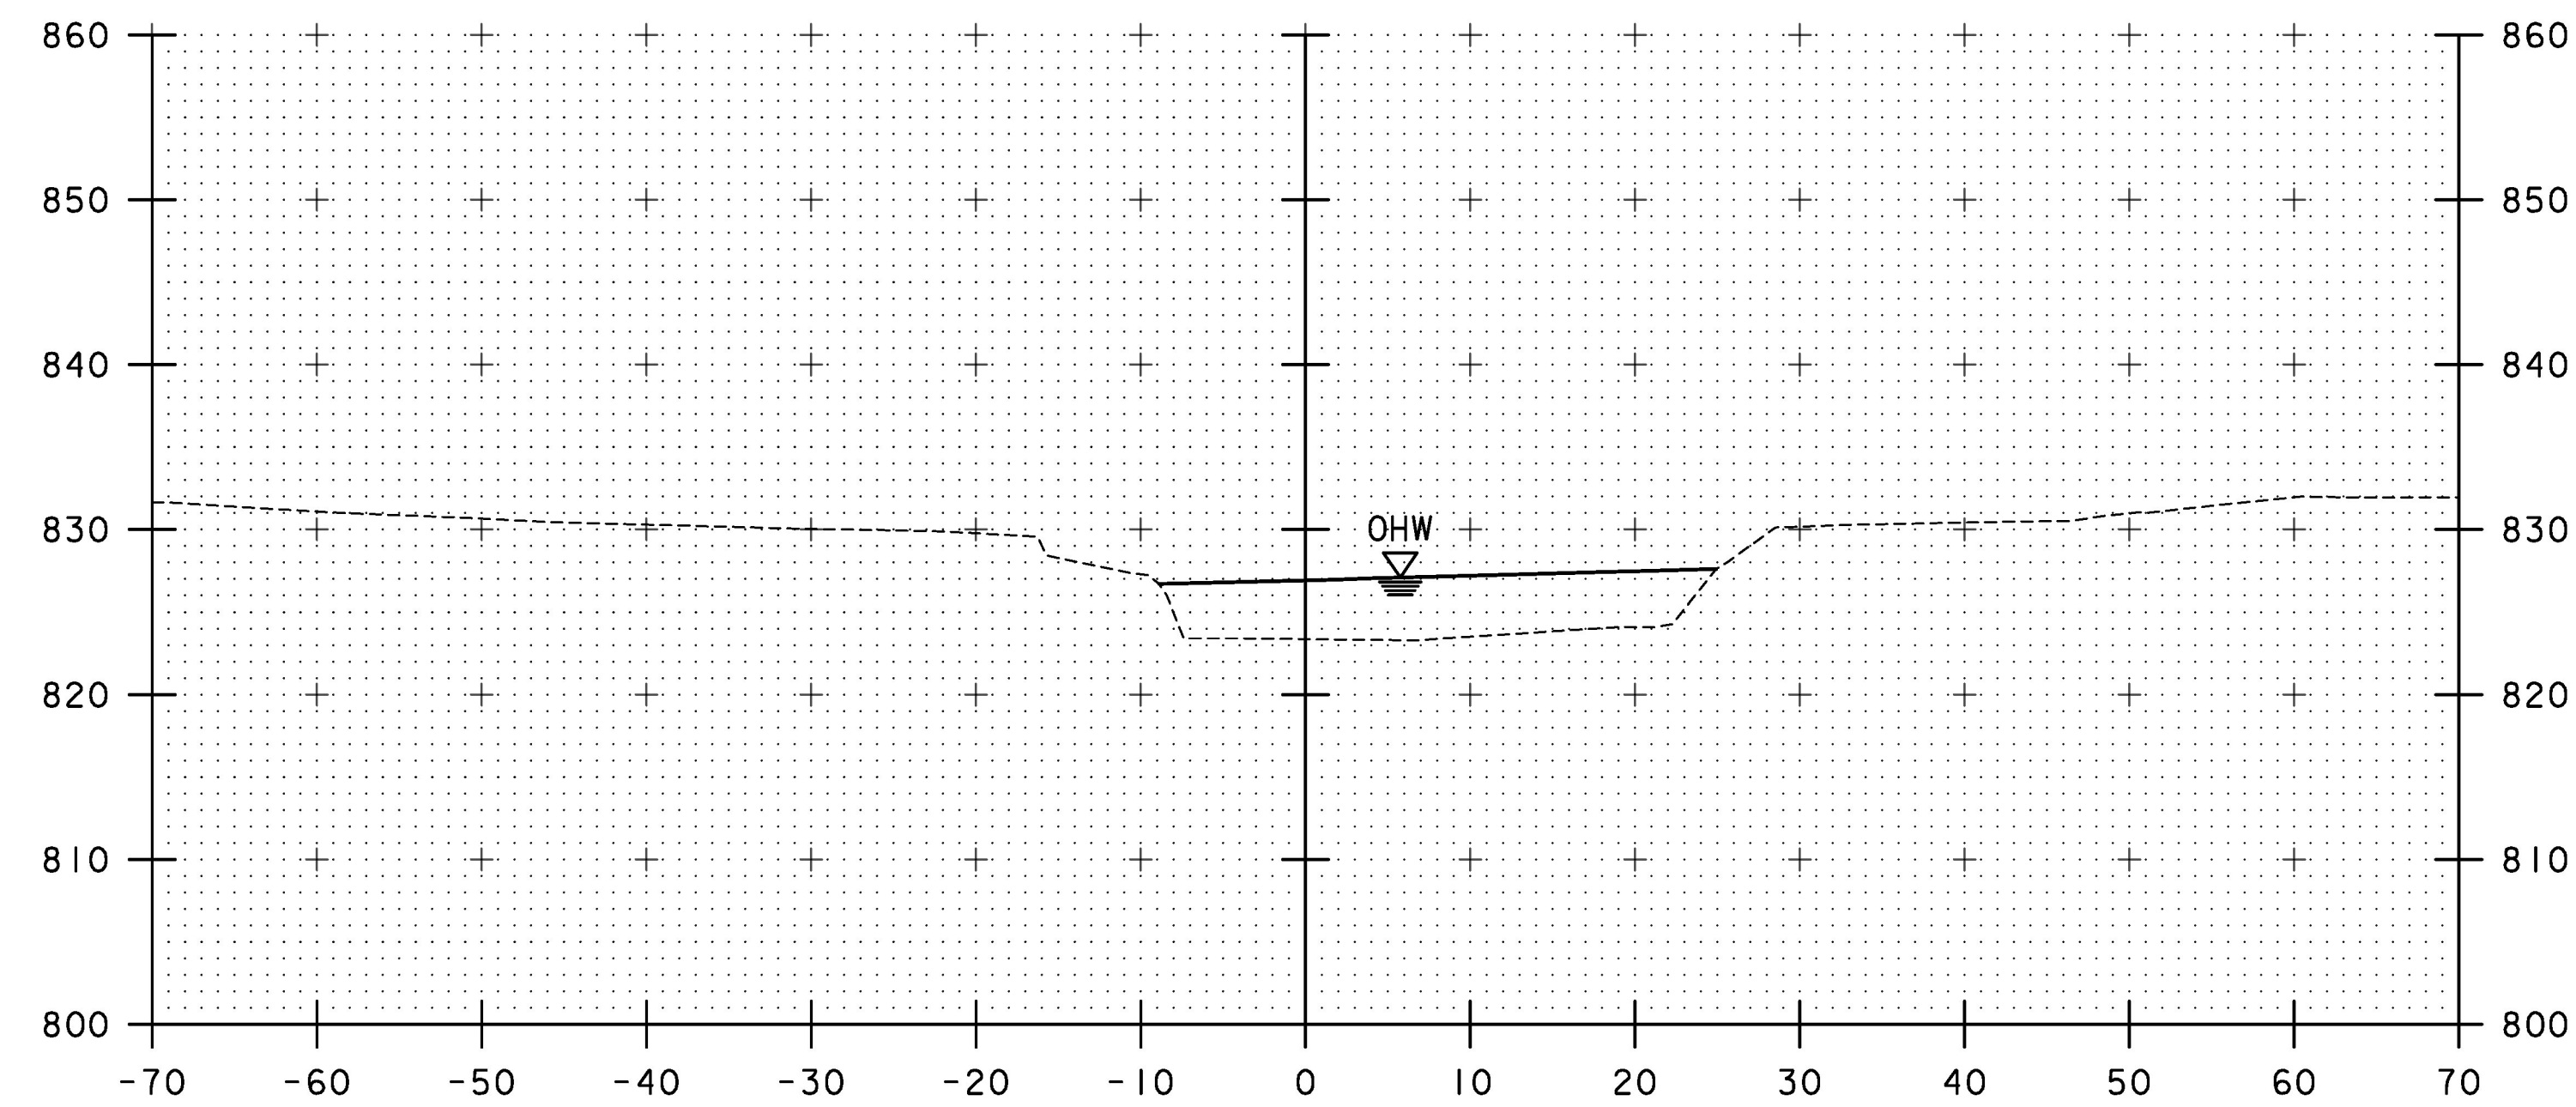

50+00

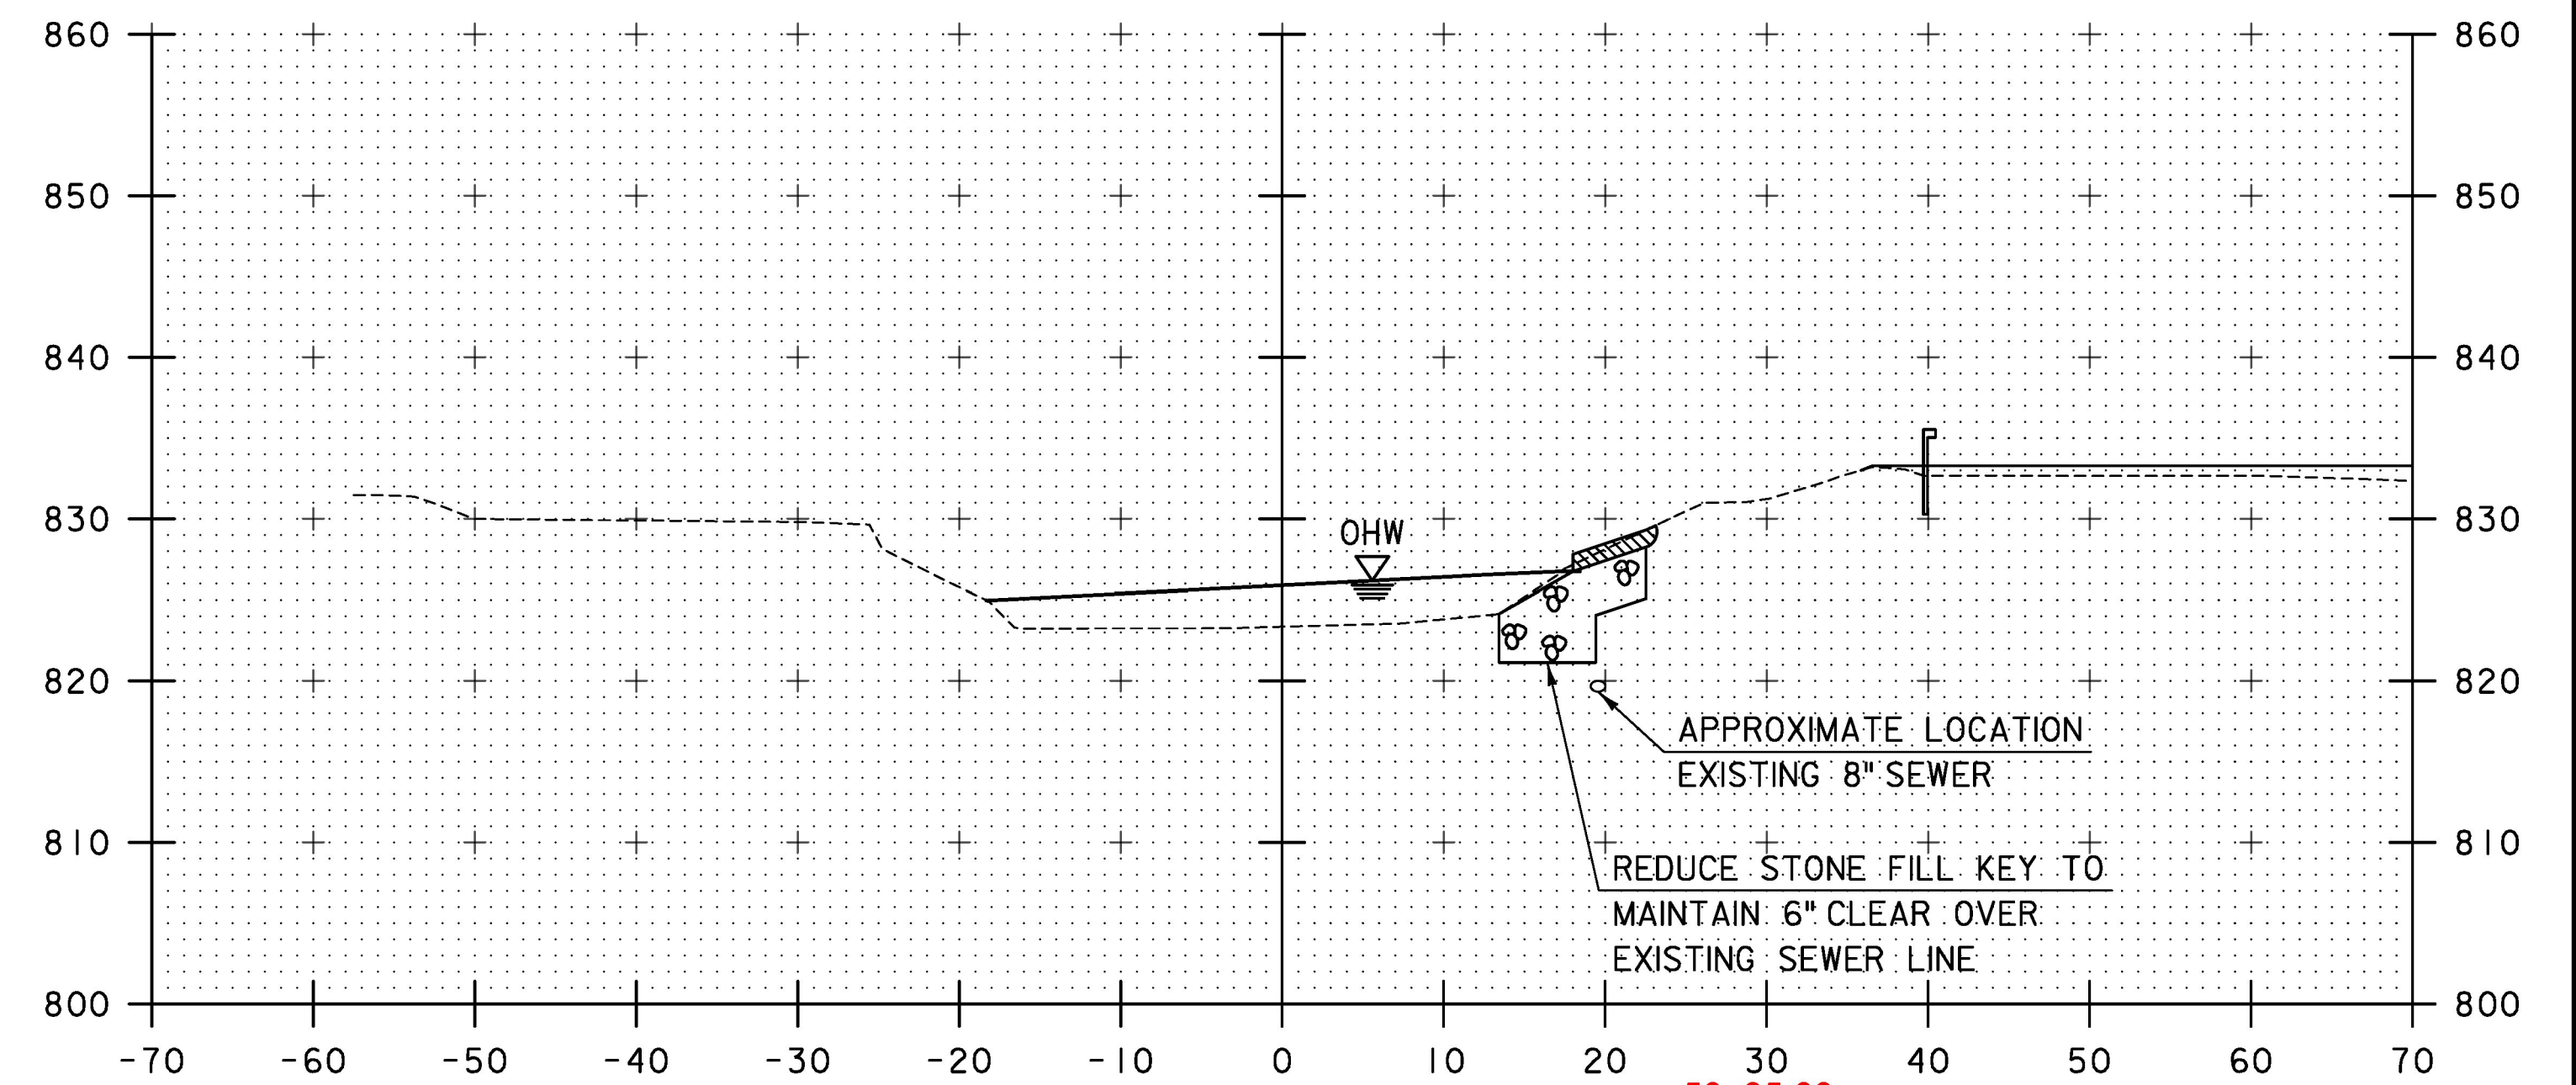

50+30

50+35.00
 STA 50+28.37, RT
 BEGIN UNCLASSIFIED CHANNEL EXCAVATION
 BEGIN GEOTEXTILE UNDER STONE FILL, TYPE III
 BEGIN STONE FILL, TYPE III
 BEGIN GRUBBING MATERIAL

STA. 50+00 TO STA. 50+40

TYLININTERNATIONAL

PROJECT NAME:	CHelsea	PLOT DATE:	8/31/2016
PROJECT NUMBER:	BHF 0169(10)	DRAWN BY:	T. POULIN
FILE NAME:	z12ci52xschnl.dgn	CHECKED BY:	J. OLUND
PROJECT LEADER:	J. OLUND	SHEET	125 OF 137
DESIGNED BY:	T. POULIN		
CHANNEL SECTIONS I			