



51+00

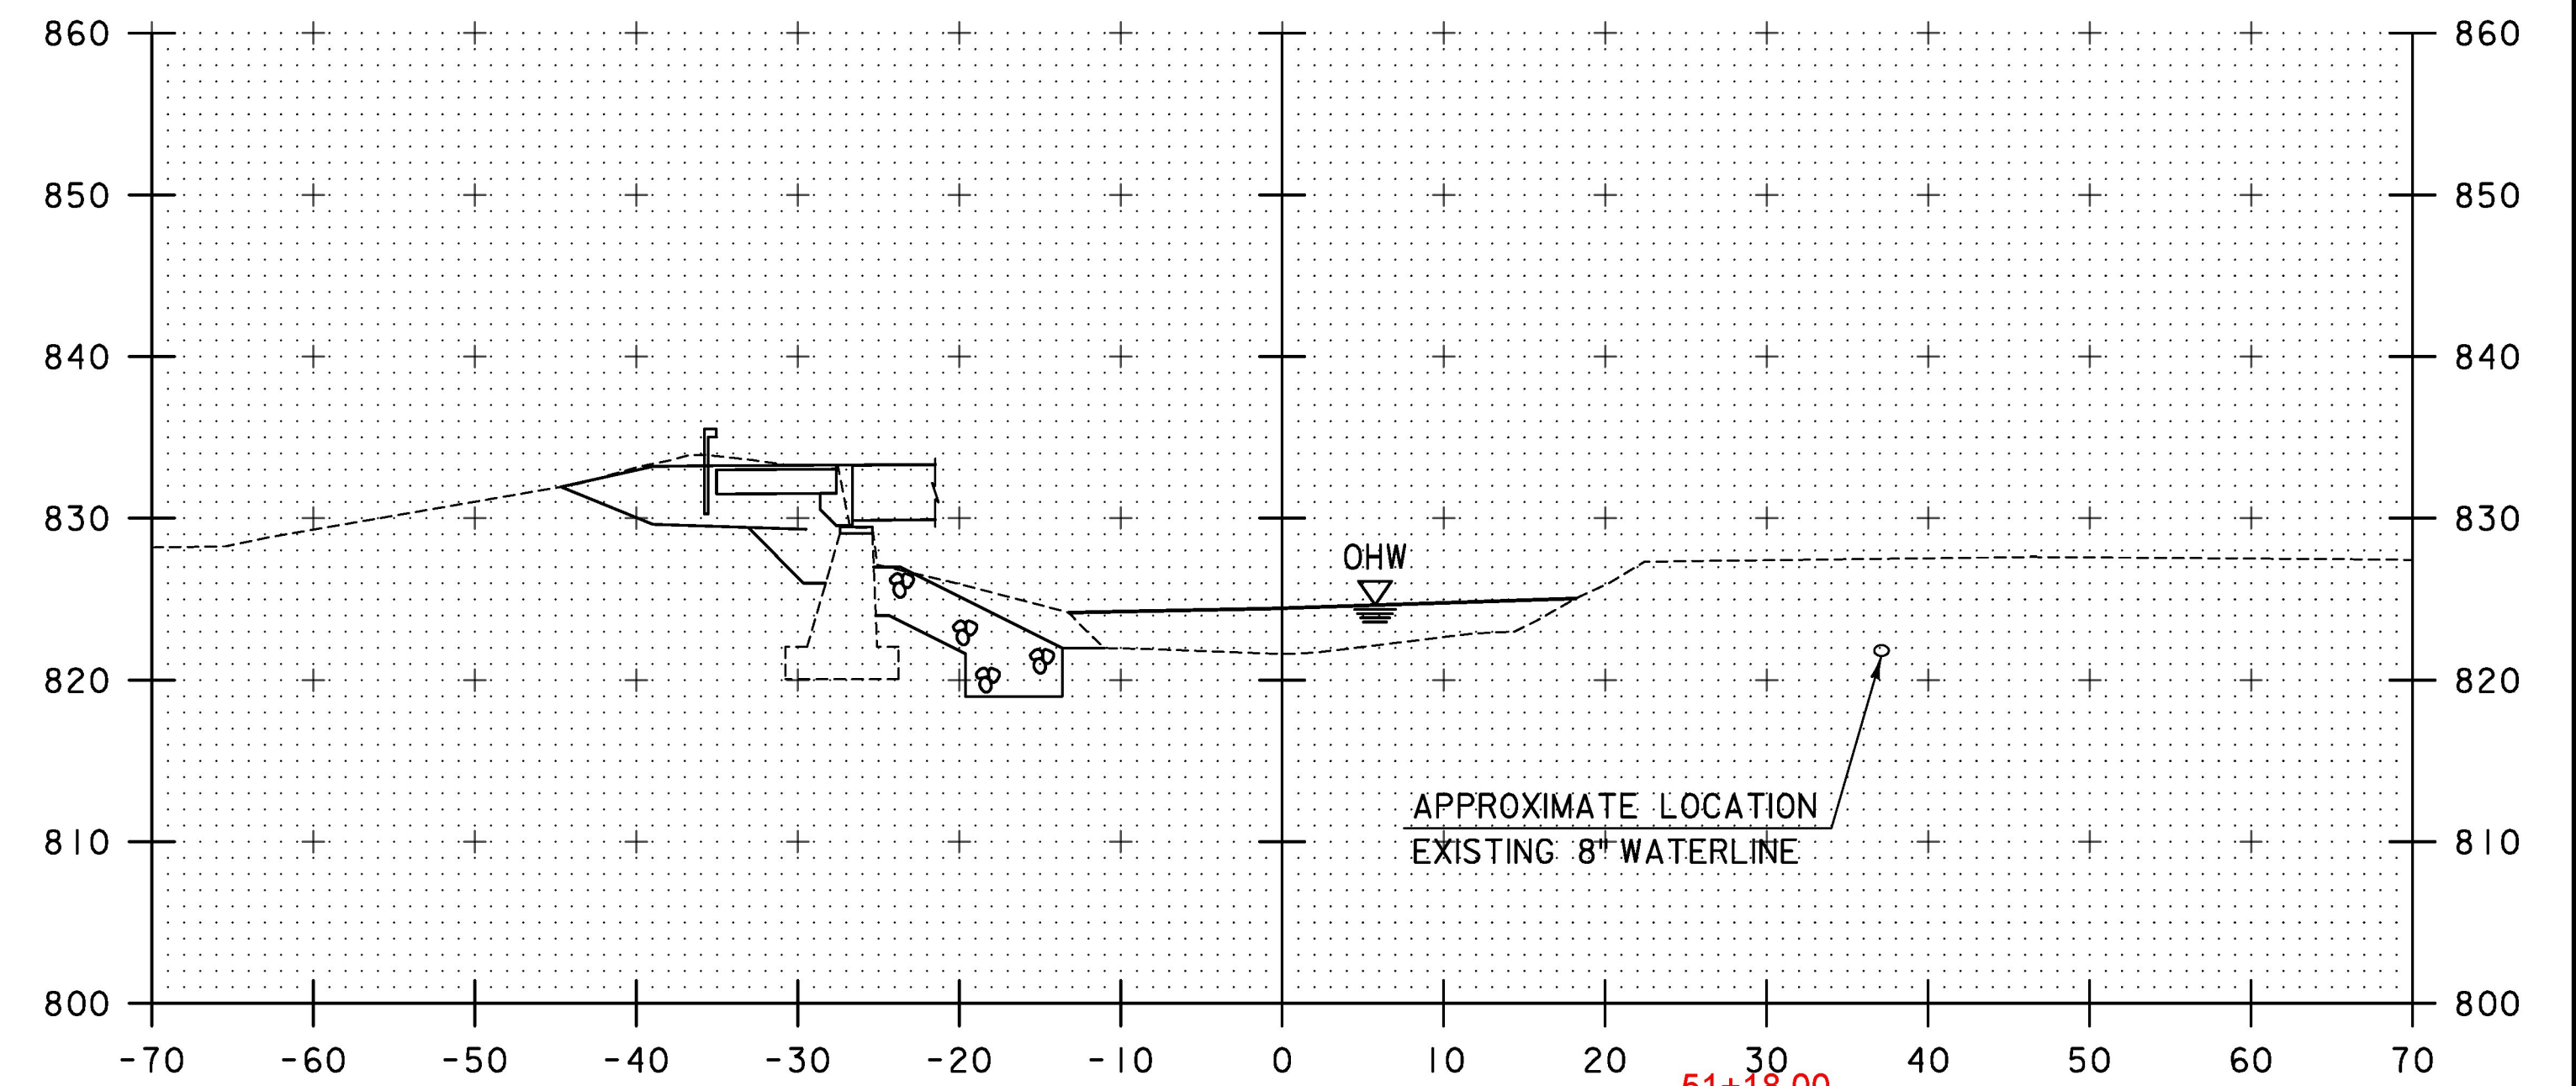


51+20

51+18.00
 STA 51+13.39, RT
 END UNCLASSIFIED CHANNEL EXCAVATION
 END GEOTEXTILE UNDER STONE FILL, TYPE III
 END STONE FILL, TYPE III
 END GRUBBING MATERIAL

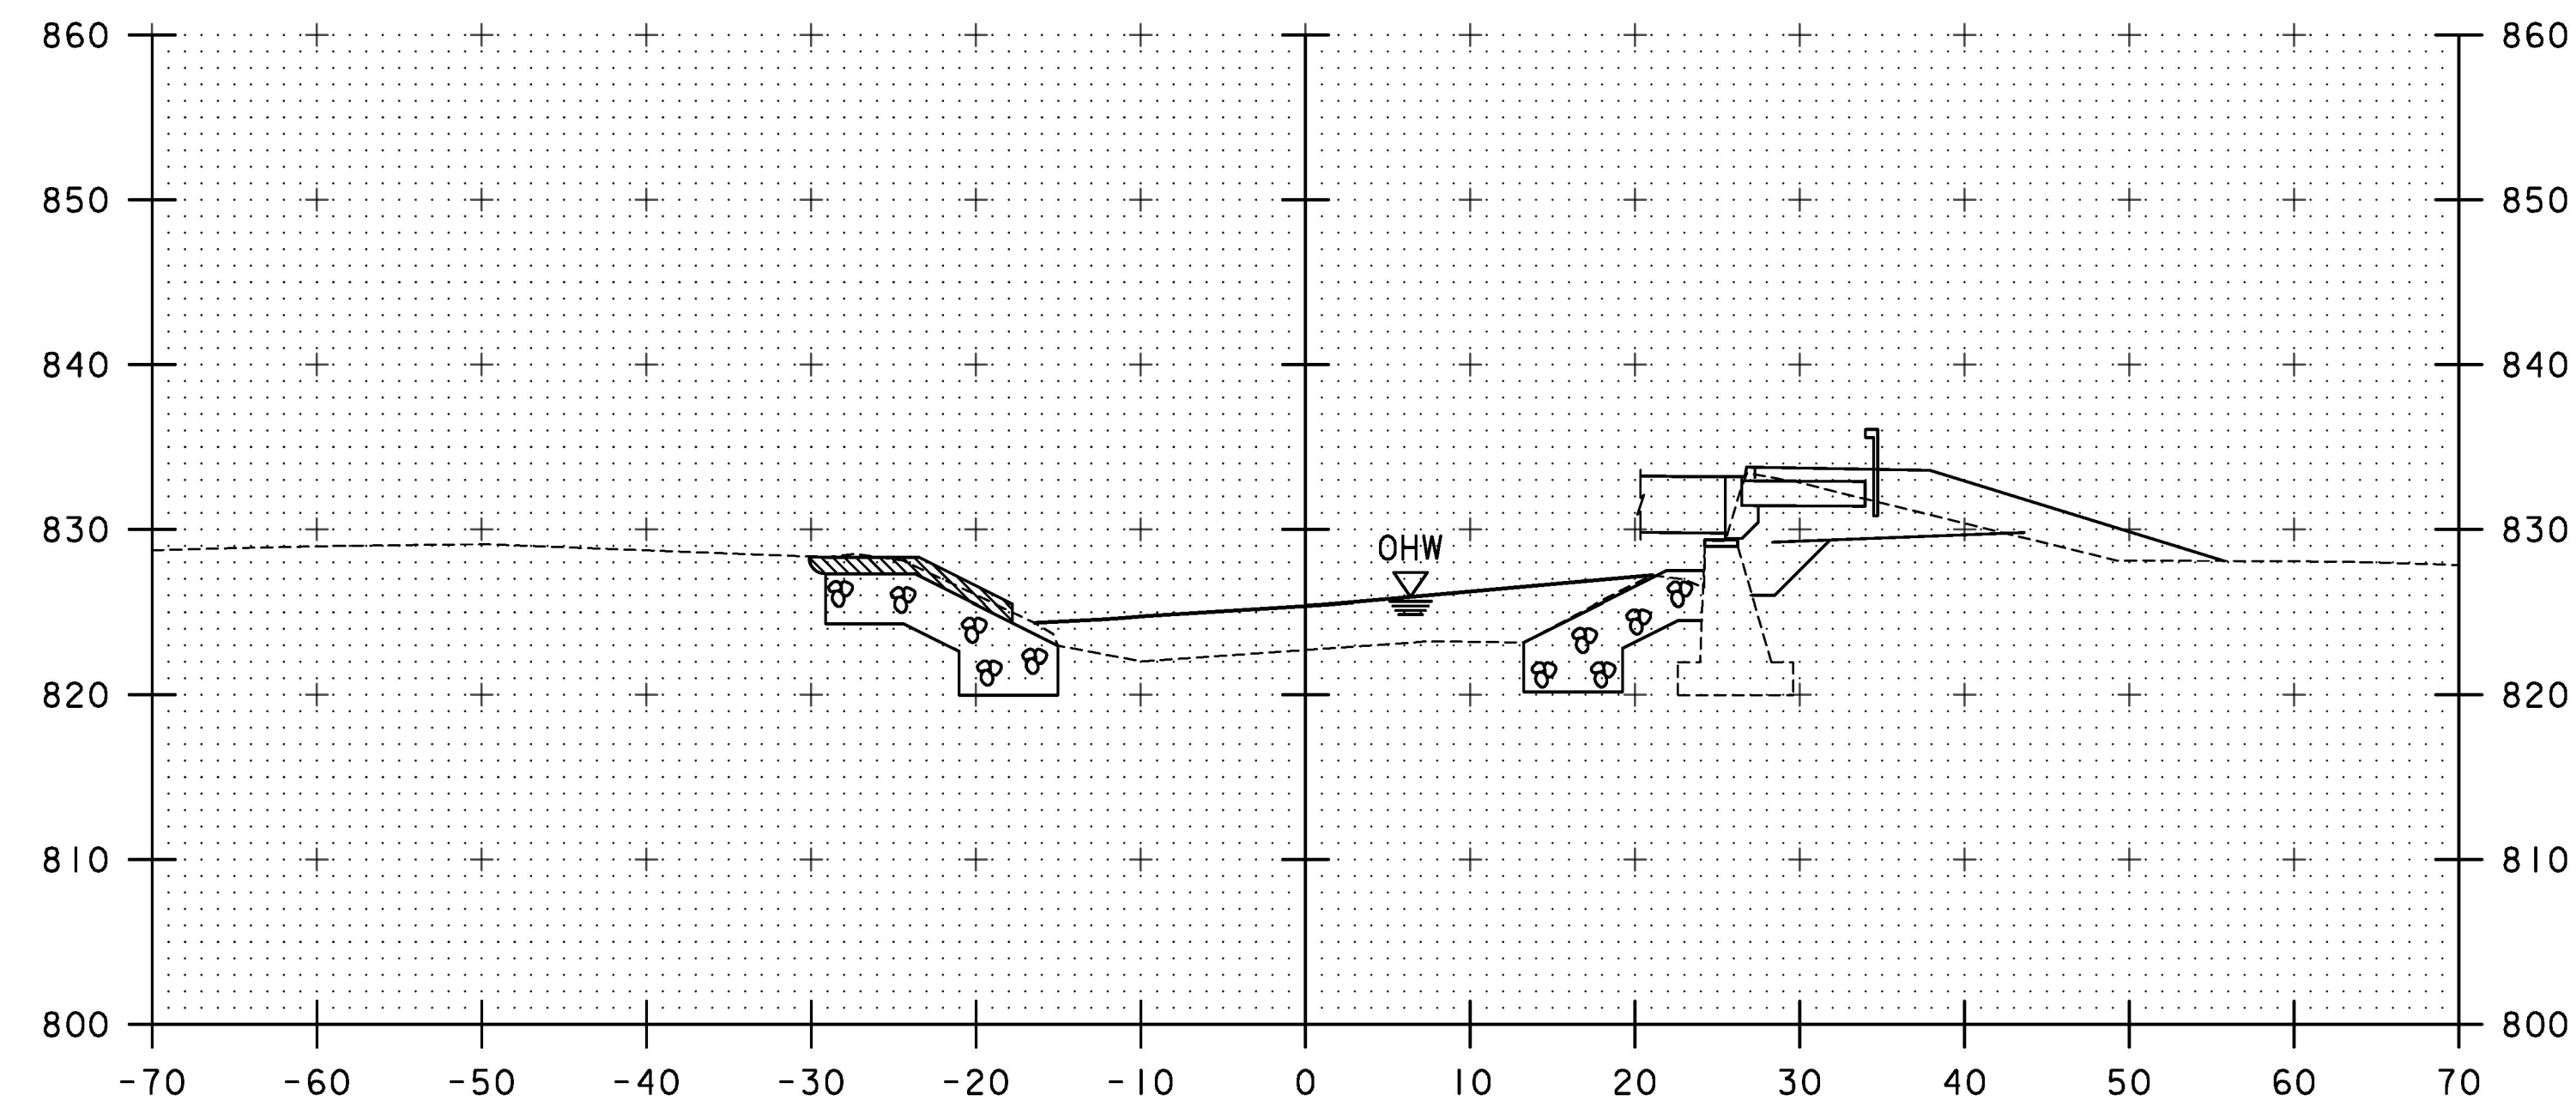

50+90

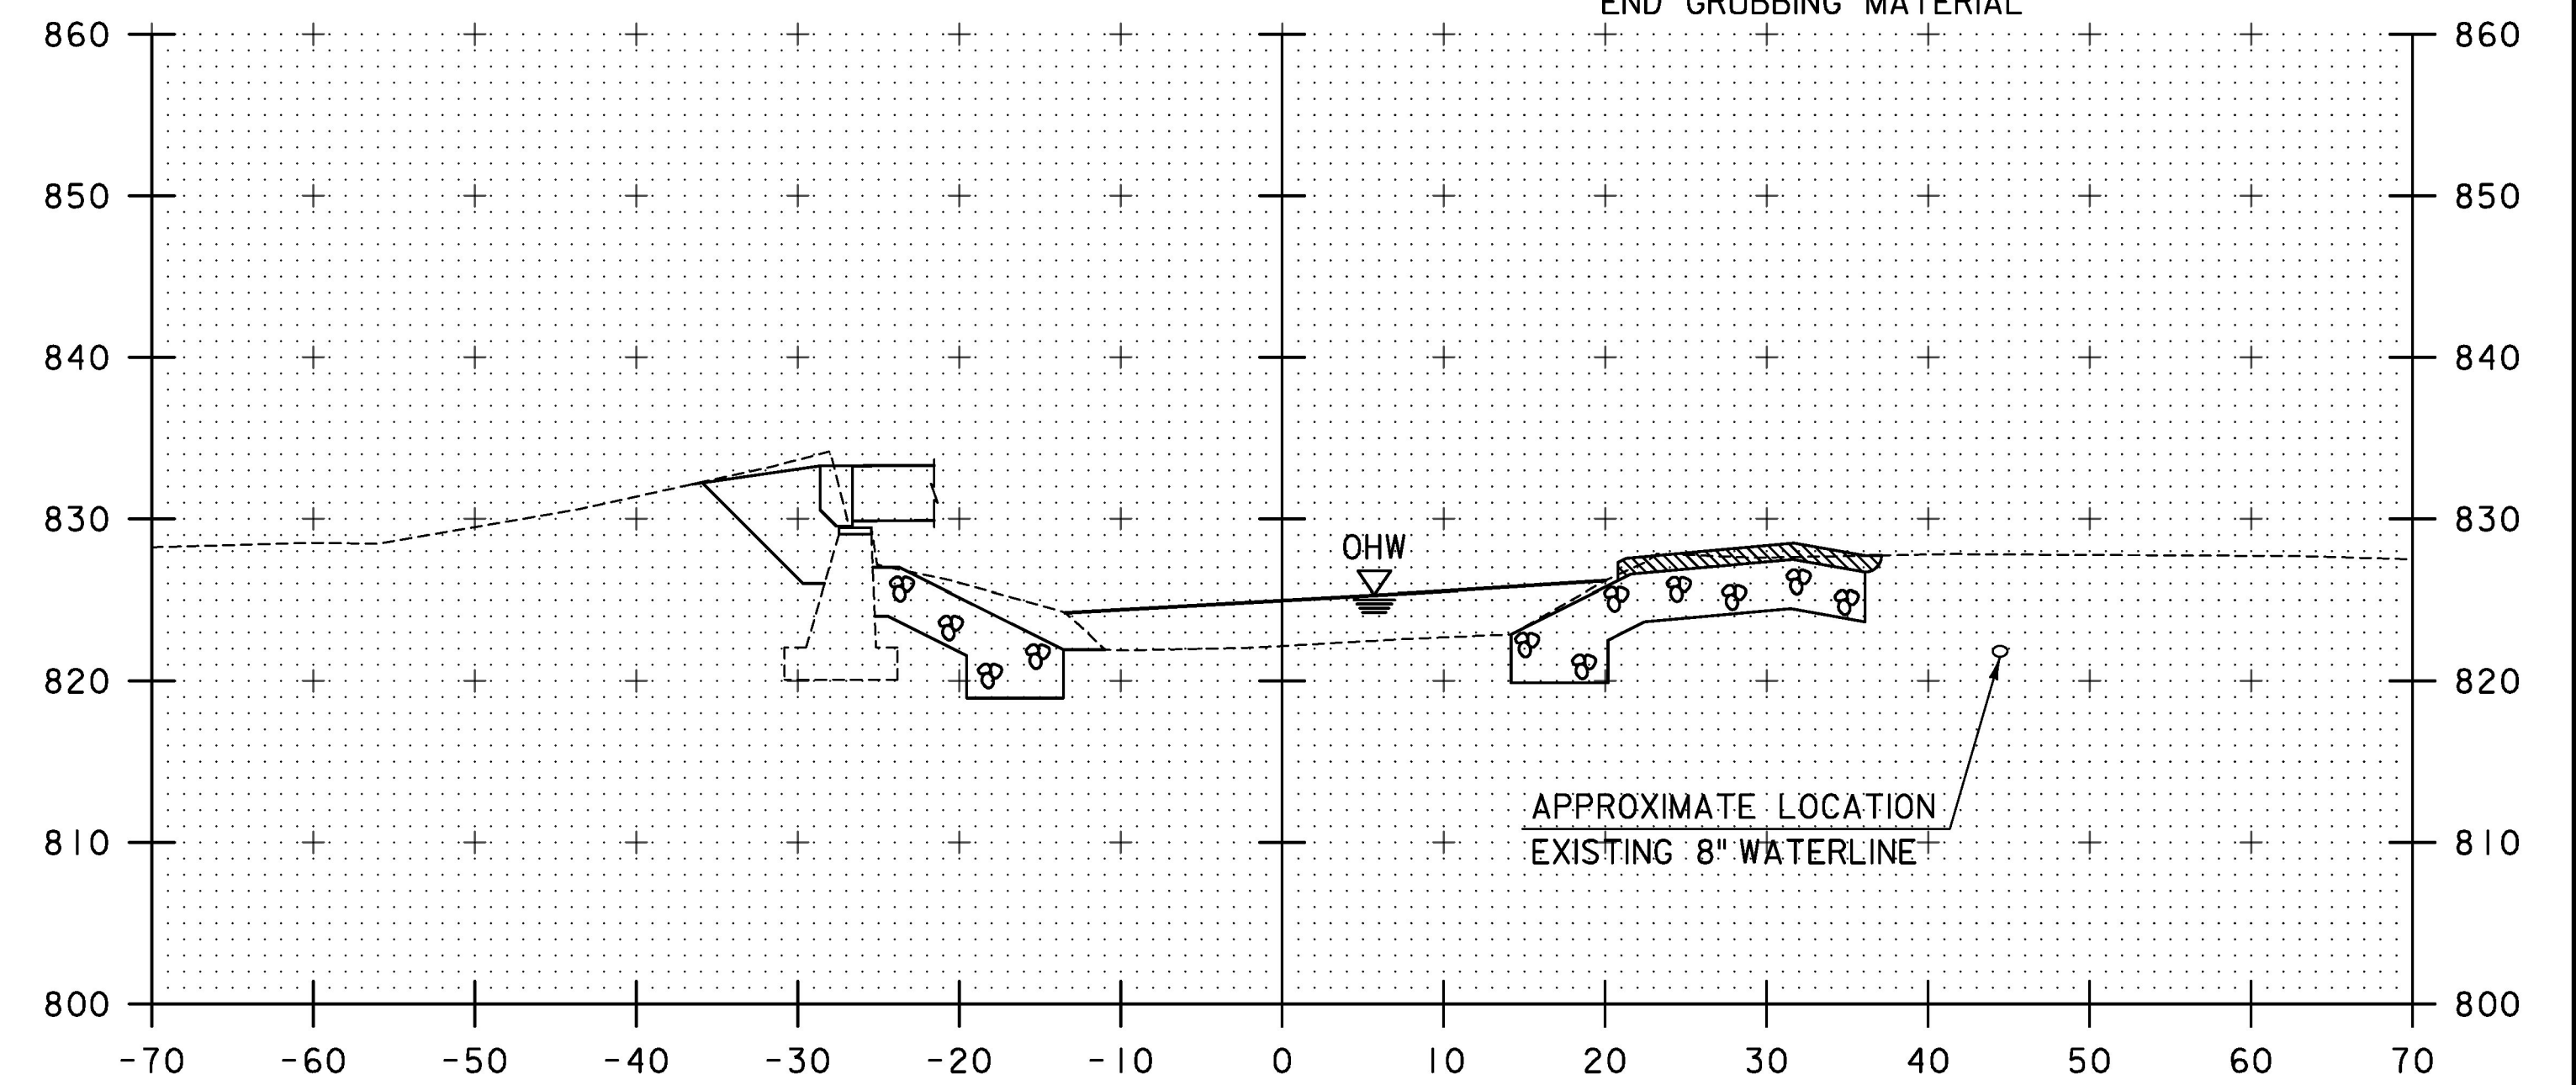

51+10

NO GRUBBING MATERIAL BENEATH SUPERSTRUCTURE

STA. 50+90 TO STA. 51+20

TYLIN INTERNATIONAL

PROJECT NAME: CHelsea
 PROJECT NUMBER: BHF 0169(10)

FILE NAME: z12ci52xschnl.dgn
 PROJECT LEADER: J. OLUND
 DESIGNED BY: T. POULIN
 CHANNEL SECTIONS 3

PLOT DATE: 8/31/2016
 DRAWN BY: T. POULIN
 CHECKED BY: J. OLUND
 SHEET 127 OF 137