


STA 51+89.00
 STA 51+87.21, LT
 END UNCLASSIFIED CHANNEL EXCAVATION
 END GEOTEXTILE UNDER STONE FILL, TYPE III
 END STONE FILL, TYPE III
 END GRUBBING MATERIAL

52+00

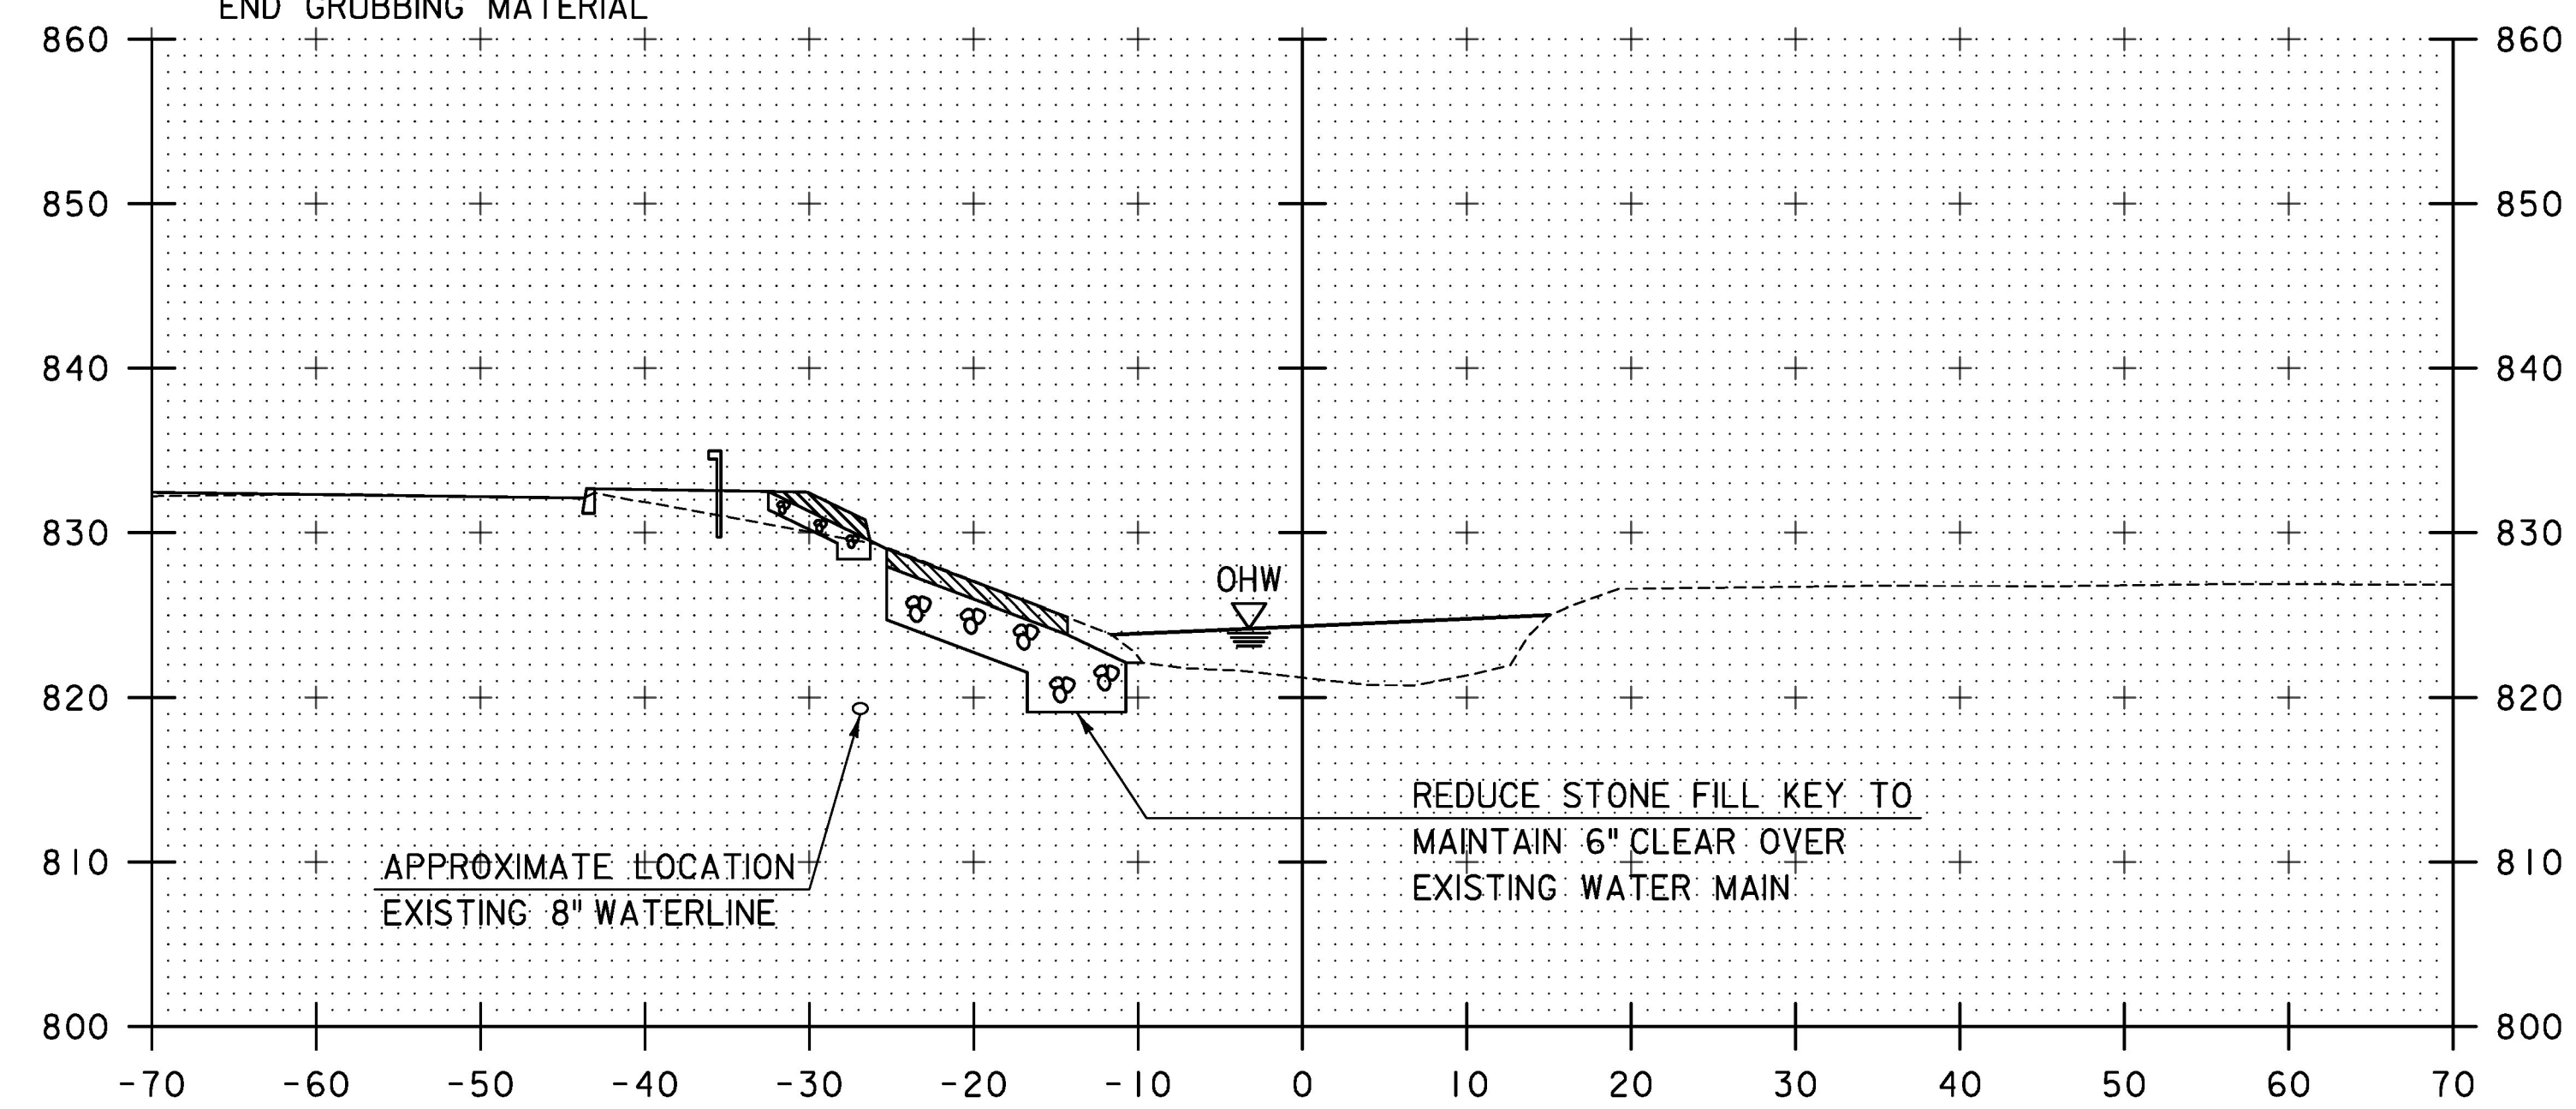

APPROXIMATE LOCATION
 EXISTING 8" WATERLINE

REDUCE STONE FILL KEY TO
 MAINTAIN 6" CLEAR OVER
 EXISTING WATER MAIN

51+75

STA. 51+75 TO STA. 52+00

TYLIN INTERNATIONAL

PROJECT NAME: CHELSEA
 PROJECT NUMBER: BHF 0169(10)

FILE NAME: z12ci52xschnl.dgn
 PROJECT LEADER: J. OLUND
 DESIGNED BY: T. POULIN
 CHANNEL SECTIONS 5

PLOT DATE: 8/31/2016
 DRAWN BY: T. POULIN
 CHECKED BY: J. OLUND
 SHEET 129 OF 137