


MISCELLANEOUS MATERIALS

ITEM	MARK	QTY.	DESCRIPTION	REMARKS
1	MK-CH	40	8T x 10" SWIFT LIFT LIFTER	GALVANIZED
2		52	4" I.D. x 1'-4" PVC SLEEVE	
3				
4		12	#5 x 7'-10 1/2" (EPOXY COATED)	
5		57	#5 x 24'-3 1/2" (EPOXY COATED)	
6		4	#5 x 8'-4 3/4" (EPOXY COATED)	
7		2	#5 x 5'-5 1/2" (EPOXY COATED)	
8		10	#5 x 5'-0" (EPOXY COATED)	
9		1	#5 x 29'-7" (EPOXY COATED)	
10		1	#5 x 28'-8" (EPOXY COATED)	
11		1	#5 x 27'-8" (EPOXY COATED)	
12		1	#5 x 27'-3" (EPOXY COATED)	
13		1	#5 x 26'-3" (EPOXY COATED)	
14		1	#5 x 25'-3" (EPOXY COATED)	
15		2	#5 x 7'-6" (EPOXY COATED)	
16		1	#5 x 19'-1 1/2" (EPOXY COATED)	
17		1	#5 x 20'-1 1/2" (EPOXY COATED)	
18		1	#5 x 21'-1 1/2" (EPOXY COATED)	
19		1	#5 x 21'-6 1/2" (EPOXY COATED)	
20		1	#5 x 22'-6 1/2" (EPOXY COATED)	
21		1	#5 x 23'-6 1/2" (EPOXY COATED)	
22				
23				
24				
25				

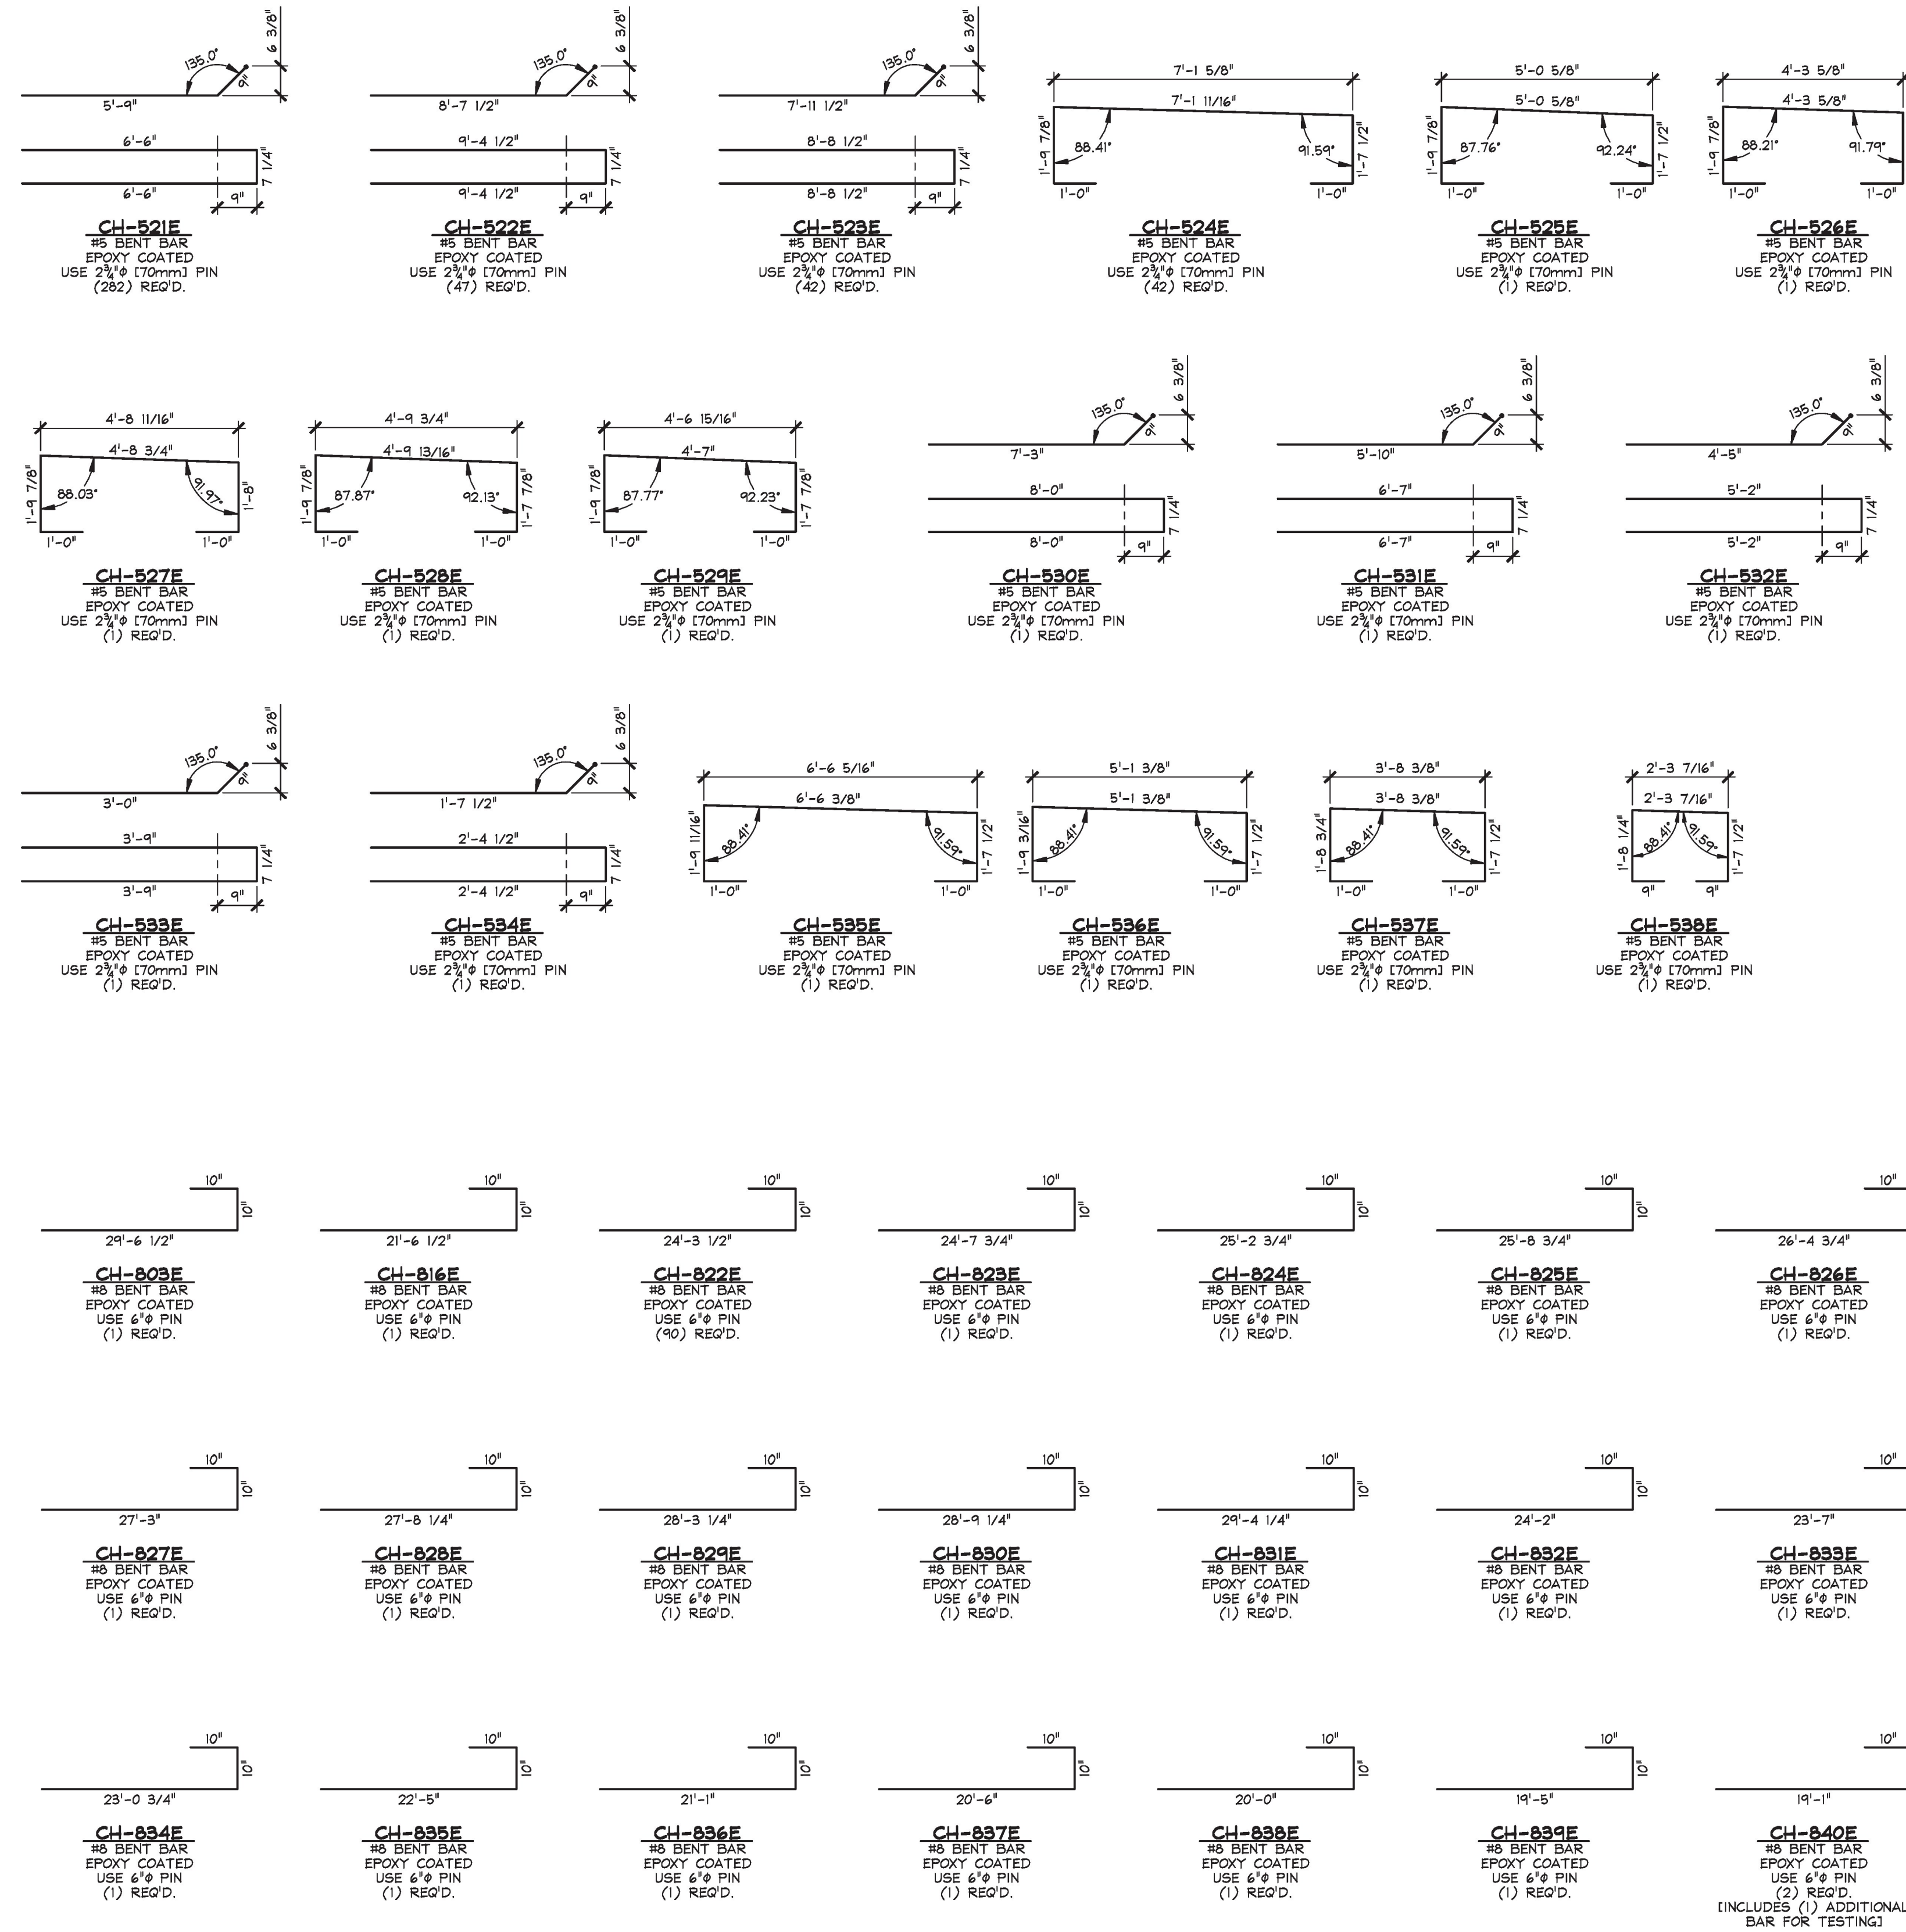

T.Y. LIN INTERNATIONAL
 THE STAMPED DOCUMENTS ARE HEREBY:
 APPROVED
 APPROVED AS NOTED
 REVISE AND RESUBMIT
 SEE TRANSMITTAL FOR ADDITIONAL INFORMATION AS APPLICABLE.
 THIS REVIEW IS FOR GENERAL CONFORMANCE WITH DESIGN CONCEPT ONLY. ANY DEVIATION FROM THE PLANS OR SPECIFICATIONS NOT CLEARLY NOTED BY THE CONTRACTOR HAS NOT BEEN REVIEWED. REVIEW BY THE ENGINEER SHALL NOT RELIEVE THE CONTRACTOR OF THE CONTRACTUAL RESPONSIBILITY FOR ANY ERRORS OR DEVIATION FROM THE CONTRACT REQUIREMENTS.
 JOSH OLUND February 24, 2017
 REVIEWER DATE

APPROVAL STAMP:
 Vermont Agency of Transportation
RECEIVED
 CK'D BY TYLin OK'D BY TYLin
 February 27, 2017
 RESUBMIT No Approved
 BY Kristin Higgins DATE 2/28/2017

J.P. CARRARA & SONS INC.
 Precast & Prestress Manufacturer
 2464 CASE STR., MIDDLEBURY, VERMONT 05753 Phone: (802)388-6361 Fax: (802)388-9010

STATE OF VERMONT AGENCY OF TRANSPORTATION
 COUNTY OF ORANGE

TOWN OF CHELSEA
 VT ROUTE 110, RURAL MAJOR COLLECTOR
 BRIDGE NO.: 9 PROJECT NO.: BHF 0169(9)

PRECAST APPROACH SLAB MATERIALS LIST

CPM CONSTRUCTORS
 CONTRACTOR
 FREEPORT, MAINE

DATE: NOV. 29, 2016
 SCALE: NOTED
 CHKD: A.S. DFTM: B.L.
 JOB NO: 23505-016
 DWG. NO: M1
 BRIDGE 9