
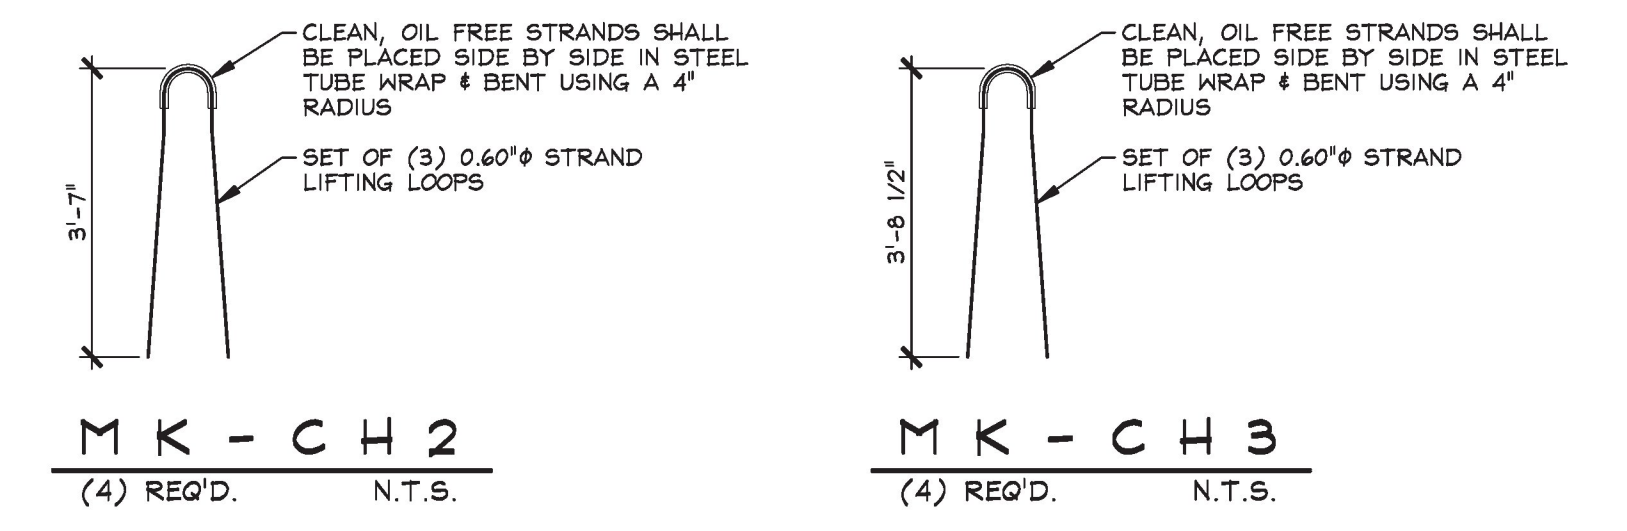


MISCELLANEOUS MATERIALS				
ITEM	MARK	QTY.	DESCRIPTION	REMARKS
1	MK-CH2	4	SET OF (3) 0.60" STRAND LIFTING LOOPS	SEE DETAIL THIS SHEET
2	MK-CH3	4	SET OF (3) 0.60" STRAND LIFTING LOOPS	SEE DETAIL THIS SHEET
3		4	4" x 1'-4 9/16" CORRUGATED STEEL PIPE	GALVANIZED
4		2	4" x 1'-0 1/4" CORRUGATED STEEL PIPE	GALVANIZED
5		4	4" x 1'-3" CORRUGATED STEEL PIPE	GALVANIZED
6		2	4" x 1'-5 3/16" CORRUGATED STEEL PIPE	GALVANIZED
7				
8		12	#5 x 6'-0 1/2" (EPOXY COATED)	
9		3	#5 x 21'-0" (EPOXY COATED)	
10		3	#5 x 22'-7" (EPOXY COATED)	
11		3	#5 x 31'-9" (EPOXY COATED)	
12		3	#5 x 13'-2" (EPOXY COATED)	
13		3	#5 x 33'-5" (EPOXY COATED)	
14		9	#5 x 7'-4" (EPOXY COATED)	INCLUDES (1) ADDITIONAL BAR FOR TESTING
15		12	#5 x 7'-3" (EPOXY COATED)	
16		3	#5 x 34'-10 1/2" (EPOXY COATED)	
17		3	#5 x 33'-3" (EPOXY COATED)	
18		9	#5 x 6'-4" (EPOXY COATED)	
19		3	#5 x 19'-3" (EPOXY COATED)	
20		3	#5 x 20'-10 1/2" (EPOXY COATED)	
21				
22		3	#9 x 21'-0" (EPOXY COATED)	
23		5	#9 x 22'-7" (EPOXY COATED)	
24		5	#9 x 33'-5" (EPOXY COATED)	
25		1	#9 x 16'-6" (EPOXY COATED)	INCLUDES (1) ADDITIONAL BAR FOR TESTING
26		3	#9 x 31'-9" (EPOXY COATED)	
27		5	#9 x 34'-10 1/2" (EPOXY COATED)	
28		3	#9 x 33'-3" (EPOXY COATED)	
29		3	#9 x 19'-3" (EPOXY COATED)	
30		5	#9 x 20'-10 1/2" (EPOXY COATED)	
31				
32		4	#10 x 6'-0" (EPOXY COATED)	
33		6	#10 x 21'-0" (EPOXY COATED)	
34		6	#10 x 23'-0" (EPOXY COATED)	
35		4	#10 x 5'-8" (EPOXY COATED)	INCLUDES (2) ADDITIONAL BAR FOR TESTING
36		6	#10 x 19'-3" (EPOXY COATED)	
37				
38				
39				
40				

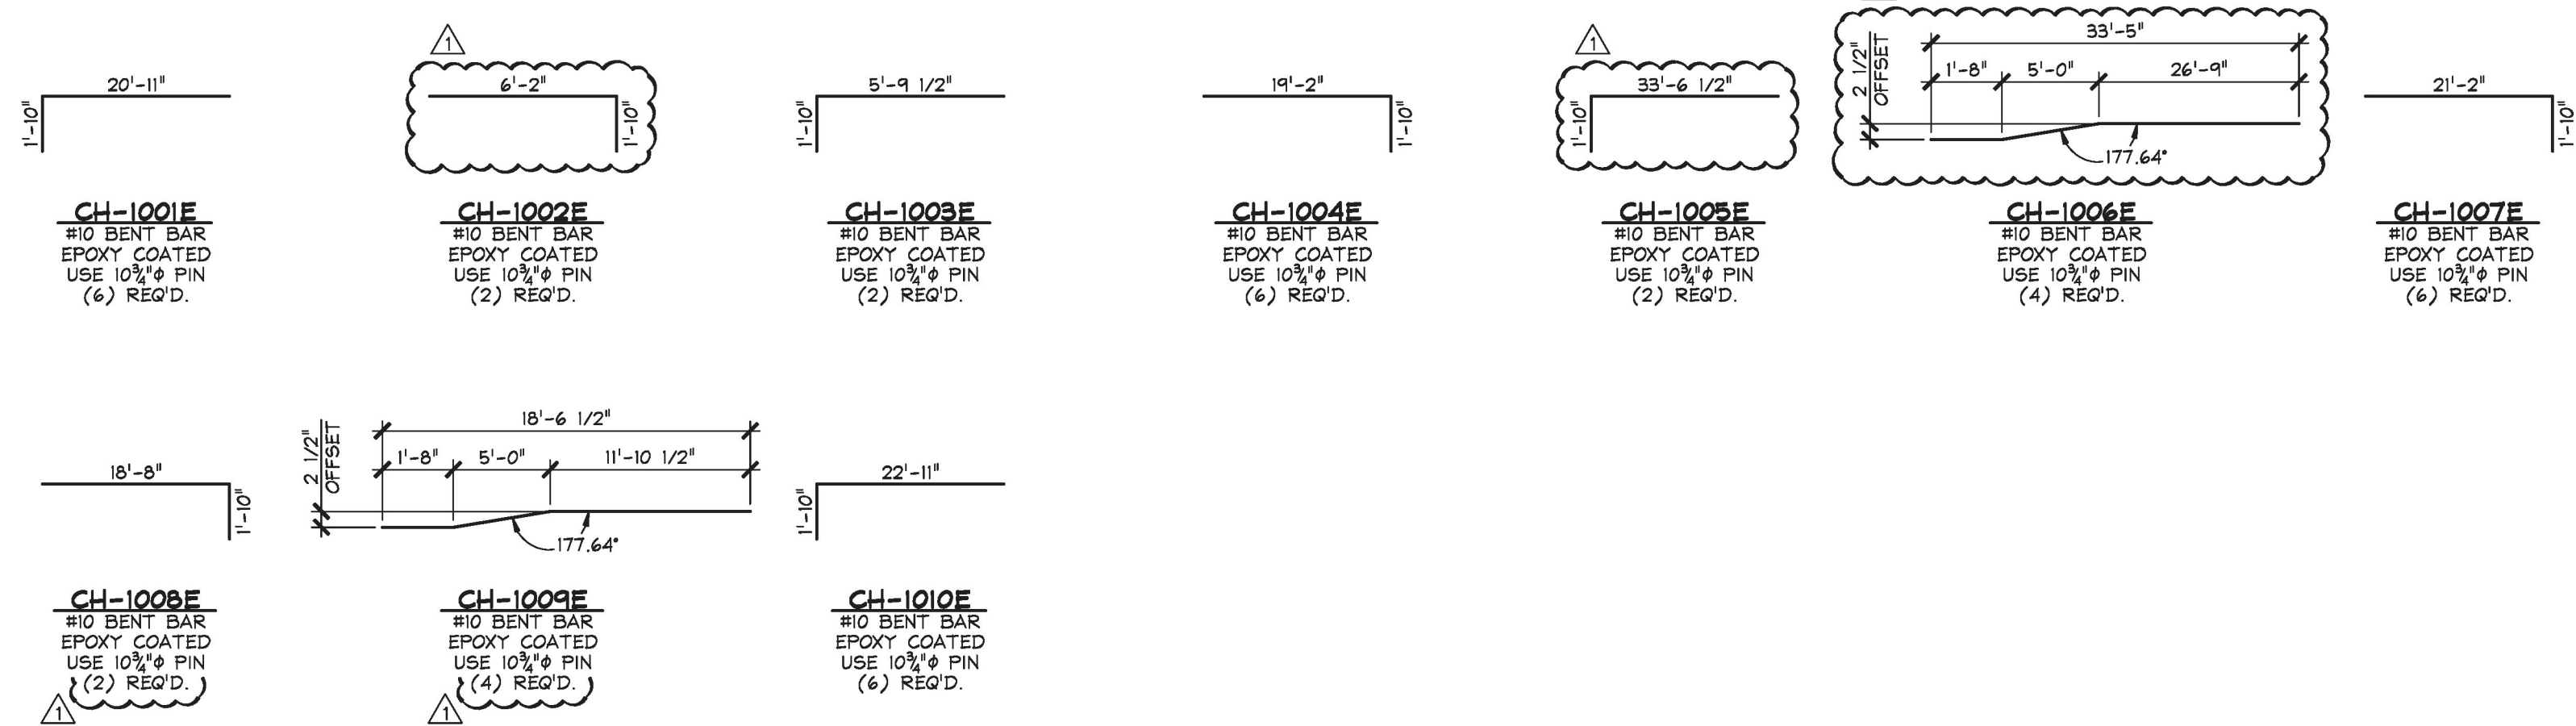

**T.Y. LIN INTERNATIONAL**  
 THE STAMPED DOCUMENTS ARE HEREBY:  
 X APPROVED  
 APPROVED AS NOTED  
 REVISE AND RESUBMIT  
 SEE TRANSMITTAL FOR ADDITIONAL INFORMATION AS APPLICABLE.  
 THIS REVIEW IS FOR GENERAL CONFORMANCE WITH DESIGN CONCEPT ONLY. ANY DEVIATION FROM THE PLANS OR SPECIFICATIONS NOT CLEARLY NOTED BY THE CONTRACTOR HAS NOT BEEN REVIEWED. REVIEW BY THE ENGINEER SHALL NOT RELIEVE THE CONTRACTOR OF THE CONTRACTUAL RESPONSIBILITY FOR ANY ERRORS OR DEVIATION FROM THE CONTRACT REQUIREMENTS.  
 JOSH OLUND February 24, 2017  
 REVIEWER DATE

2-22-17 REVISED AS NOTED

APPROVAL STAMP: Vermont Agency of Transportation <b>RECEIVED</b> CK'D BY TYLin OK'D BY TYLin February 27, 2017 RESUBMIT No Approved BY Kristin Higgins DATE 2/28/2017	J.P. CARRARA & SONS INC. Precast & Prestress Manufacturer 2464 OSE STR., MIDDLEBURY, VERMONT 05753 Phone:(802)388-6361 Fax:(802)388-8010	CPM CONSTRUCTORS CONTRACTOR FREEPORT, MAINE
STATE OF VERMONT AGENCY OF TRANSPORTATION COUNTY OF ORANGE	DATE: NOV. 29, 2016 SCALE: NOTED	CHKD: M.W. DFTM: B.L. JOB NO: 23505-016
TOWN OF CHELSEA VT ROUTE 110, RURAL MAJOR COLLECTOR BRIDGE NO.: 9 PROJECT NO.: BHF 0169(9)	DWG. NO: <b>M2</b> BRIDGE 9	